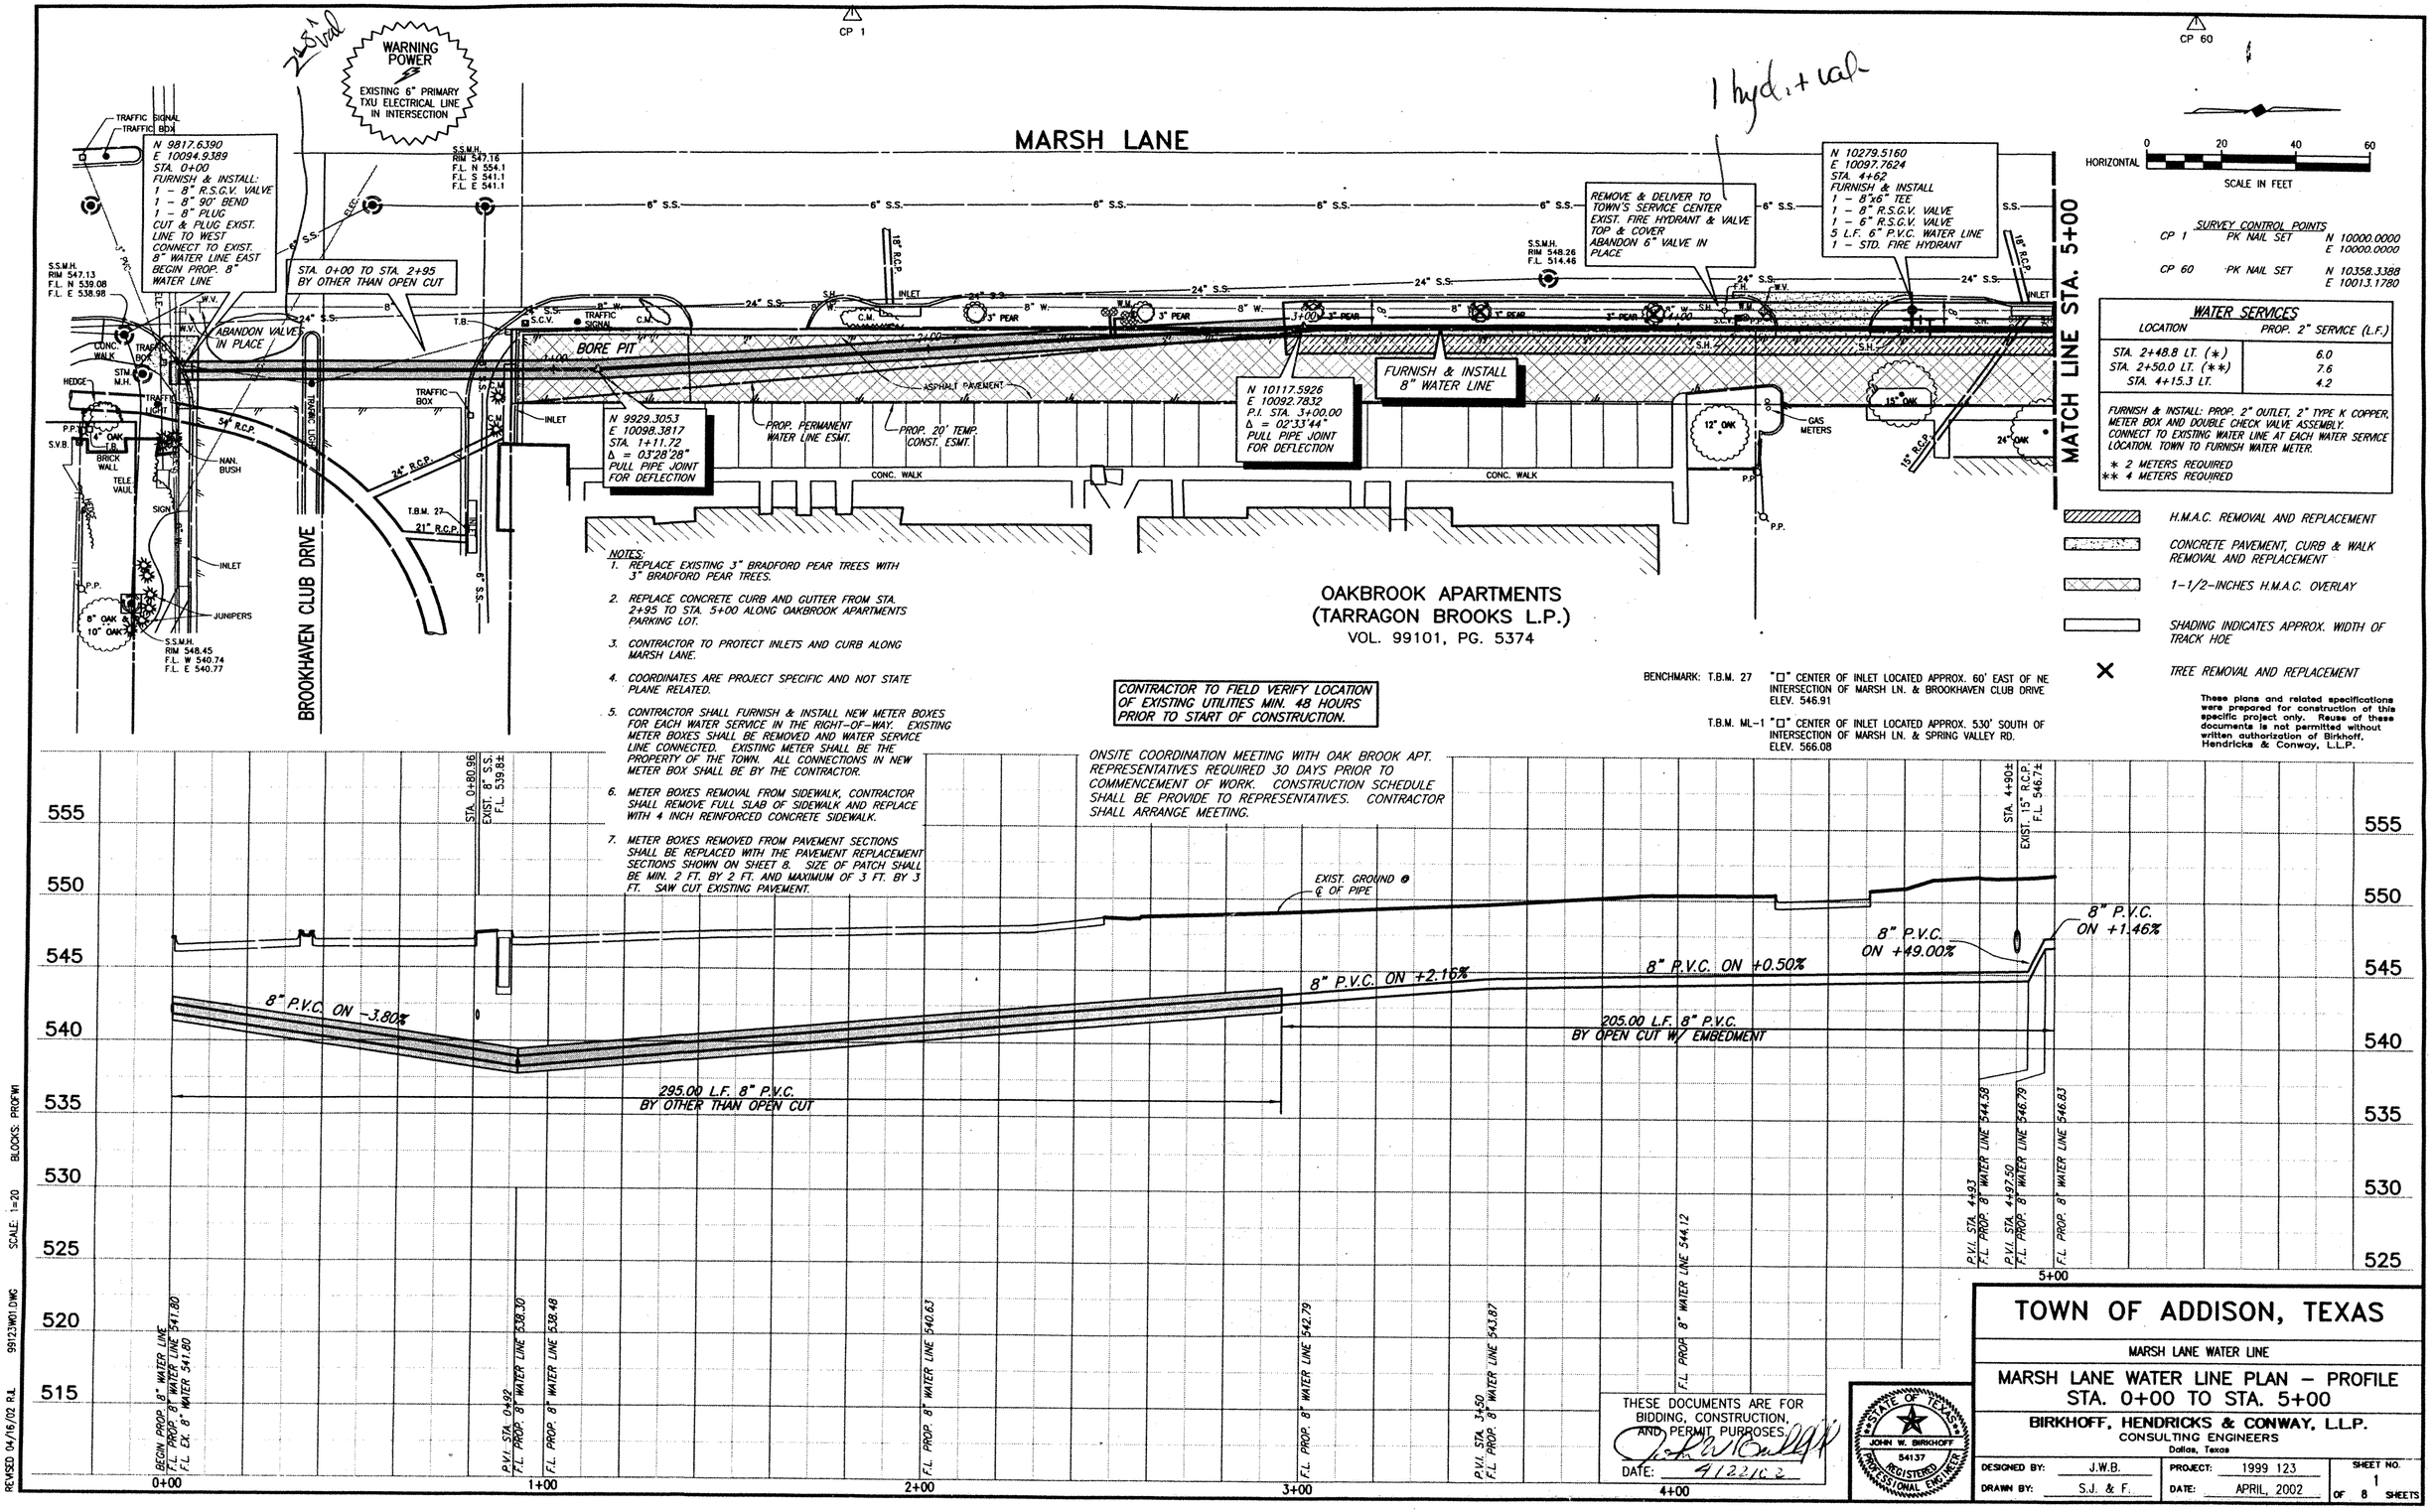

NOTES:

1. REPLACE EXISTING 3" BRADFORD PEAR TREES WITH 3" BRADFORD PEAR TREES.
2. REPLACE CONCRETE CURB AND GUTTER FROM STA. 2+95 TO STA. 5+00 ALONG OAKBROOK APARTMENTS PARKING LOT.
3. CONTRACTOR TO PROTECT INLETS AND CURB ALONG MARSH LANE.
4. COORDINATES ARE PROJECT SPECIFIC AND NOT STATE PLANE RELATED.
5. CONTRACTOR SHALL FURNISH & INSTALL NEW METER BOXES FOR EACH WATER SERVICE IN THE RIGHT-OF-WAY. EXISTING METER BOXES SHALL BE REMOVED AND WATER SERVICE LINE CONNECTED. EXISTING METER SHALL BE THE PROPERTY OF THE TOWN. ALL CONNECTIONS IN NEW METER BOX SHALL BE BY THE CONTRACTOR.
6. METER BOXES REMOVAL FROM SIDEWALK, CONTRACTOR SHALL REMOVE FULL SLAB OF SIDEWALK AND REPLACE WITH 4 INCH REINFORCED CONCRETE SIDEWALK.
7. METER BOXES REMOVED FROM PAVEMENT SECTIONS SHALL BE REPLACED WITH THE PAVEMENT REPLACEMENT SECTIONS SHOWN ON SHEET 8. SIZE OF PATCH SHALL BE MIN. 2 FT. BY 2 FT. AND MAXIMUM OF 3 FT. BY 3 FT. SAW CUT EXISTING PAVEMENT.

These plans and related specifications were prepared for construction of this specific project only. Reuse of these documents is not permitted without written authorization of Birkhoff, Hendricks & Conway, L.L.P.