



LIGHT ●

SURVEYOR

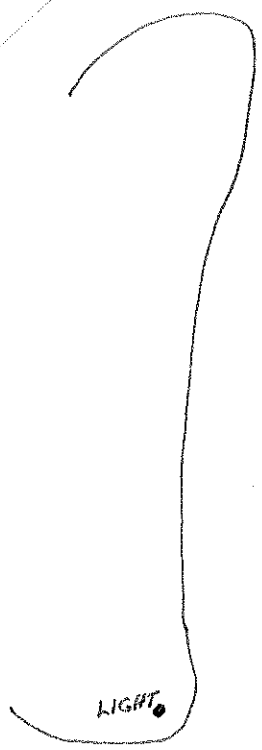


LIGHT ●

MORNING

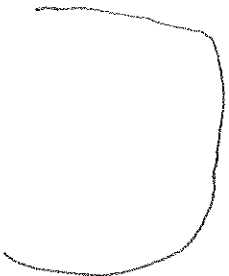

BELTWAY

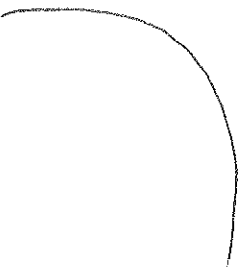

● NO LIGHT, NO TRANSFORMER

● NO LIGHT, NO TRANSFORMER

● TRANSFORMER WITH LIGHT

● TRANSFORMER, NO LIGHT

● TRANSFORMER, NO LIGHT

● LIGHT

PECAN SQUARE

● TRANSFORMER, NO LIGHT

●

MIDWAY MEADOWS 249 LOTS 24933M YACUDIM



- LEGEND**
- PROPOSED 1500 WATT TRANSFORMER 1312.5KVA
 - PROPOSED HANDHOLE 102
 - PROPOSED 120' PRIMARY CABLE 11.50C
 - PROPOSED 120' SECONDARY CABLE 7.80C
 - PROPOSED 120' 1ST CABLE 2.00C
NOTE:
 1) DUPLEXES BLK A BLK B & BLK C LOTS 1-19 (49 LOTS)
 2) ZERO LOT LINE PATIO HOMES
 BLK C LOTS 20-80, BLK D, BLK E & BLK F (202 LOTS)
 3) ONE SERVICE RUN TO EACH DUPLEX LOT
 SIDEWALK INSTALLED IN: BLK C Lot 59-85
 (S. AGAINST CURB)
 BLK D
 BLK E

CONDUIT JOB: W.A. 1005
 PROJ. 19-5267

PREL 190-1694 WA 10-5428
 FARMERS' BRANCH DISTRICT
 ADDISON
 MIDWAY MEADOWS
 249 LOTS

DESIGNED BY	DATE	APPROVED BY
SCALE AS SHOWN	DATE	DATE

INST 1795 of
 1-477MCM 72KV PRI