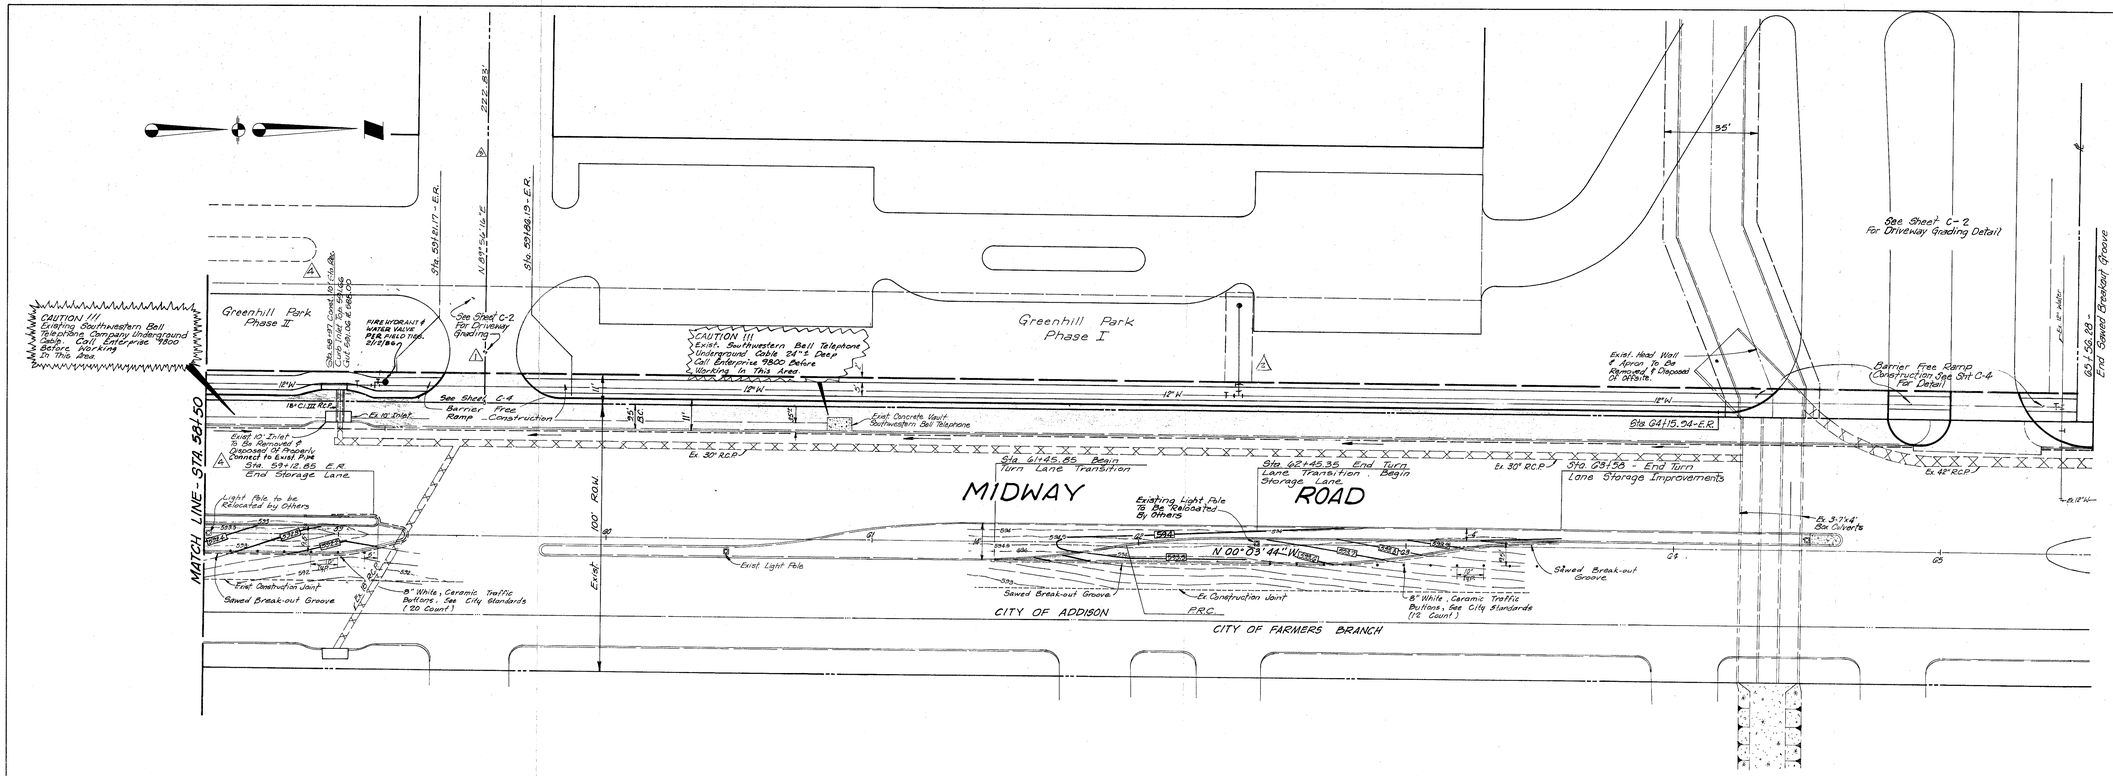

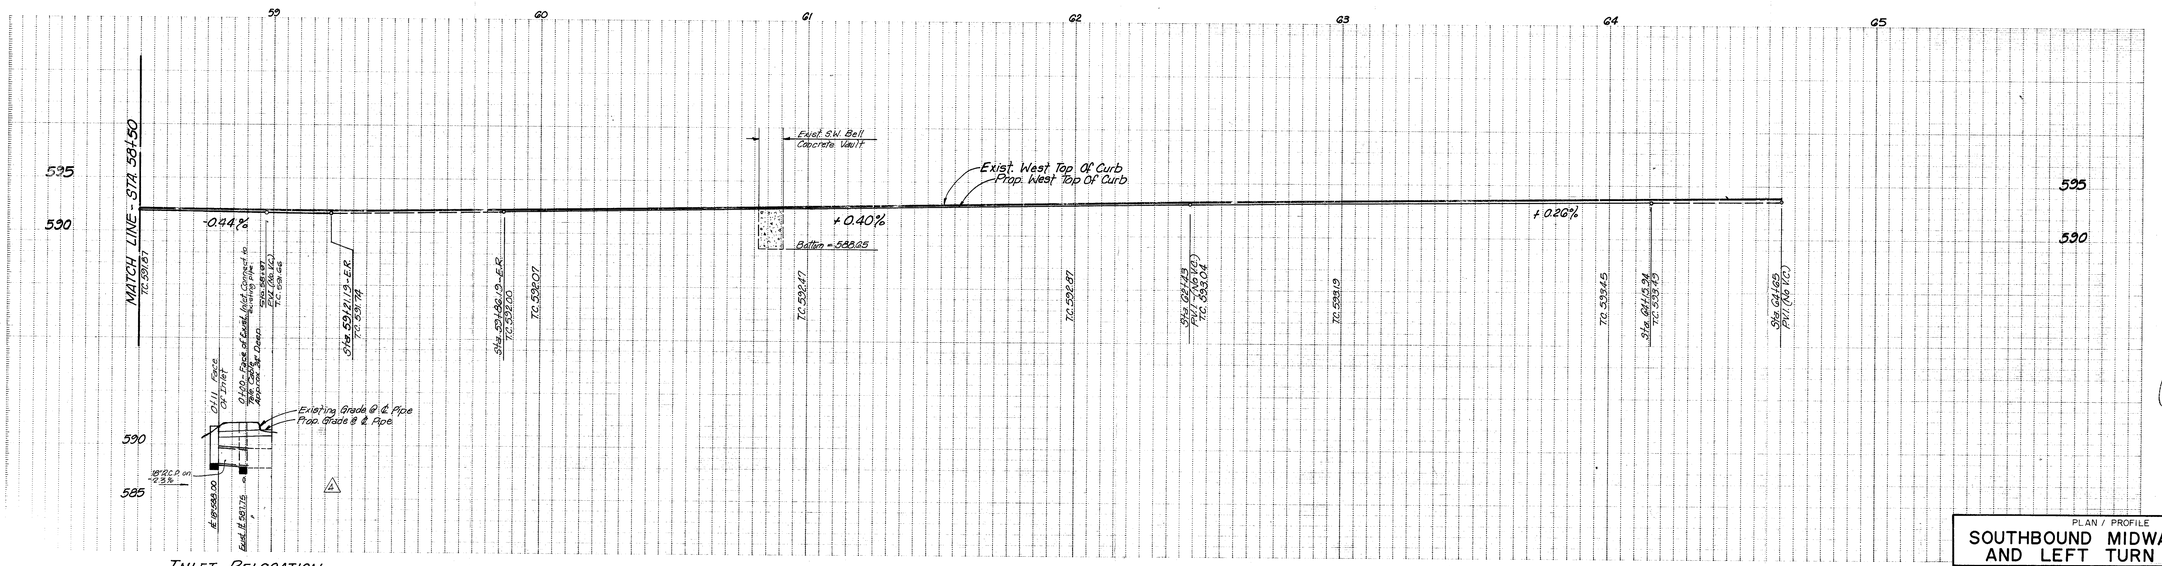

INLET RELOCATION

BENCHMARK		ELEVATION
1.	Found "□" on the southwest corner of the Greenhill School brick sign, standing on the northwest corner of the Spring Valley Road and Midway Road intersection.	588.16
2.	Found "□" in center of west headwall of triple 7'x 4' box culvert under Midway Road, approximately 115 feet south of Greenhill Park northeast corner.	589.78

Craig S. Sowinski
April 17, 1986

C-5

1 Revised Driveway
2 FIRE HYDRANT REVISION
3 Phase Line Revision. 7-2-86
4 Inlet & Top of Curb Revision 2-13-86

PLAN / PROFILE
SOUTHBOUND MIDWAY ROAD AND LEFT TURN LANES

ALBERT H. HALFF ASSOCIATES, INC.
ENGINEERS & SCIENTISTS

DESIGN	DRAWN	DATE	SCALE	NOTES	FILE	NO.
C.S.S.	B.W.	MAR 86	H: 1"=20' V: 1"=5'			

A.V.O. 7783

THE OFFICE OF PIERCE GOODWIN ALEXANDER
Architecture
Planning
Interior Architecture
2121 San Jacinto
Suite 1900
Dallas, Texas 75201
214-969-6888

Project Number: 8420
Date Issued:
Revisions:

PHASE ONE
GREENHILL PARK
FOR THE TRAMMELL CROW COMPANY
ADDISON, TEXAS