


S: 1"=50'-0"

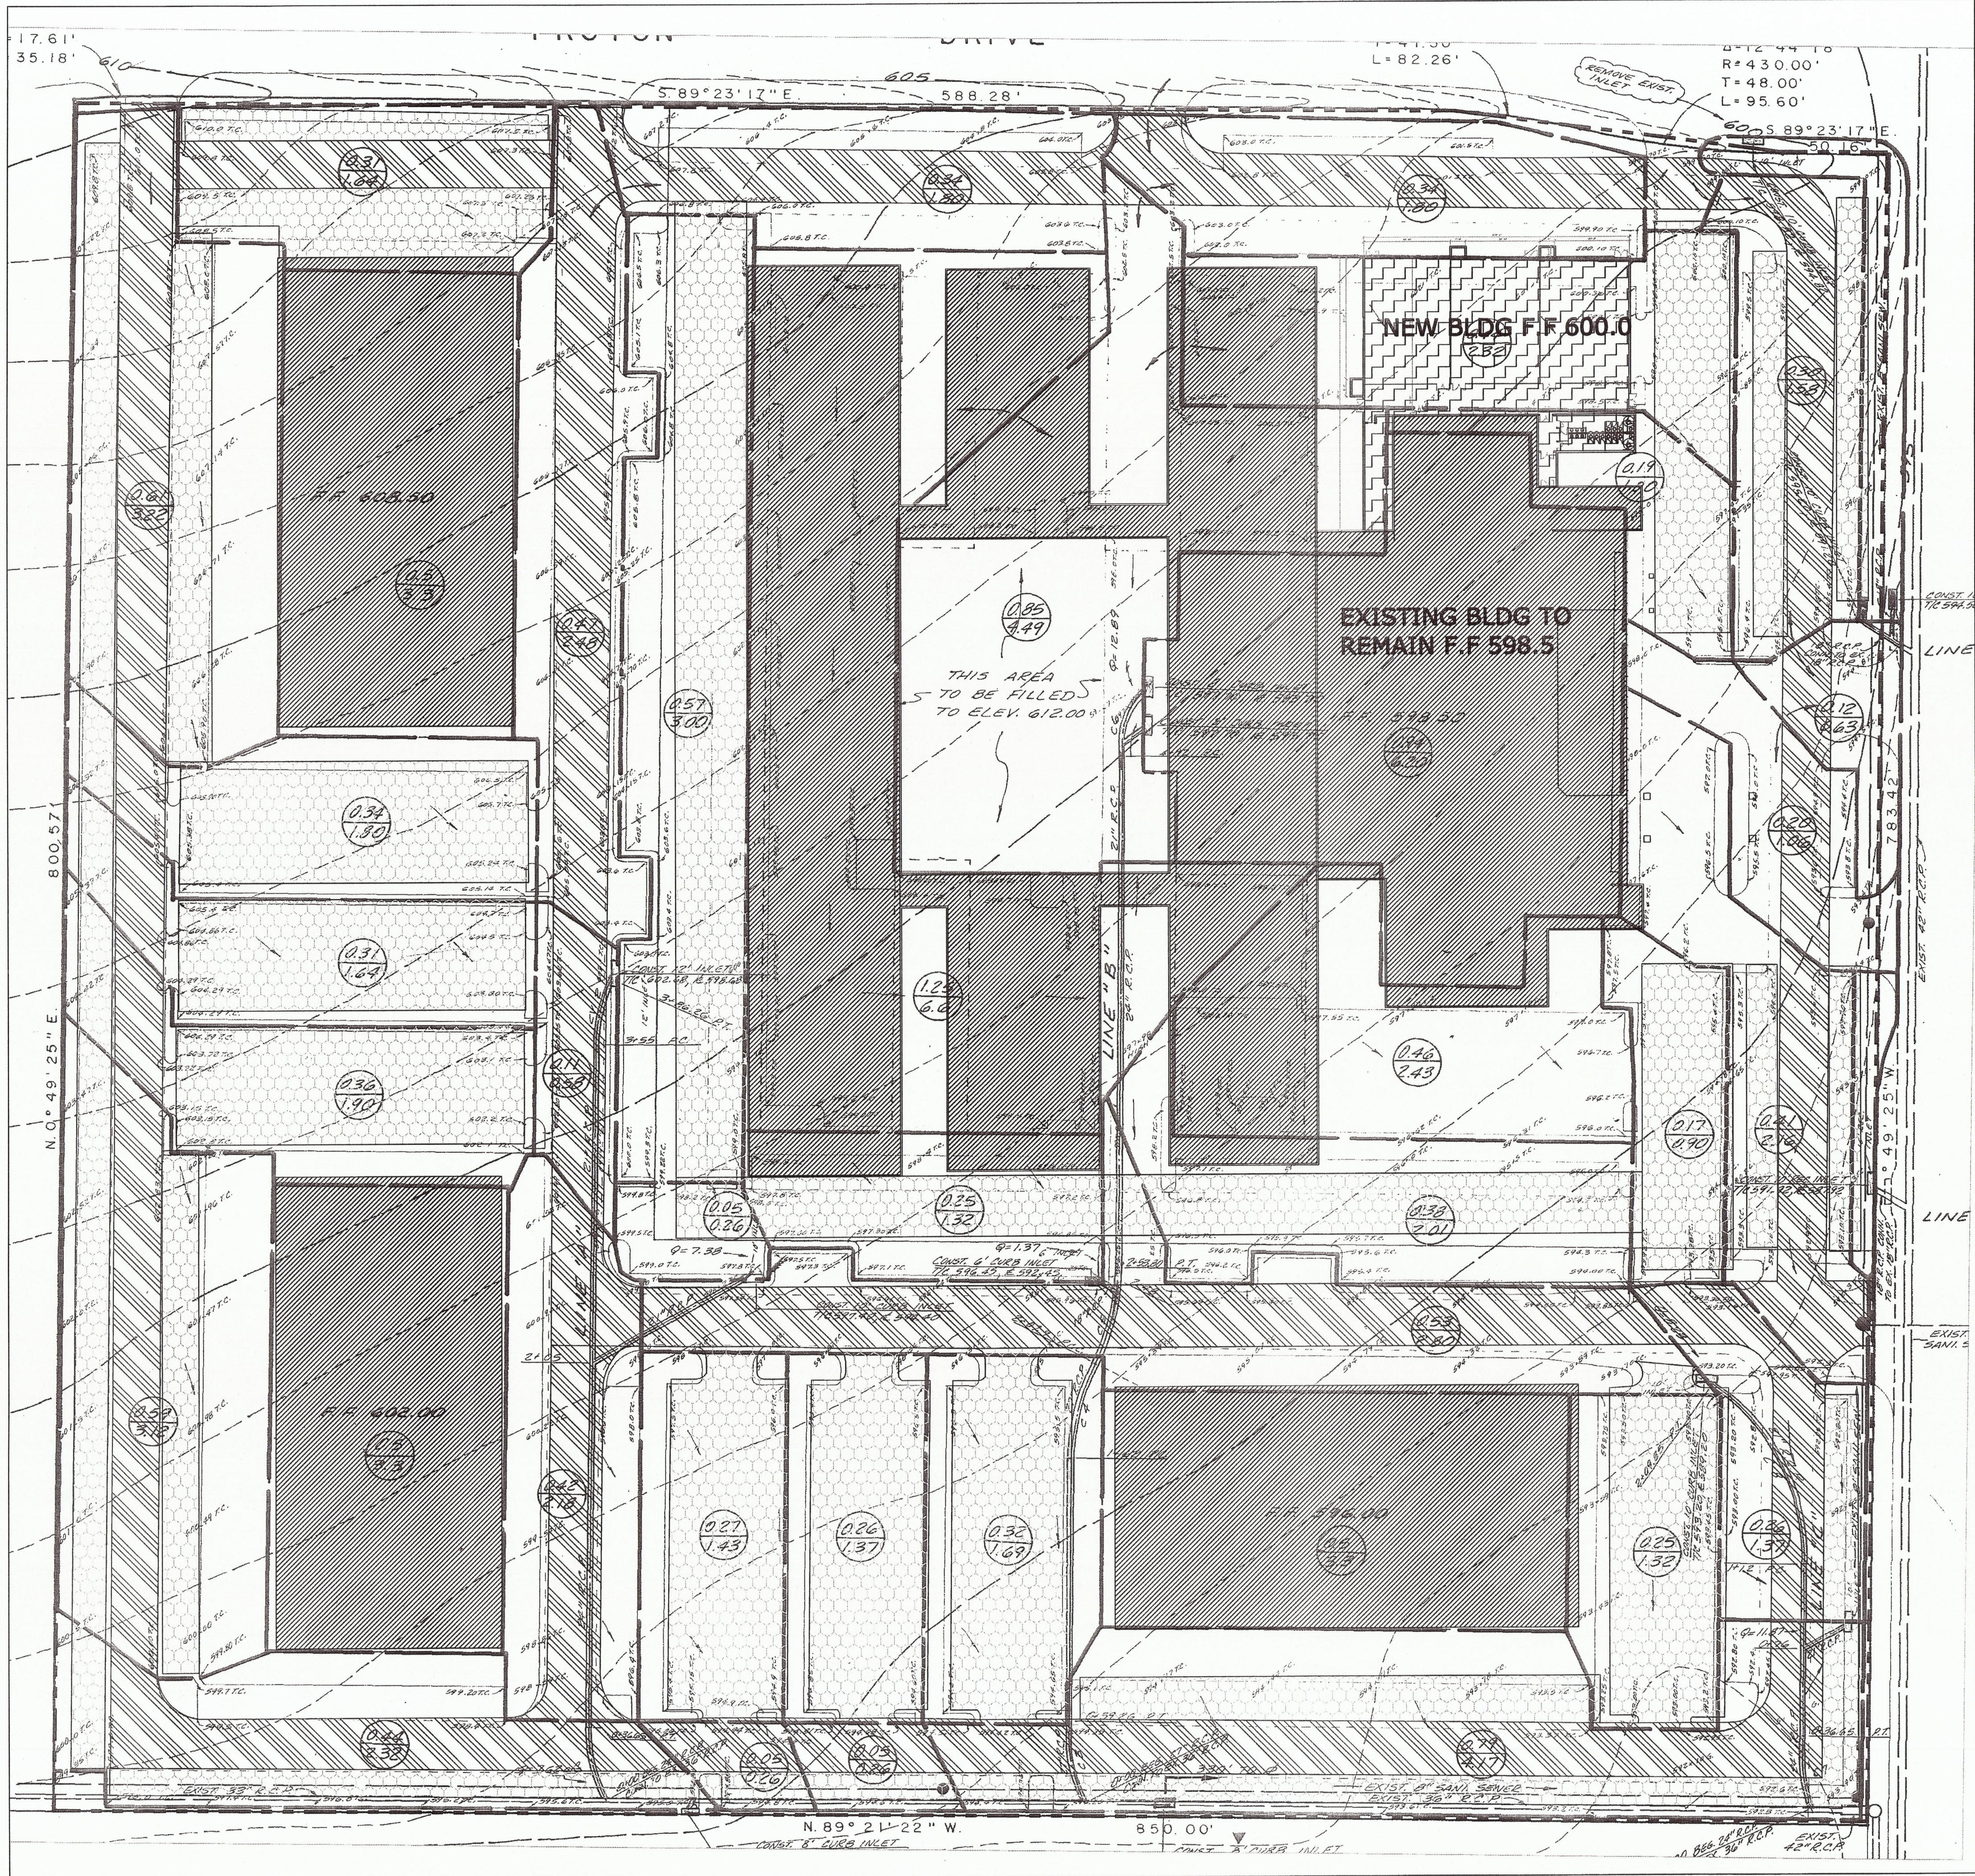

S: 1"=40'-0"

**CHAUCER'S
DESIGN STUDIO**

949 SIMON DRIVE, PLANO, TX. 75025
TEL: 972.849.6848 E-MAIL: chaucerdsgn@gmail.com



CROWN PLAZA HOTEL

14315 MIDWAY
ADDISON, TEXAS 75001

REVISION:

DRAFTER:
CHEHSIANG CHEN
DATE:
03/01/2010

C2