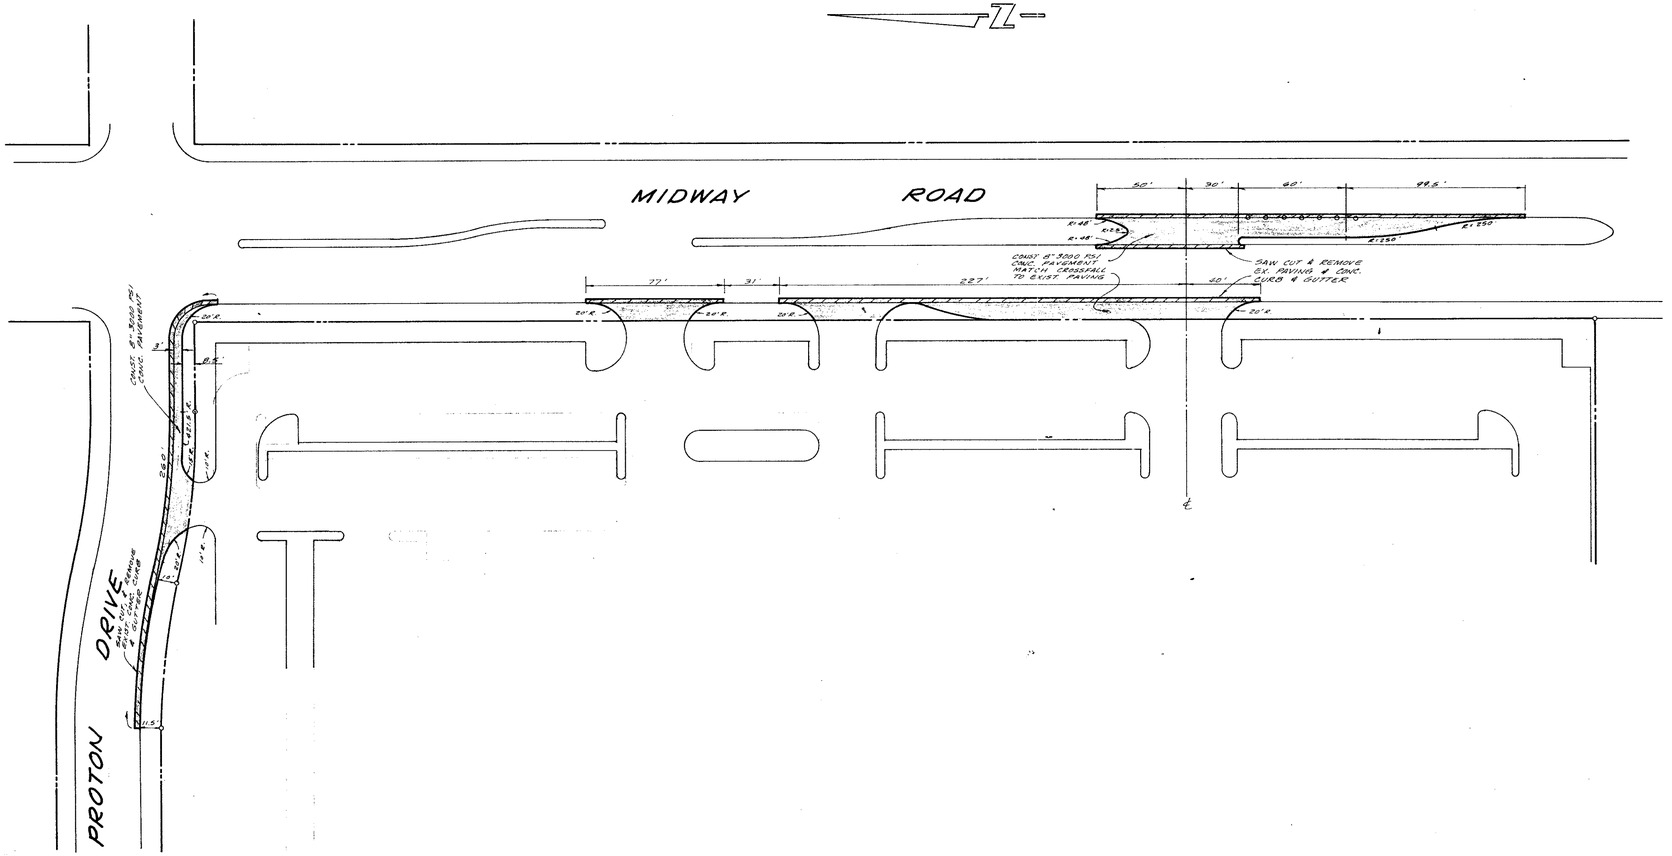

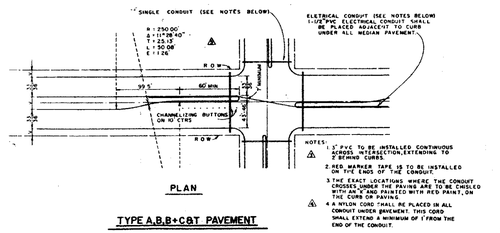

PLAN

TYPE A,B,B+C&T PAVEMENT

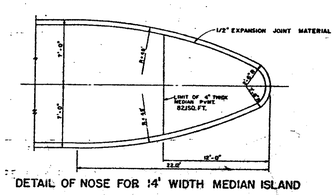

DETAIL OF NOSE FOR 14' WIDTH MEDIAN ISLAND

AS BUILT PLANS

NOTE: THE INTENT OF THE OWNER AND ENGINEER WAS TO CONSTRUCT THE UTILITIES ACCORDING TO THESE PLANS AS APPROVED BY THE CITY OF ADDISON. THE LINES AND GRADES WERE SET ON THE GROUND FOR CONSTRUCTION ACCORDING TO SAID PLANS. THE CITY OF ADDISON INSPECTED THE CONSTRUCTION. THE OWNER OR ENGINEER DID NOT VERIFY LINES OR GRADES AFTER CONSTRUCTION. WE ARE NOT AWARE OF ANY CHANGES OR REVISIONS TO THESE PLANS DURING CONSTRUCTION. EXCEPT SOME PARKING ISLANDS HAVE CHANGED.

NOV. 14, 1985

STATE OF TEXAS
DAN M. DOWDEY
21433
REGISTERED PROFESSIONAL ENGINEER

OWNERSHIP OF DOCUMENTS

THIS DOCUMENT, AND THE IDEAS AND DESIGNS INCORPORATED HEREIN, AS AN INSTRUMENT OF PROFESSIONAL SERVICE, IS THE PROPERTY OF THREADGILL-DOWDEY & ASSOCIATES AND IS NOT TO BE USED, IN WHOLE OR IN PART, FOR ANY OTHER PROJECT WITHOUT THE WRITTEN AUTHORIZATION OF THREADGILL-DOWDEY & ASSOCIATES

PAVING PLANS

HUIE ADDISON ADDITION

THOMAS L. CHENOWETH SUR., ABST. 273

ADDISON, TEXAS

THREADGILL - DOWDEY and ASSOCIATES
CONSULTING ENGINEERS DALLAS, TEXAS

DESIGN	DRAWN	CHECKED	DATE	SCALE	JOB	SHEET
A.R.W.	R.E.	D.M.D.	6-84	1"=40'	9208	1

PLATE No. 7