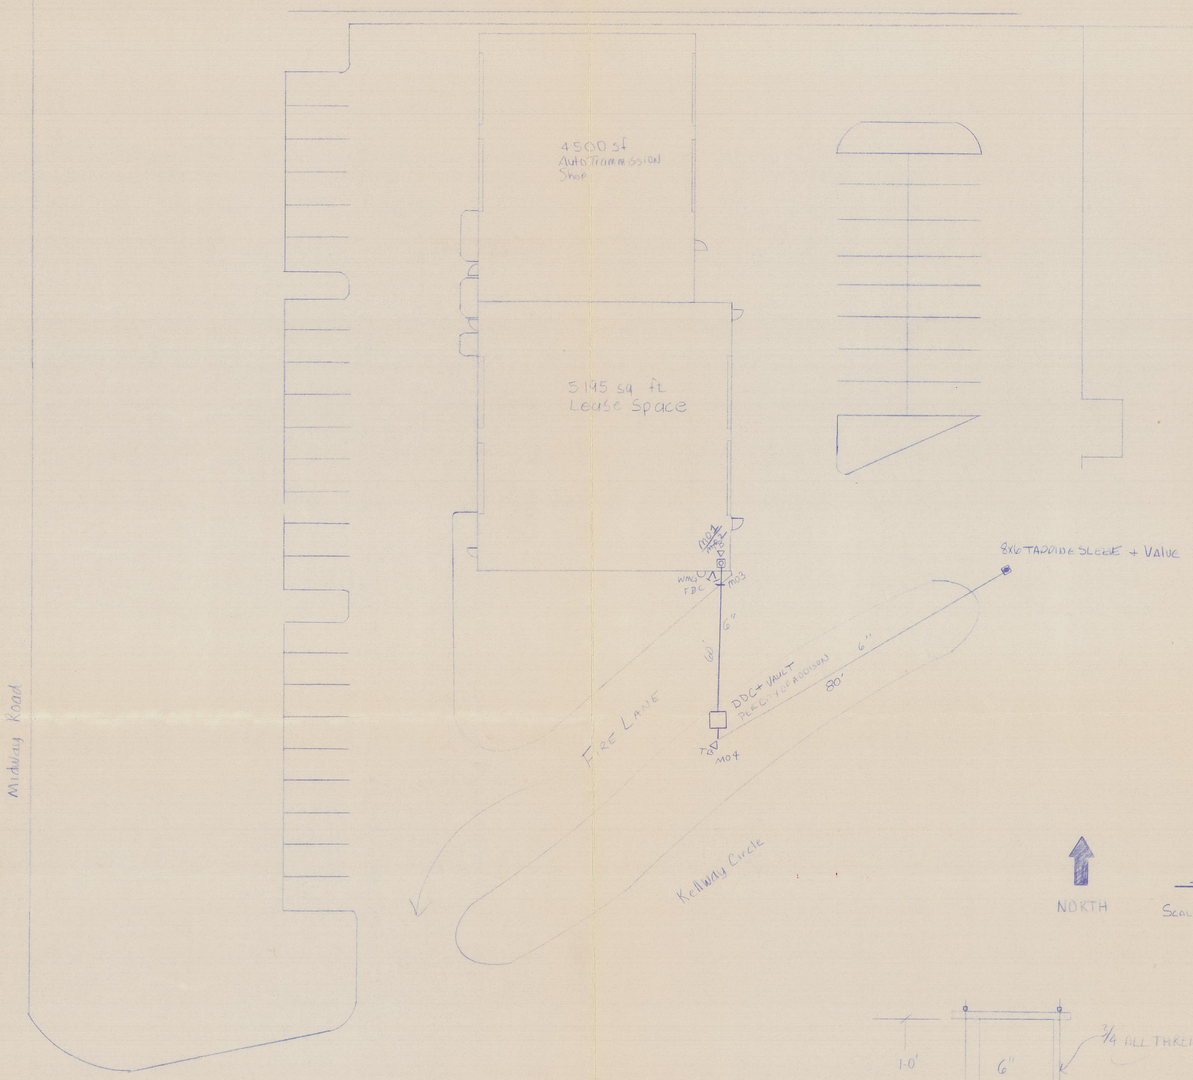

NORTH

SITE PLAN

Scale 1" = 20'

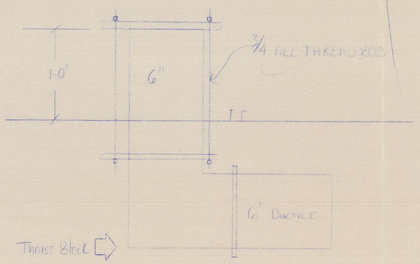

SPIGOT DETAIL PER
NFPA 24
NO SCALE

NOTE:

FIRE UNDERGROUND INSTALLED PER NFPA 24
AND City of ADDISON SPECIFICATIONS

Thrust Block 90°

$T = \frac{57.88 \times 42}{100} = 22209$

A $\frac{T = 22209}{Sb\ 16000} = .60\,Ft^2$

Height = .60Ft

Width = 1.20Ft

Flow Test Date Aug 96

Static 72

Residual 42

Flow 2095

8" MAIN

RECORD OF WORK
AS-BUILT

GOLDEN TRIANGLE
FIRE PROTECTION, INC.
SCR #0273
ELWIN E. WISDOM
TABC # 0420

GENERAL NOTES

1. System to be designed and installed in accordance with NFPA 13.
2. All material and equipment installed in system shall be U.L. listed.
3. All threaded fittings are to be cast iron-cast 125.
4. All piping 2 1/2" & larger shall be schedule 10 (unless noted otherwise), joined with roll groove and groove fittings.
5. All piping 2" and smaller shall be schedule 40.
6. All piping is black steel and meets specifications set forth by ATSM as required by NFPA 13, Table 3-1.1.1.
7. All hangers and components shall be ferrous.
8. All hangers and components shall be U.L. listed and shall conform to all requirements set forth by NFPA 13, section 3-10.
9. All electrical installations are to be performed by others.
10. See title block for system design data, flow test data and occupation classification.

WALL THICKNESS OF THIN WALL PIPE	REVIEWING AGENCY	SYSTEM		GENERAL NOTES
1" thru 2" = .109		WET ☑		CONTROL ELEVATION
2½" thru 4" = .120		DRY ☐		
5" and 6" = .134	OWNER OCCUPANT	DELUGE ☐	BTOS	BELOW TOP OF STEEL
8" and 10" = .188	THE HOH COMPANY	PREACTION ☐	AFF	ABOVE FINISHED FLOOR
	8235 Douglas Ave	FOAM ☐		CONTROL DIMENSIONS
	DALLAS TX 75225	COMBINATION ☐		SPRINKLER PIPING DIMENSIONS SHOWN ARE TO
		☐		
		☐		

STANDARD SYMBOLS	DESIGN CRITERIA	SPRINKLER HEADS						
	OCCUPANCY:	SYMBOL	TYPE	OR	K	TEMP.	QUAN	
UPRIGHT	HAZARD:							
	CLASS:							
PENDANT	DENSITY:							
UPRIGHT OR 1" BRNG UP	CALCULATED AREA:							
PENDANT OR 1" DROP	AREA PER SPRINKLER							
SPRINKLER GUARD	STORAGE HEIGHT:							
SIDEWALL SPRINKLERS	NOTES:		TOTAL HEADS THIS SHEET					
VALVE GENERAL			TOTAL HEADS FOR PROJECT					
FLGD CHECK VALVE	GOLDEN TRIANGLE FIRE PROTECTION, INC. P.O. Box 33838 Denton, Texas 76206 Metro 294-434-1998	PROJECT: EAGLE TRANSMISSIONS 16230 MIDWAY RD ADDISON TEXAS						
WAFER CHECK VALVE		JOB NO:	DESIGNER		SYS. NO. 1			
SPRINKLER RISER		DATE: 6-12-97	SN		SHEET NUMBER 1 of 2			
		SCALE: NO						

B-8-11

FIRE SERVICE
16230 MIDWAY
EAGLE TRANSMISSION