


B.M. #4 On Conc. Walk At S.E. Corner Of Bldg At 15301 Midway Rd. Elev. 621.43

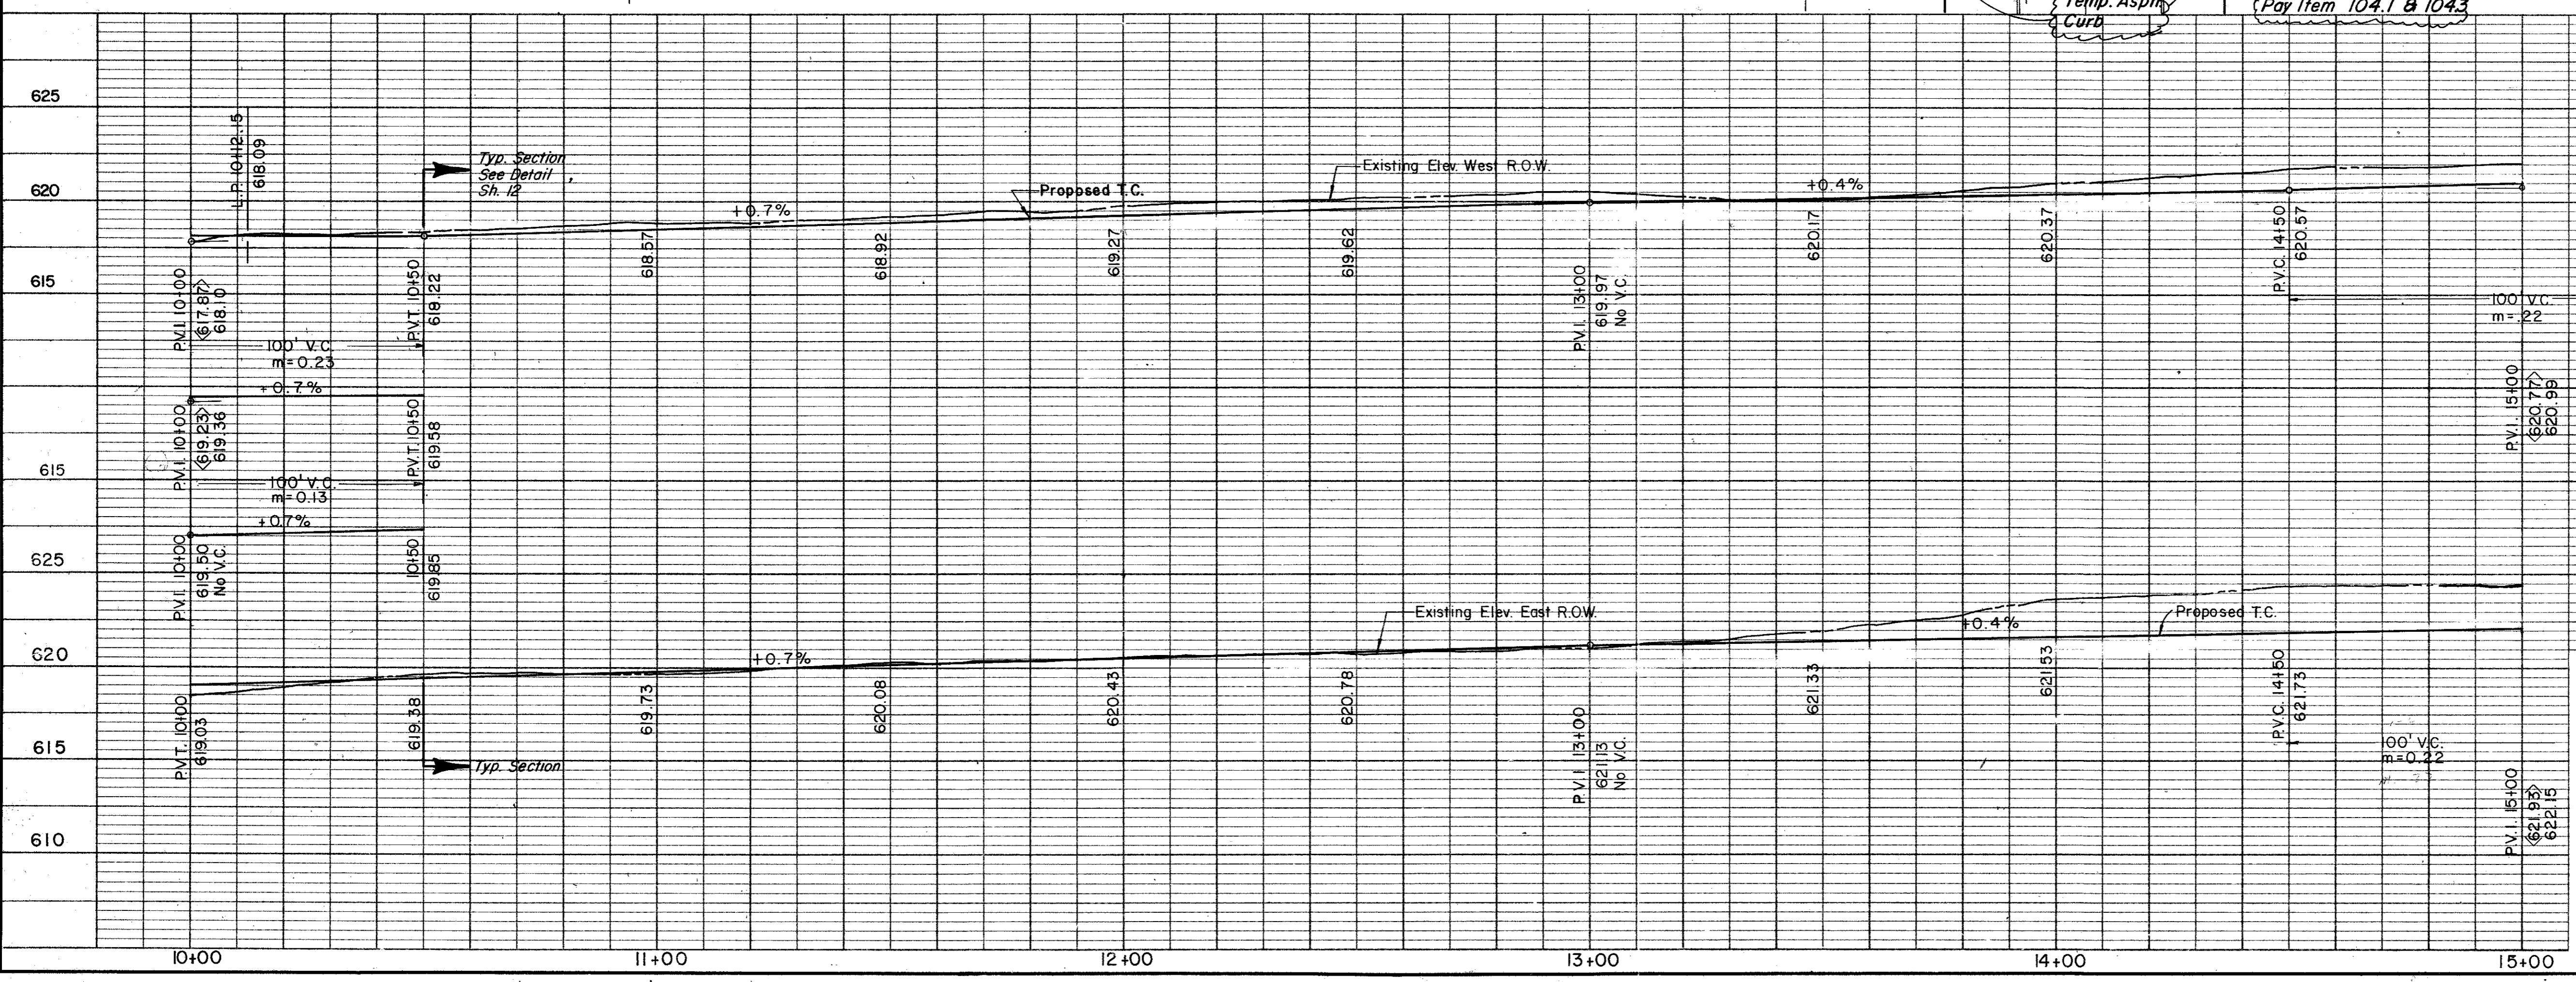

CITY OF ADDISON			
PAVING			
Paving Sta. 10+00 to Sta. 15+00			
MIDWAY ROAD IMPROVEMENTS			
GINN, INC., Consulting Engineers			
DESIGNED - HBJ	DRAWN - SM - GF	DATE - MARCH, 1981	FILE
APPROVED - HWG	CHECKED - HBJ	SCALE - 1" = 20' H, 1" = 5' V	SHEET 6 OF