

CITY OF ADDISON DALLAS COUNTY, TEXAS

CONSTRUCTION PLANS FOR: MIDWAY ROAD

FROM BELT LINE ROAD TO WRIGHT BROTHERS DRIVE
AND DITCH IMPROVEMENTS
FROM MIDWAY ROAD TO SURVEYOR BOULEVARD

PROJECT LENGTH ± 3,548 L.F. (PAVING)
± 2,466 L.F. (DITCH)

CITY OF CARROLLTON

LEDDIE TAYLOR - MAYOR


COUNCIL MEMBERS:
CAROLYN STANDRIDGE
DAVE GILMORE
RICHARD WALKER
PAT ARNOLD
SANDY JACOBS

CLONIS LUALLEN - CITY MANAGER
JIM JENNE - DIRECTOR of COMMUNITY
DEVELOPMENT

CITY OF ADDISON

JERRY J. REDDING - MAYOR
COUNCIL MEMBERS:

JOHN B. ALLEN
RICHARD RODER
WILLIAM F. SELLMAYER
BARVO WALKER
TERRY ROBERTS
G.J. WEBSTER - CITY ADMINISTRATOR
GEORGE DOWLING, P.E. - DIRECTOR of COMMUNITY
DEVELOPMENT

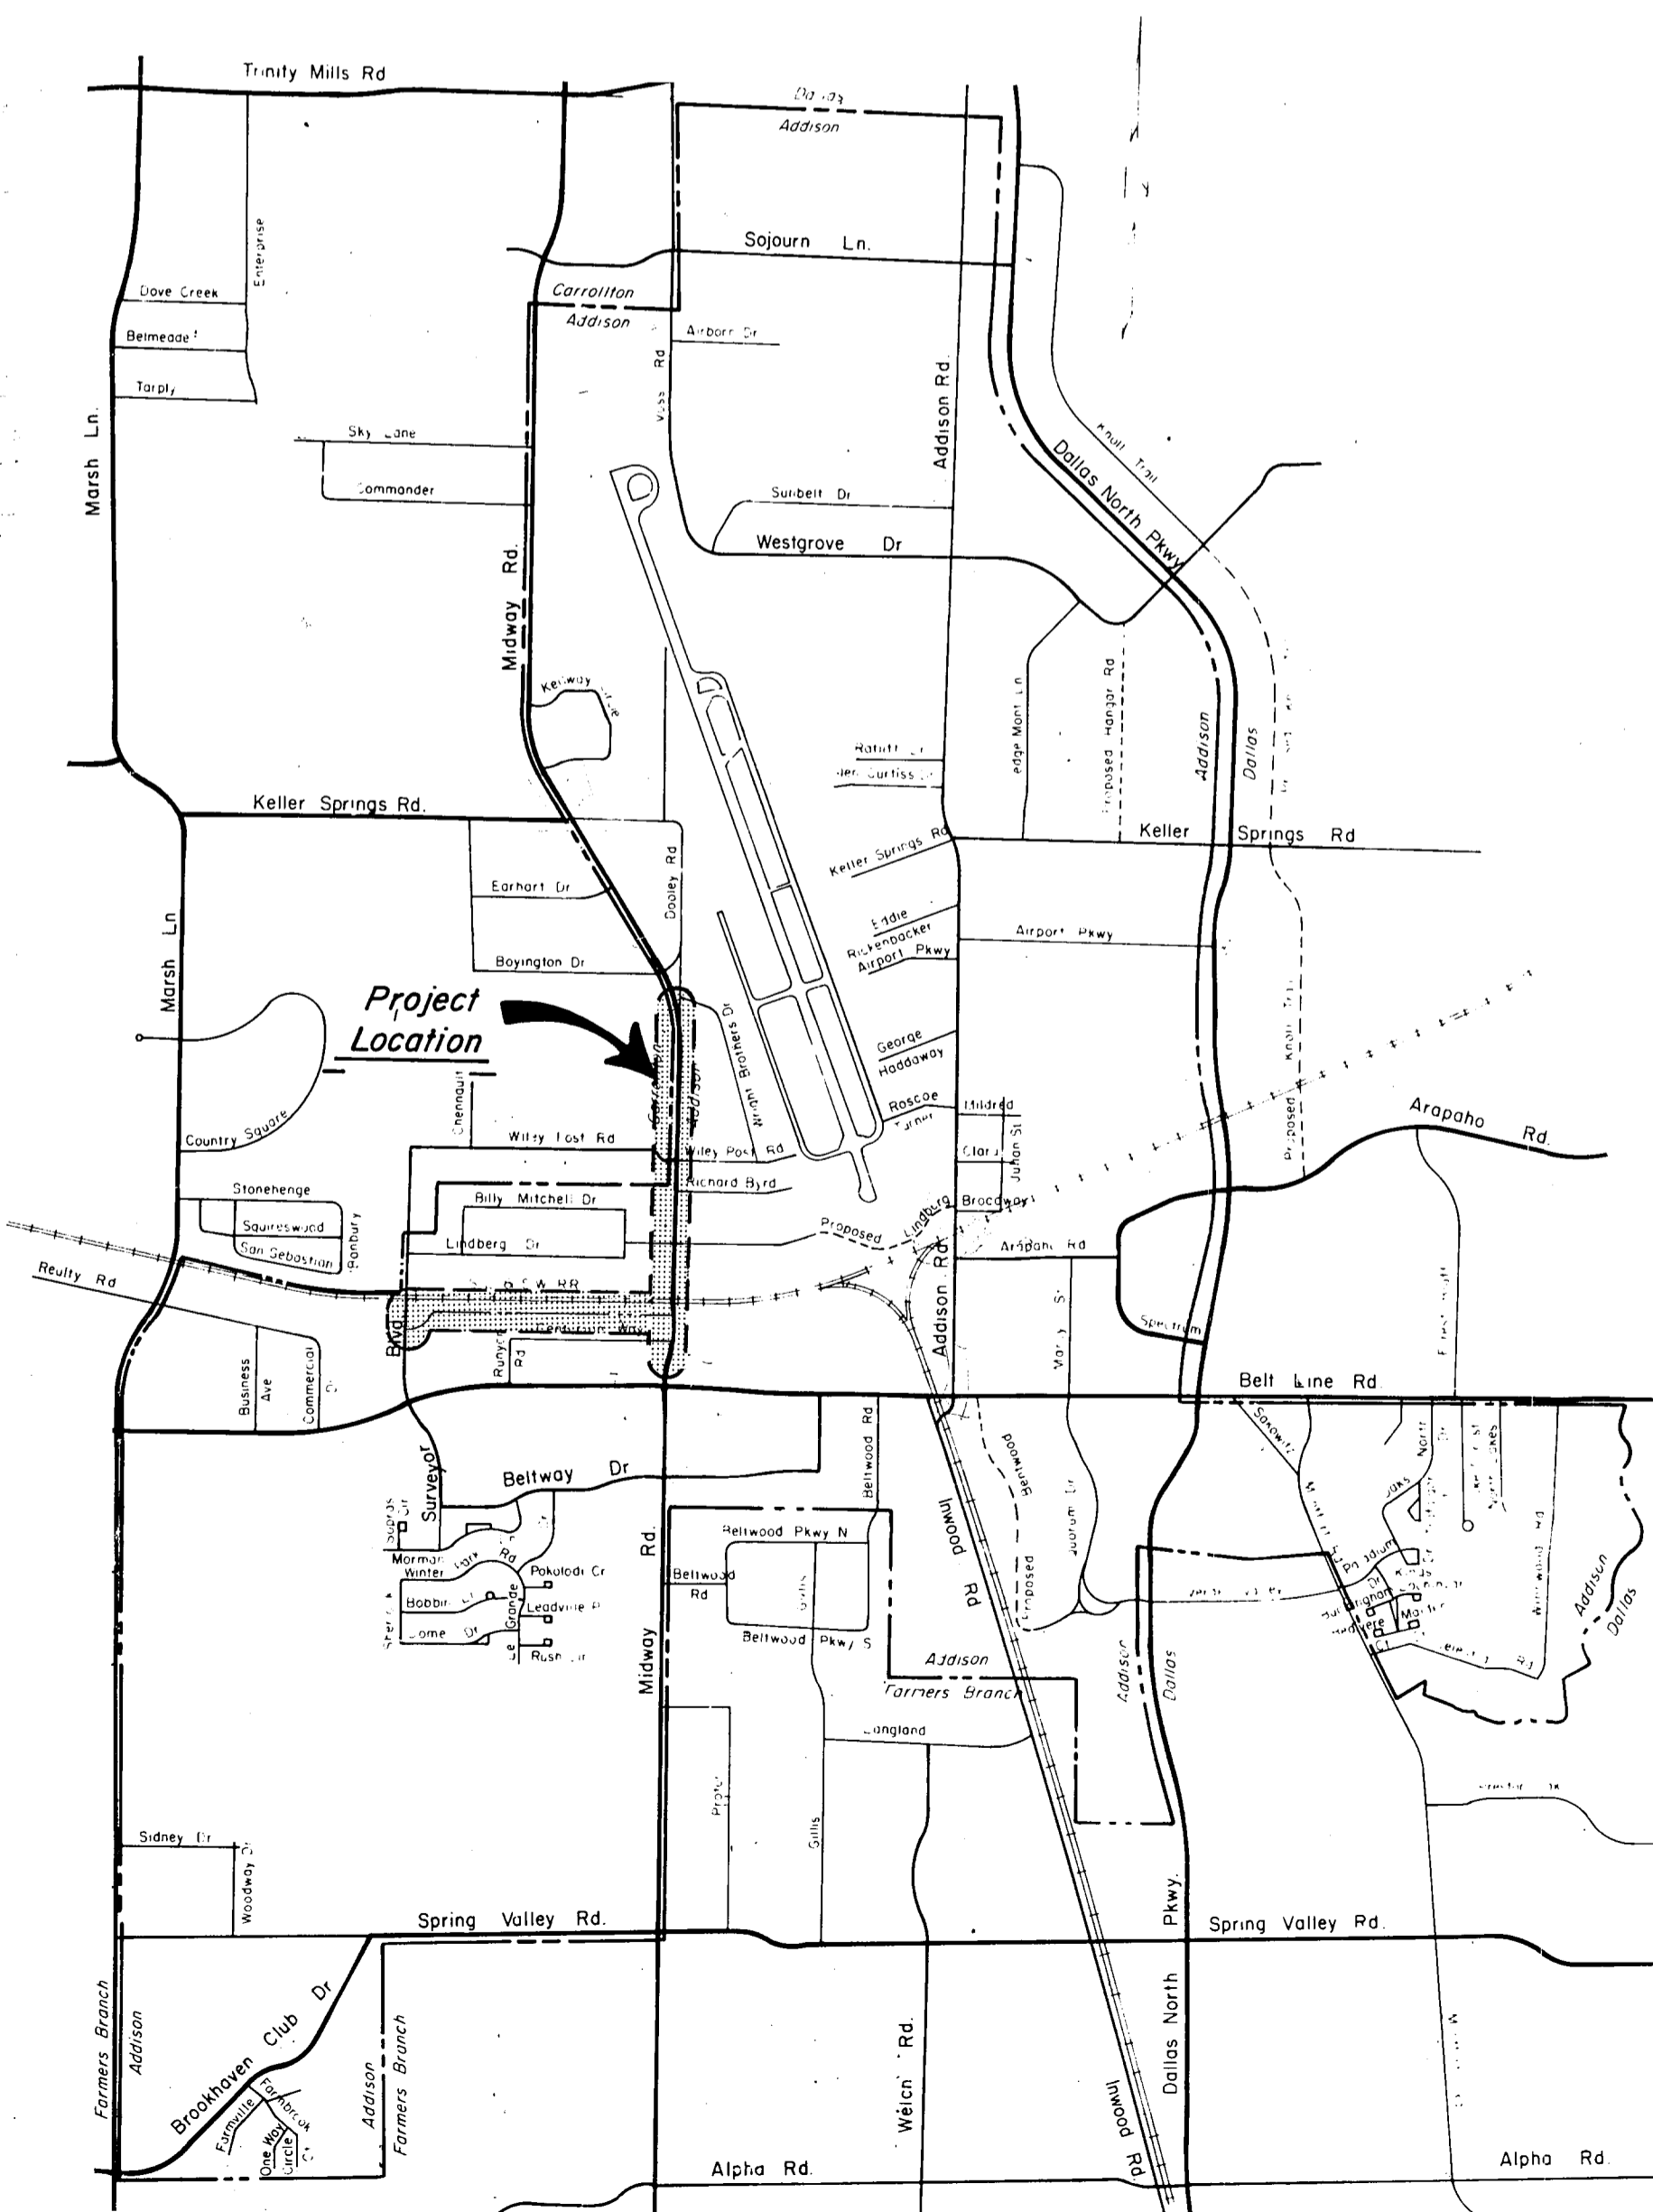

CITY OF CARROLLTON

Approved By: *[Signature]*
City Manager

Date: 3-6-81



CITY OF ADDISON

Approved By: *[Signature]*
Mayor

Date: 3-6-81




GINN INC.
CONSULTING ENGINEERS
DALLAS, TEXAS

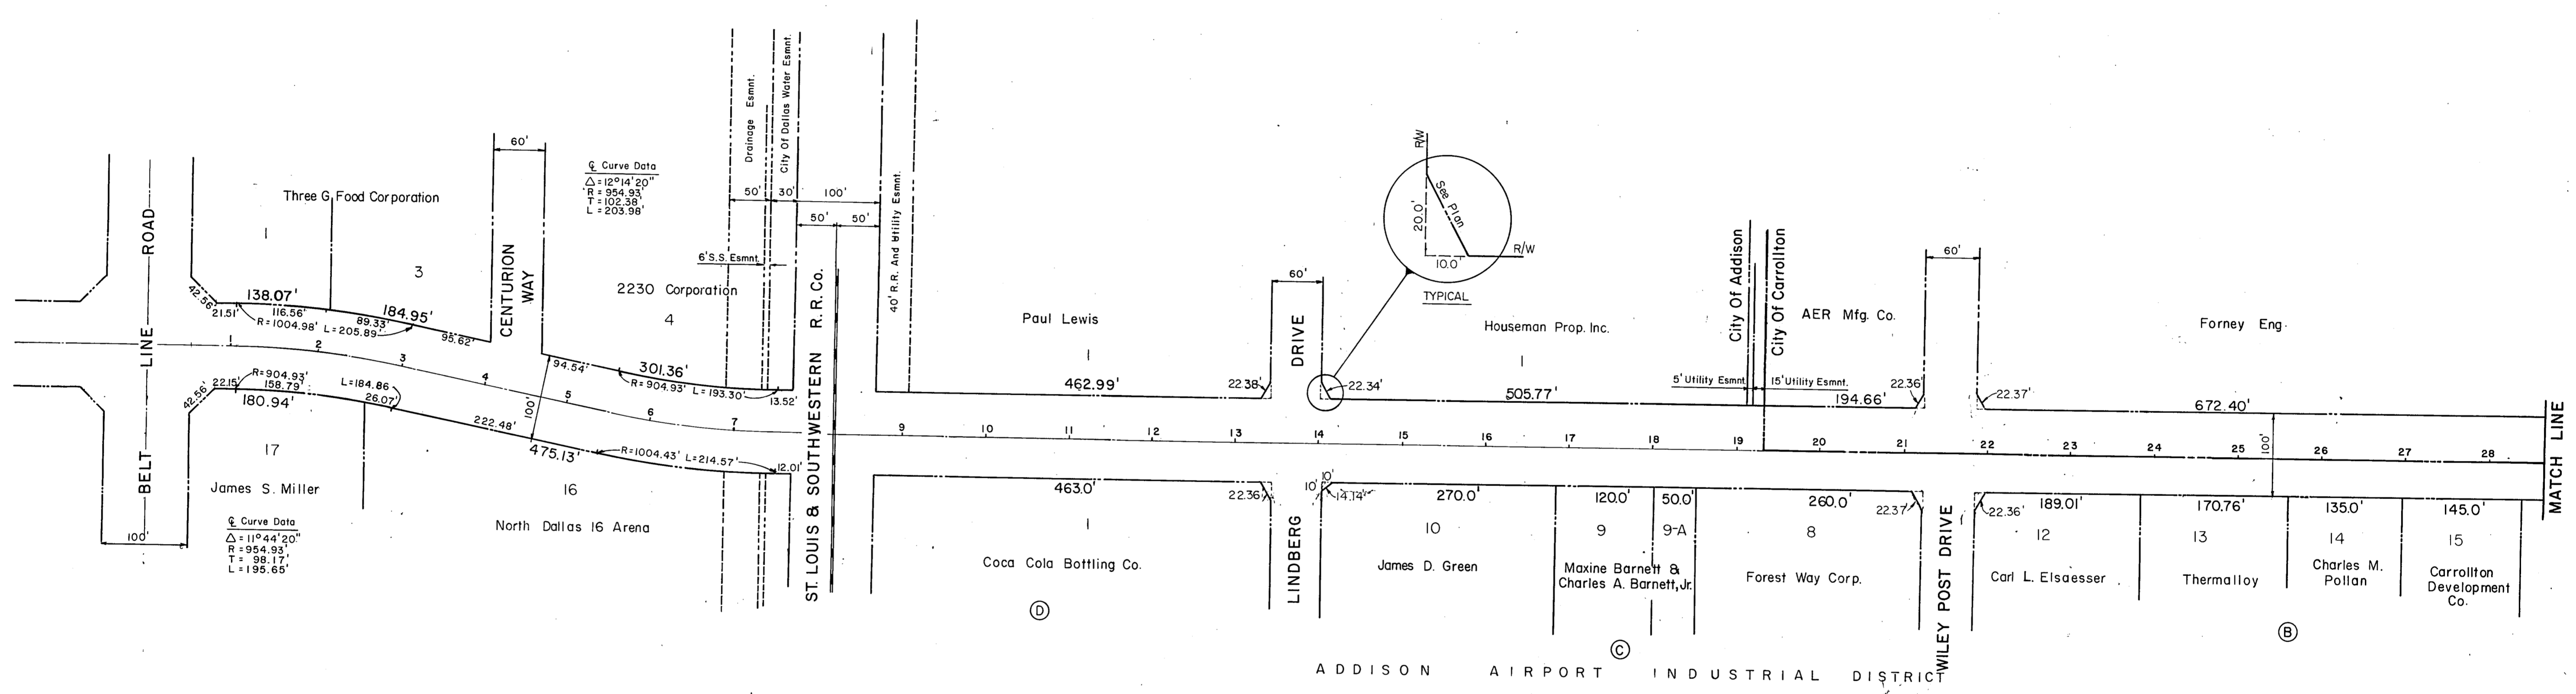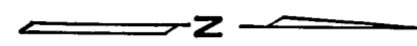

Curve Data
 $\Delta = 12^{\circ}14'20''$
 $R = 954.93'$
 $T = 102.36'$
 $L = 203.98'$

Curve Data
 $\Delta = 11^{\circ}44'20''$
 $R = 954.93'$
 $T = 98.17'$
 $L = 195.65'$

Curve Data
 $\Delta = 33^{\circ}17'00''$
 $R = 940.0'$
 $T = 280.97'$
 $L = 546.05'$

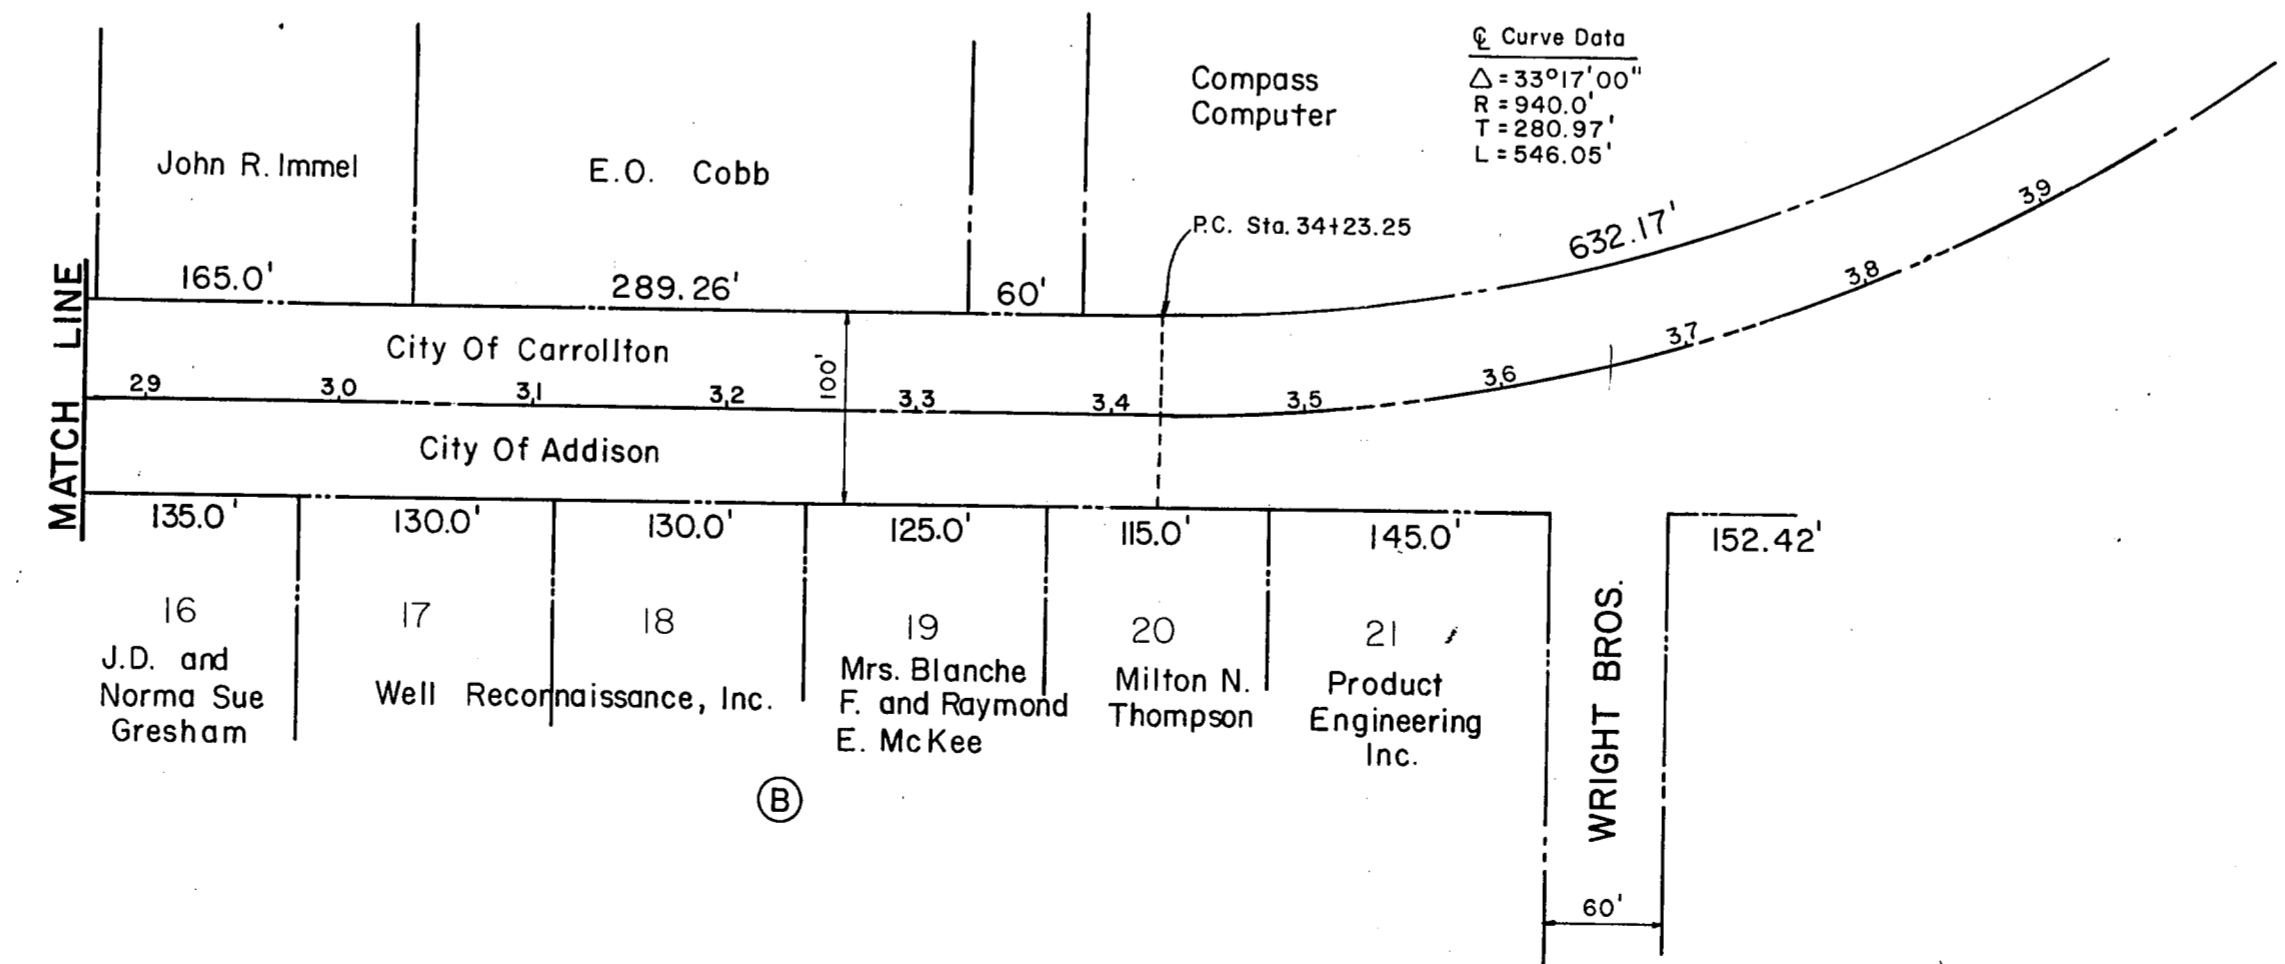


Lewisville ES&I

City of Addison
MIDWAY ROAD
IMPROVEMENTS

RIGHT OF WAY MAP

SUMMARY CONSTRUCTION SEQUENCE
 (See Special Conditions 22 of Specifications for additional details)





1. Construct Detour A & B.
2. Construct 9'x5' box culvert and Detour C. This will also involve lowering of 16" water main and sanitary sewer relocation.
3. Construct storm sewer system on west side of centerline.
4. Excavate, lime and pave west 34-ft. section of roadway.
5. Switch the traffic to the new paving.
6. Construct the storm sewer system on the east side of centerline.
7. Excavate, lime and pave the east 34-ft. section of roadway.
8. Split the traffic and construct the median and left-turn lanes.
9. Complete remainder of the project as shown.
10. Drainage ditch improvement can commence at any time.

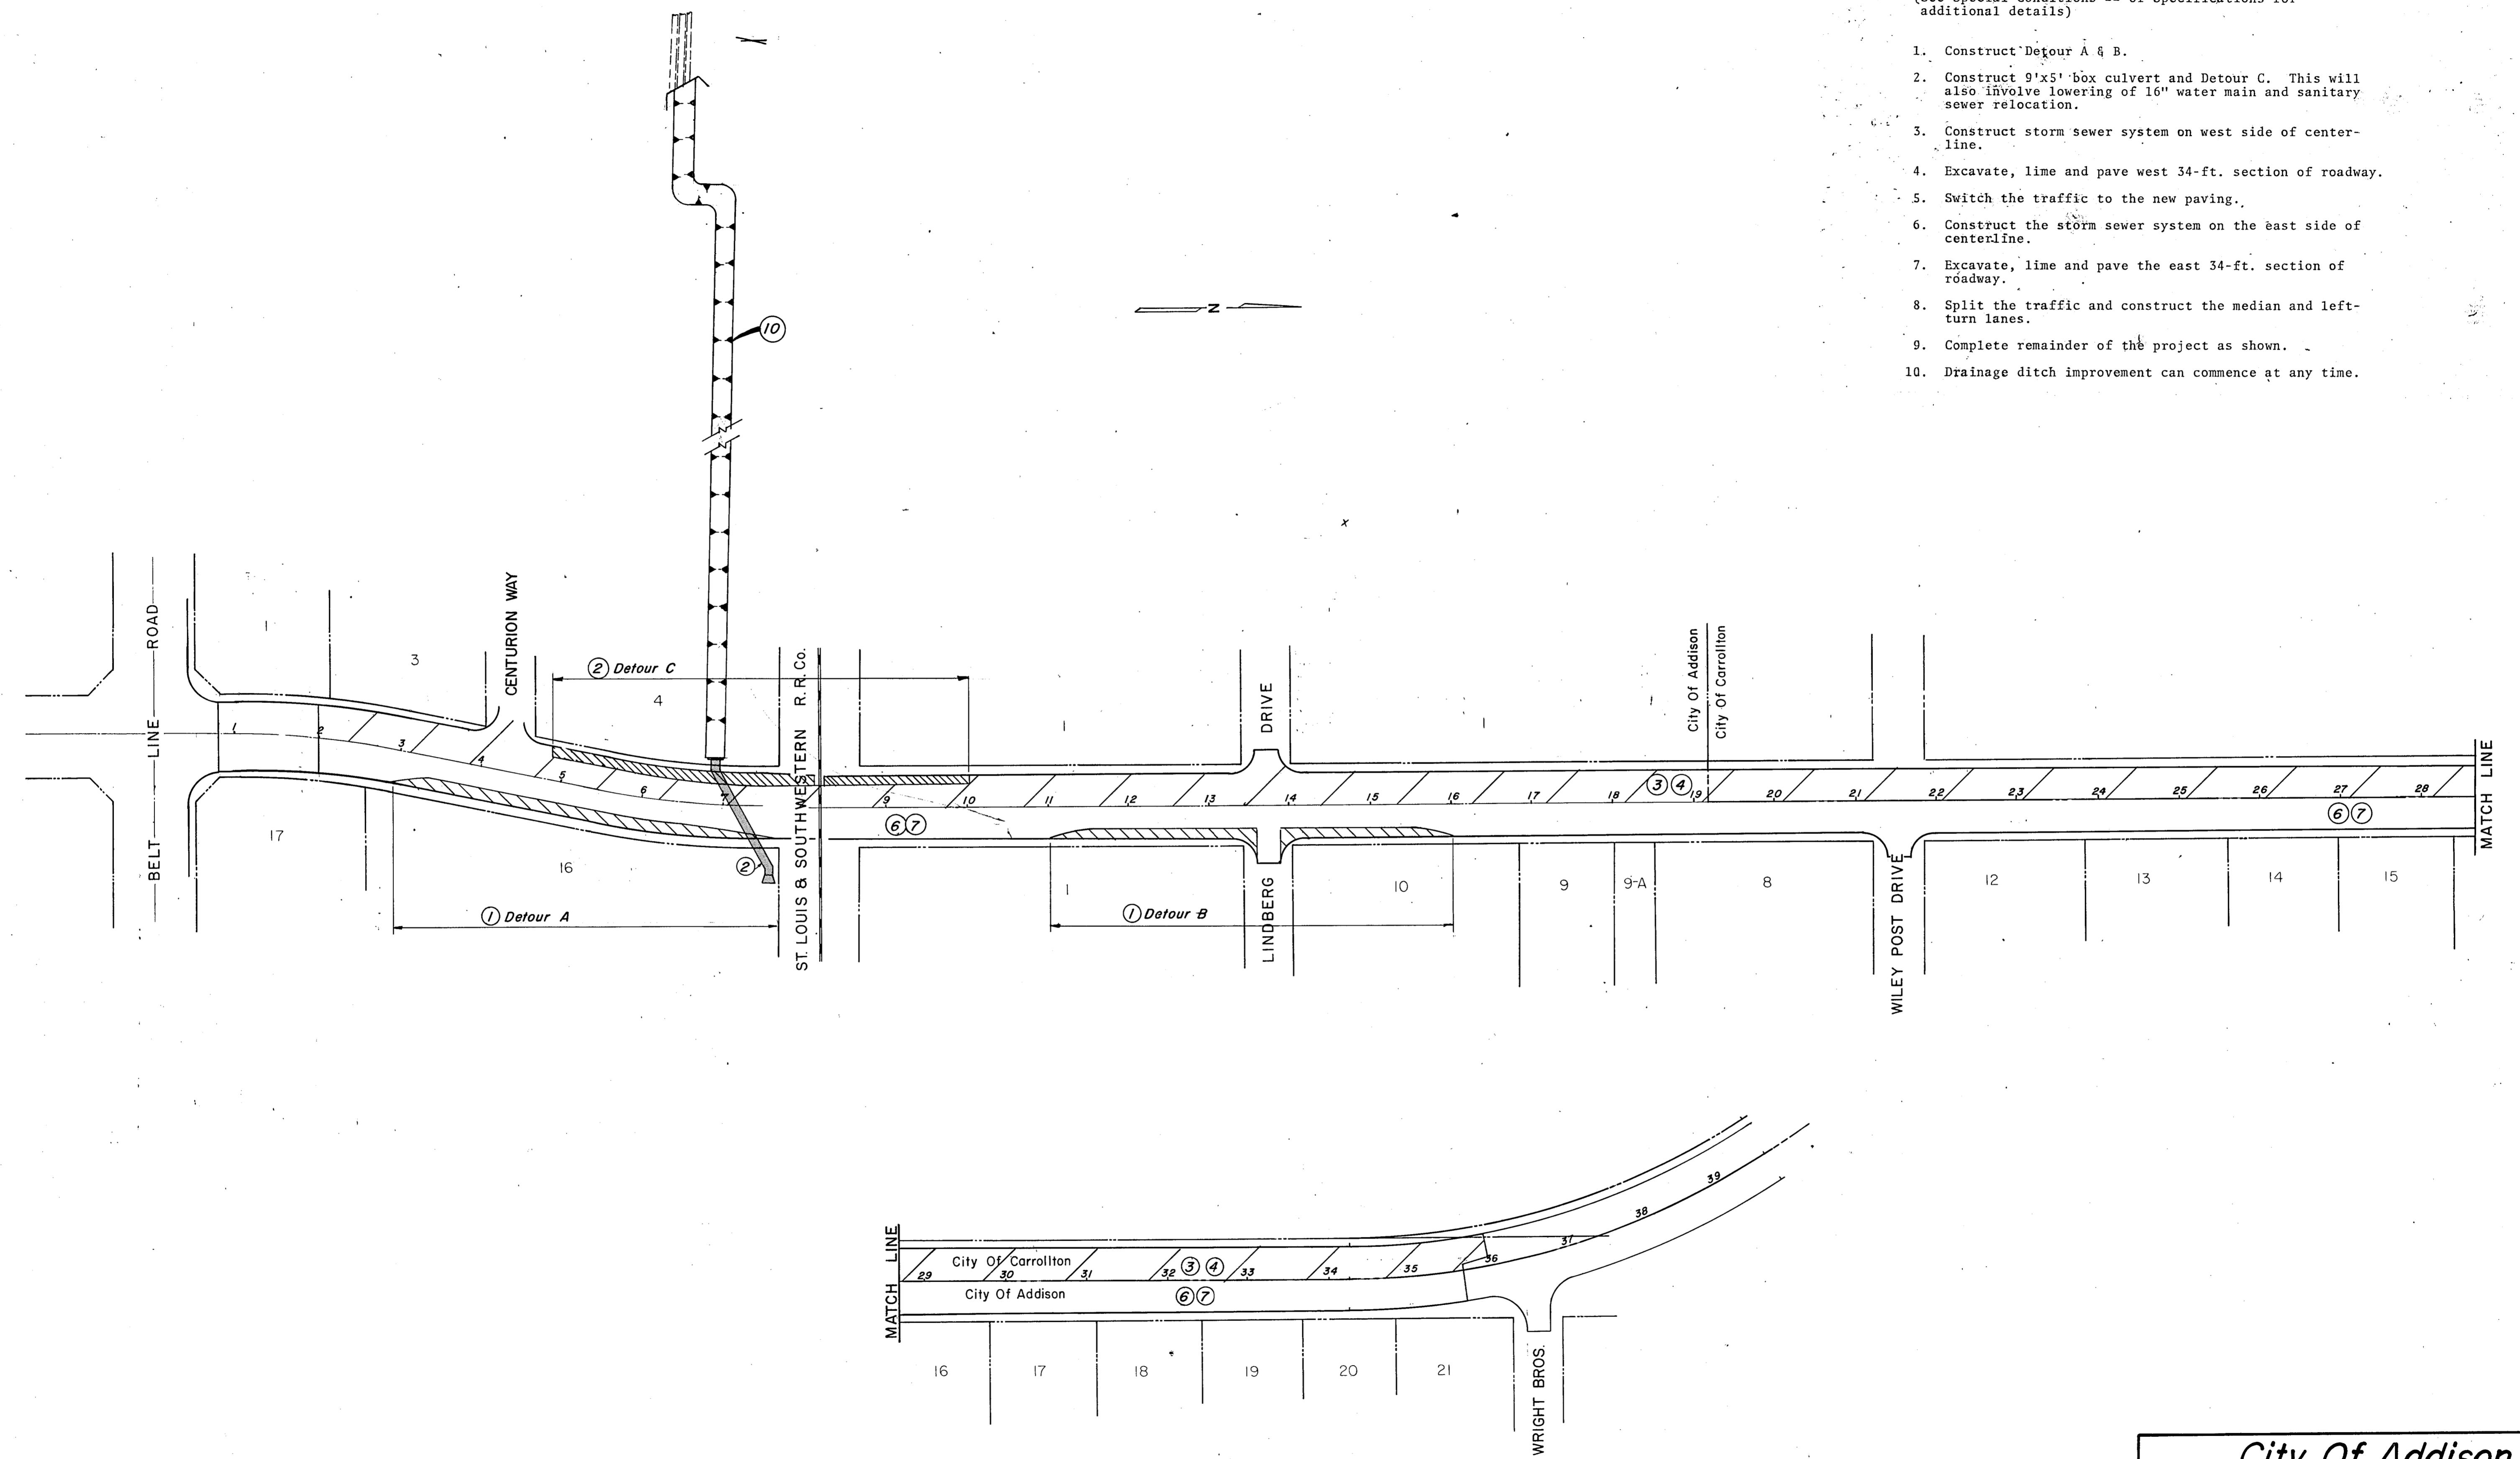



City Of Addison
**MIDWAY ROAD
 IMPROVEMENTS**

CONSTRUCTION SEQUENCE

DESIGNED H.B.J.	DRAWN R.G.B.	DATE MARCH, 1981	FILE
APPROVED H.W.G.	CHECKED A.G.F.	SCALE 1" = 100'	SHEET 3A OF

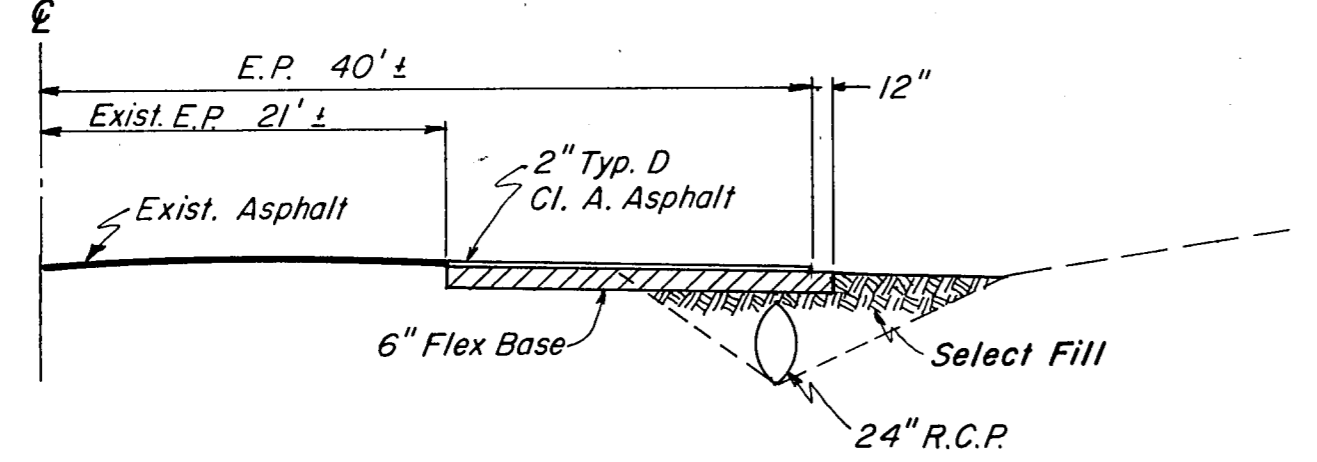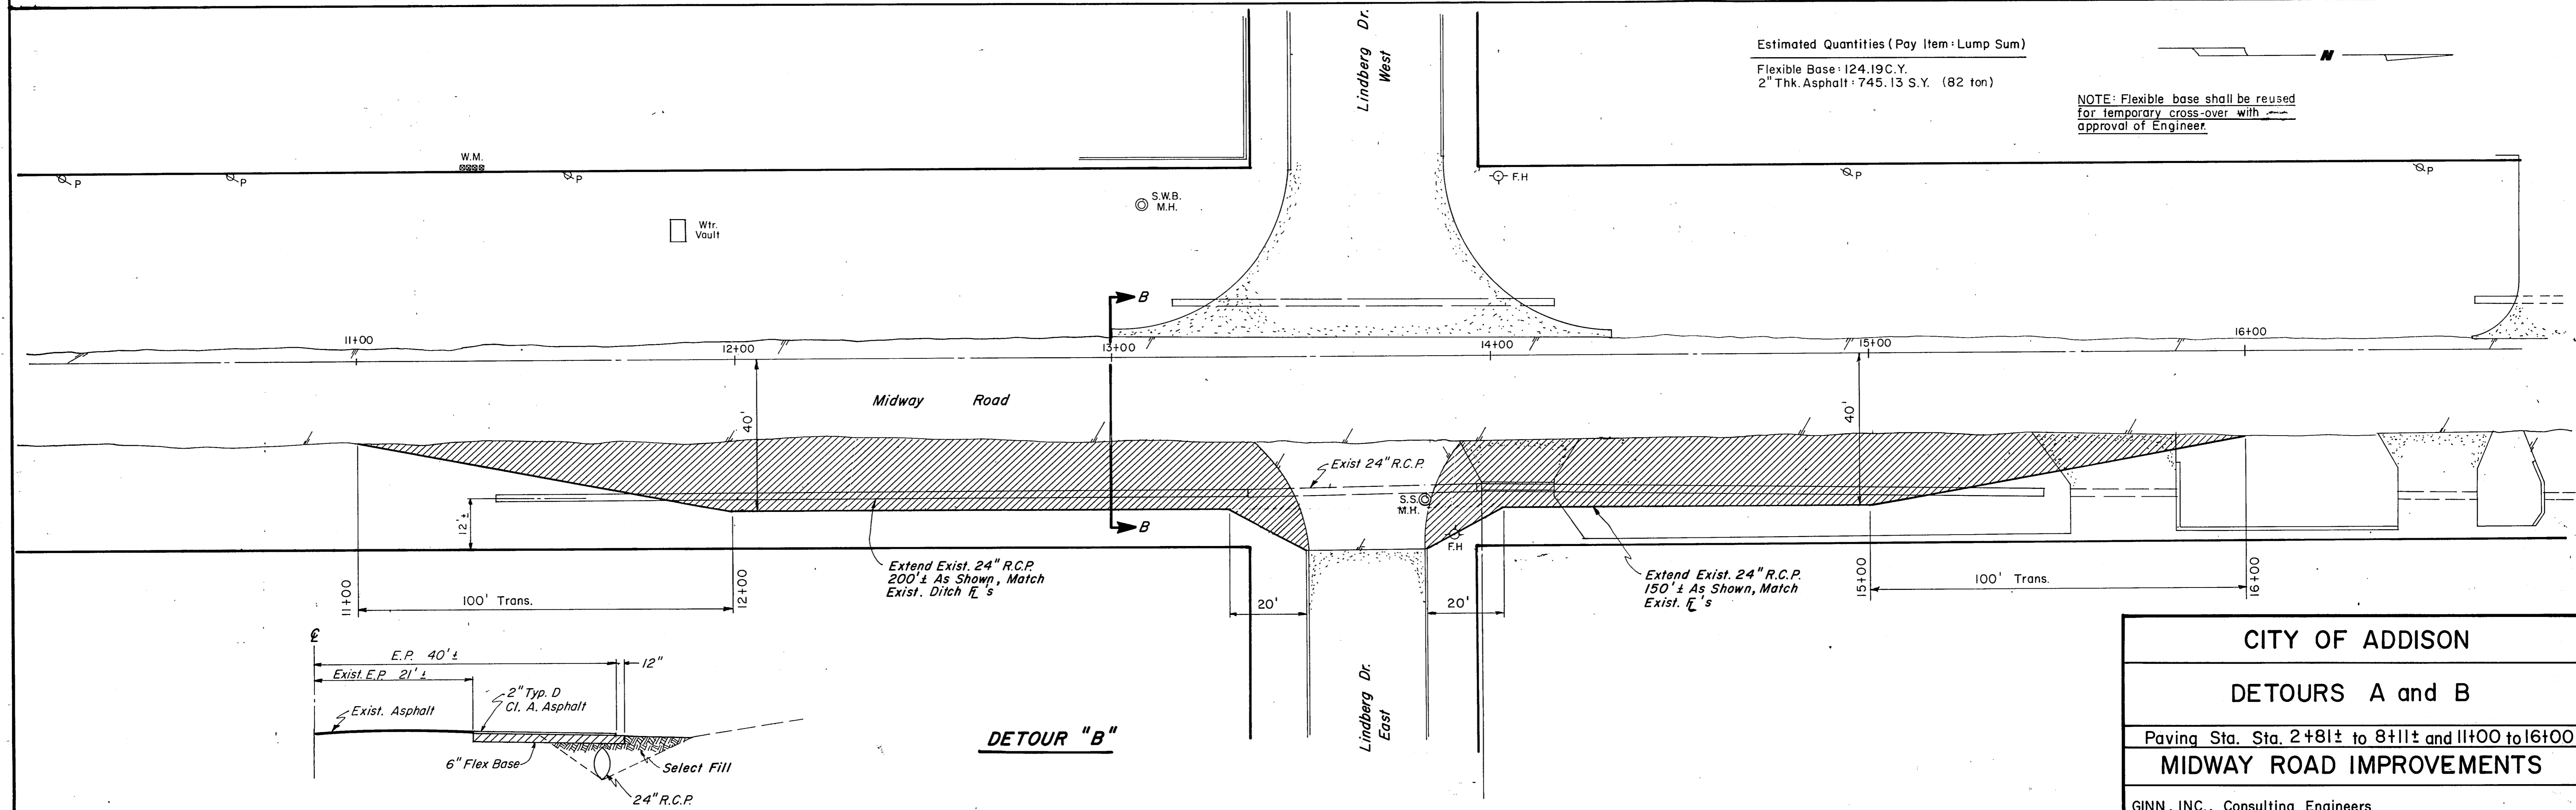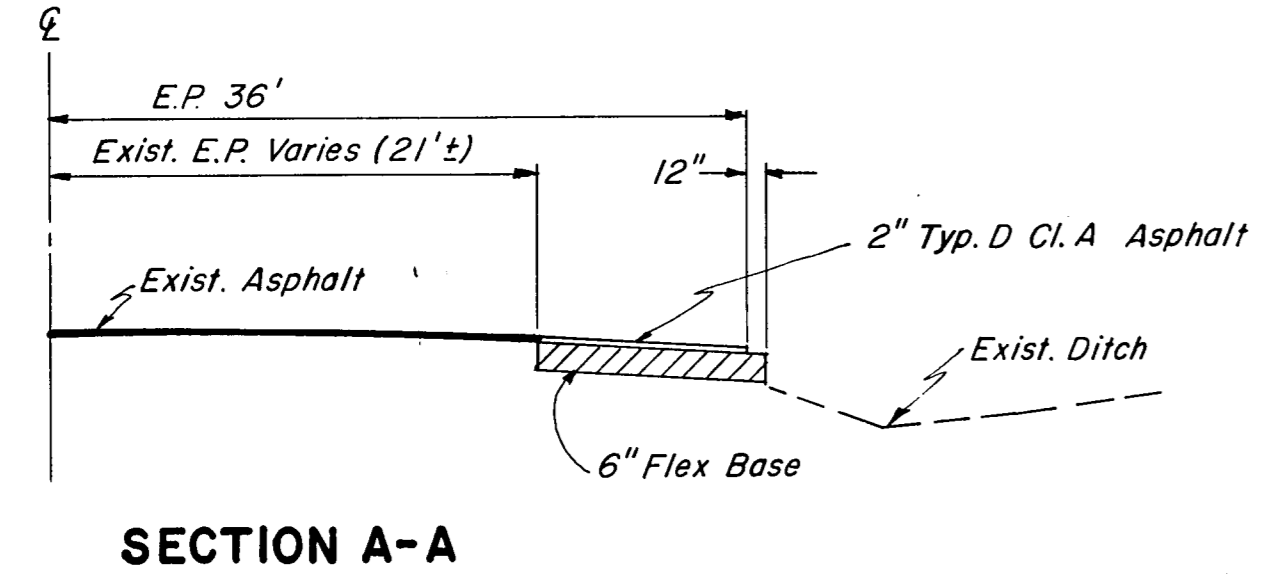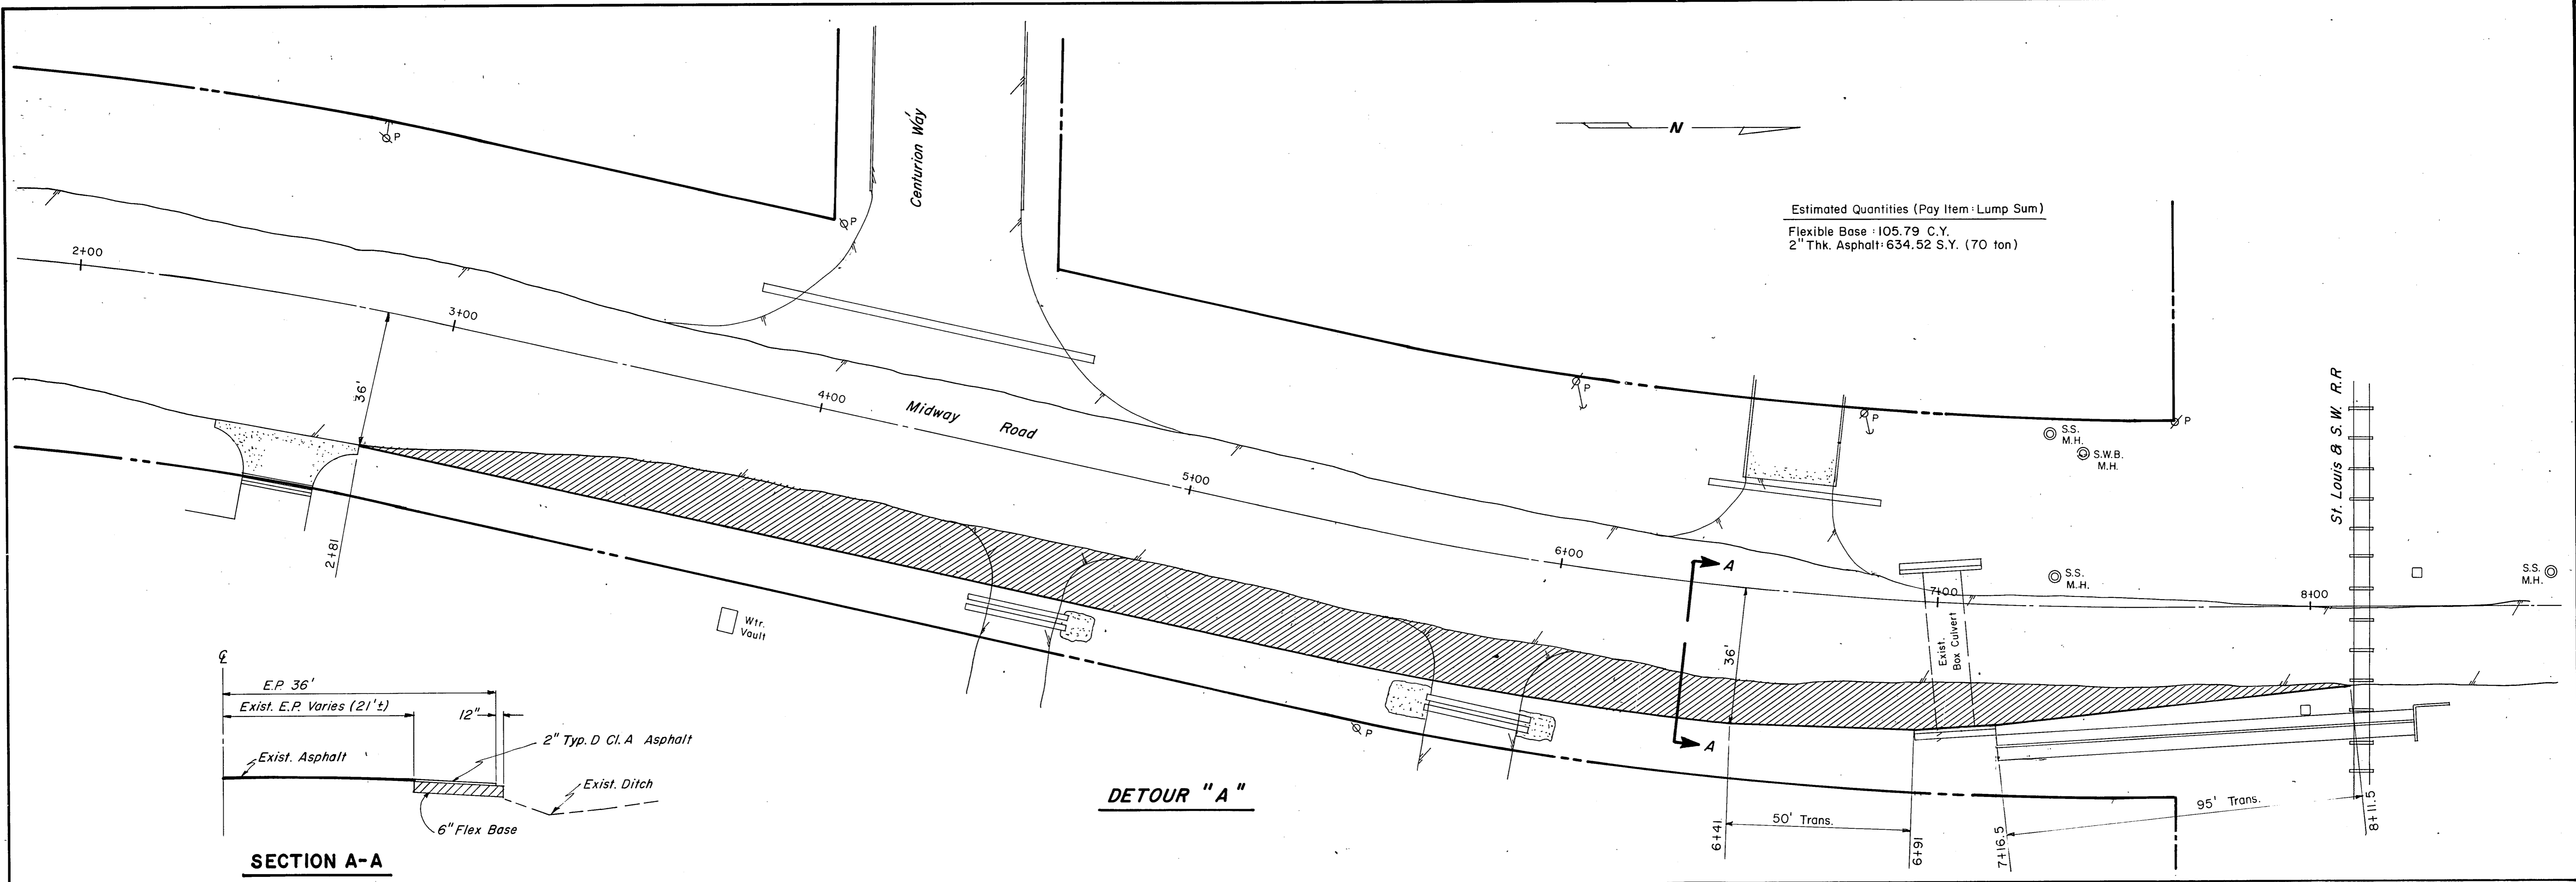

CITY OF ADDISON			
DETOURS A and B			
Paving Sta. Sta. 2+81± to 8+11± and 11+00 to 16+00			
MIDWAY ROAD IMPROVEMENTS			
GINN, INC., Consulting Engineers			
DESIGNED-H.B.J.	DRAWN-S.M.M.	DATE MARCH, 1981	
APPROVED-H.W.G.	CHECK-C.F.	SCALE 1" = 20'	SHEET 3B OF

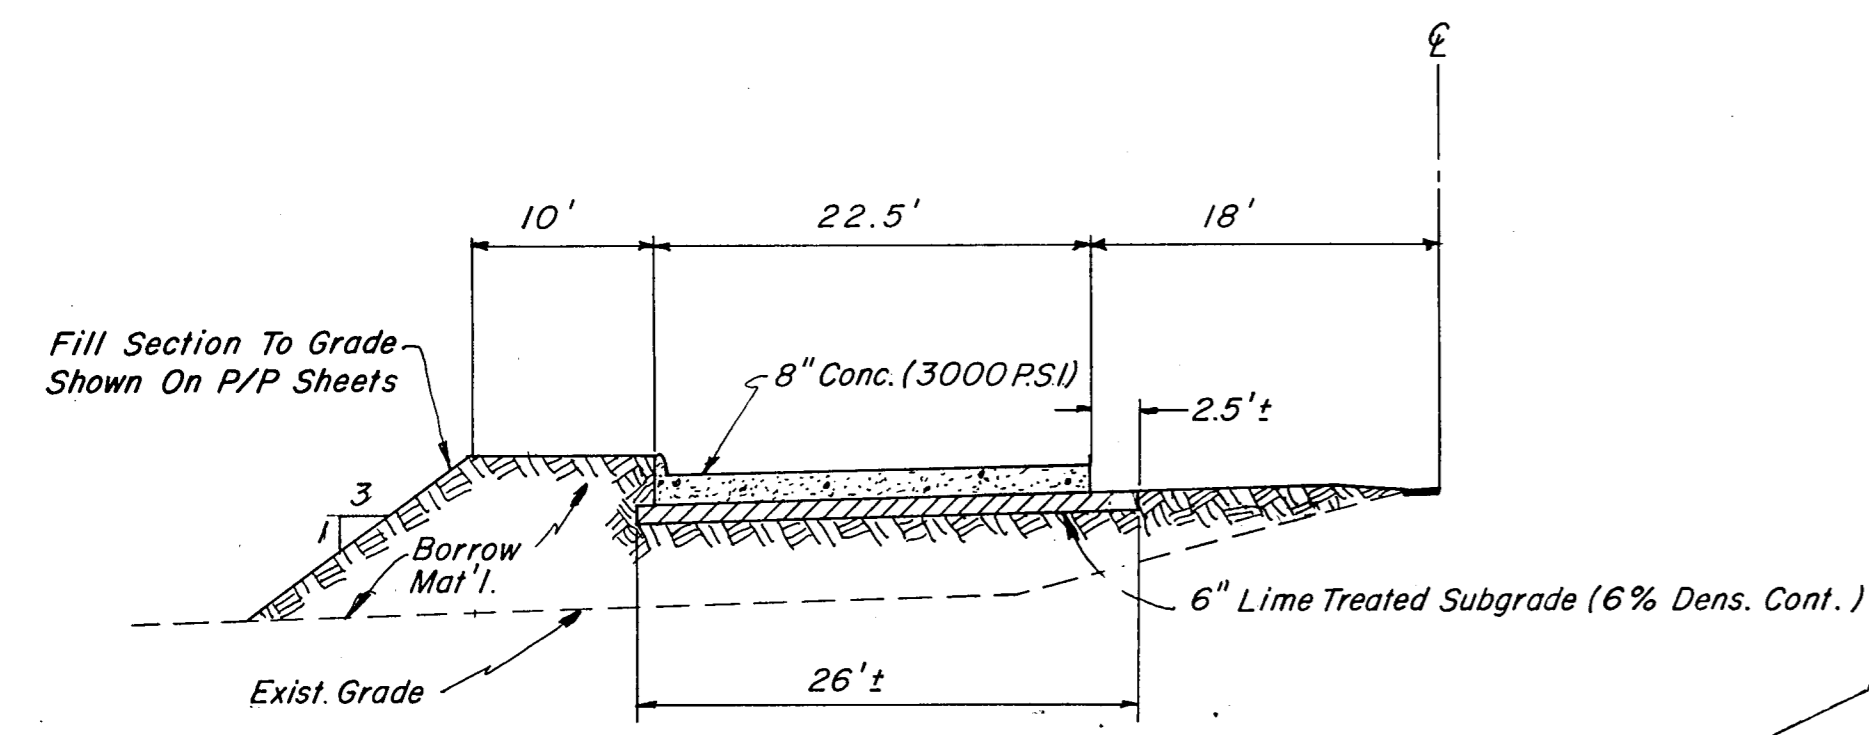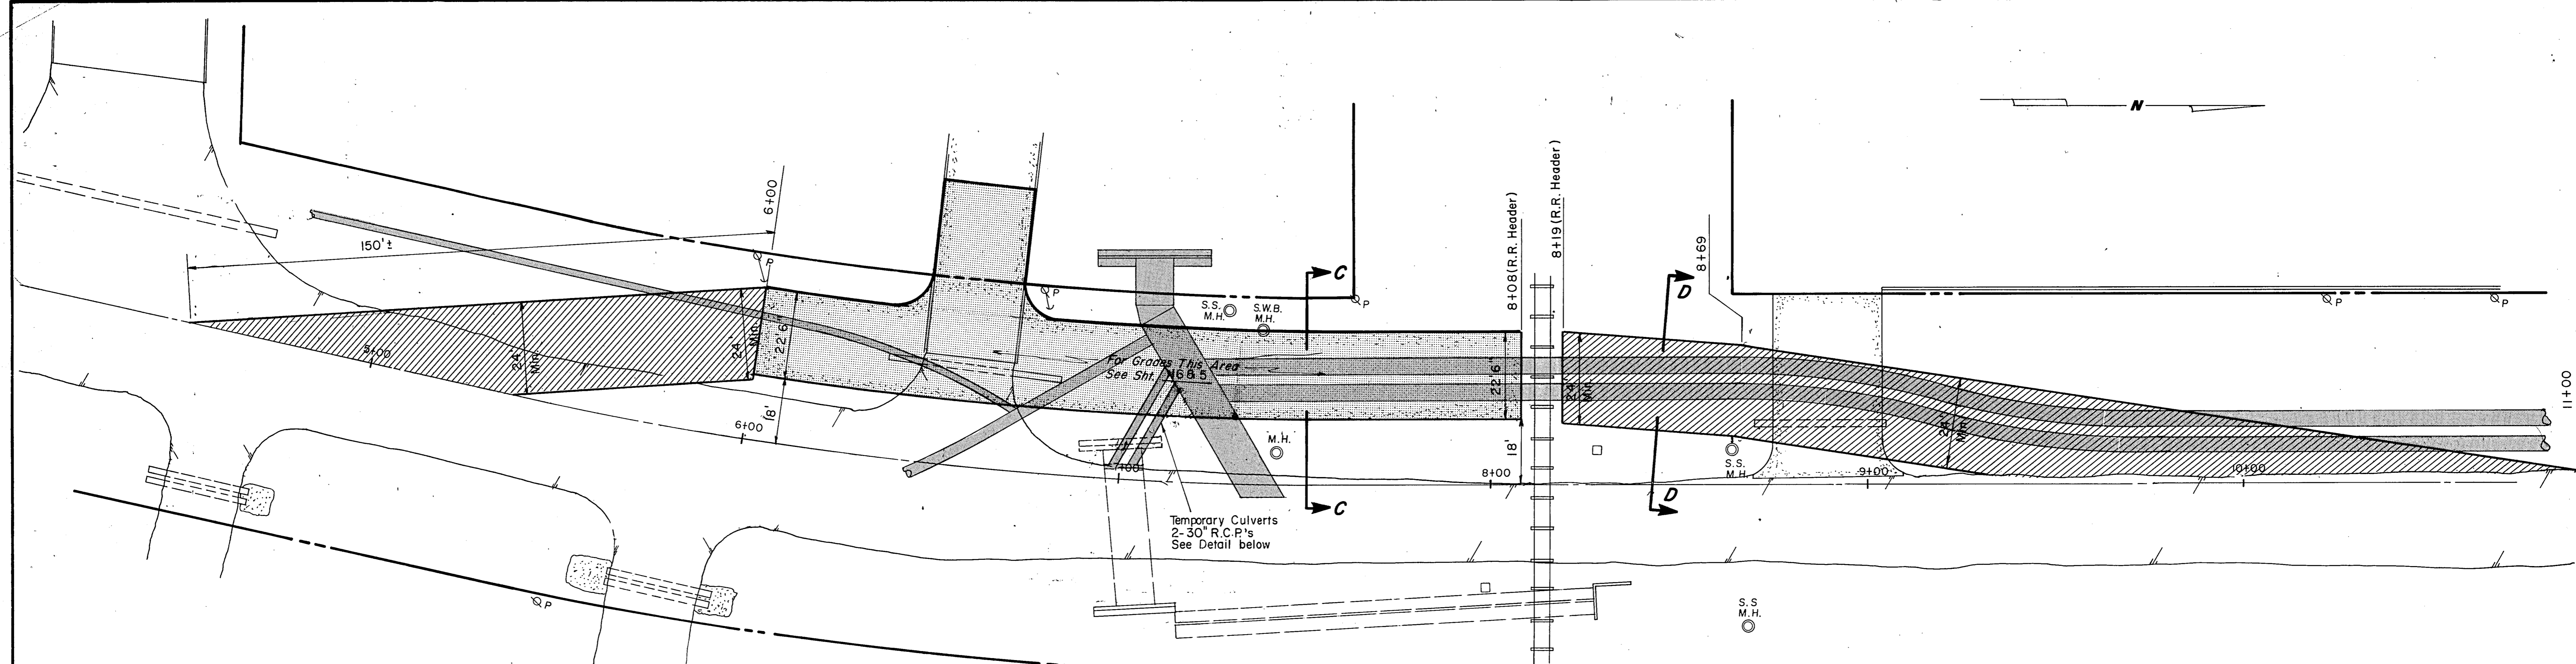


SECTION "C-C"

DETOUR C
Scale: 1"=20'

Estimated Quantities
Flexible Base : 135.78 C.Y.
2" Thk. Asphalt : 814.67 S.Y. (90 tons)


NOTE: The Flexible Base And Asphalt Will Be Paid For As Separate Items As Shown, The 8" Conc. Pvm't, Borrow, Box Culvert, And Other Items Are Shown As Pay Items Elsewhere In Plans.

The flexible base shall be reused for temporary cross over with approval of Engineer.

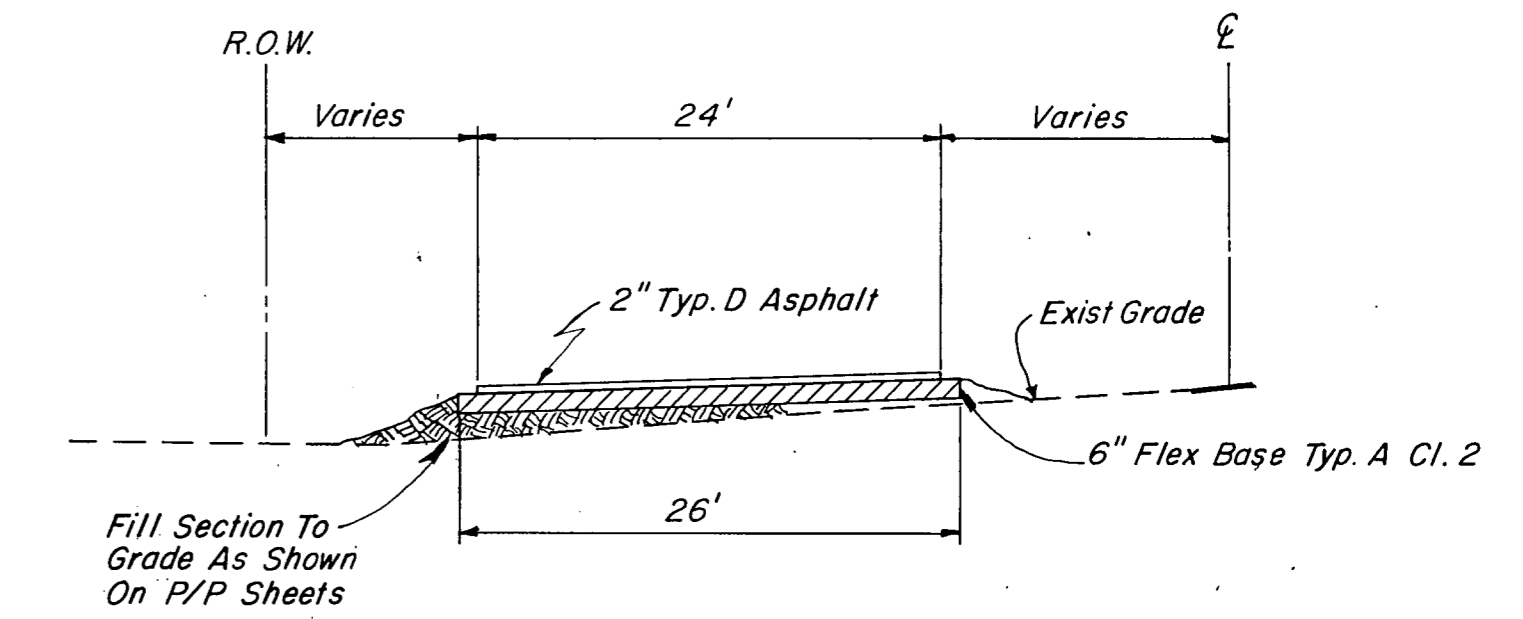


SECTION "D-D"

NOTE: After temporary culvert is not required, Contractor shall cut and plug 30" R.C.P.'s as directed by Engineer.

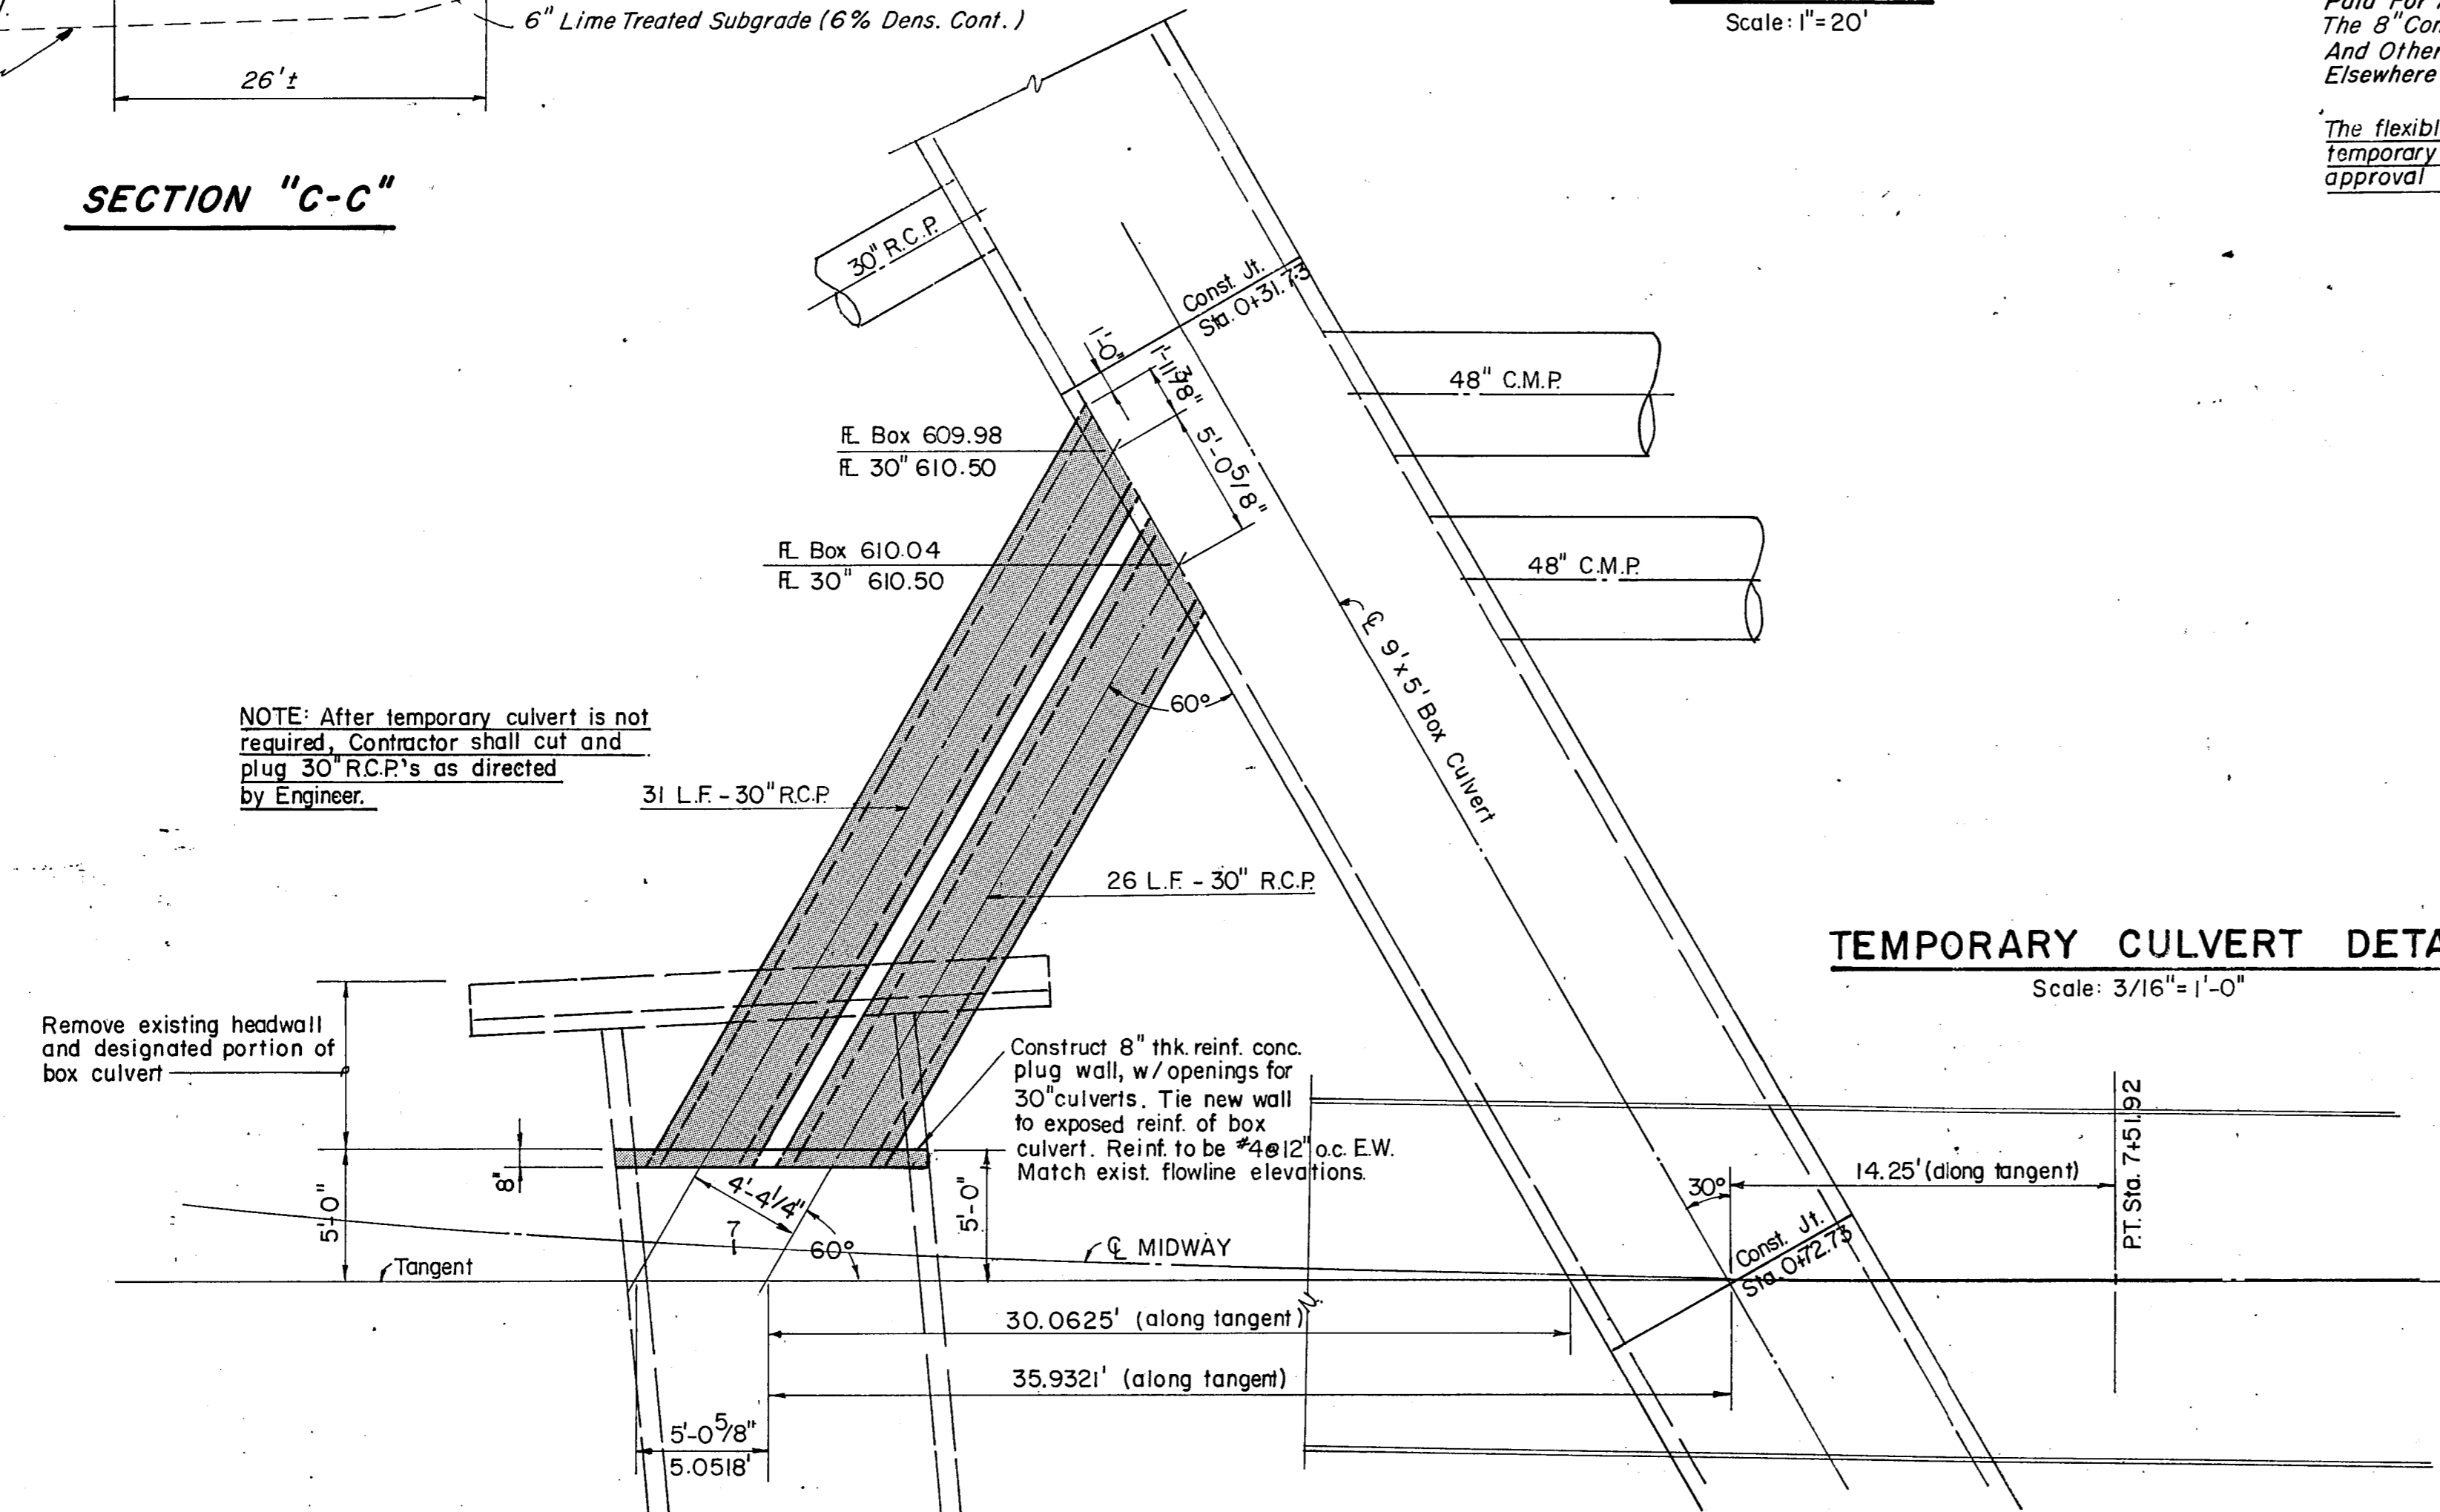


TEMPORARY CULVERT DETAIL
Scale: 3/16"=1'-0"

CITY OF ADDISON			
DETOUR C			
Paving Sta. 8+50± to 11+00			
MIDWAY ROAD IMPROVEMENTS			
GINN, INC., Consulting Engineers			
DESIGNED-H.B.J.	DRAWN-S.M.M.	DATE MARCH, 1981	
APP'D - H.W.G.	CHECK - C.F.	SCALE: 1"= 20'	SHEET 3 C OF

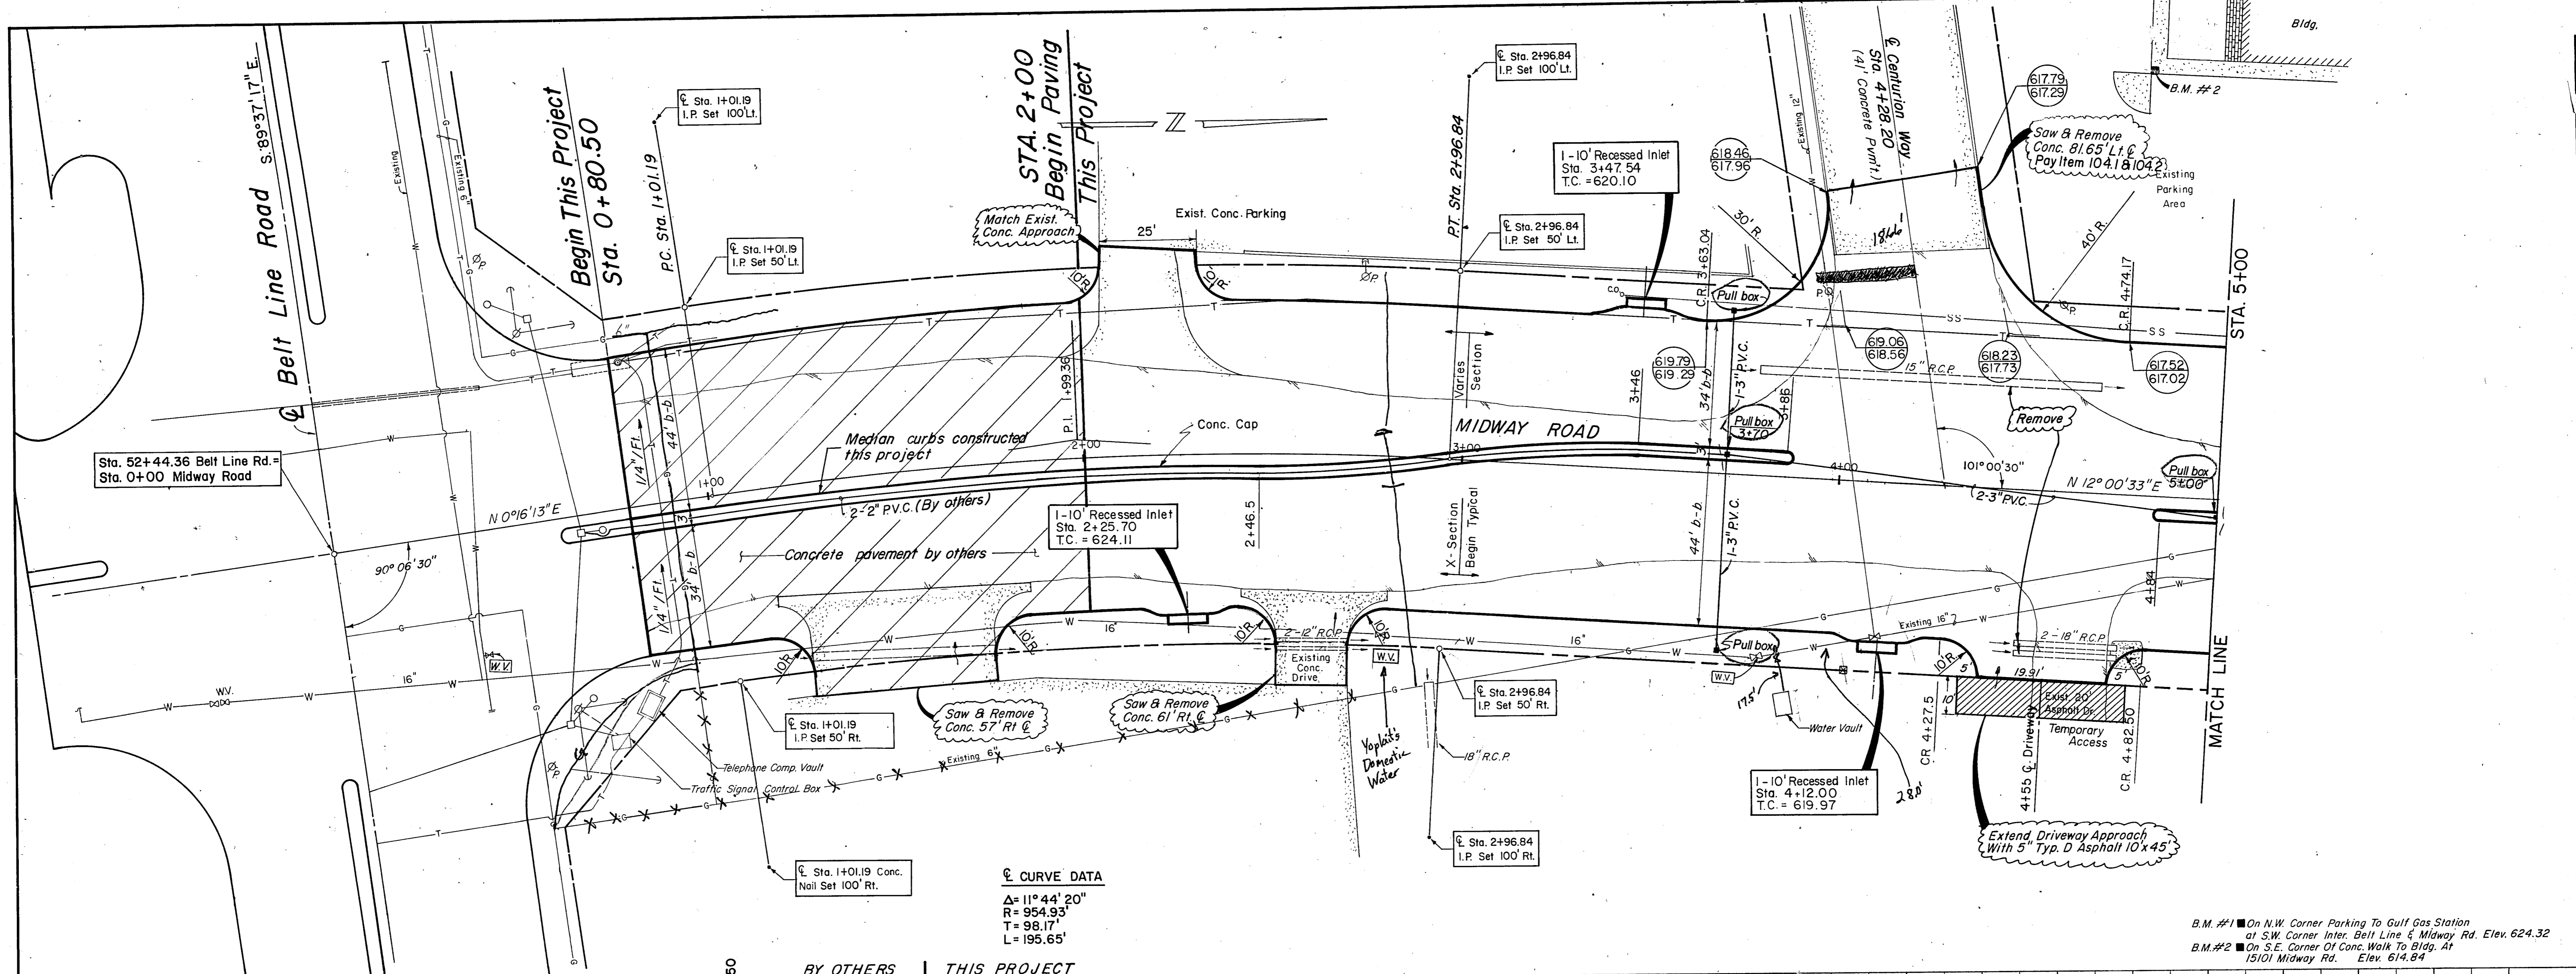

Δ CURVE DATA
 Δ = 11° 44' 20"
 R = 954.93'
 T = 98.17'
 L = 195.65'

B.M. #1 ■ On N.W. Corner Parking To Gulf Gas Station at S.W. Corner Inter. Belt Line & Midway Rd. Elev. 624.32
 B.M. #2 ■ On S.E. Corner Of Conc. Walk To Bldg. At 15101 Midway Rd. Elev. 614.84

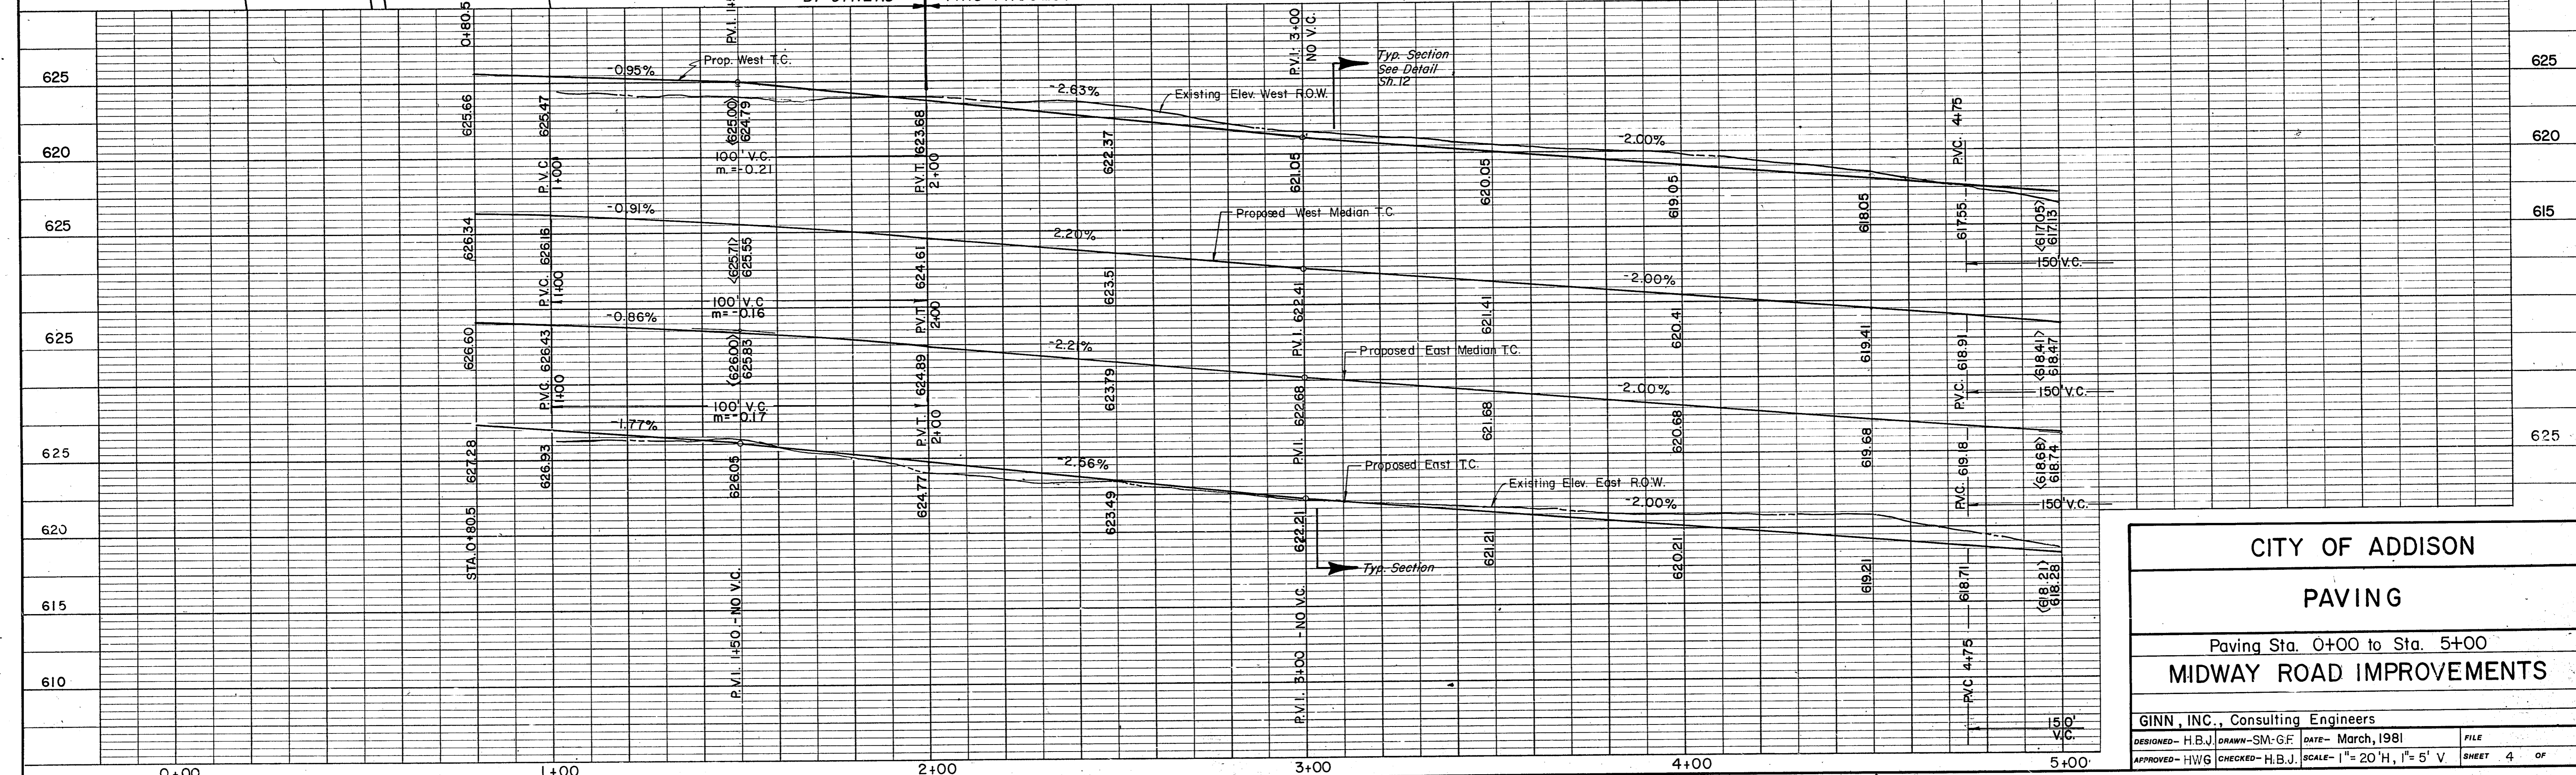


CITY OF ADDISON

PAVING


Paving Sta. 0+00 to Sta. 5+00
MIDWAY ROAD IMPROVEMENTS

GINN, INC., Consulting Engineers
 DESIGNED - H.B.J. DRAWN - SM.G.F. DATE - March, 1981
 APPROVED - HWG CHECKED - H.B.J. SCALE - 1" = 20' H, 1" = 5' V SHEET 4 OF



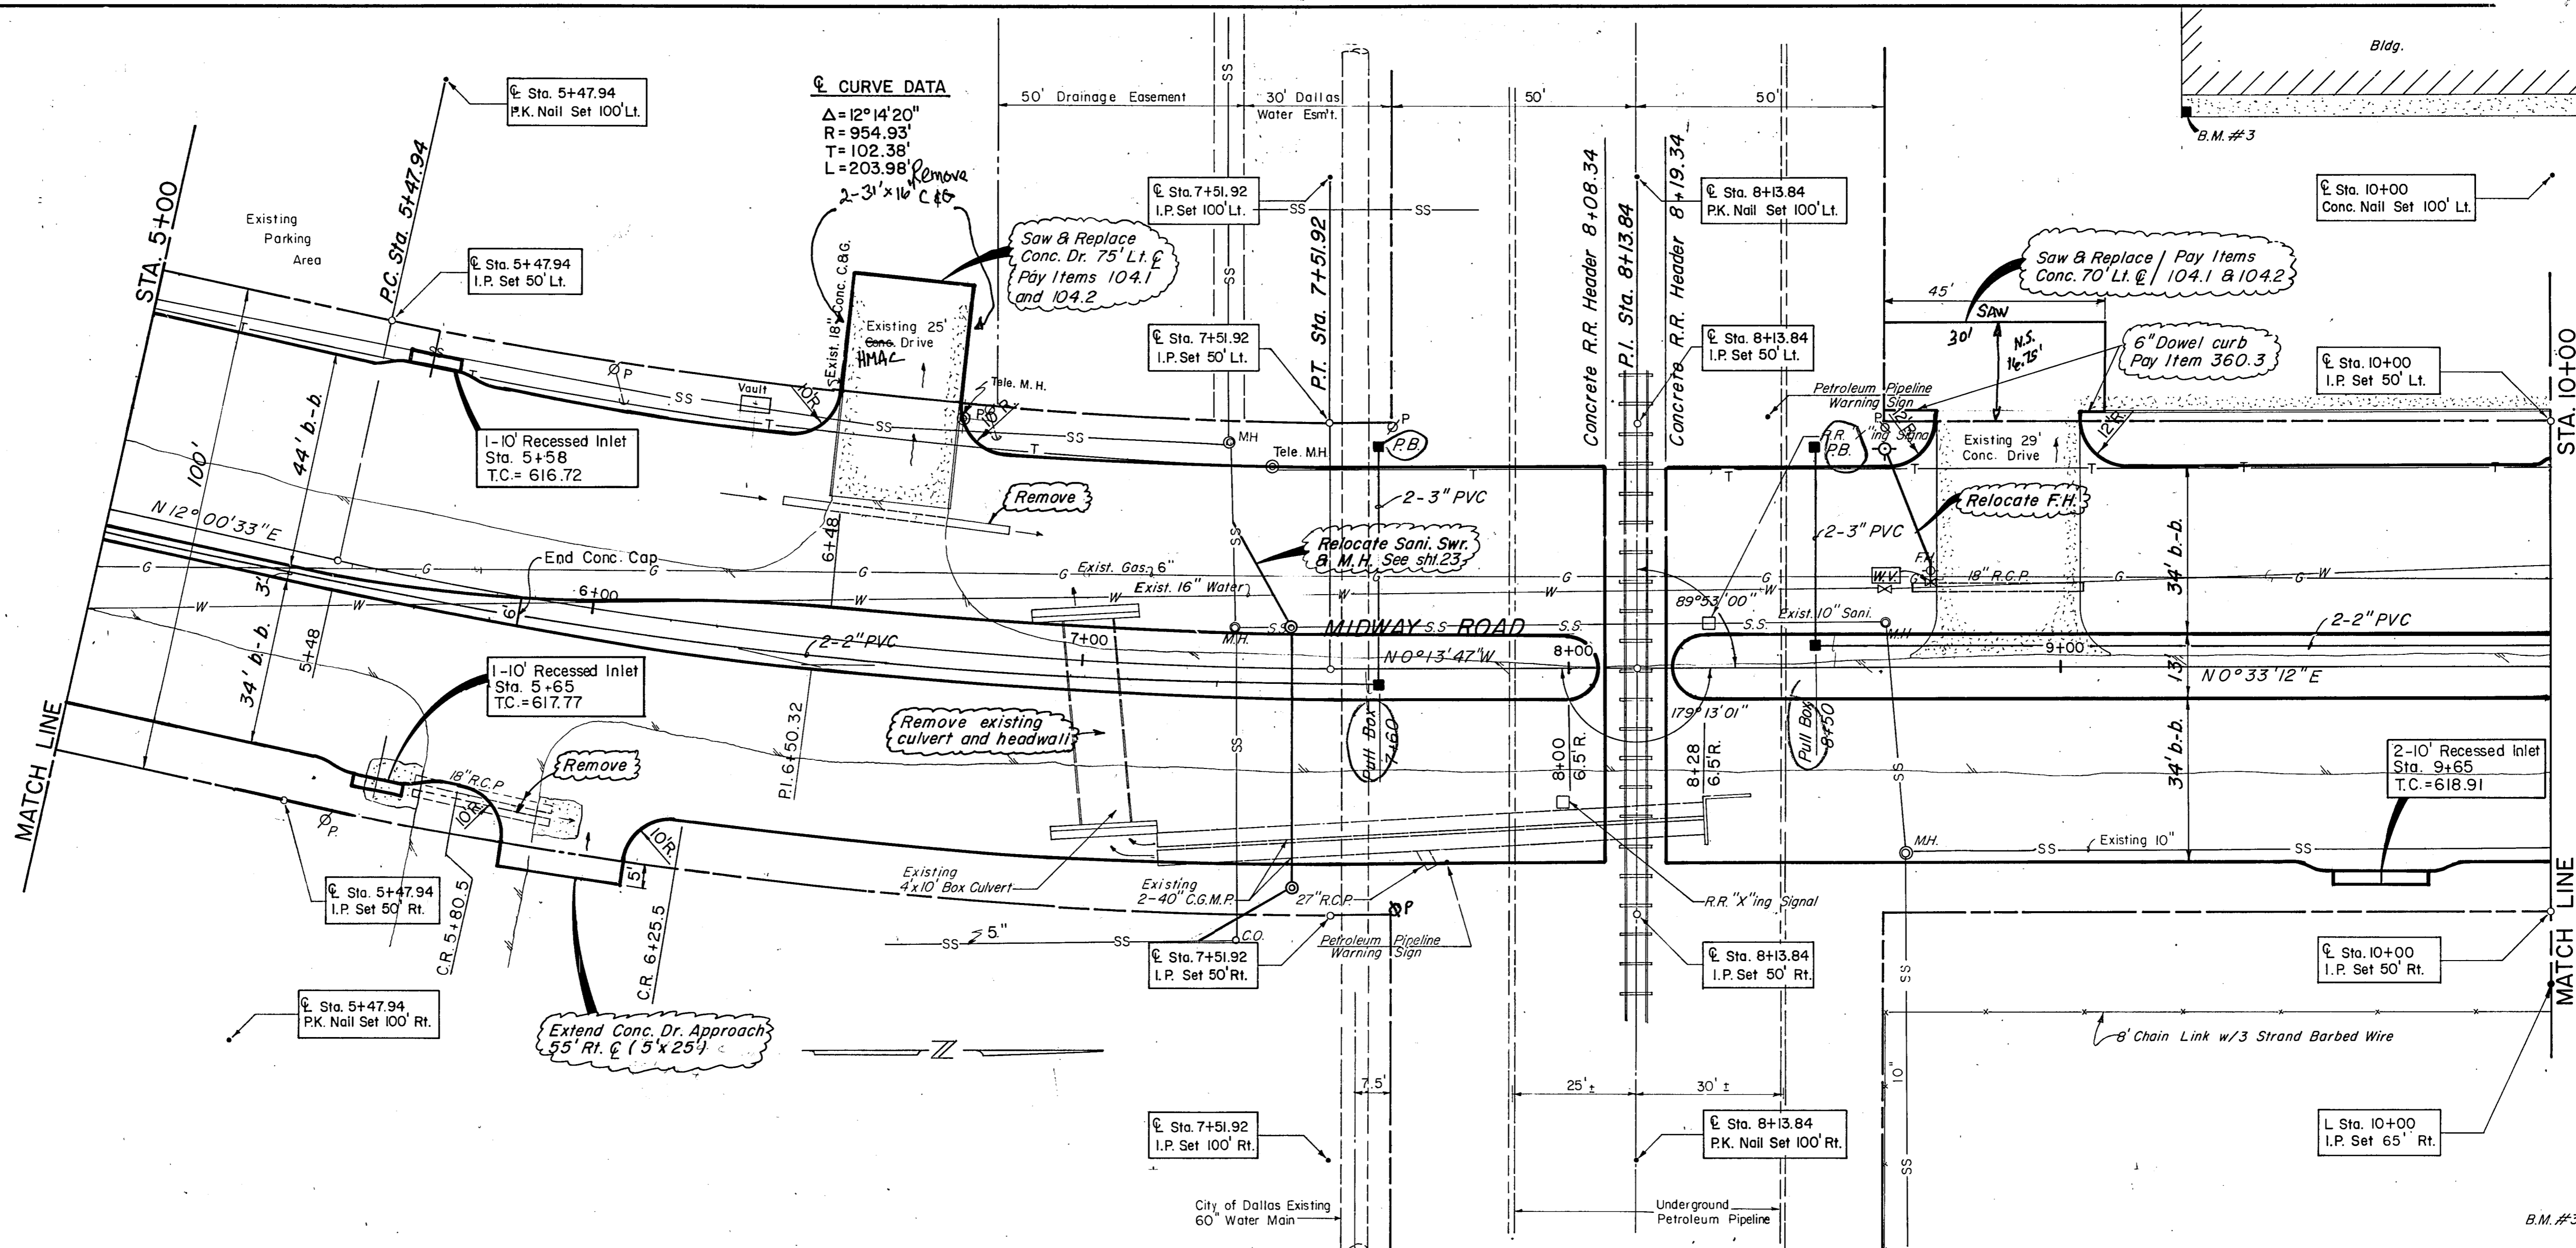


☉ CURVE DATA
 $\Delta = 12^\circ 14' 20''$
 $R = 954.93'$
 $T = 102.36'$
 $L = 203.98'$


B.M. #3 On Conc. Walk At S.E. Corner Of Bldg. At 15201 Midway Rd. Elev. 618.14

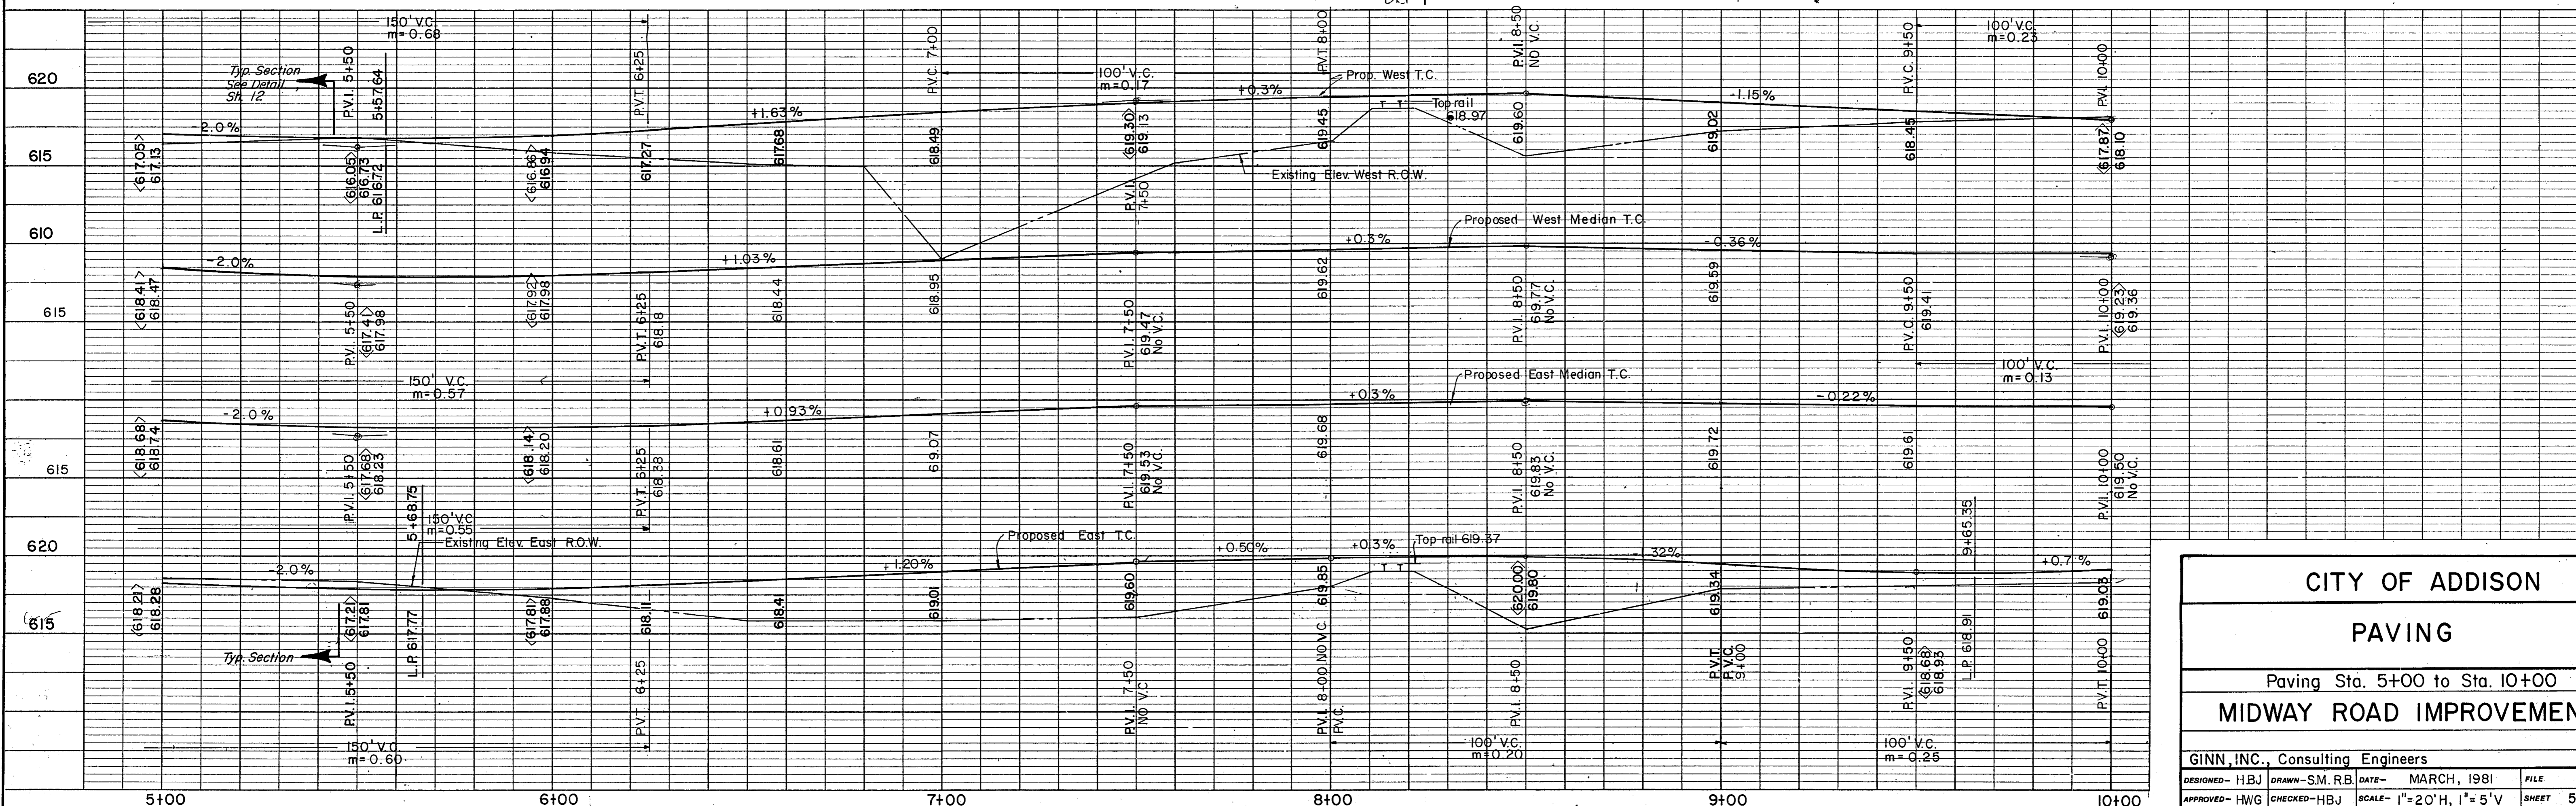

CITY OF ADDISON			
PAVING			
Paving Sta. 5+00 to Sta. 10+00			
MIDWAY ROAD IMPROVEMENTS			
GINN, INC., Consulting Engineers			
DESIGNED - HBJ	DRAWN - S.M.R.B.	DATE - MARCH, 1981	FILE
APPROVED - HWG	CHECKED - HBJ	SCALE - 1"=20'H, 1"=5'V	SHEET 5 OF

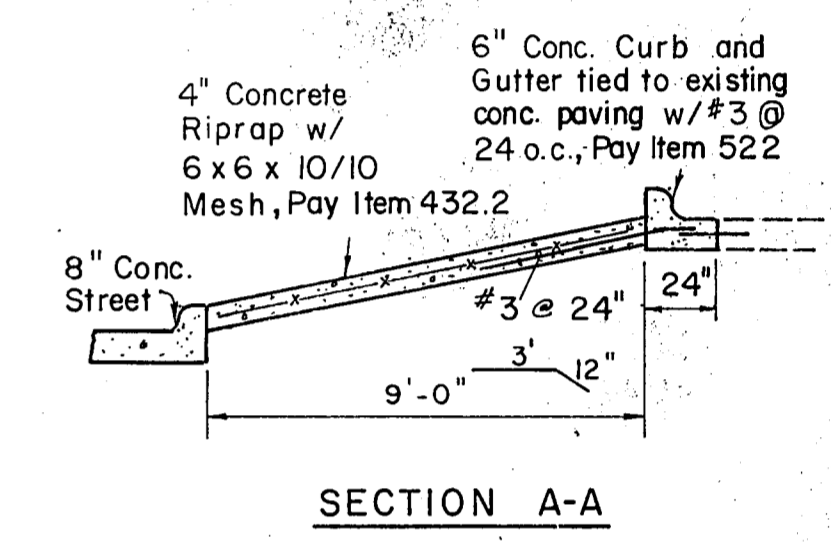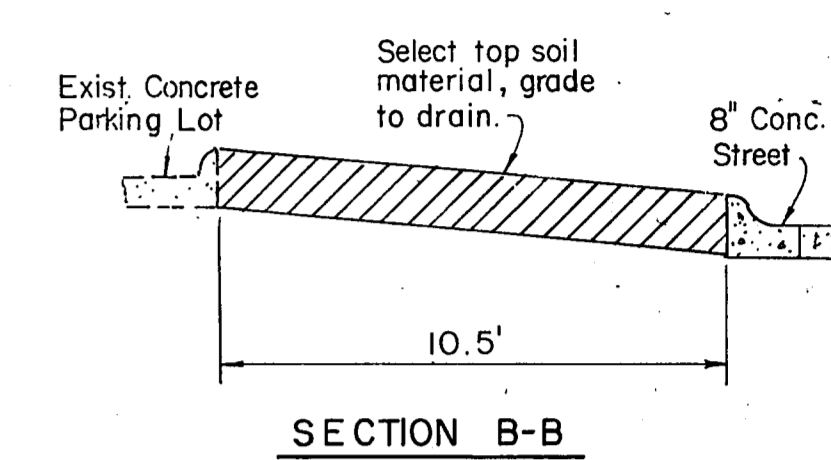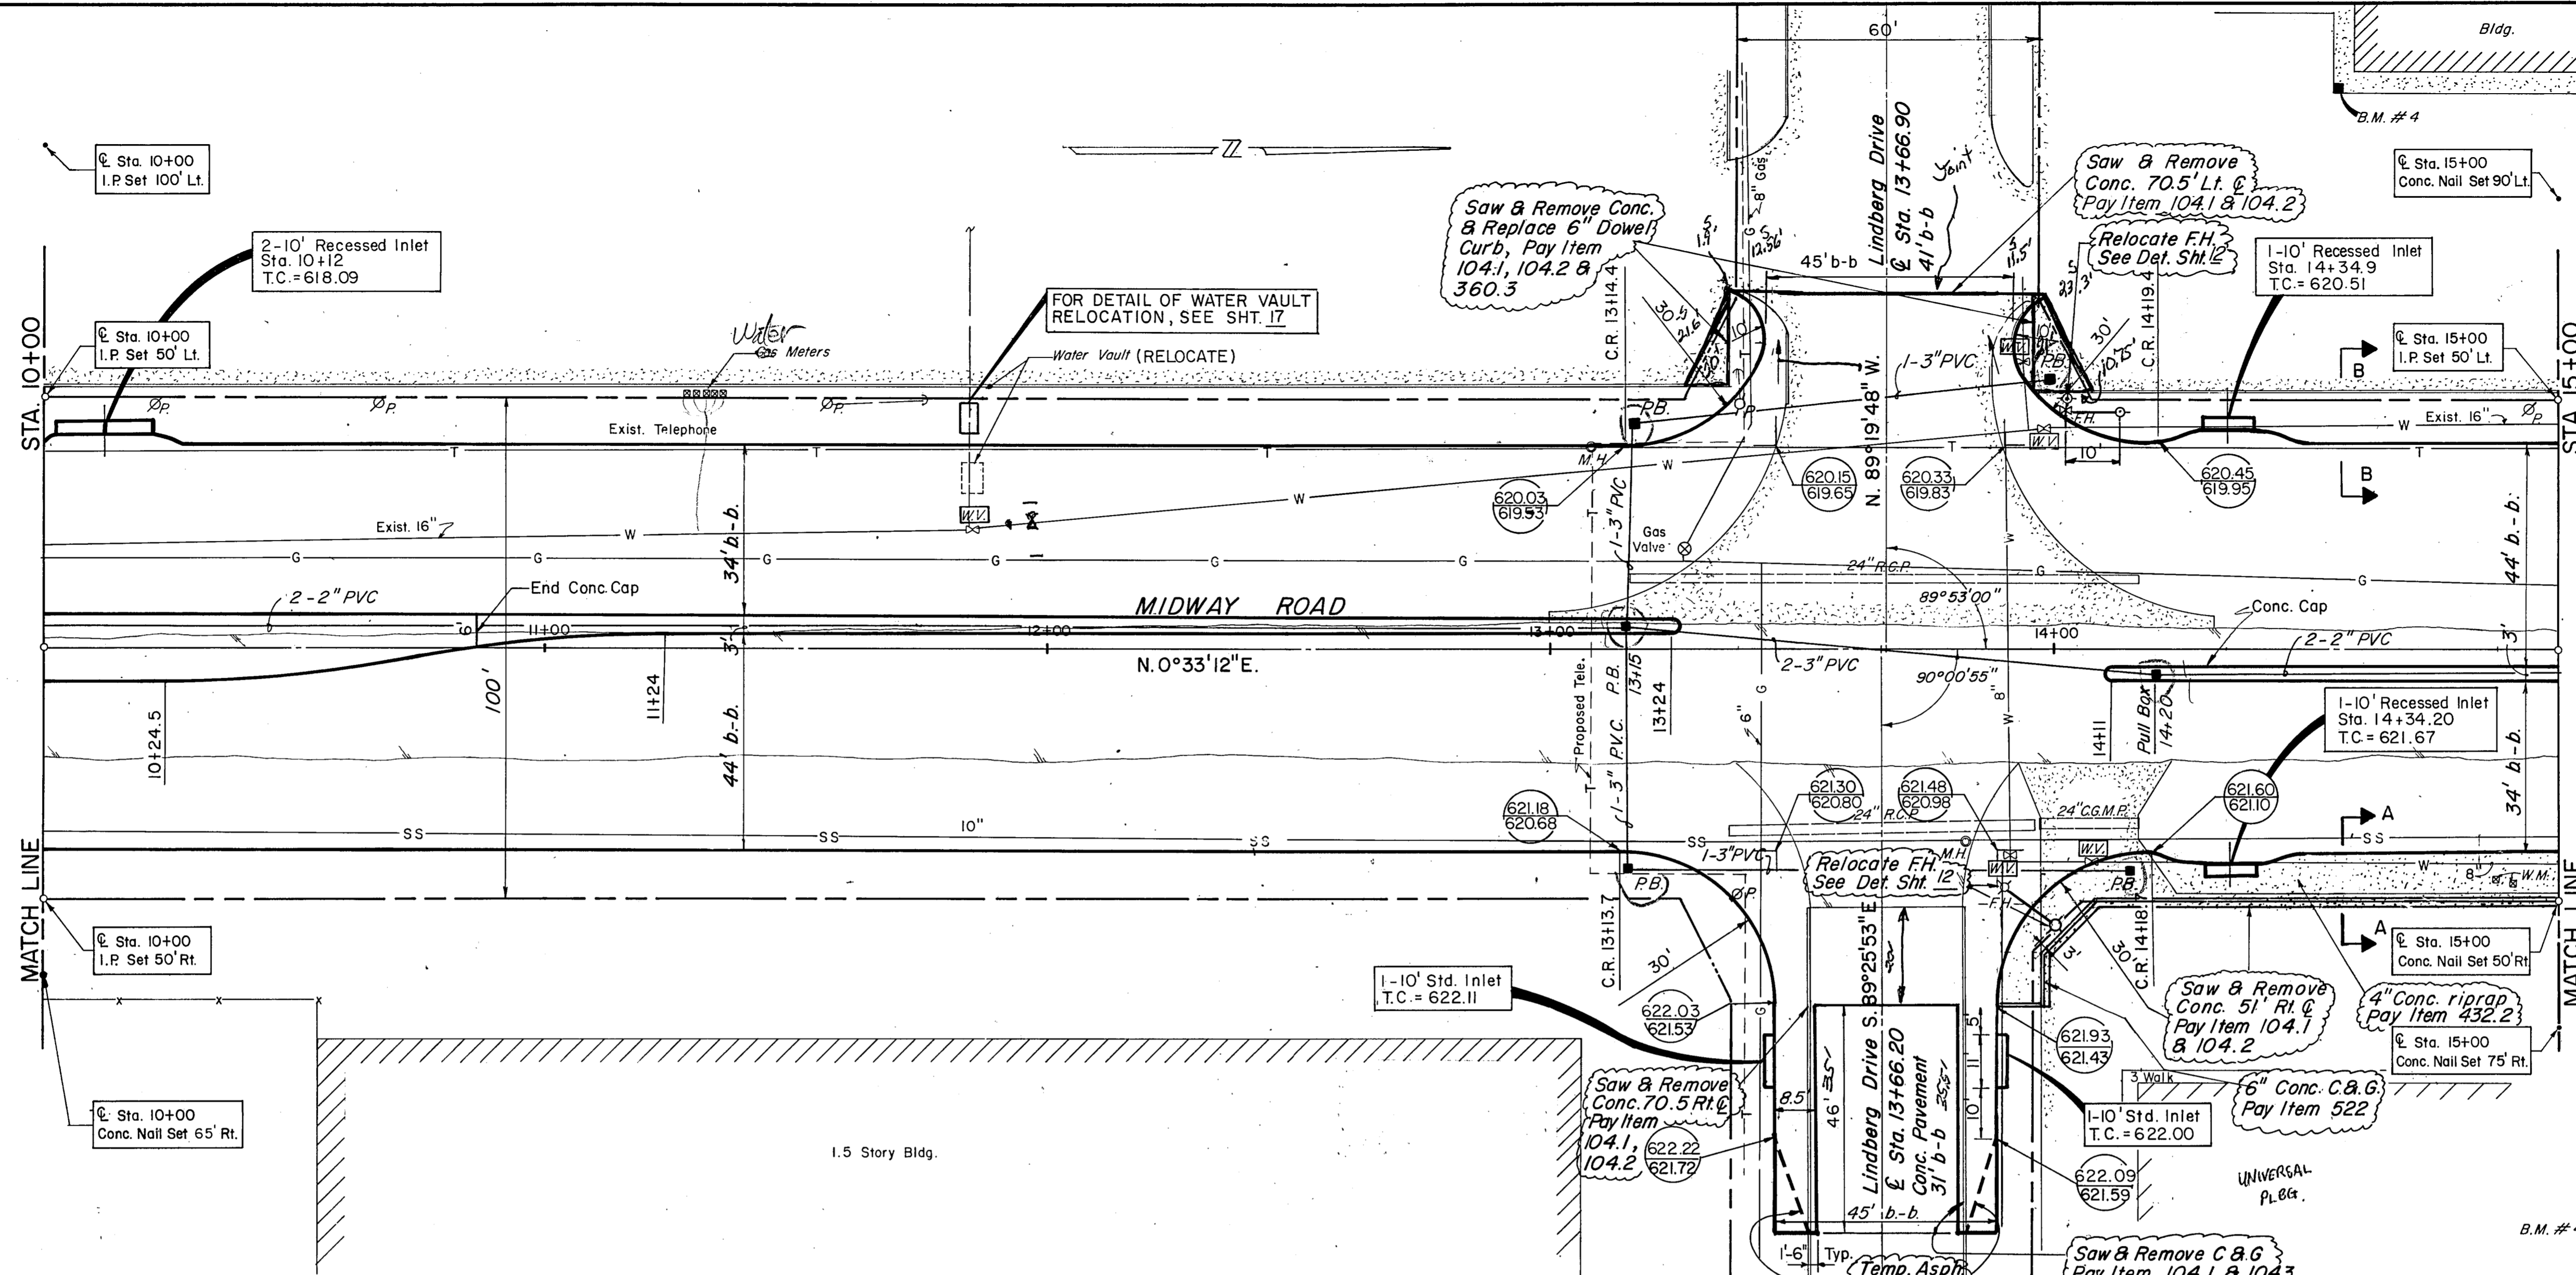

B.M. #4 On Conc. Walk At S.E. Corner Of Bldg At 15301 Midway Rd. Elev. 621.43

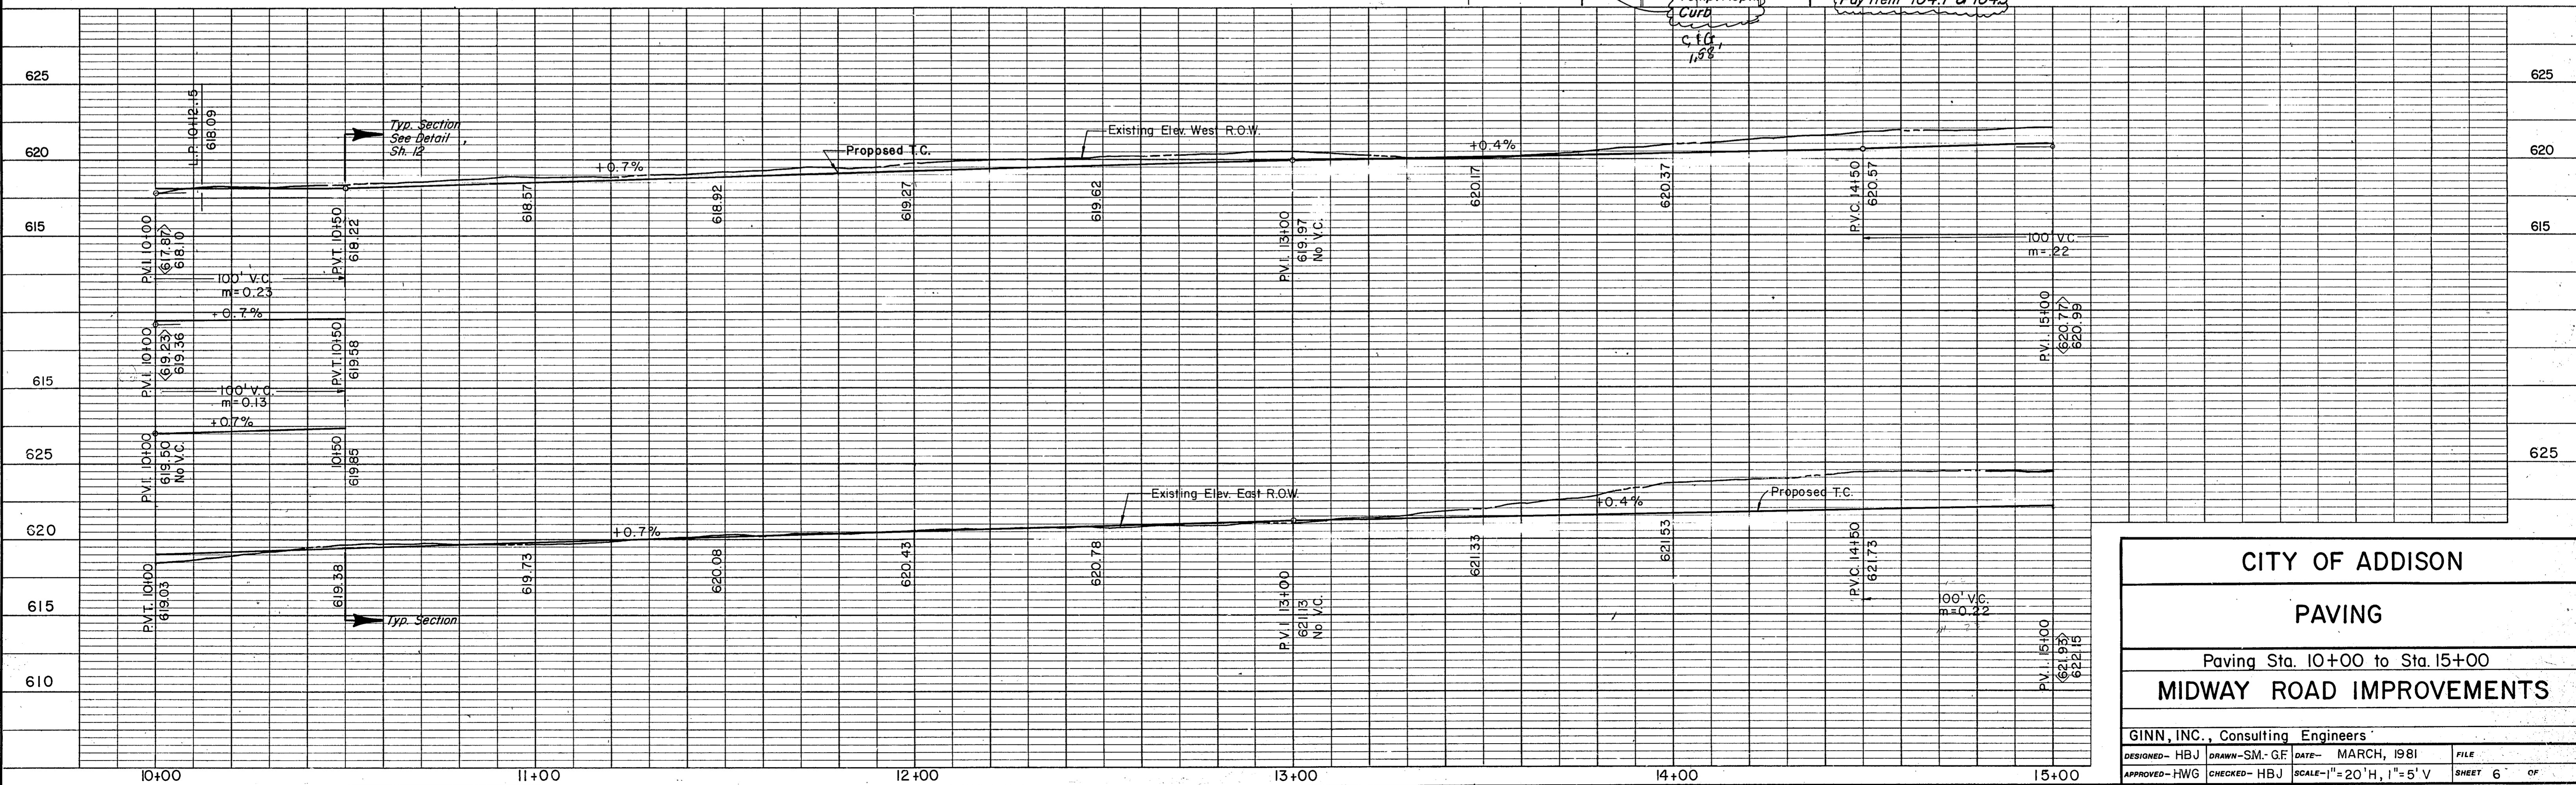

CITY OF ADDISON



PAVING

Paving Sta. 10+00 to Sta. 15+00
MIDWAY ROAD IMPROVEMENTS


GINN, INC., Consulting Engineers

DESIGNED - HBJ DRAWN - SM - GF DATE - MARCH, 1981 FILE

APPROVED - HWG CHECKED - HBJ SCALE - 1" = 20' H, 1" = 5' V SHEET 6 OF

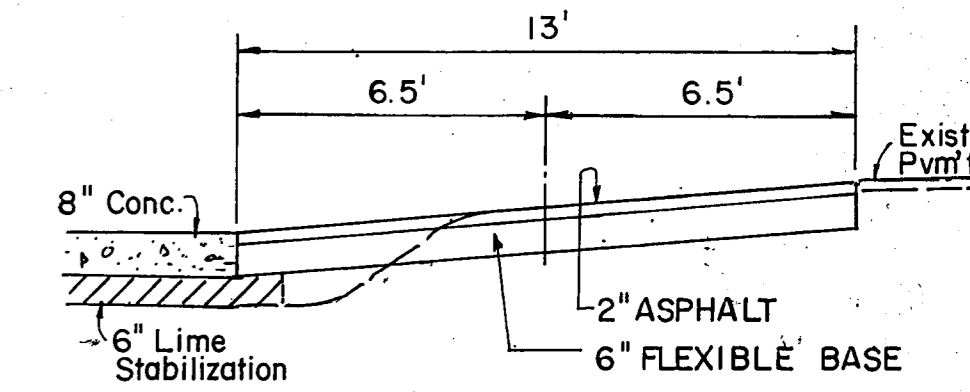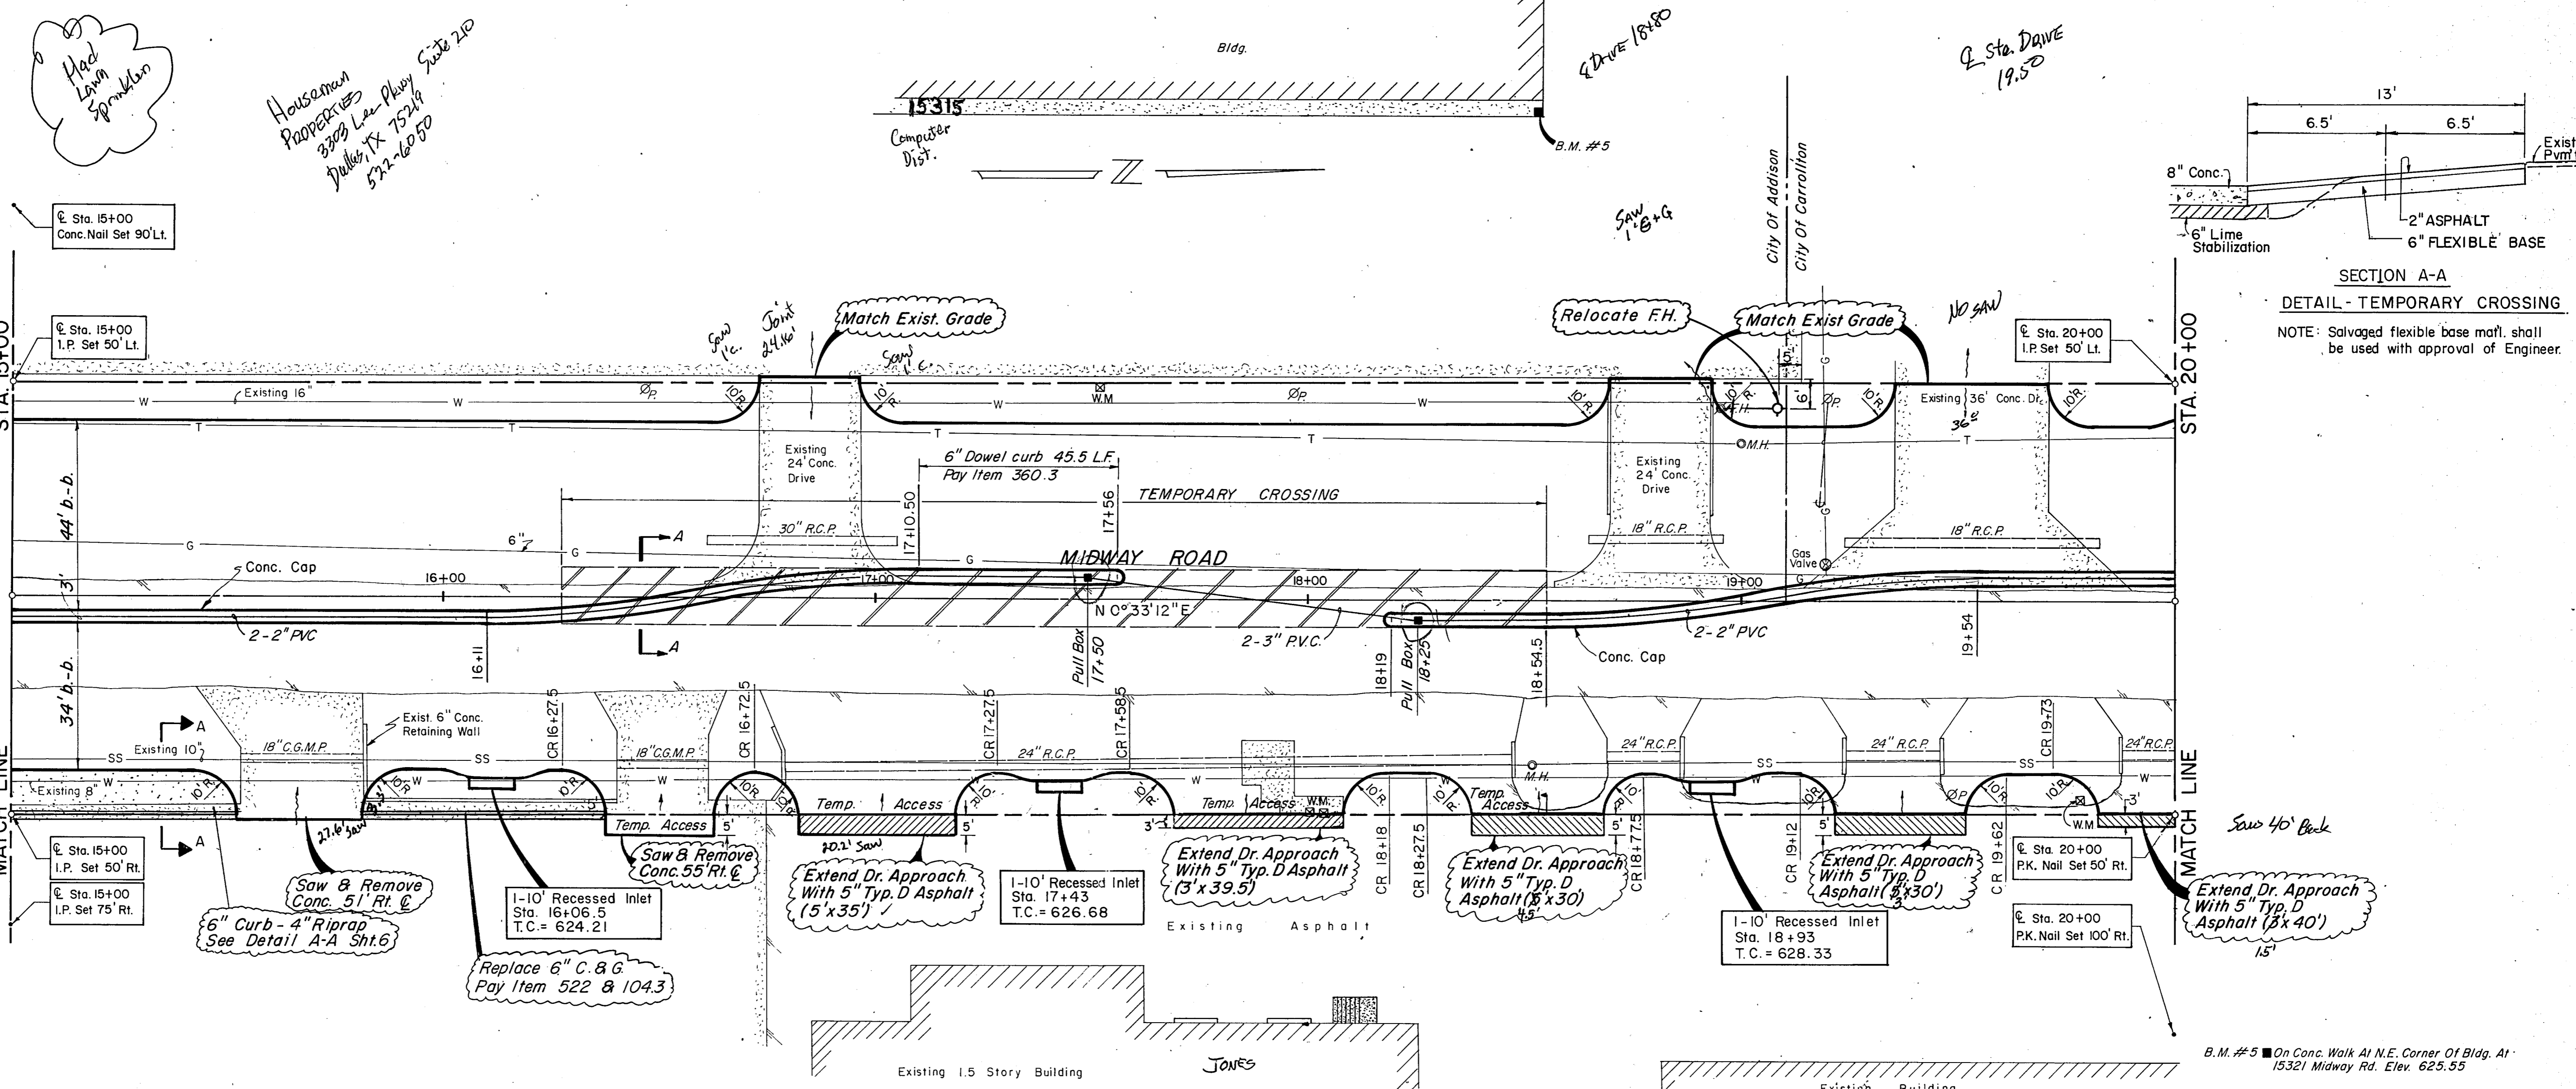

SECTION A-A
 DETAIL - TEMPORARY CROSSING
 NOTE: Salvaged flexible base mat. shall be used with approval of Engineer.

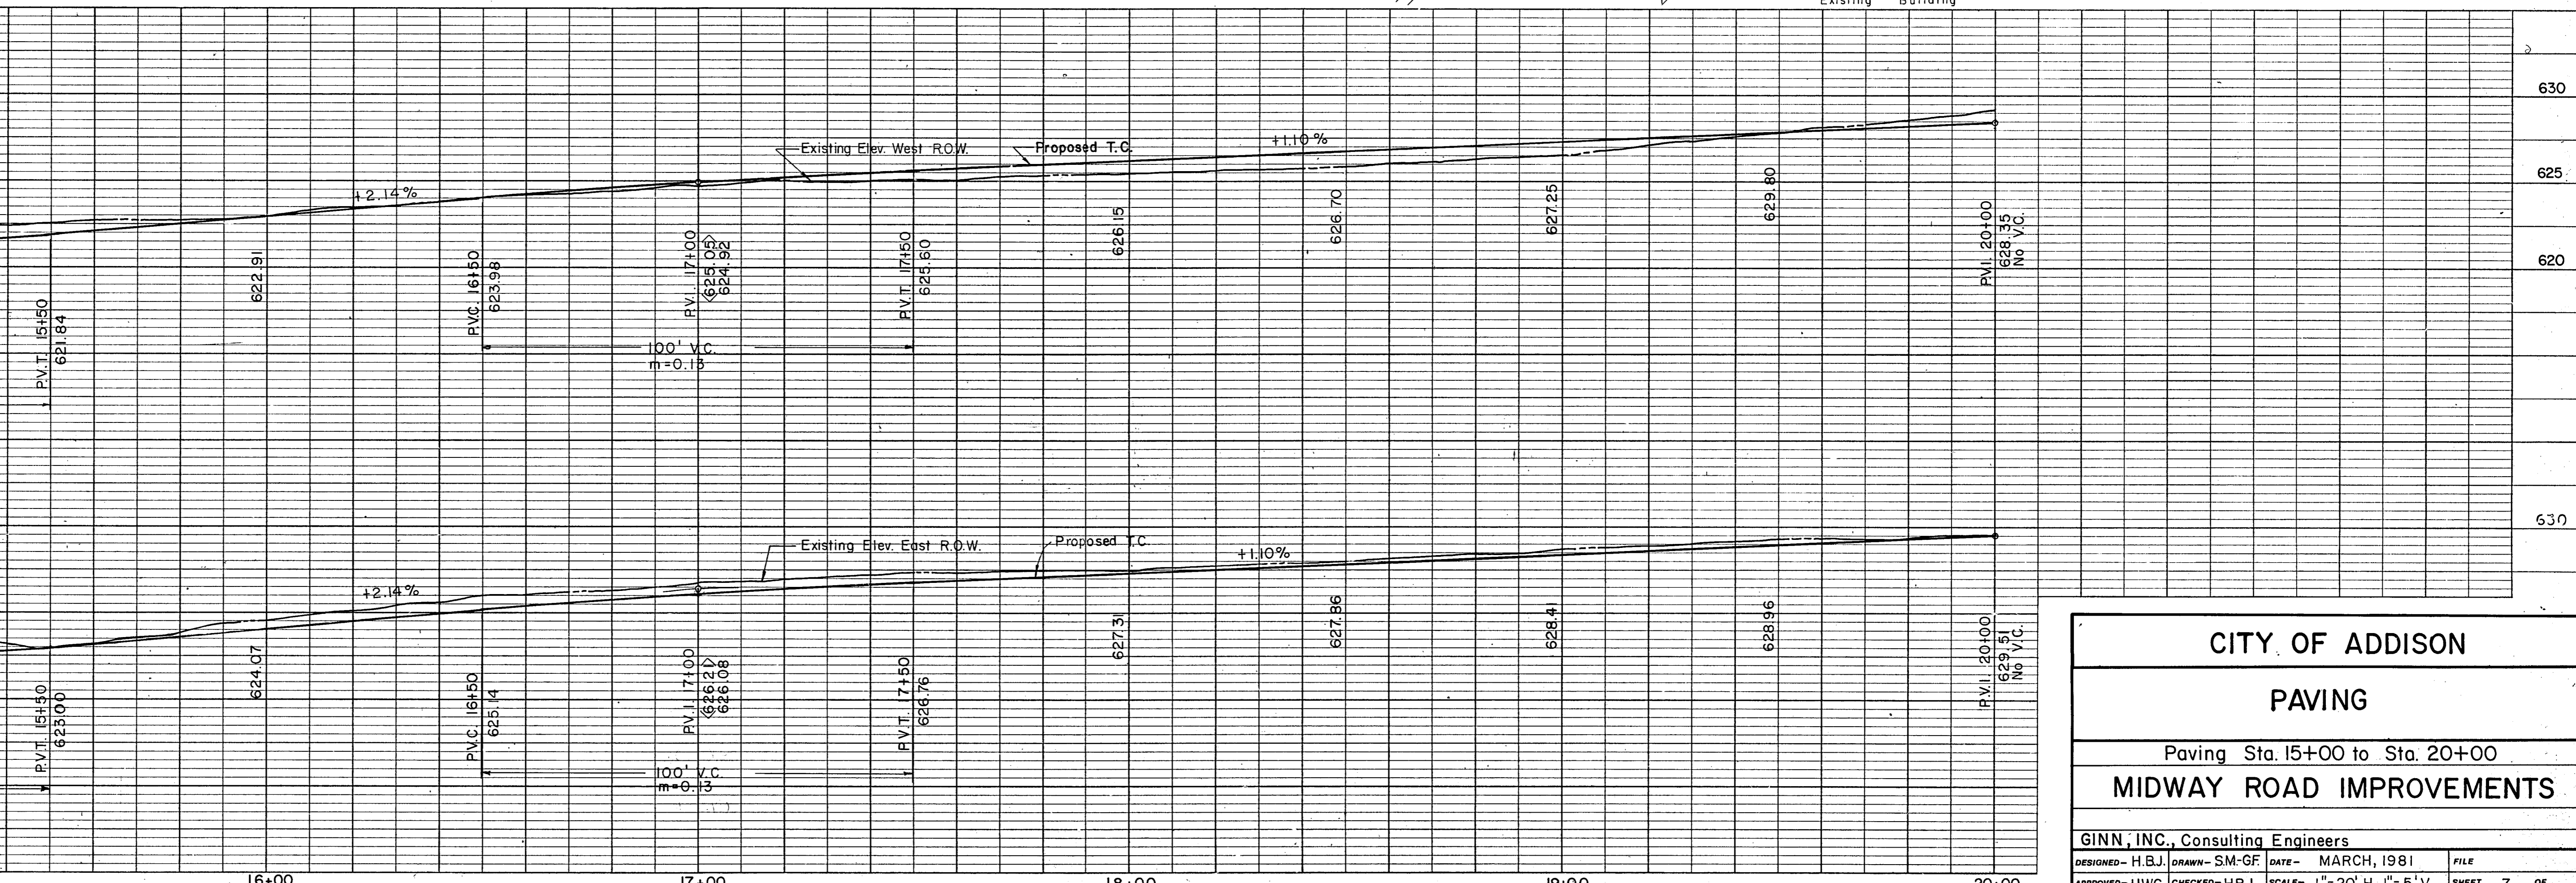

CITY OF ADDISON

PAVING

Paving Sta. 15+00 to Sta. 20+00
MIDWAY ROAD IMPROVEMENTS

GINN, INC., Consulting Engineers
 DESIGNED - H.B.J. DRAWN - SM-GF DATE - MARCH, 1981 FILE
 APPROVED - HWG CHECKED - HBJ SCALE - 1" = 20' H, 1" = 5' V SHEET 7 OF

Had Lawn Sprinkler
 Houseman
 PROPERIES
 3309 Lee-Play Site 210
 Dallas, TX 75219
 512-460-570

Sta. 15+00
 Conc. Nail Set 90' Lt.

Sta. 15+00
 I.P. Set 50' Lt.

Sta. 15+00
 I.P. Set 50' Rt.

Sta. 15+00
 I.P. Set 75' Rt.

Saw & Remove
 Conc. 5' Rt. @
 6" Curb - 4" Riprap
 See Detail A-A Sht. 16

Replace 6" C. & G.
 Pay Item 522 & 104.3

1-10' Recessed Inlet
 Sta. 16+06.5
 T.C. = 624.21

Extend Dr. Approach
 With 5" Typ. D Asphalt
 (5' x 35')

1-10' Recessed Inlet
 Sta. 17+43
 T.C. = 626.68


Extend Dr. Approach
 With 5" Typ. D Asphalt
 (8' x 30')

1-10' Recessed Inlet
 Sta. 18+93
 T.C. = 628.33

Extend Dr. Approach
 With 5" Typ. D Asphalt
 (8' x 40')

Extend Dr. Approach
 With 5" Typ. D Asphalt
 (8' x 40')

B.M. #5 On Conc. Walk At N.E. Corner Of Bldg. At
 15321 Midway Rd. Elev. 625.55

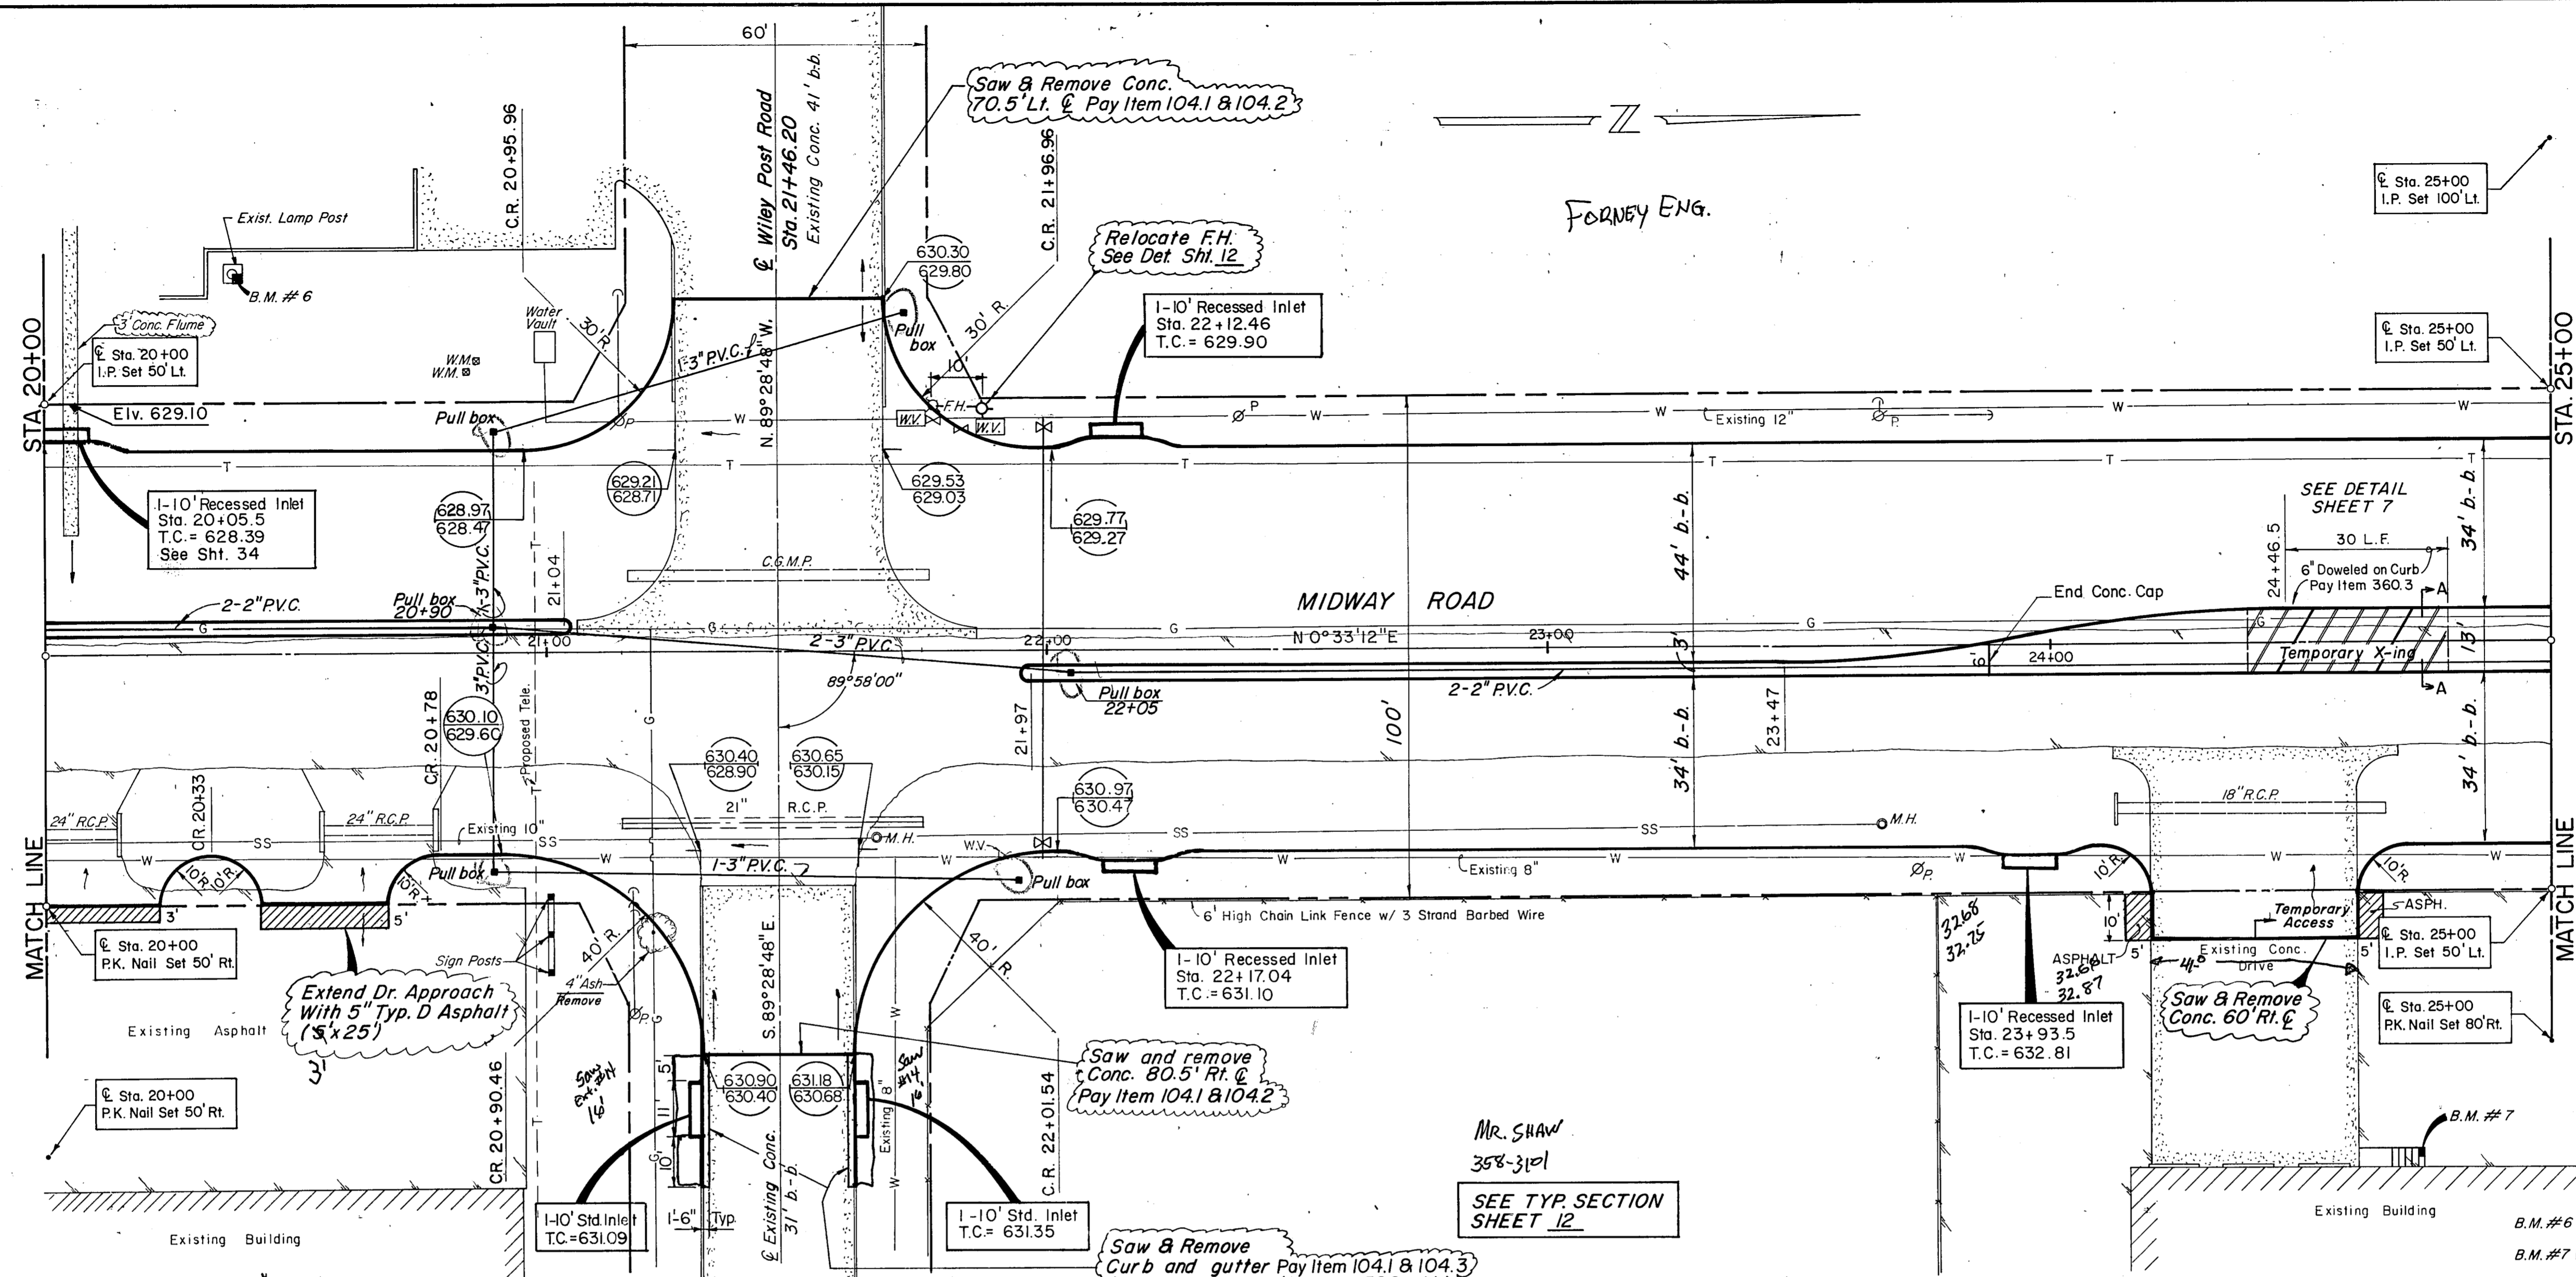


FORNEY ENG.



MR. SHAW
358-3101

SEE TYP. SECTION SHEET 12

B.M. #6 On Conc. Base To Lamp Post At S.W. Corner Of Inter. Wiley Post Rd & Midway Rd. Elev. 631.34
B.M. #7 On Bottom Step To Loading Dock At 15302 Midway Rd. Elev. 635.05

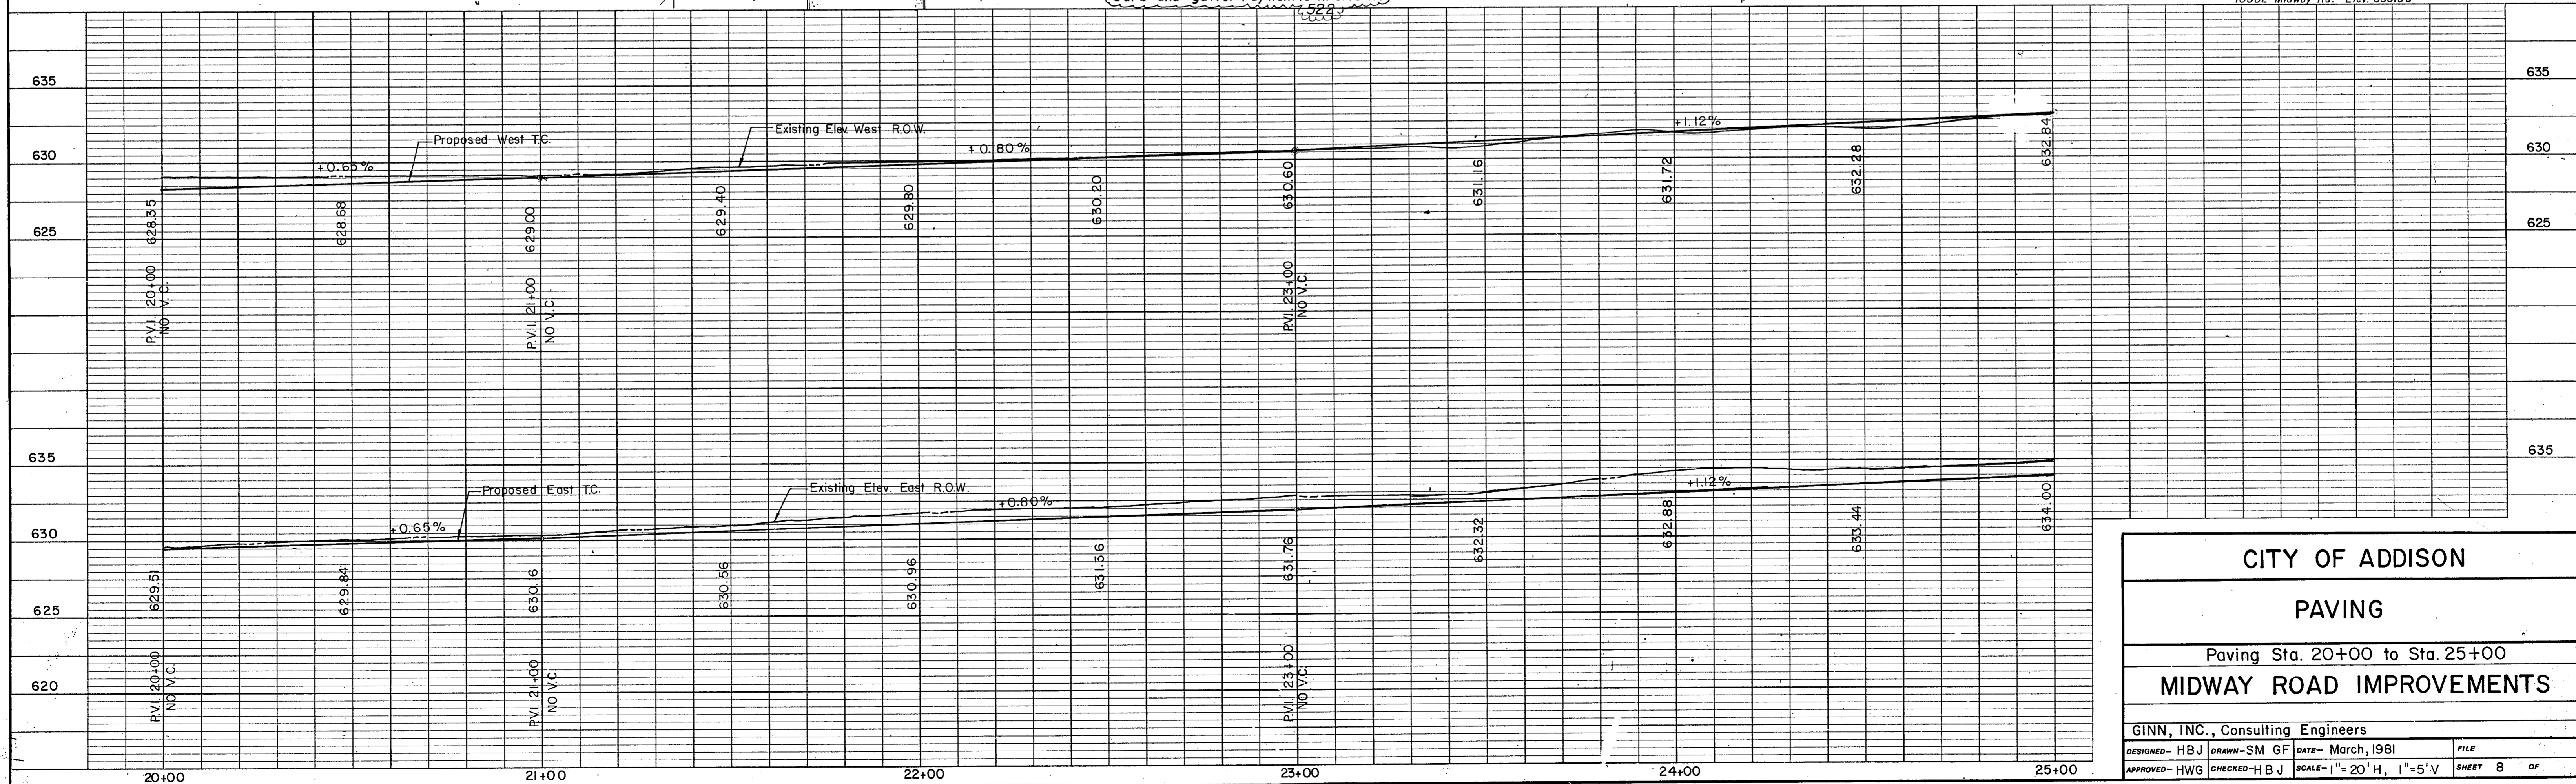

CITY OF ADDISON	
PAVING	
Paving Sta. 20+00 to Sta. 25+00	
MIDWAY ROAD IMPROVEMENTS	
GINN, INC., Consulting Engineers	
DESIGNED - HBJ	DRAWN - SM GF
DATE - March, 1981	FILE
APPROVED - HWG	CHECKED - HBJ
SCALE - 1" = 20' H, 1" = 5' V	SHEET 8 OF

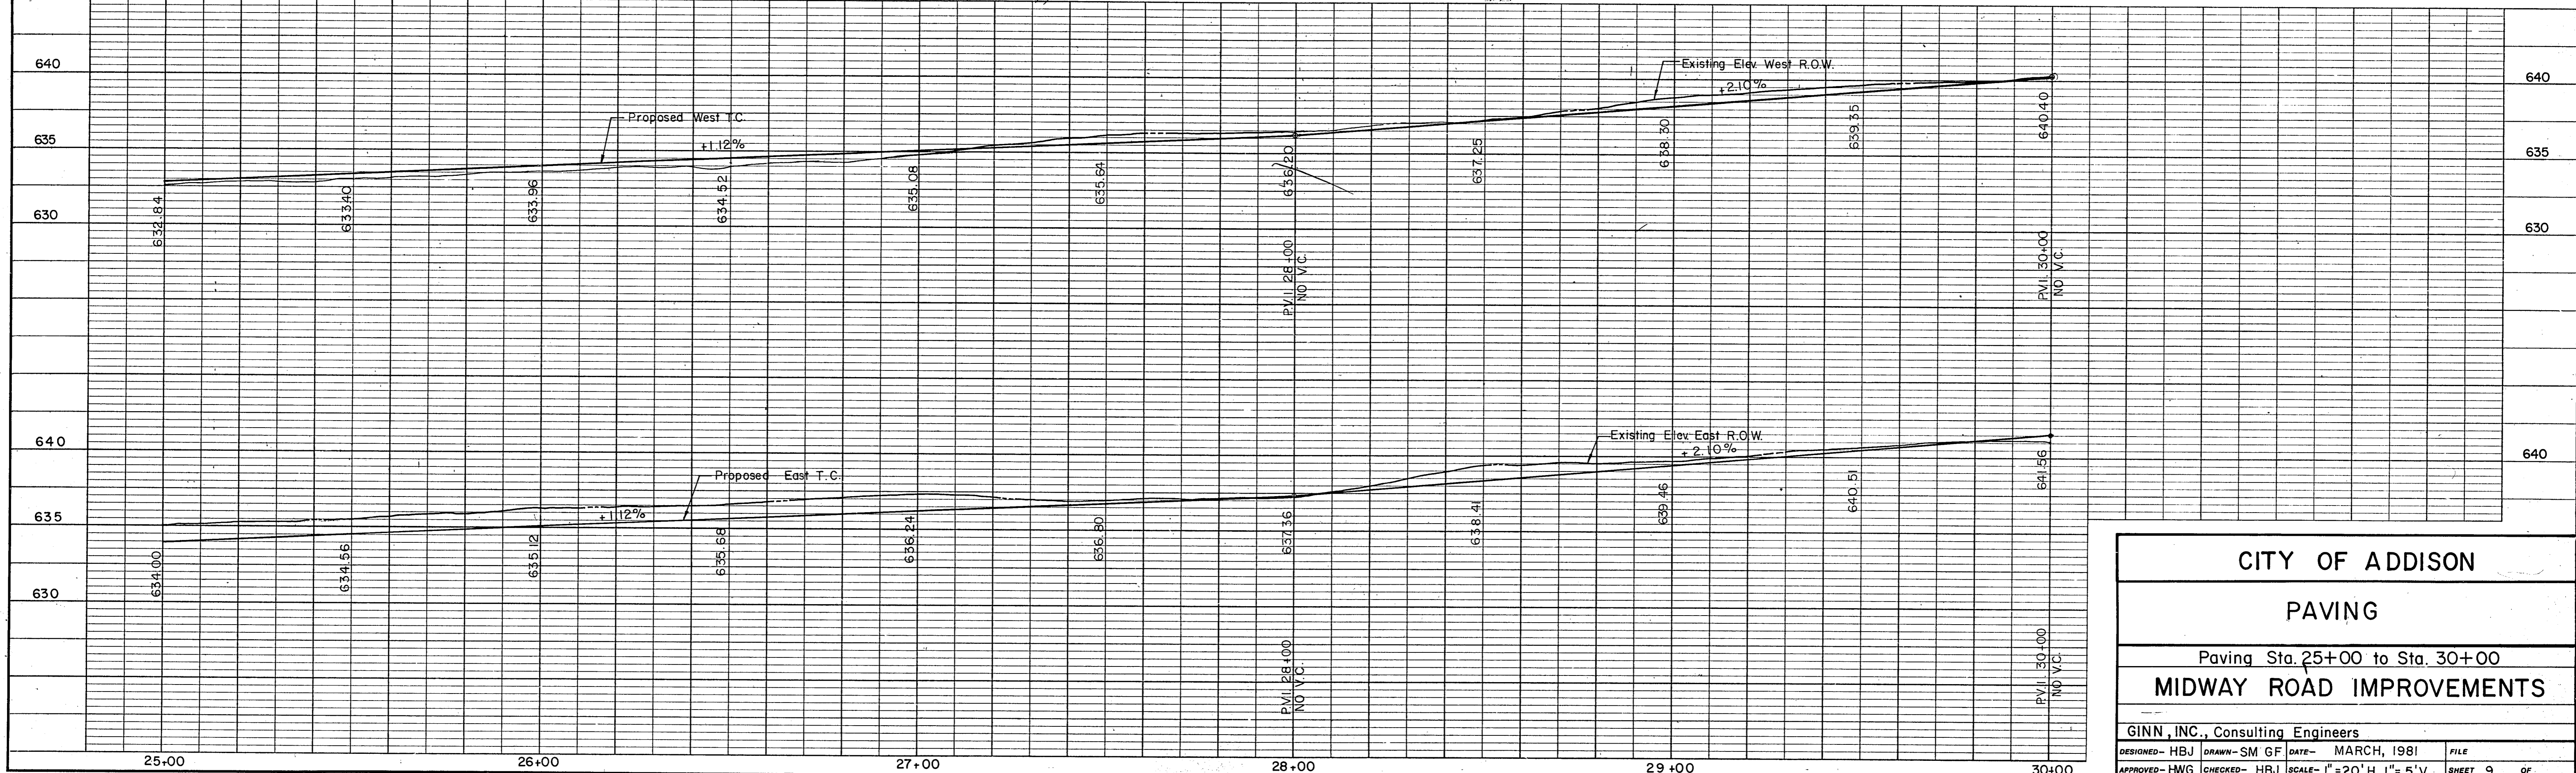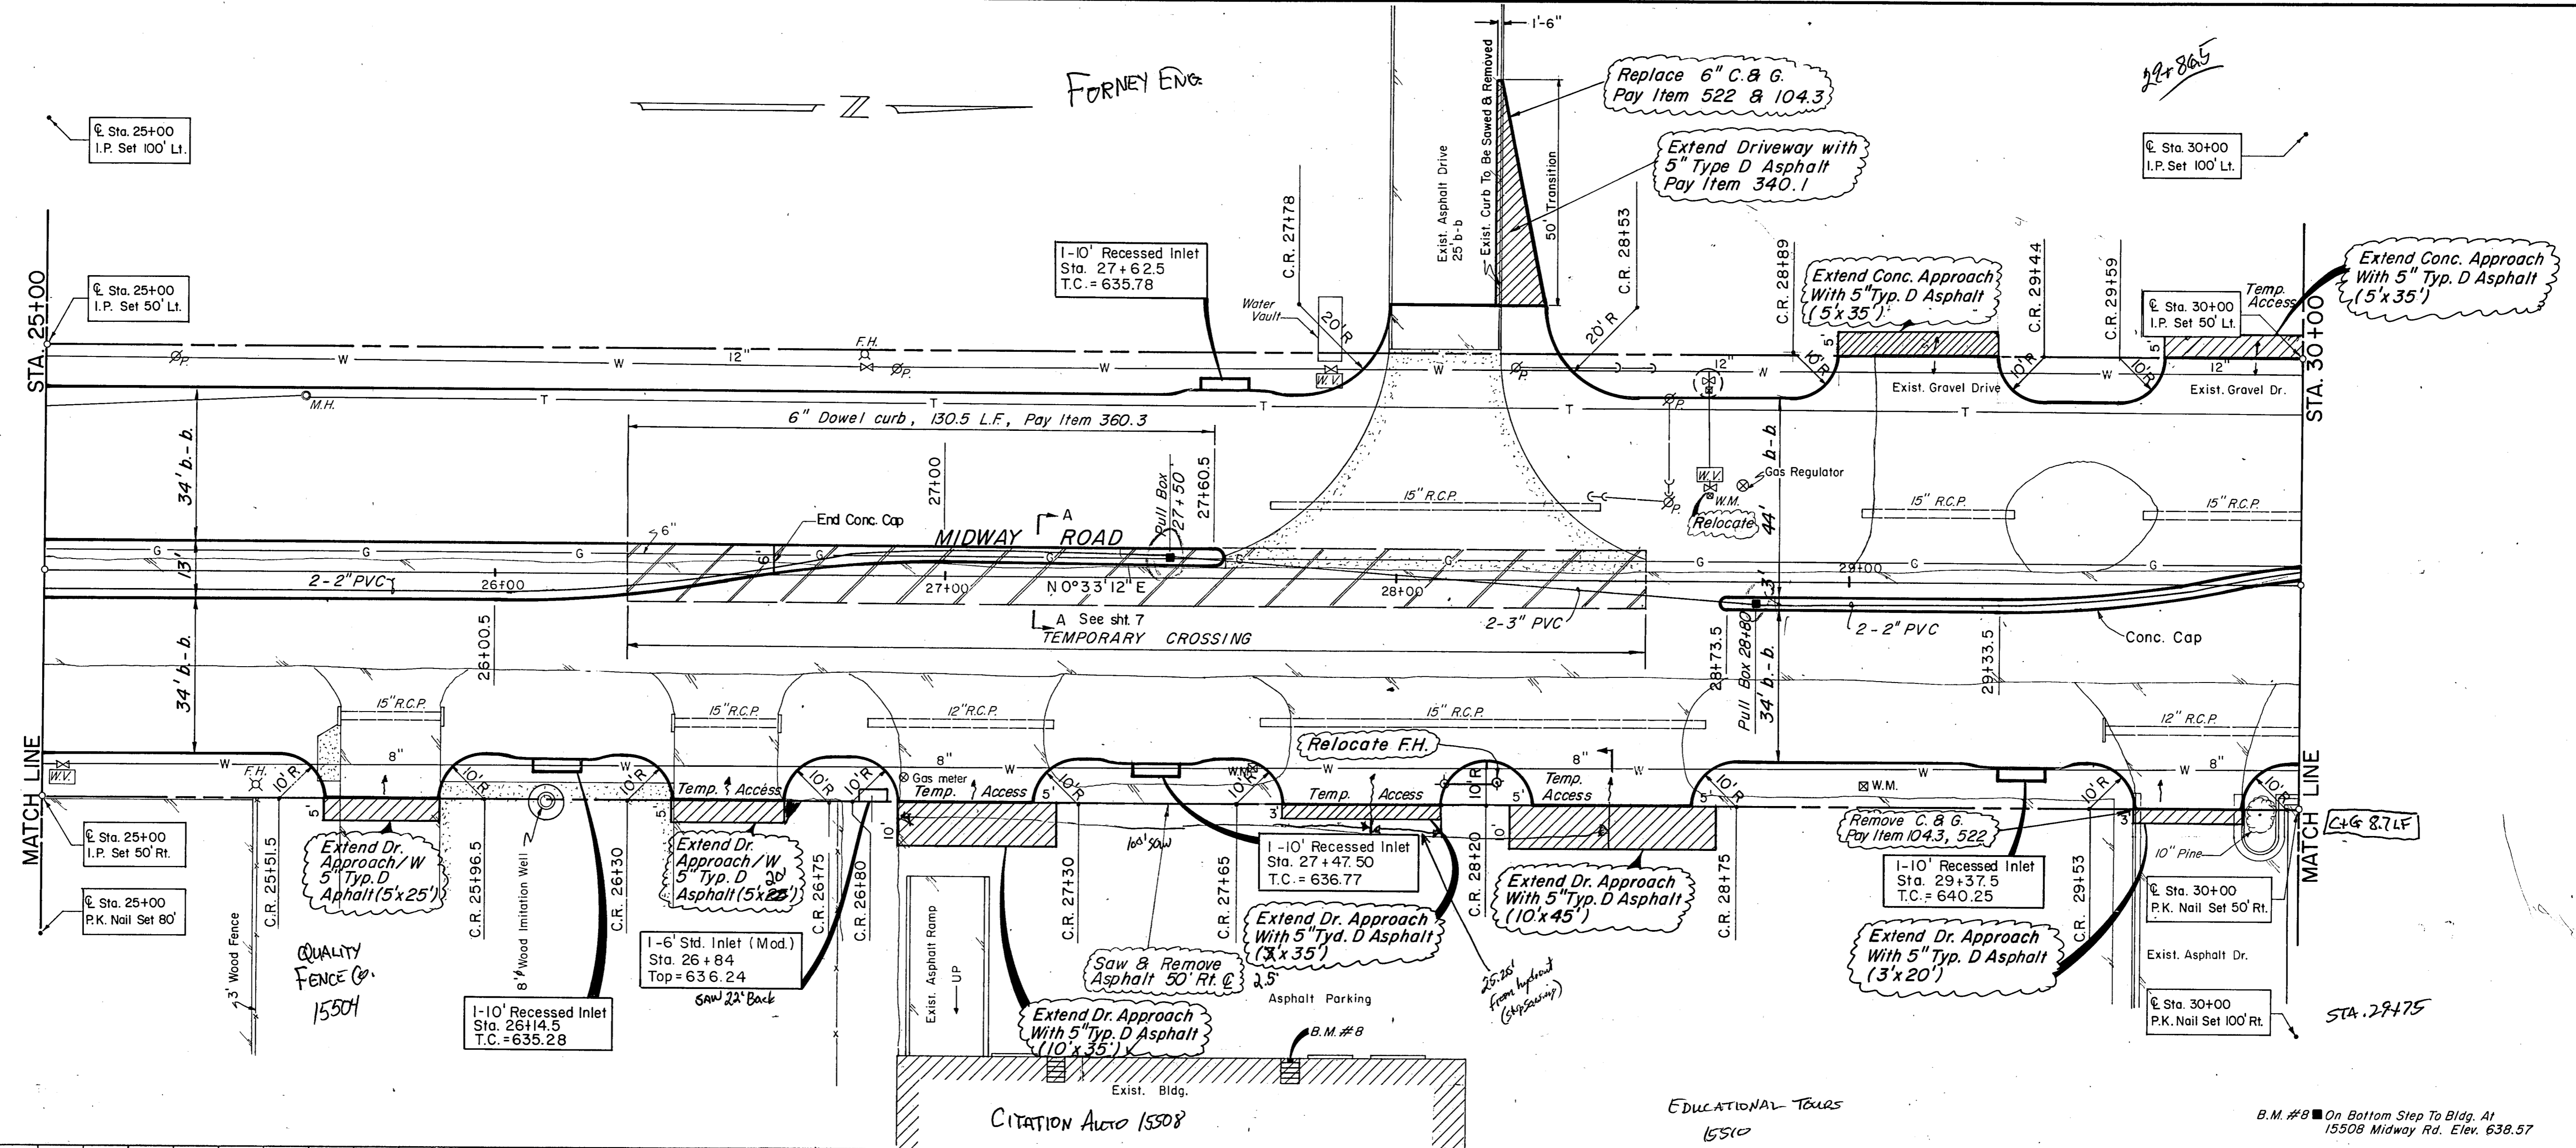

CITY OF ADDISON

PAVING

Paving Sta. 25+00 to Sta. 30+00
MIDWAY ROAD IMPROVEMENTS

GINN, INC., Consulting Engineers

DESIGNED - HBJ DRAWN - SM GF DATE - MARCH, 1981 FILE _____

APPROVED - HWG CHECKED - HBJ SCALE - 1" = 20' H, 1" = 5' V SHEET 9 OF _____

Sta. 30+00
I.P. Set 100' Lt.

Sta. 30+00
I.P. Set 50' Lt.

Sta. 30+00
I.P. Set 50' Rt.

Sta. 30+00
I.P. Set 100' Rt.

Curve Data
Δ = 33°17'00"
R = 940.0'
T = 280.97'
L = 546.05'

Sta. 35+00
I.P. Set 100' Lt.

Sta. 35+00
I.P. Set 50' Lt.

Sta. 35+00
I.P. Set 50' Rt.

Sta. 35+00
I.P. Set 100' Rt.


GLIDDEN PAINT

MIDWAY ROAD

Existing Building
MINNOLAB INC.
15610

GEARHART DIV.
15660

B.M. #9 On Conc. Pavement At S.E. Corner Of Bldg. At
15635 Midway Rd. Elev. 642.61

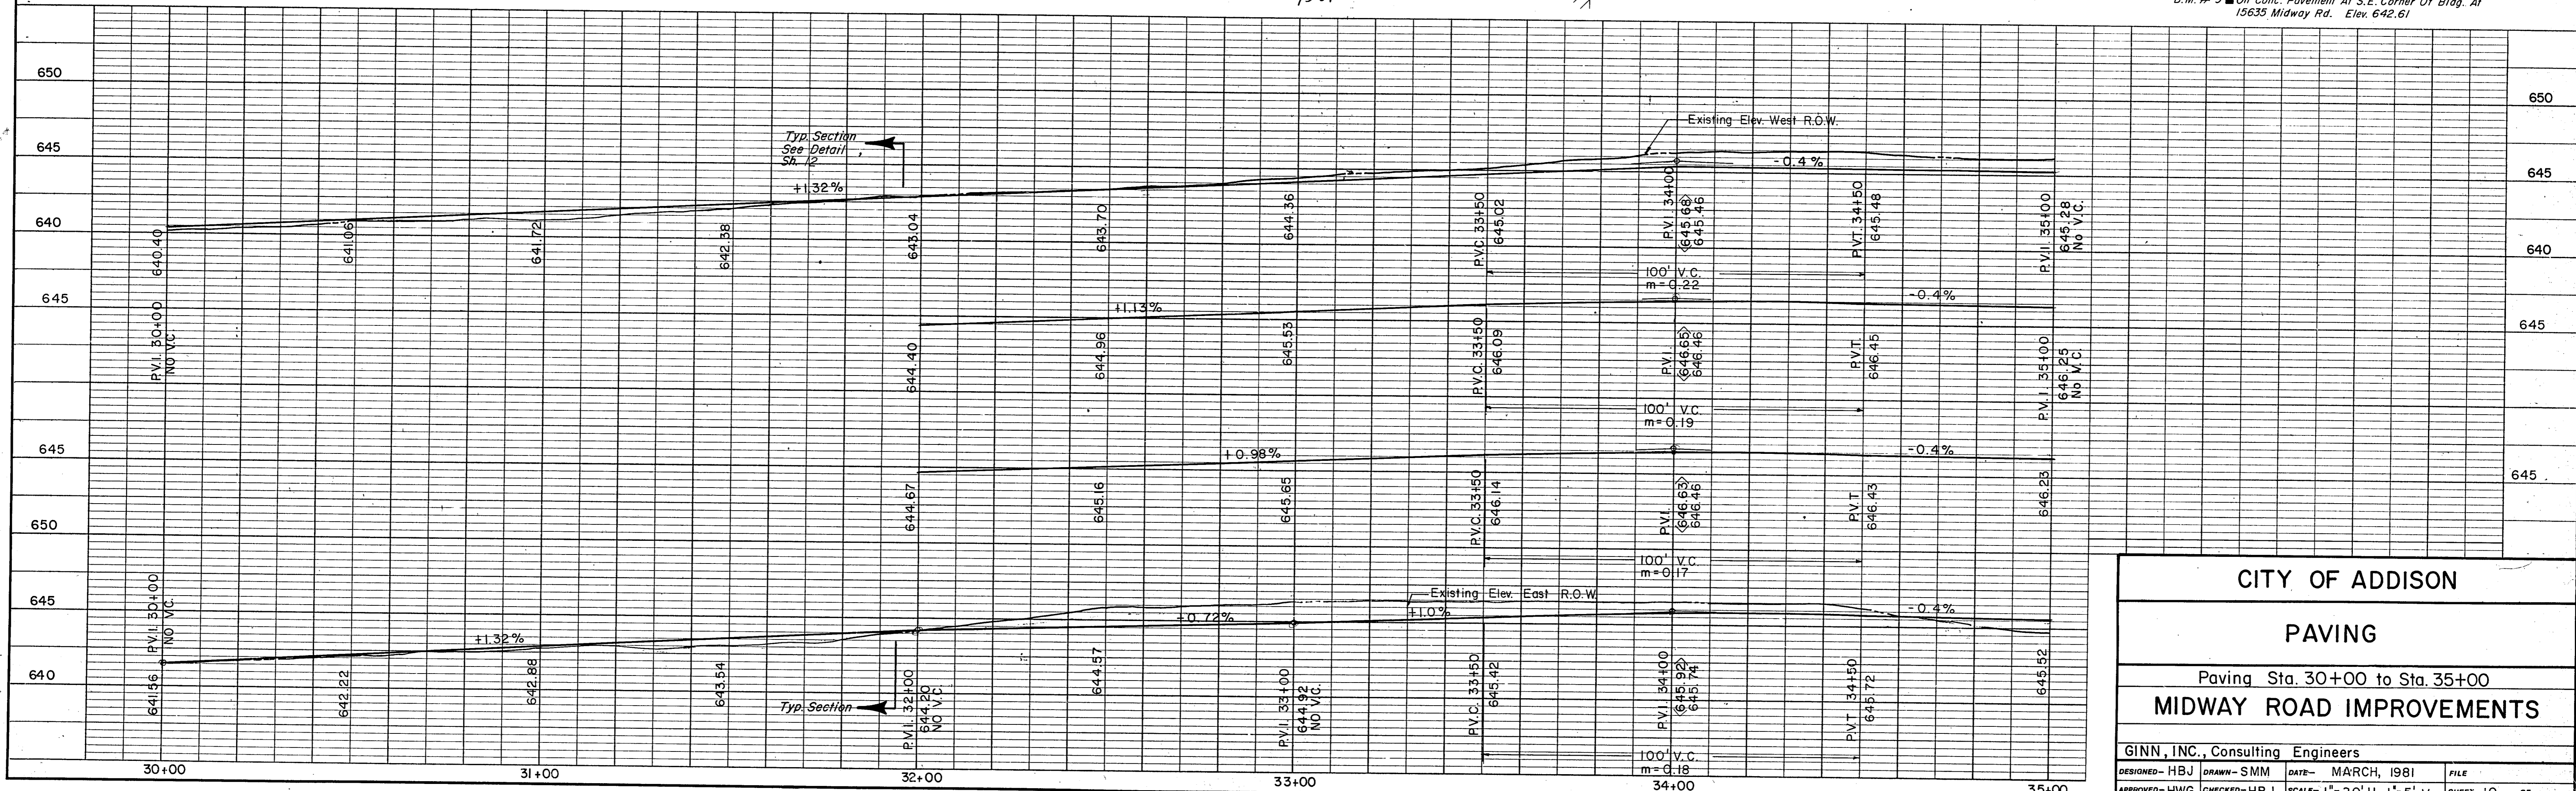



CITY OF ADDISON

PAVING

Paving Sta. 30+00 to Sta. 35+00
MIDWAY ROAD IMPROVEMENTS

GINN, INC., Consulting Engineers

DESIGNED - HBJ DRAWN - SMM DATE - MARCH, 1981 FILE
 APPROVED - HWG CHECKED - HBJ SCALE - 1" = 20' H, 1" = 5' V SHEET 10 OF

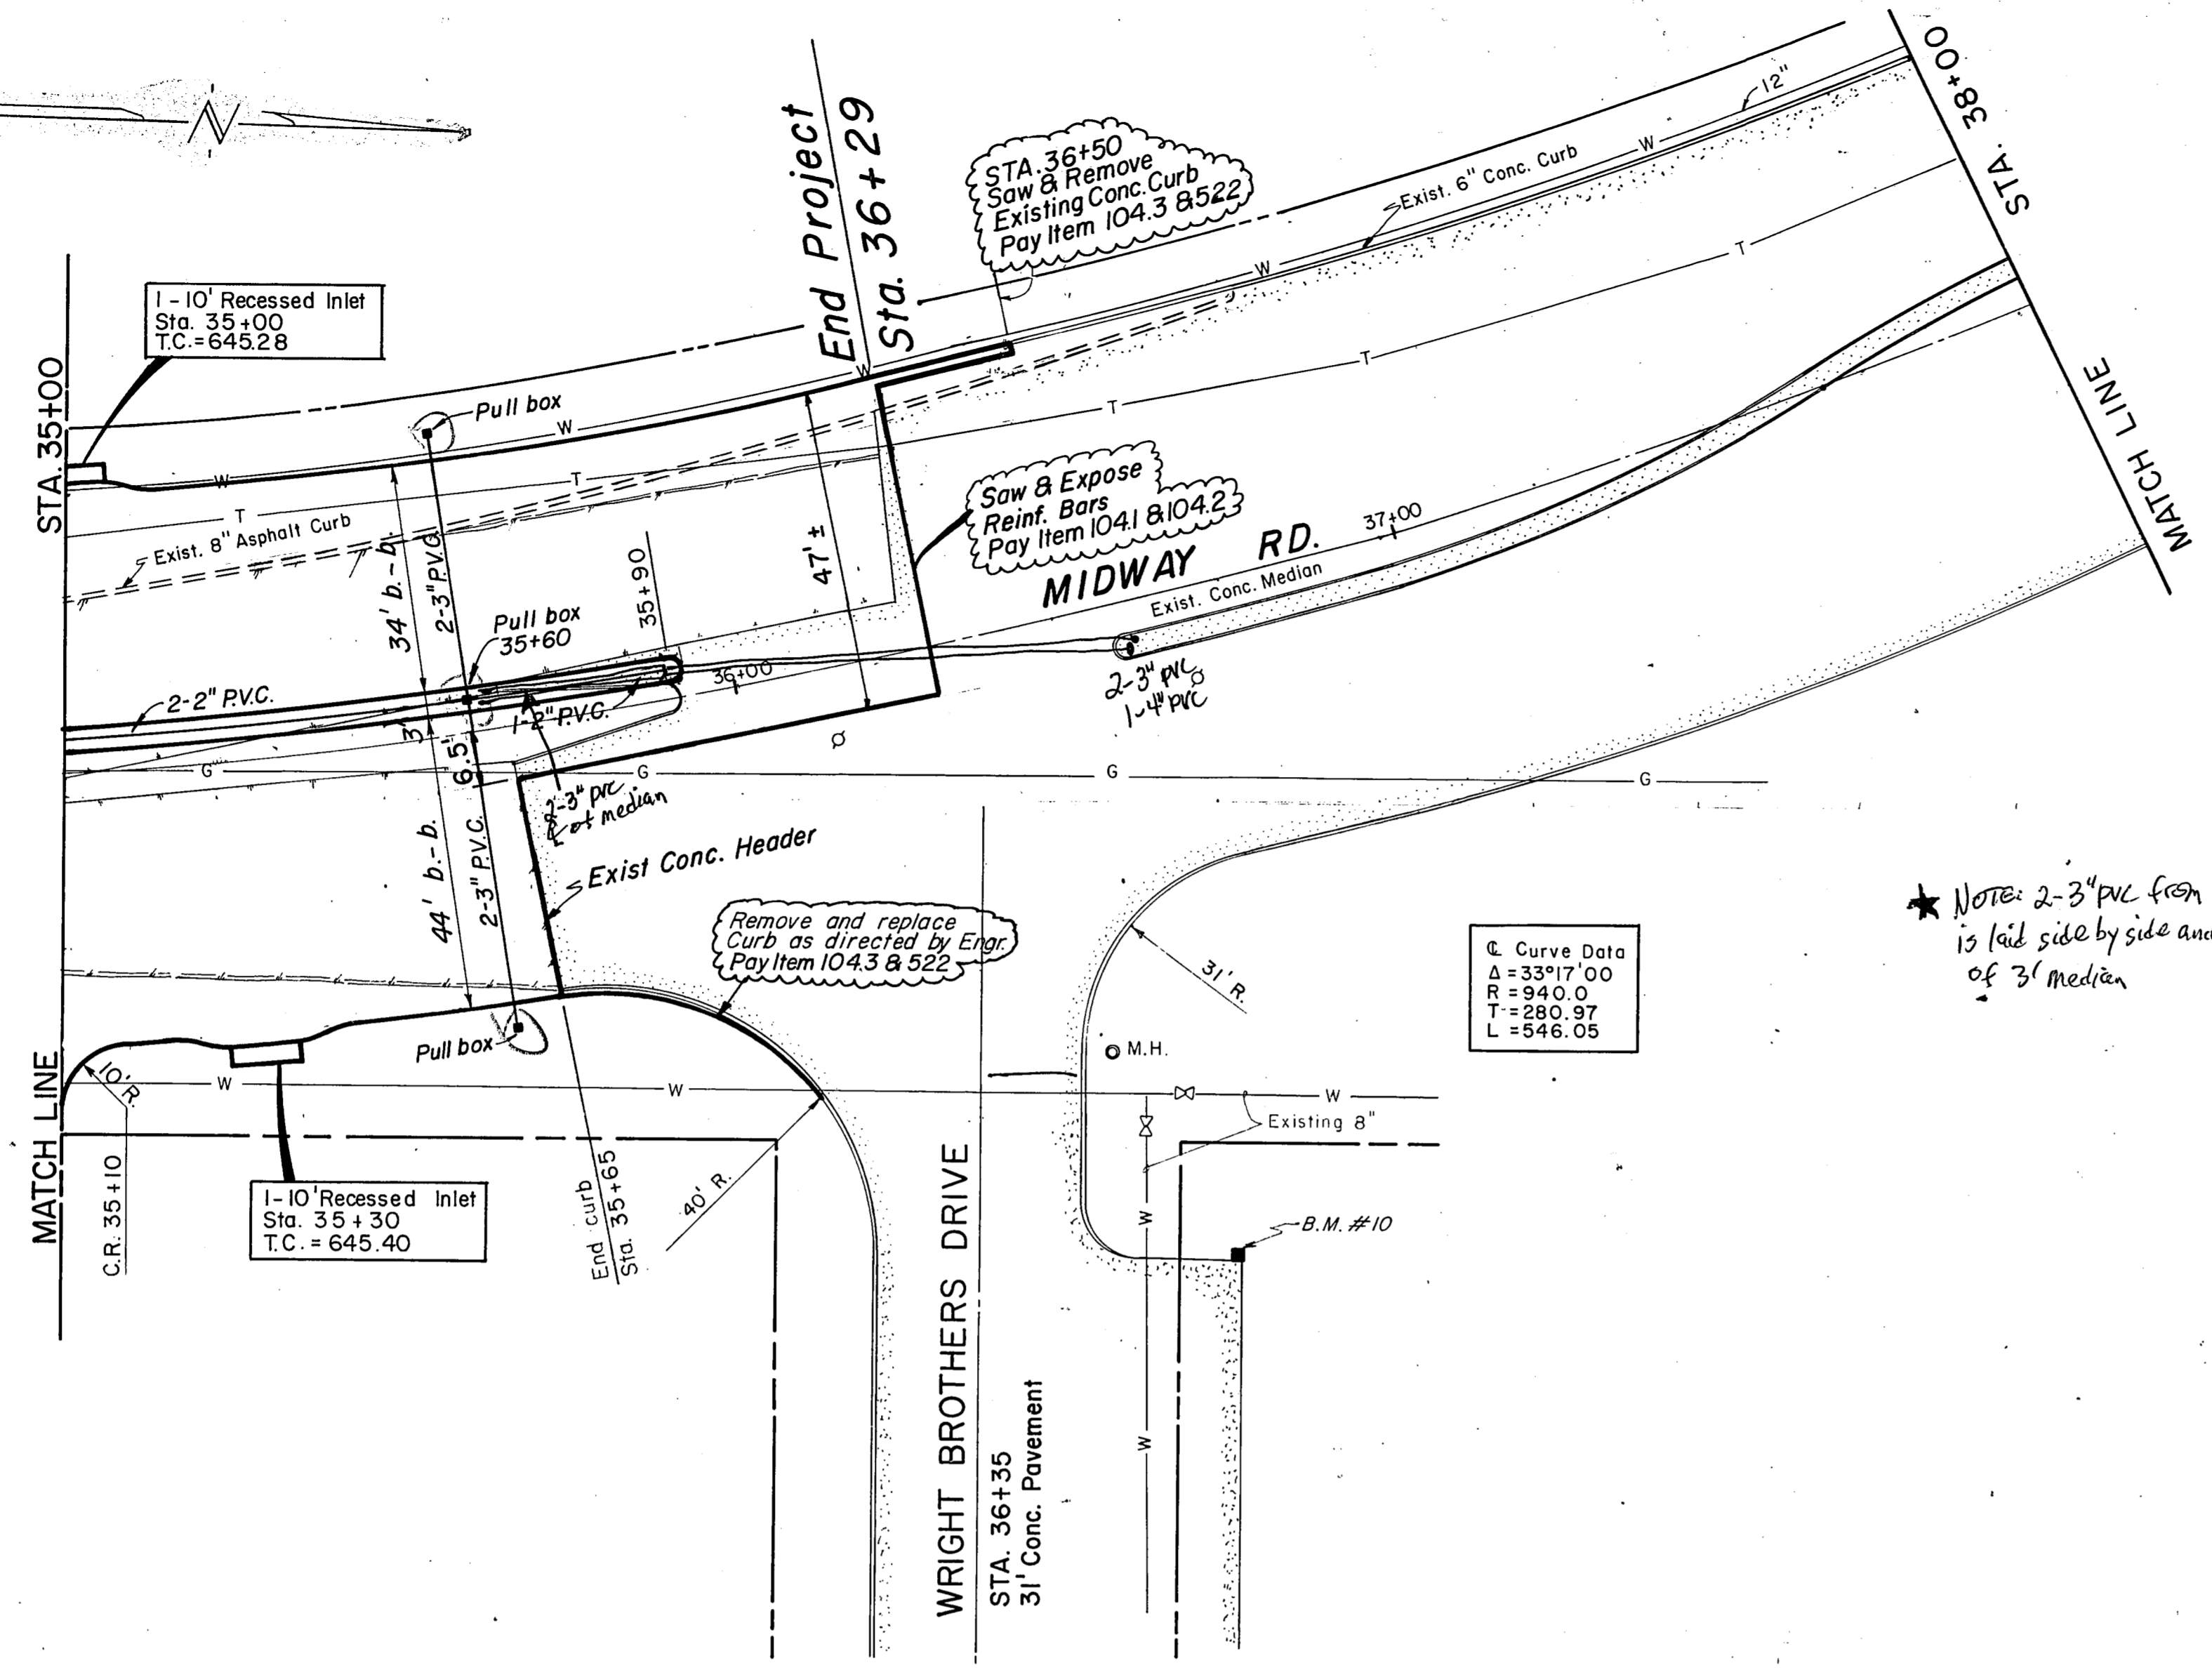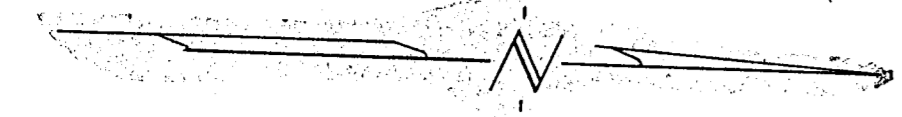


★ Note: 2-3" PVC from 35+90 to 36+60 is laid side by side and in the center of 3' median


Curve Data

Δ	= 33°17'00
R	= 940.0
T	= 280.97
L	= 546.05


B.M. #10 On Corner Curb At N.W. Corner Of Parking At Wright Brothers Dr. E. 13700 Midway Rd. Elev. 647.28

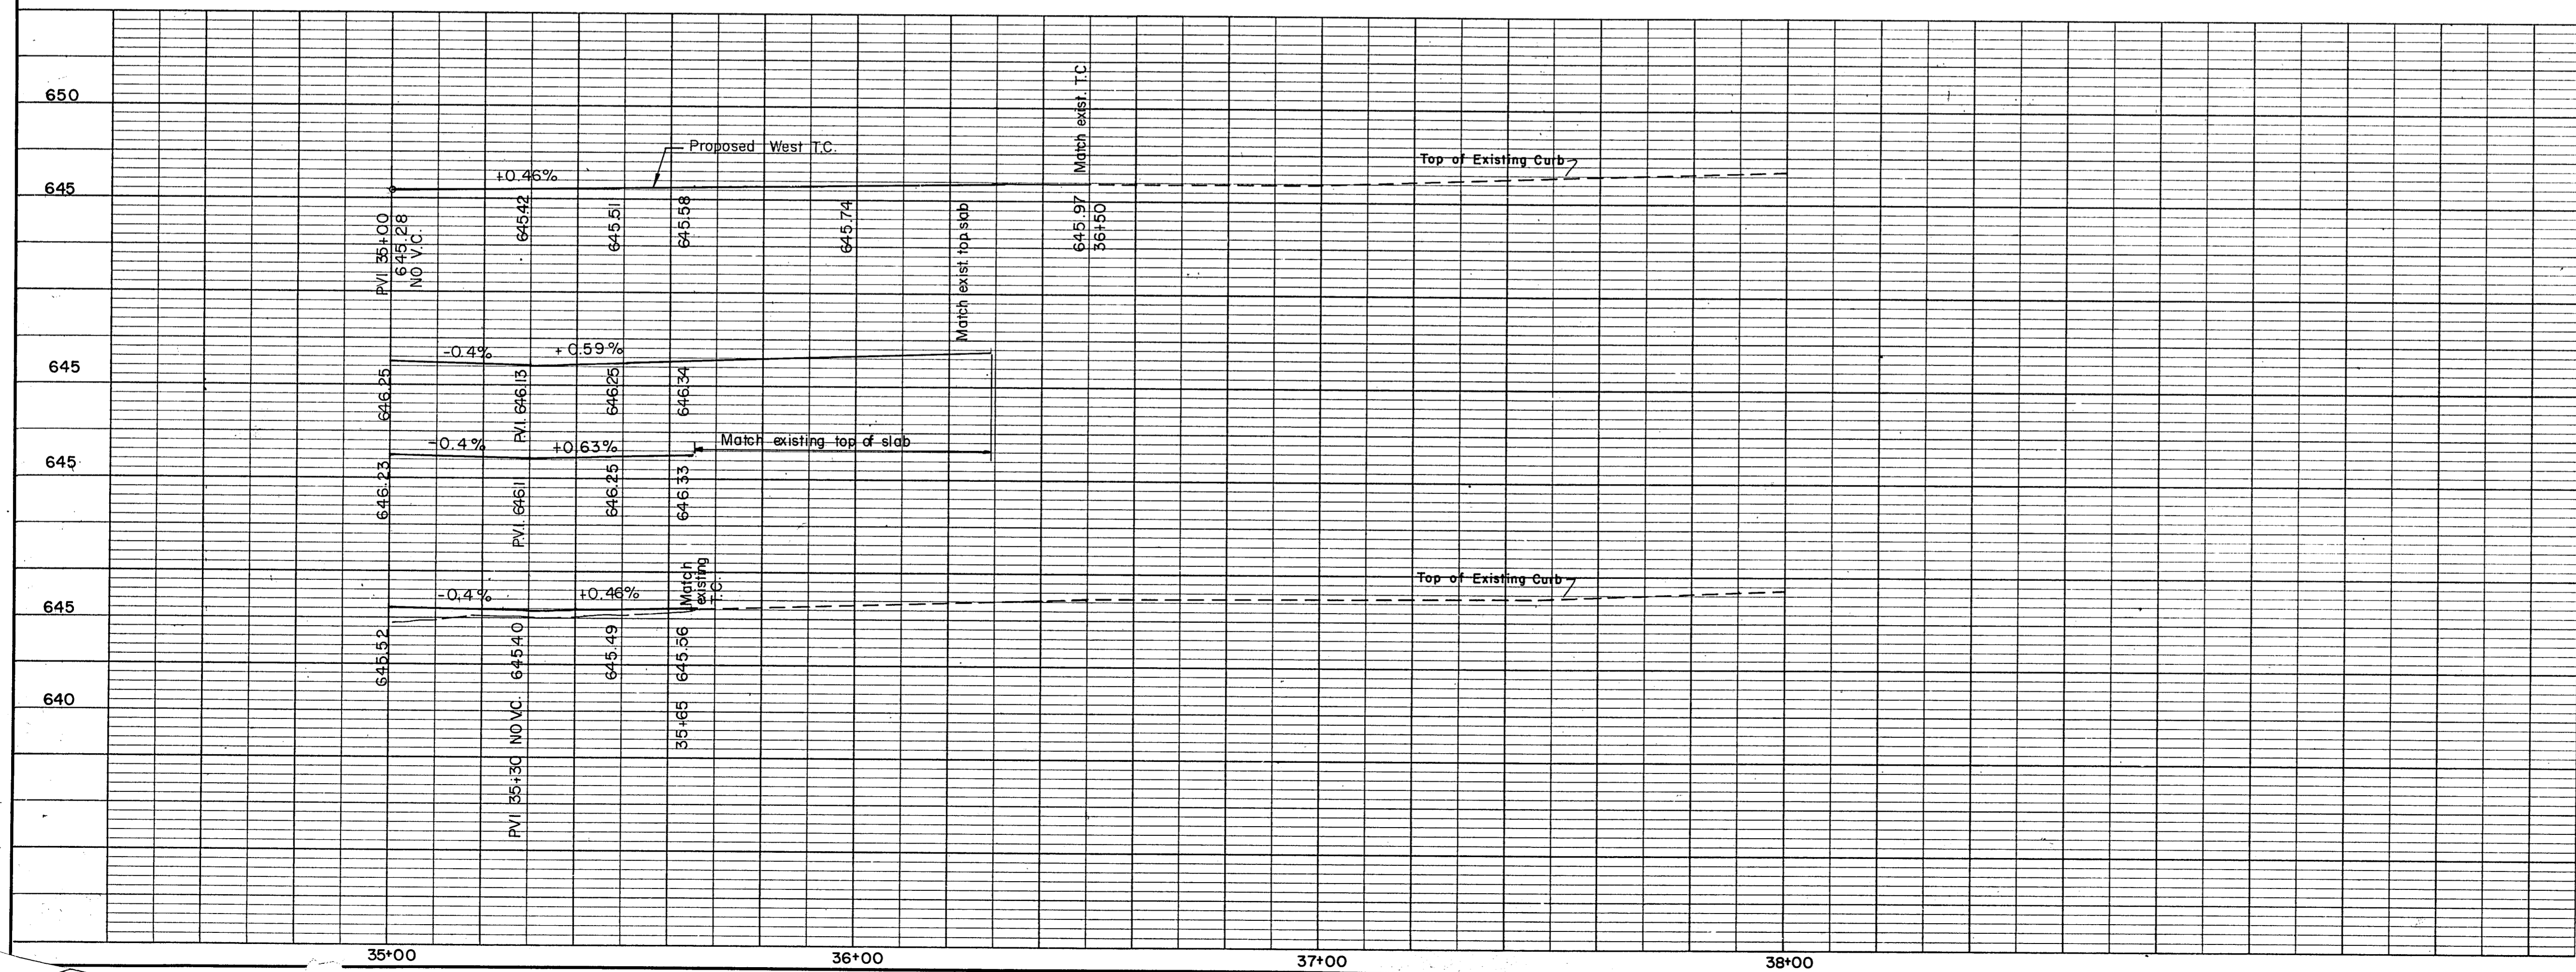


CITY OF ADDISON			
PAVING			
Paving Sta. 35+00 to Sta. 36+29			
MIDWAY ROAD IMPROVEMENTS			
GINN, INC., Consulting Engineers			
DESIGNED - HBJ	DRAWN - GF-SM	DATE - March, 1981	FILE
APPROVED - HWG	CHECKED - HBJ	SCALE - 1" = 20' H, 1" = 5' V	SHEET 11 OF

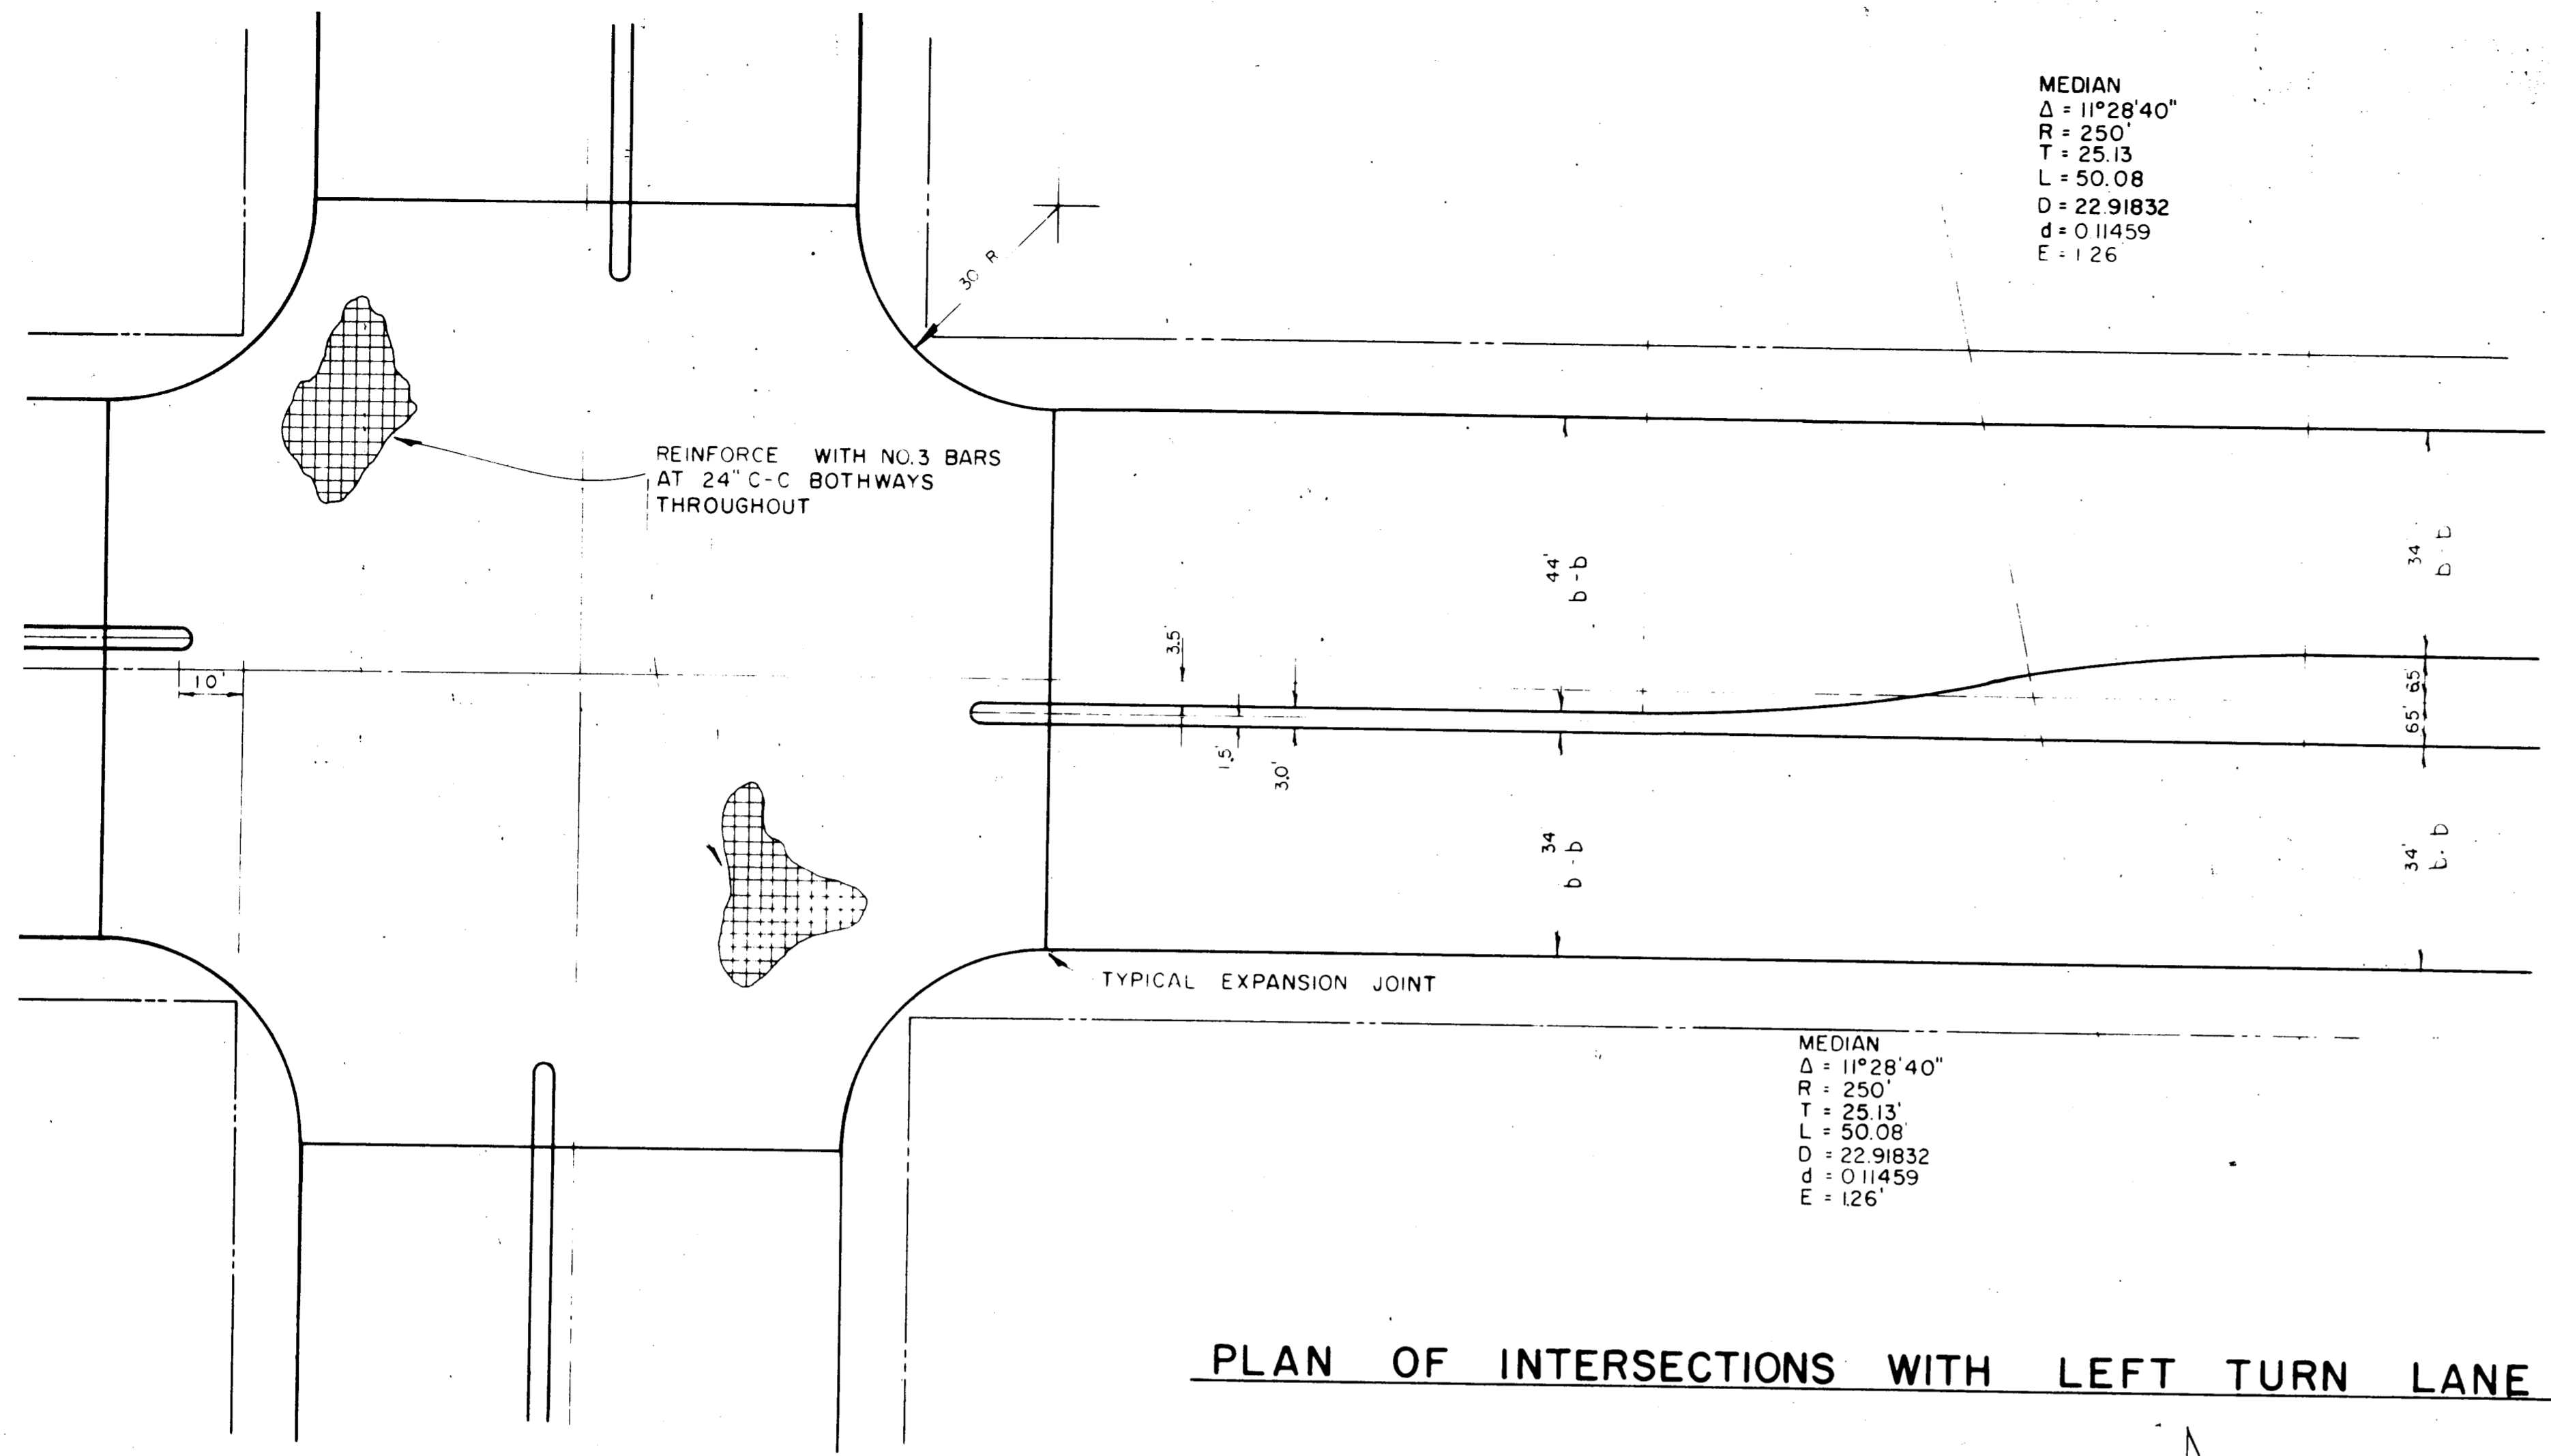

PLAN OF INTERSECTIONS WITH LEFT TURN LANE

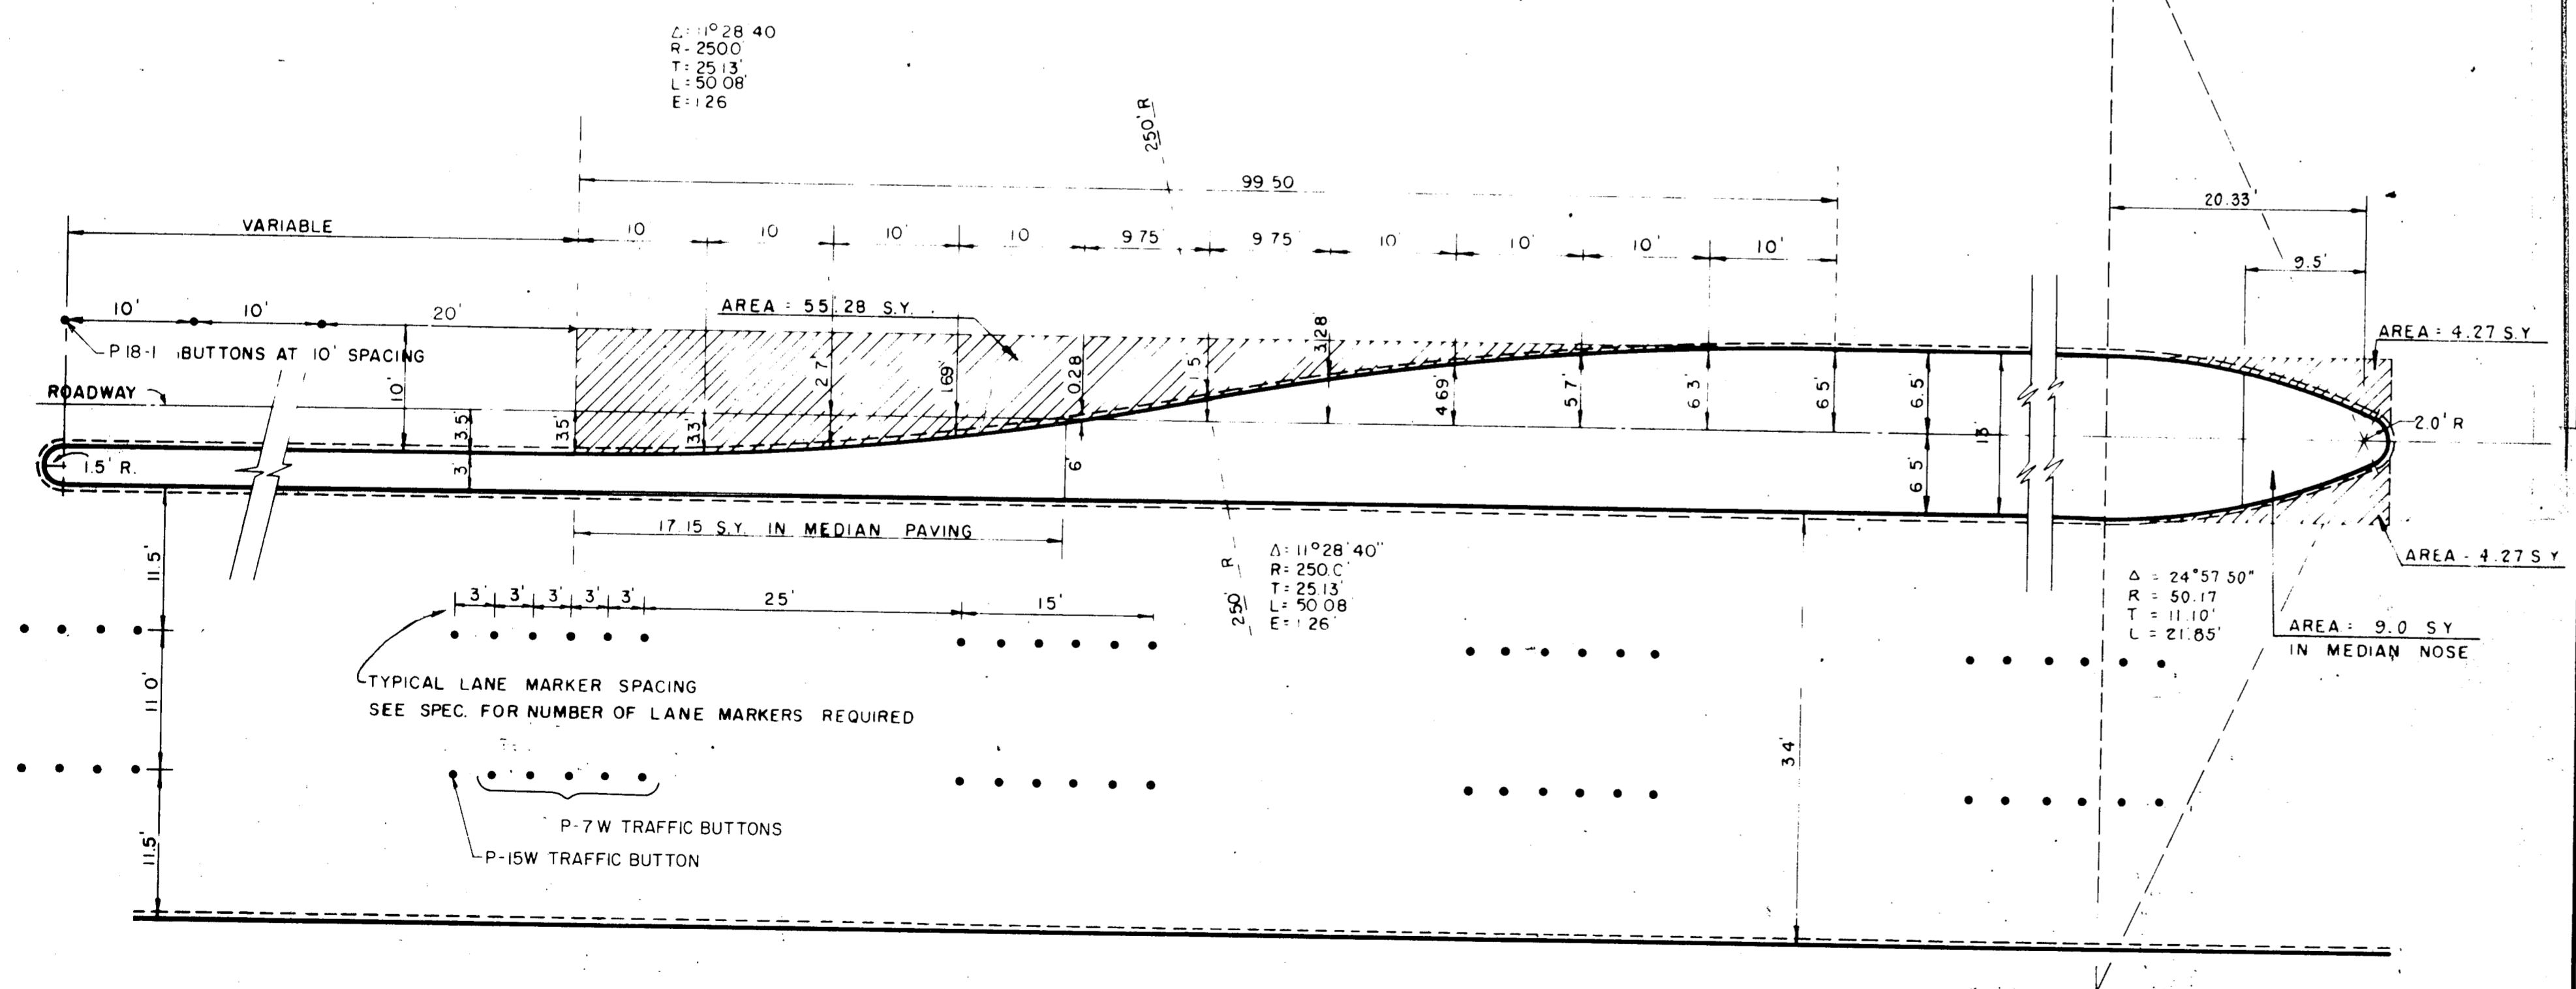


LEFT TURN LANE & LANE MARKER DETAIL

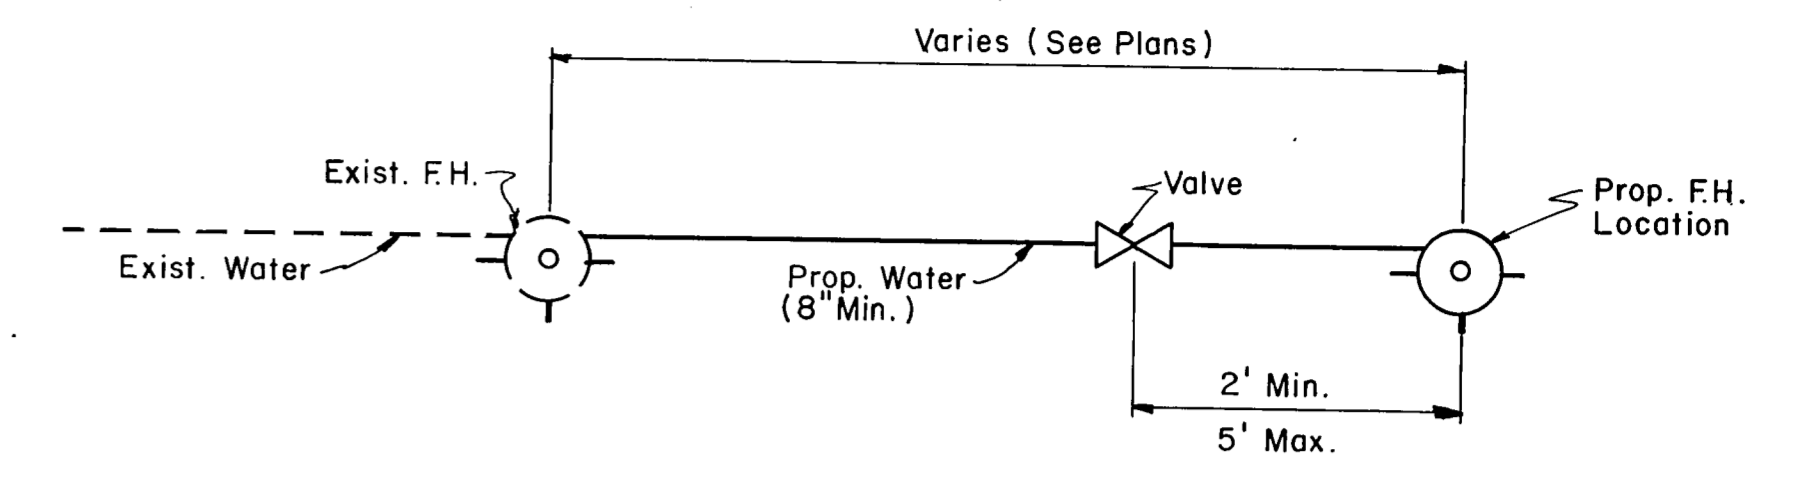


Salvage & Reuse
 Fire Hydrant
 Valve
 90° Bend

FIRE HYDRANT RELOCATION DETAIL

Typical Section
 Sta. 3+00 to 5+50
 Sta. 10+50 to 32+00

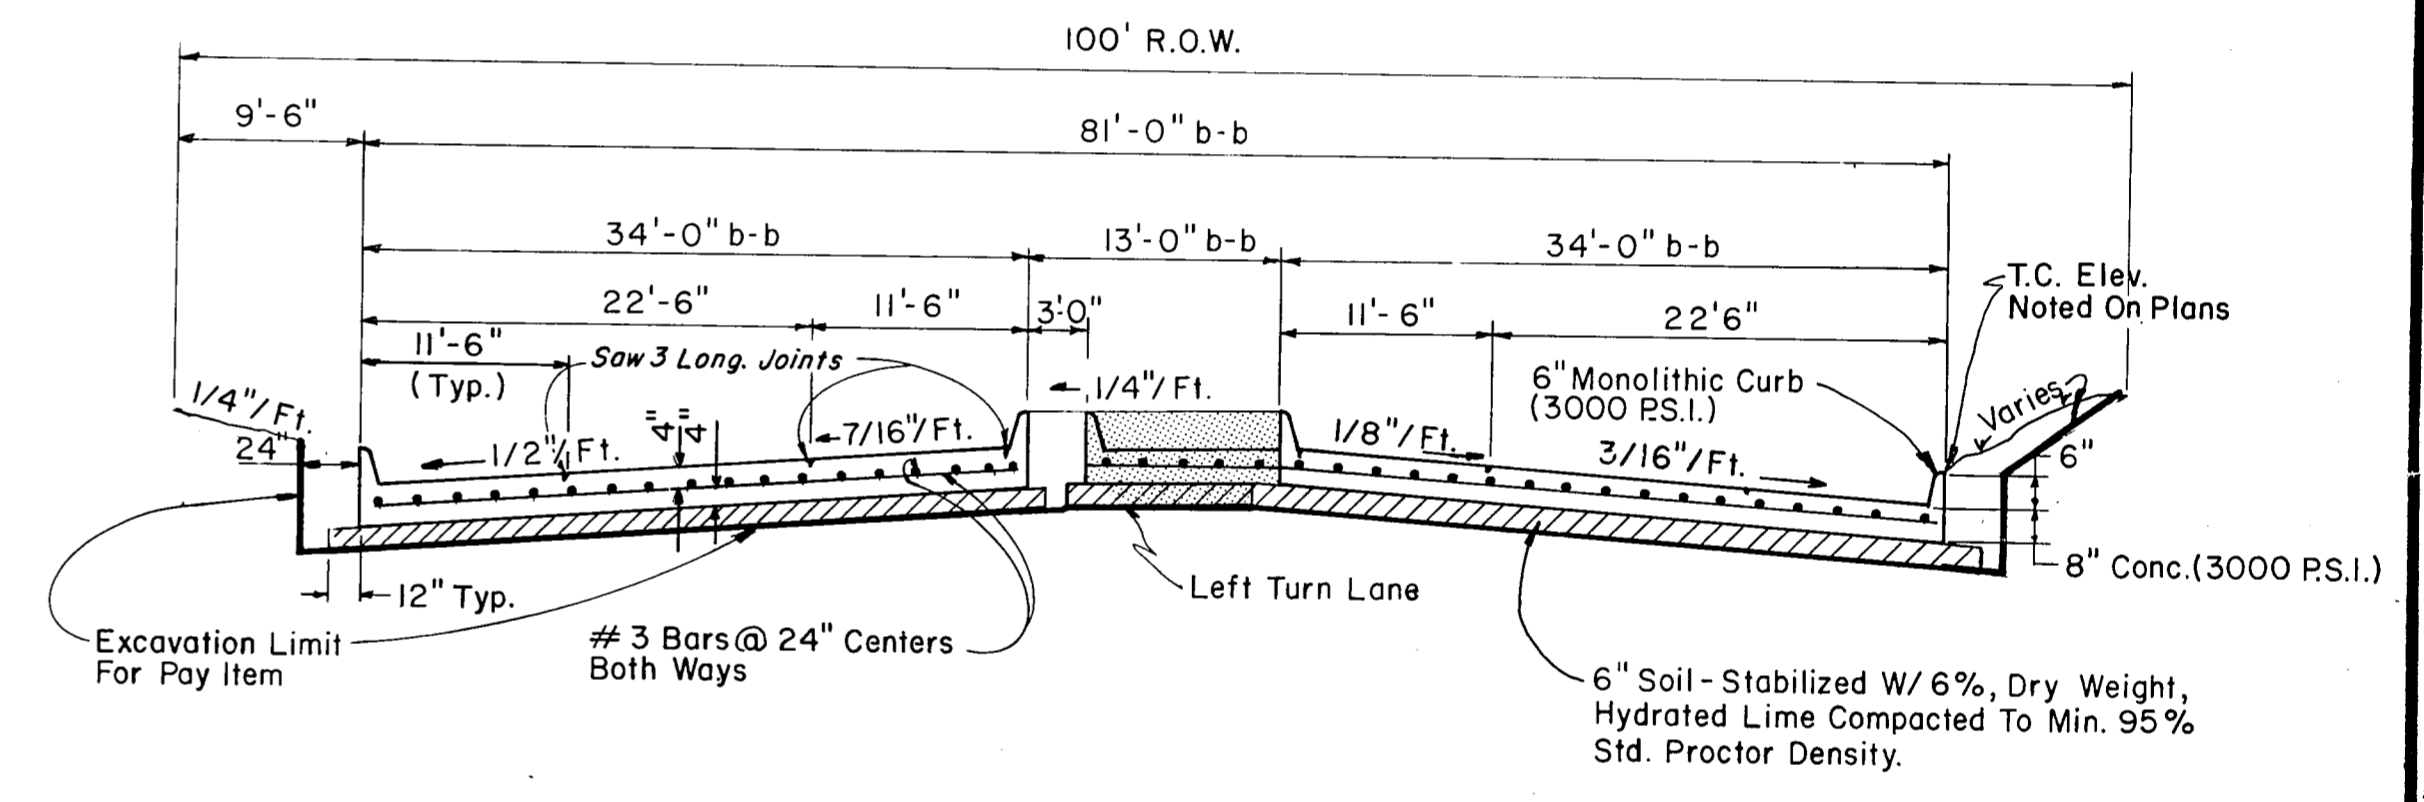


PAVING SECTION DETAIL

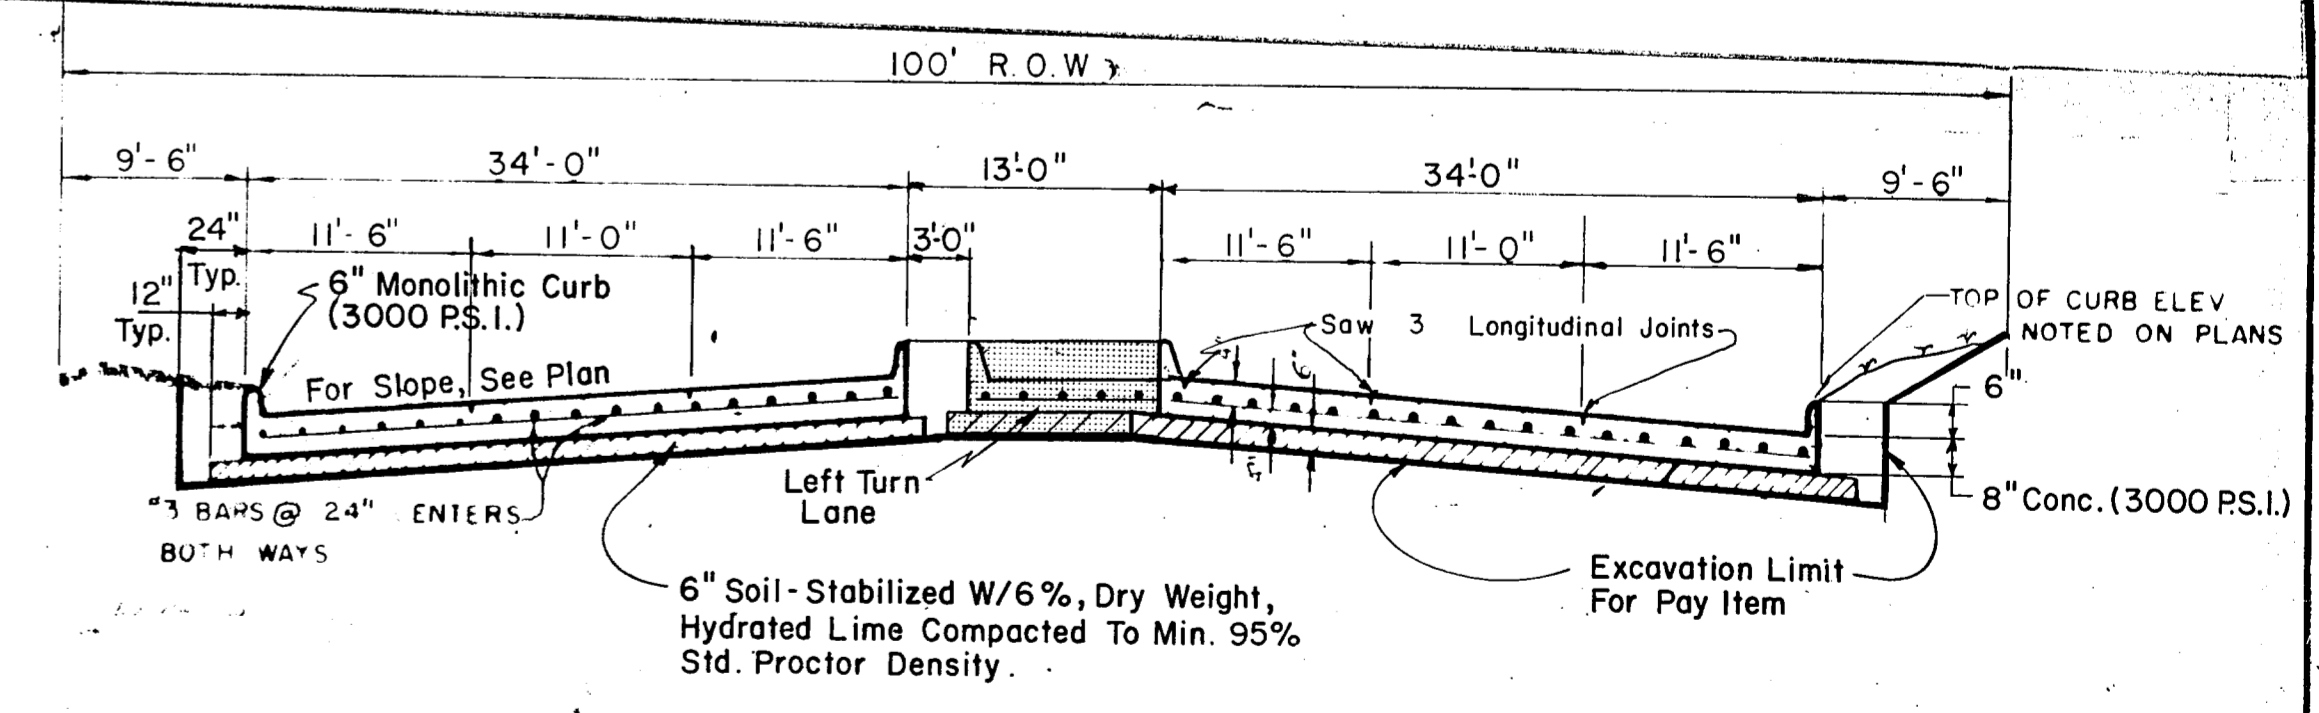

PAVING SECTION DETAIL

Sta. 0+80.5 to 3+00,
 Sta. 5+50 to 10+50,
 Sta. 32+00 to 36+50

CITY OF ADDISON DALLAS COUNTY, TEXAS MIDWAY ROAD			
PAVING DETAILS A			
GINN, INC. Consulting Engineers - Dallas, Texas			
Designed - H.B.J. / Crown - S.M.M.	Date - MARCH, 1981	Scale - NONE	Sheet 12 of
Approved - H.W.G.	Checked - G.F.		


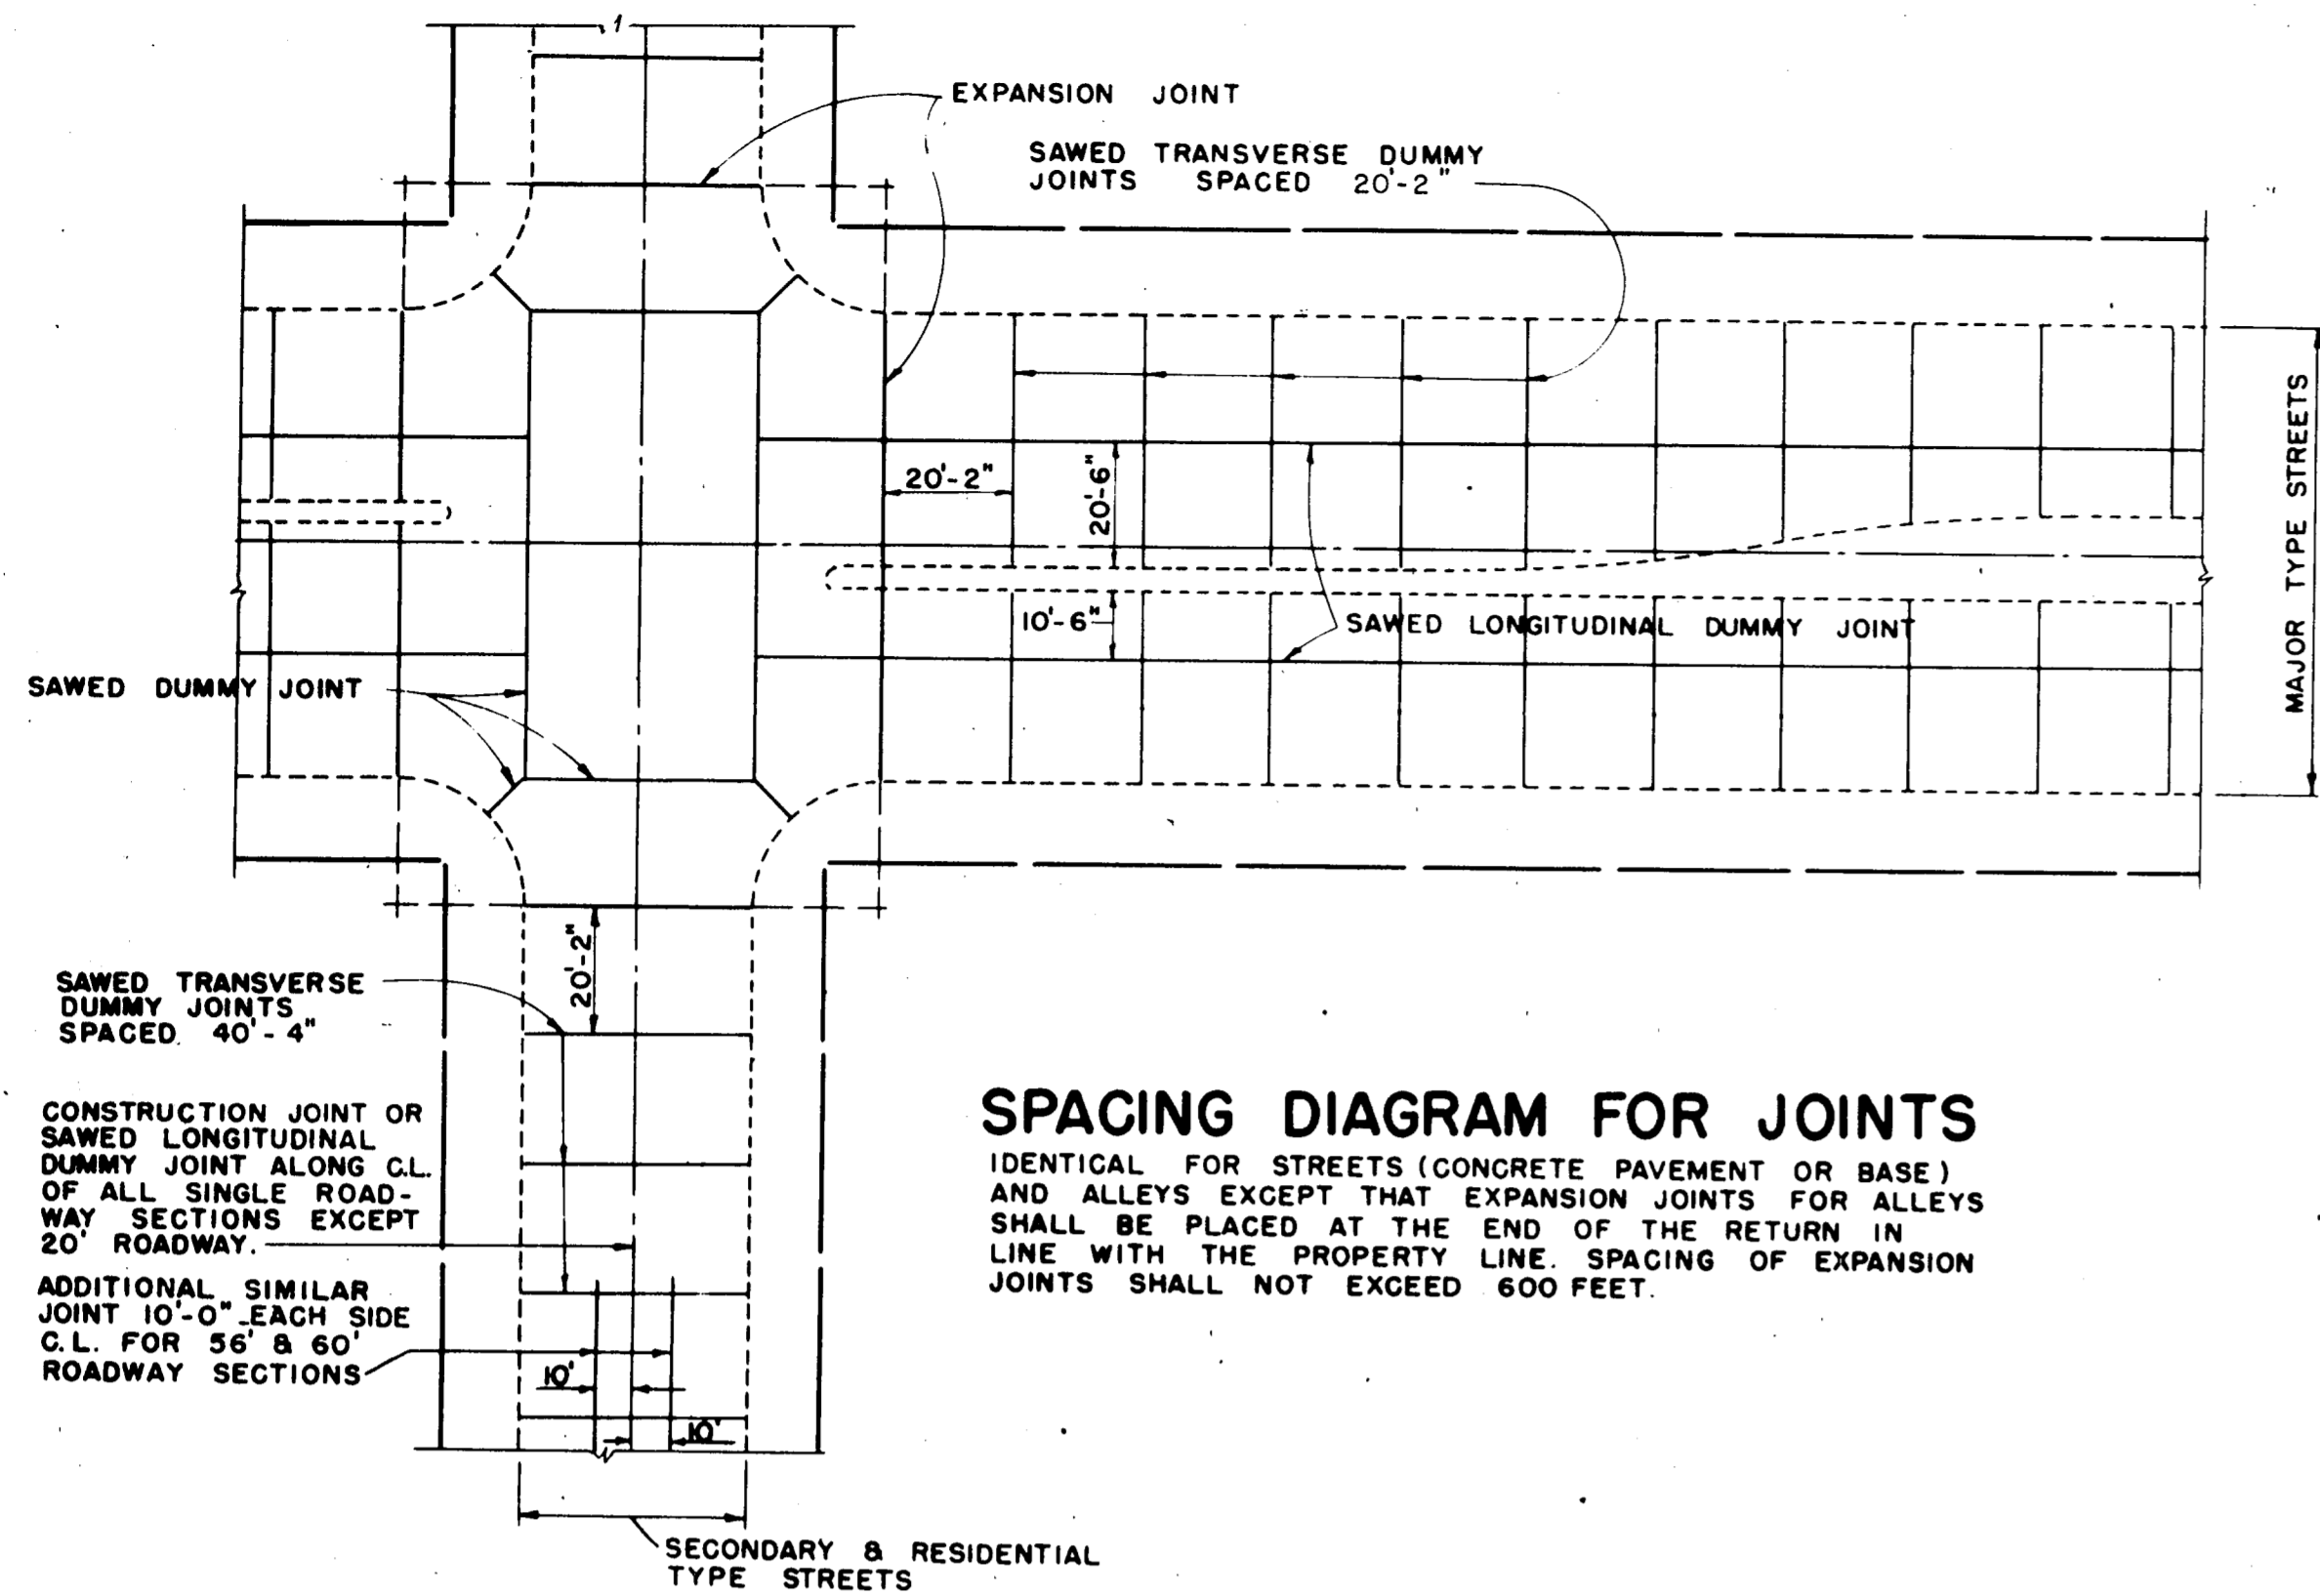


SPACING DIAGRAM FOR JOINTS

IDENTICAL FOR STREETS (CONCRETE PAVEMENT OR BASE) AND ALLEYS EXCEPT THAT EXPANSION JOINTS FOR ALLEYS SHALL BE PLACED AT THE END OF THE RETURN IN LINE WITH THE PROPERTY LINE. SPACING OF EXPANSION JOINTS SHALL NOT EXCEED 600 FEET.


SEPARATE CURB & GUTTER
REINFORCEMENT SHALL BE NO. 5 BARS

CURB AND CURB & GUTTER

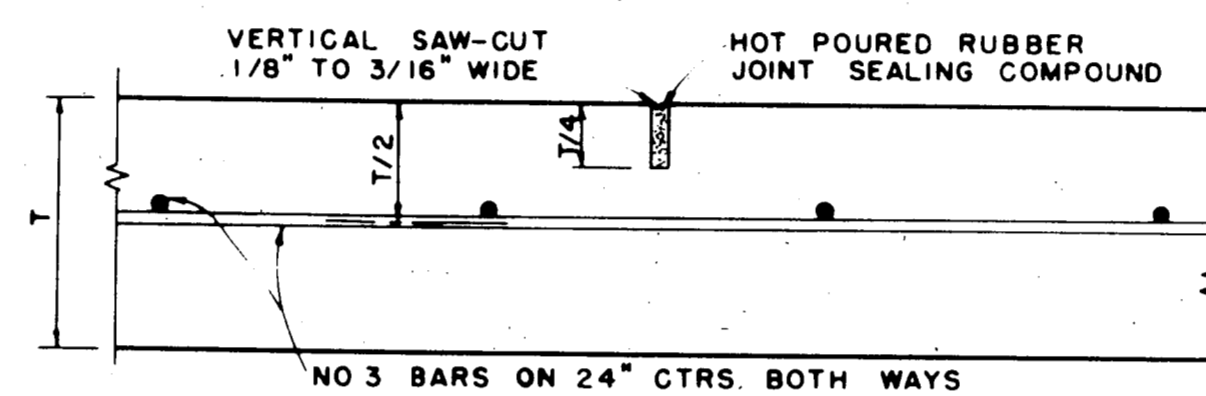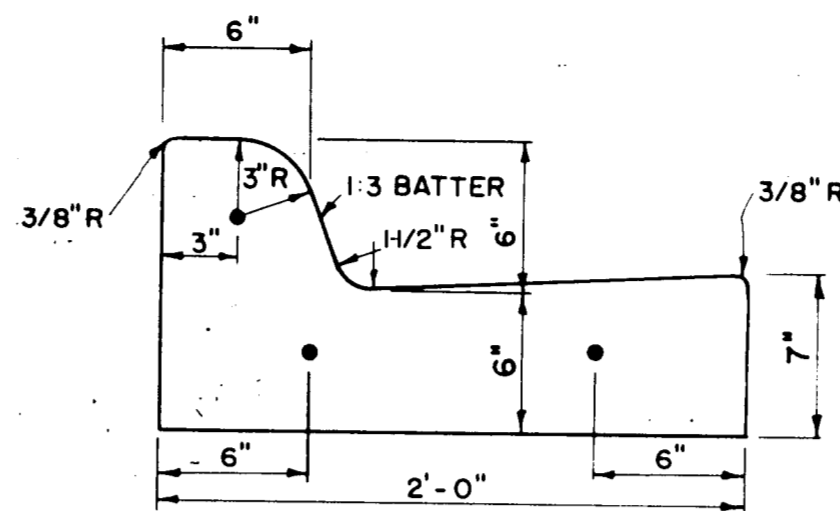


SAWED DUMMY JOINT

IDENTICAL FOR STREETS AND ALLEYS EXCEPT ALLEY LONGITUDINAL REINFORCEMENT BARS

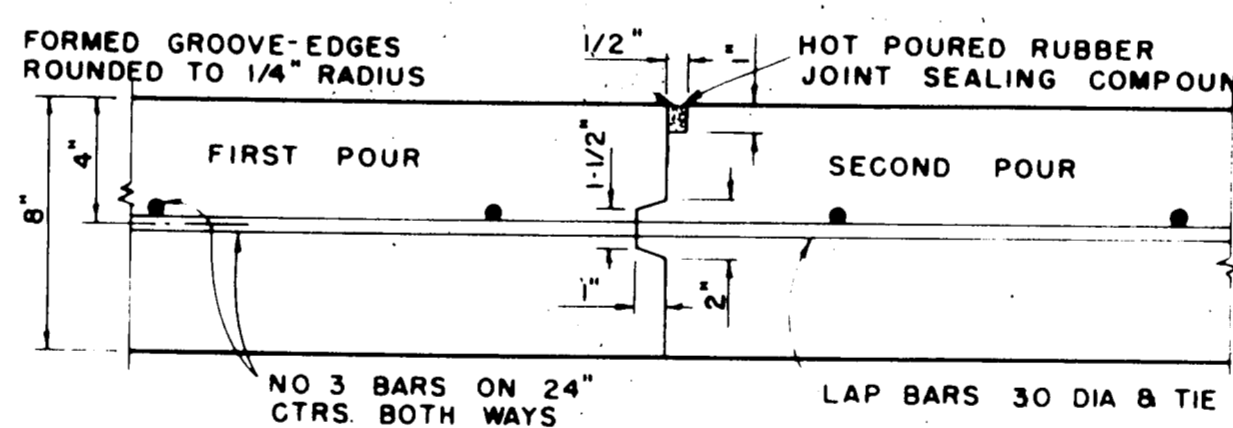


CONSTRUCTION JOINT

FOR 8" THICKNESS PAVEMENT OR BASE

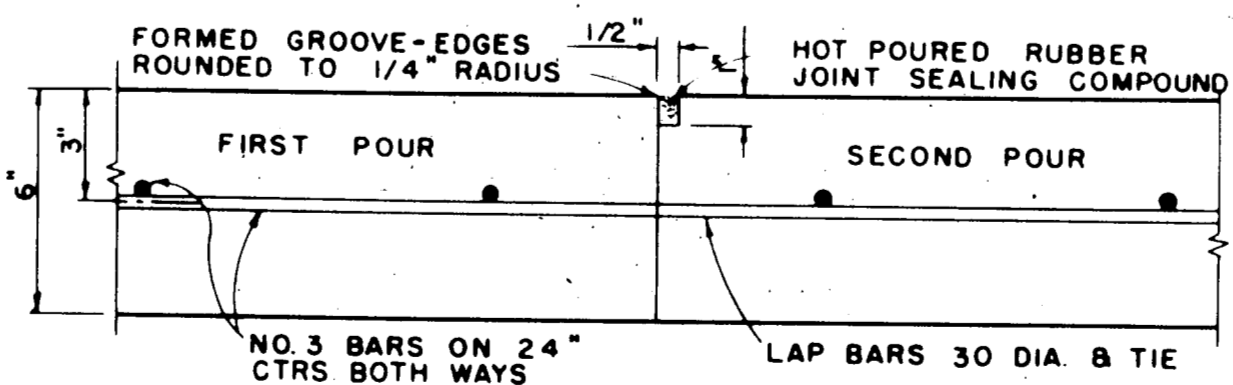


CONSTRUCTION JOINT

FOR 6" THICKNESS PAVEMENT OR BASE IDENTICAL FOR STREETS AND ALLEYS EXCEPT ALLEY LONGITUDINAL REINFORCEMENT BARS

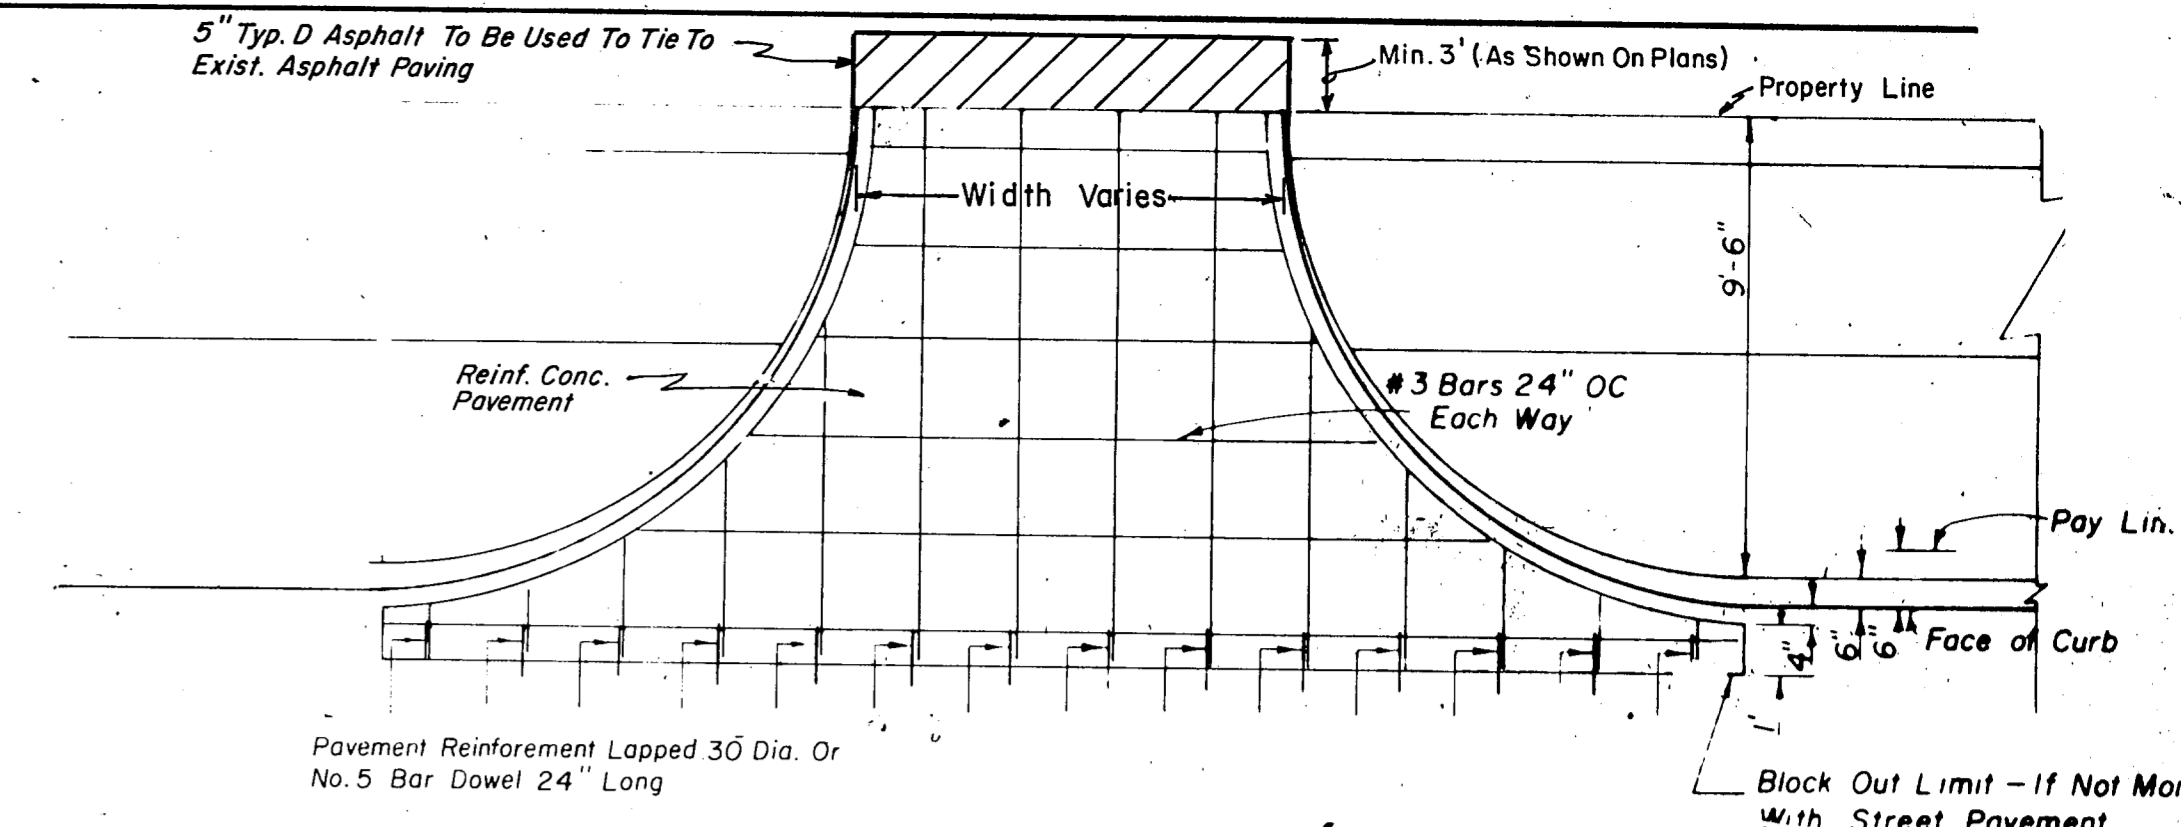


DRIVEWAY PAVING DETAILS

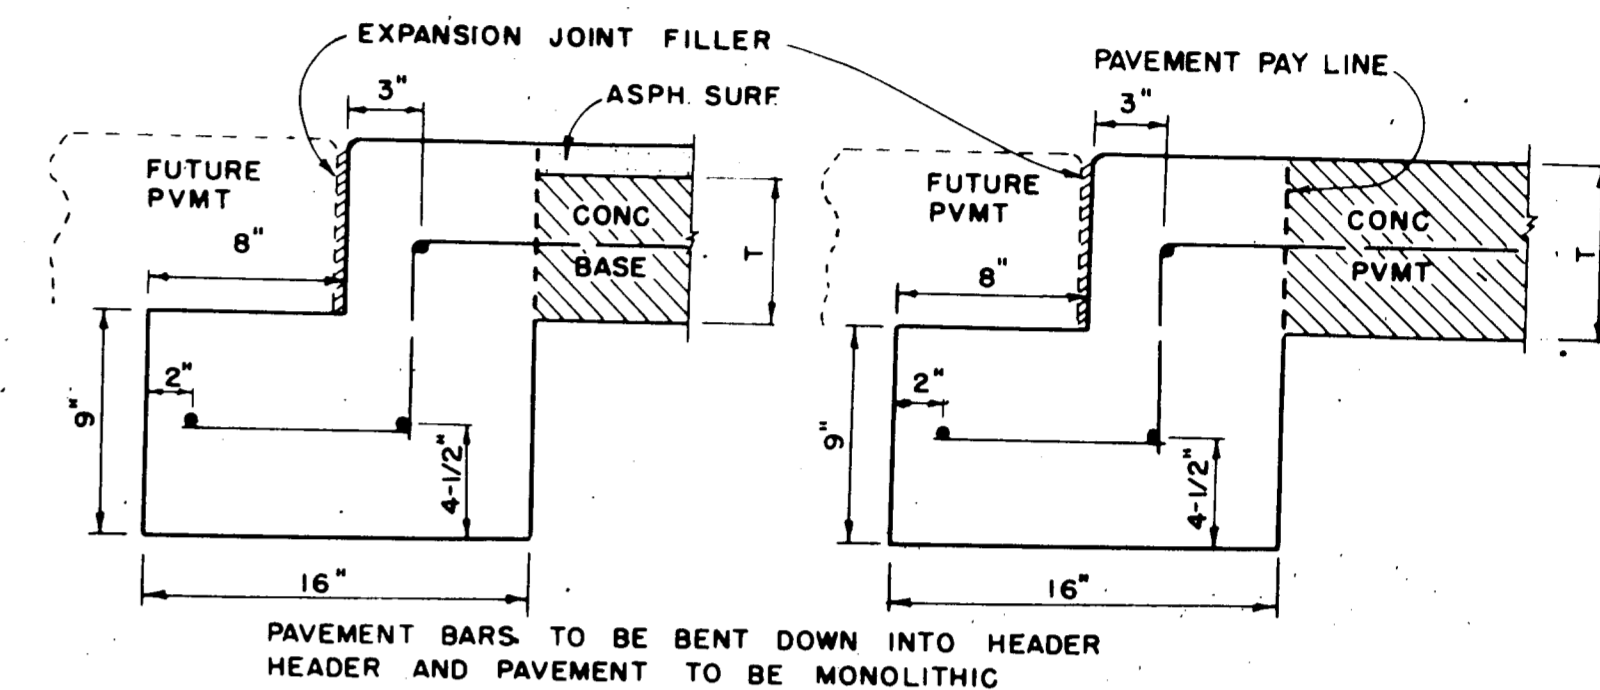


STREET HEADER

FOR ASPHALT PAVEMENT ON CONC BASE, TREAT THE SURFACE AS DETAILED BELOW FOR STREET HEADER.


ALL WORK BETWEEN HEADERS TO BE DONE BY OTHERS UNLESS OTHERWISE SPECIFIED

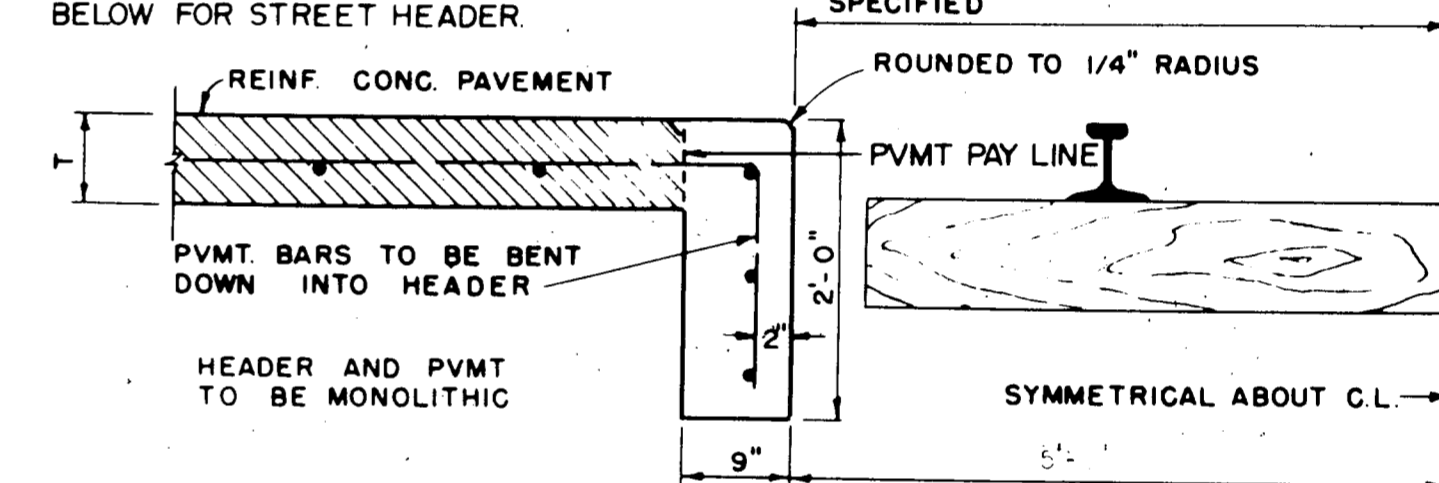


RAILROAD HEADER

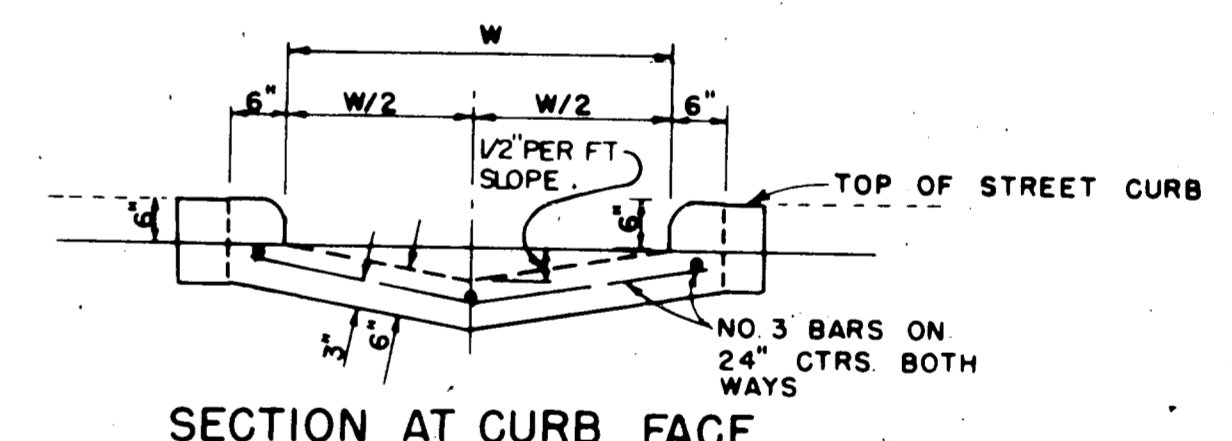

SECTION AT CURB FACE

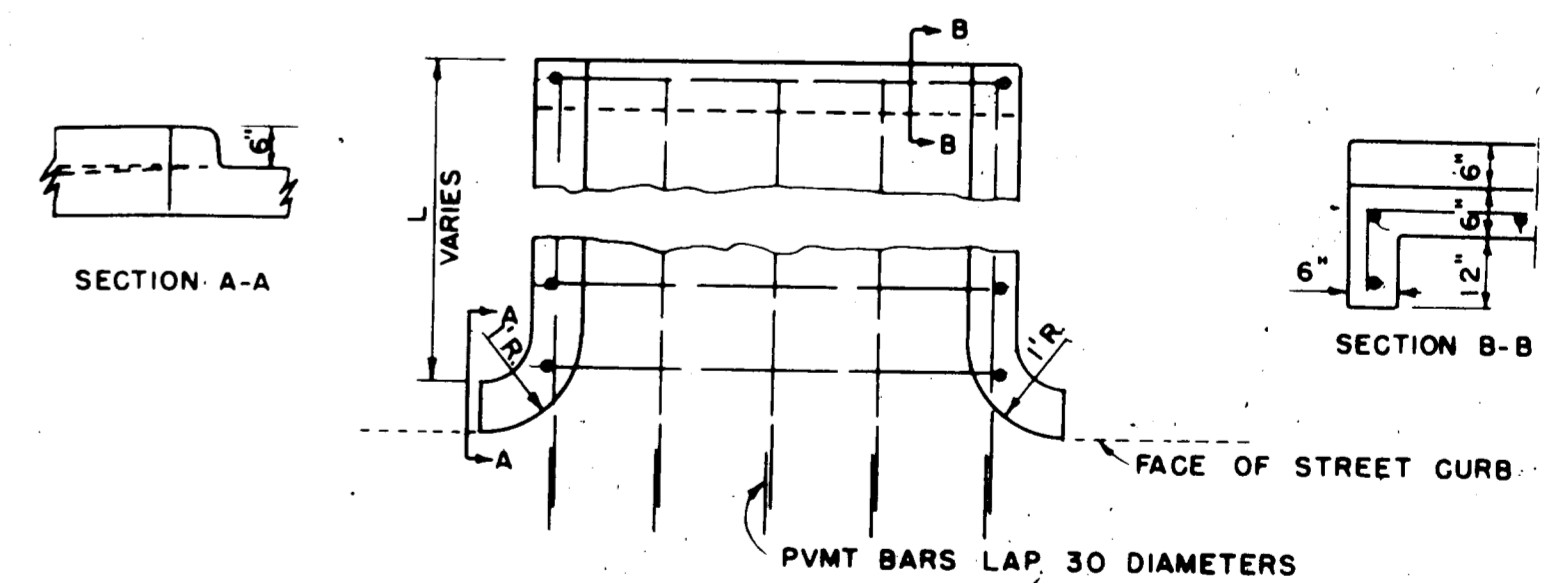


PLAN FLUME

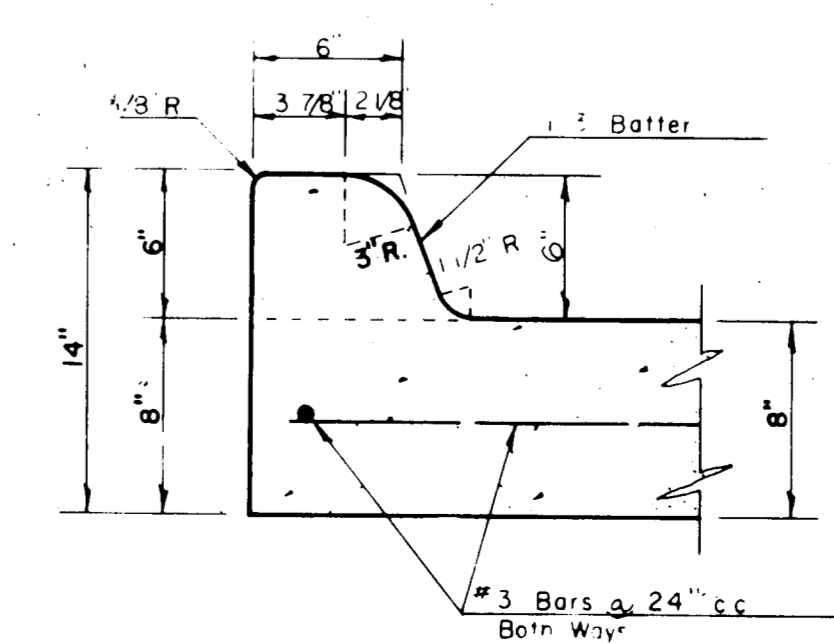

6" INTEGRAL CURB DETAIL

TRANSVERSE EXPANSION JOINT
IDENTICAL FOR STREETS & ALLEYS

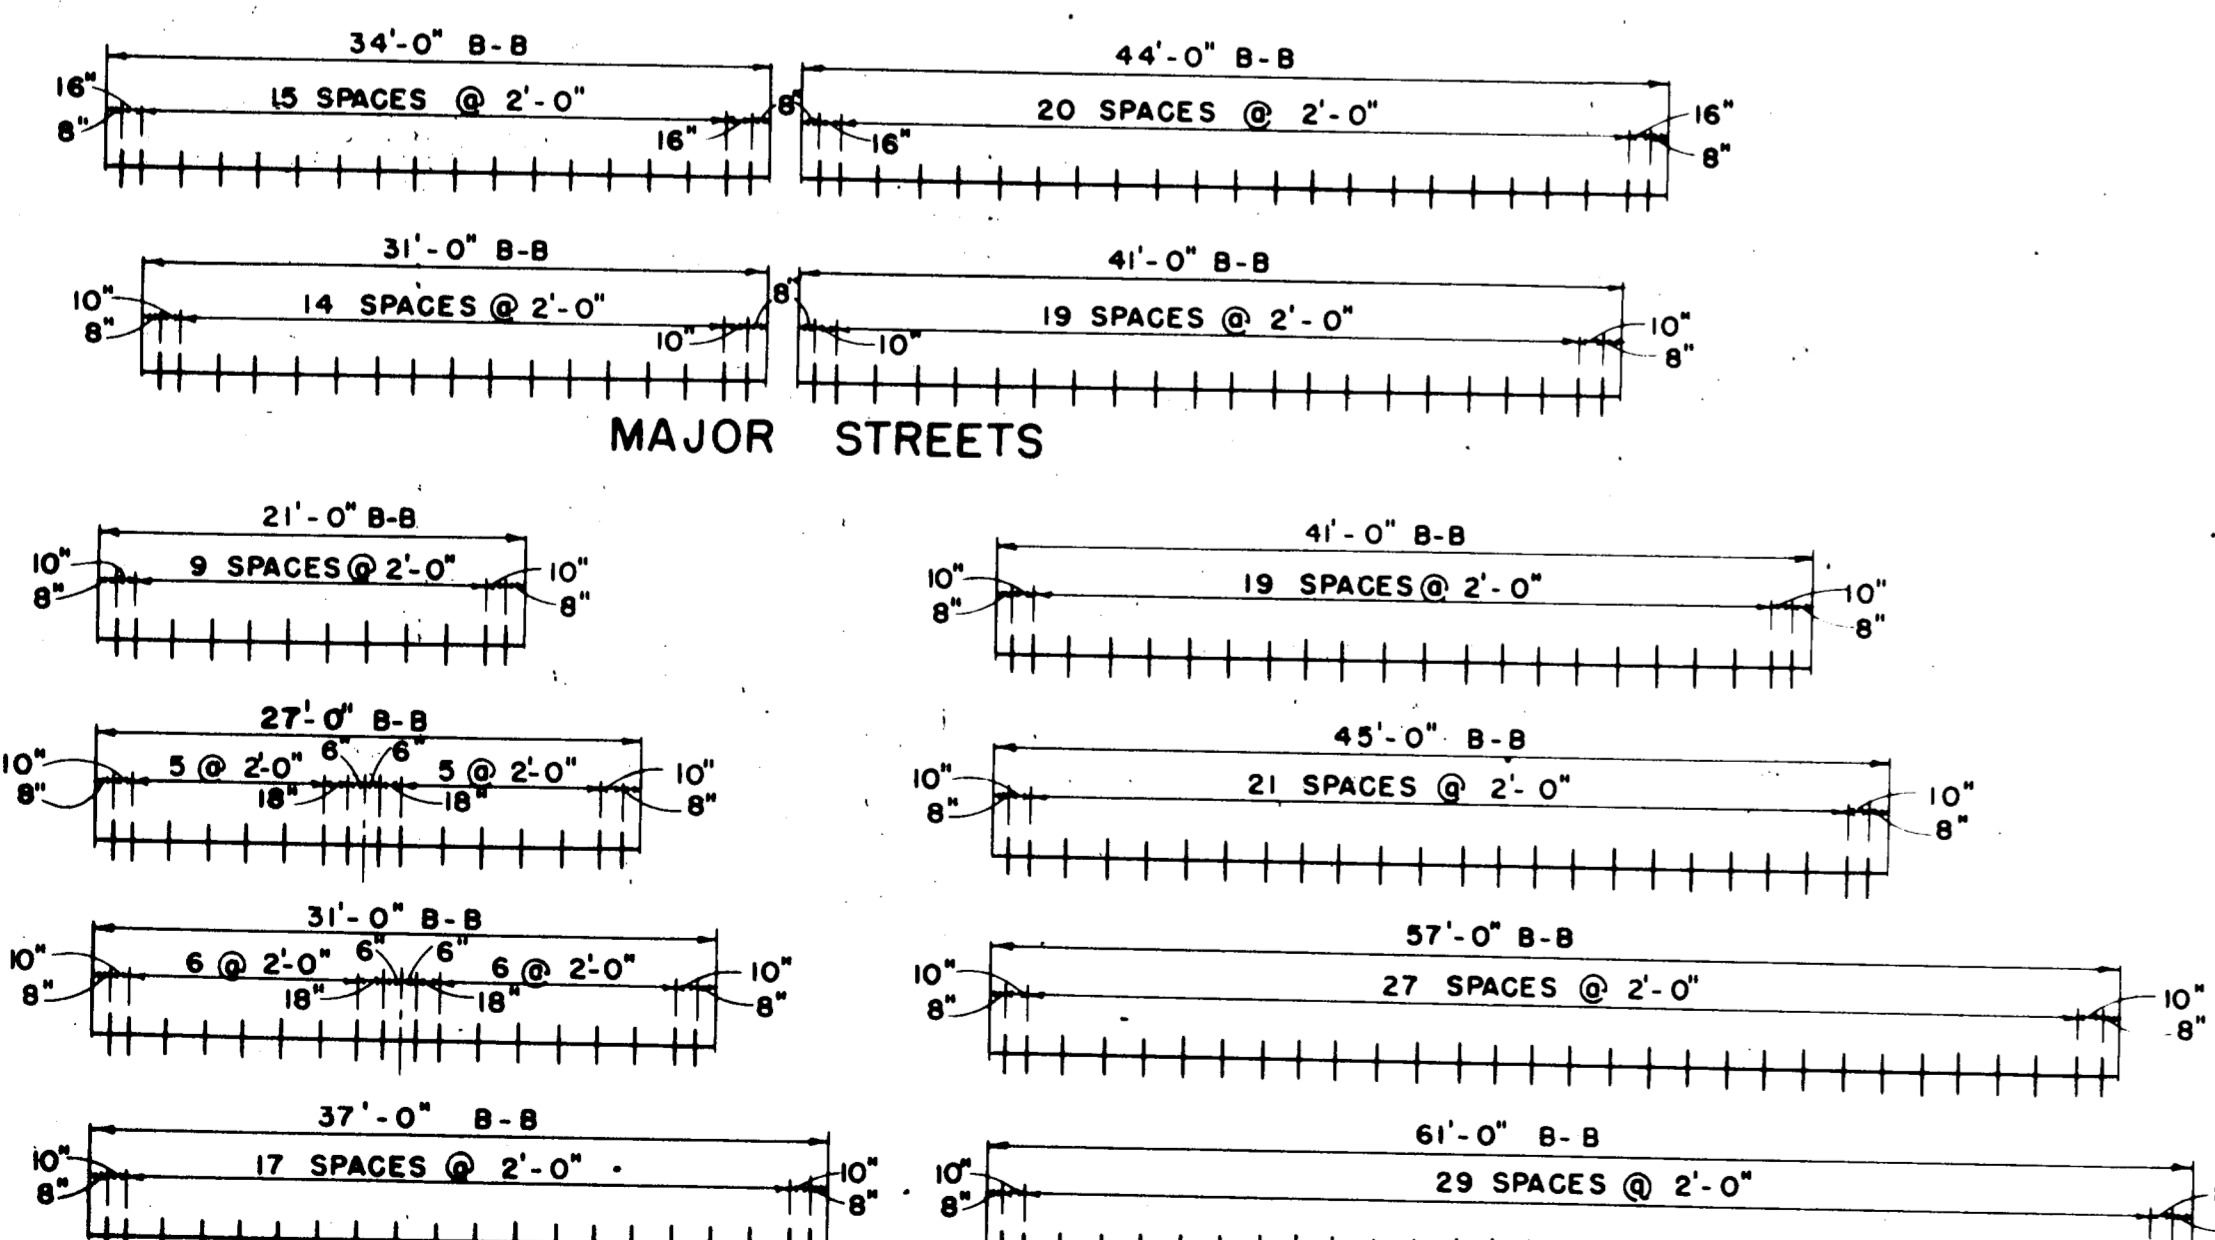

SPACING DIAGRAM FOR DOWELS AT EXPANSION JOINTS


CITY OF ADDISON
DALLAS COUNTY, TEXAS

MIDWAY ROAD

PAVING DETAILS B

GINN, INC.
Consulting Engineers - Dallas, Texas

DESIGNED-H.B.J. DRAWN-S.M. DATE MARCH, 1981 FILE
APPROVED-HWG CHECKED-B.H. SCALE-NONE SHEET 13

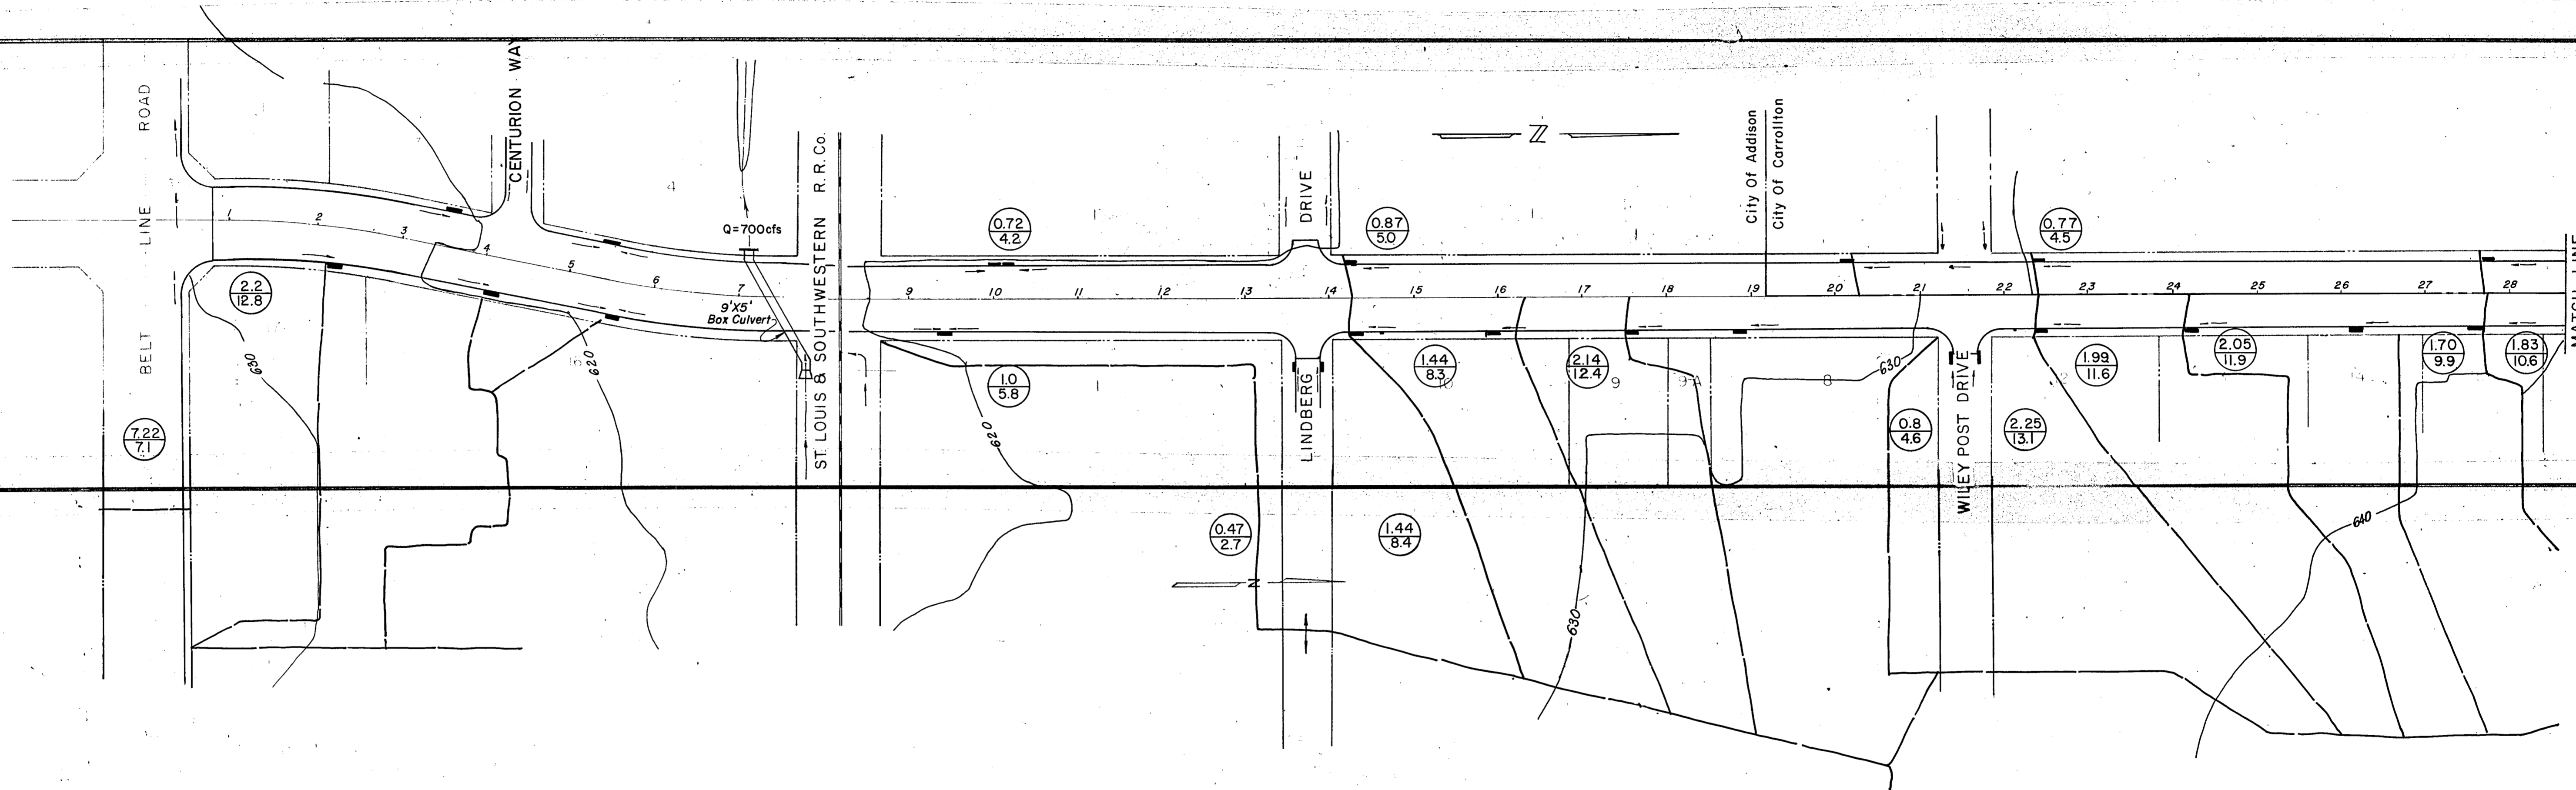


Drainage Calculations (T.H.D. Hydraulic Manual)
 Rolling Terrain 1%-3.5%
 Impervious Soils
 Commercial C = 0.6-0.9 (use C=0.75)
 For Dallas County



$$Q_{100} = C(I)(A) = (0.75)(7.8)(Ac.)$$

$$Q_{100} = (5.8c.f.s)(Ac)$$



2.5 ACRES
 14.5 Q₁₀₀

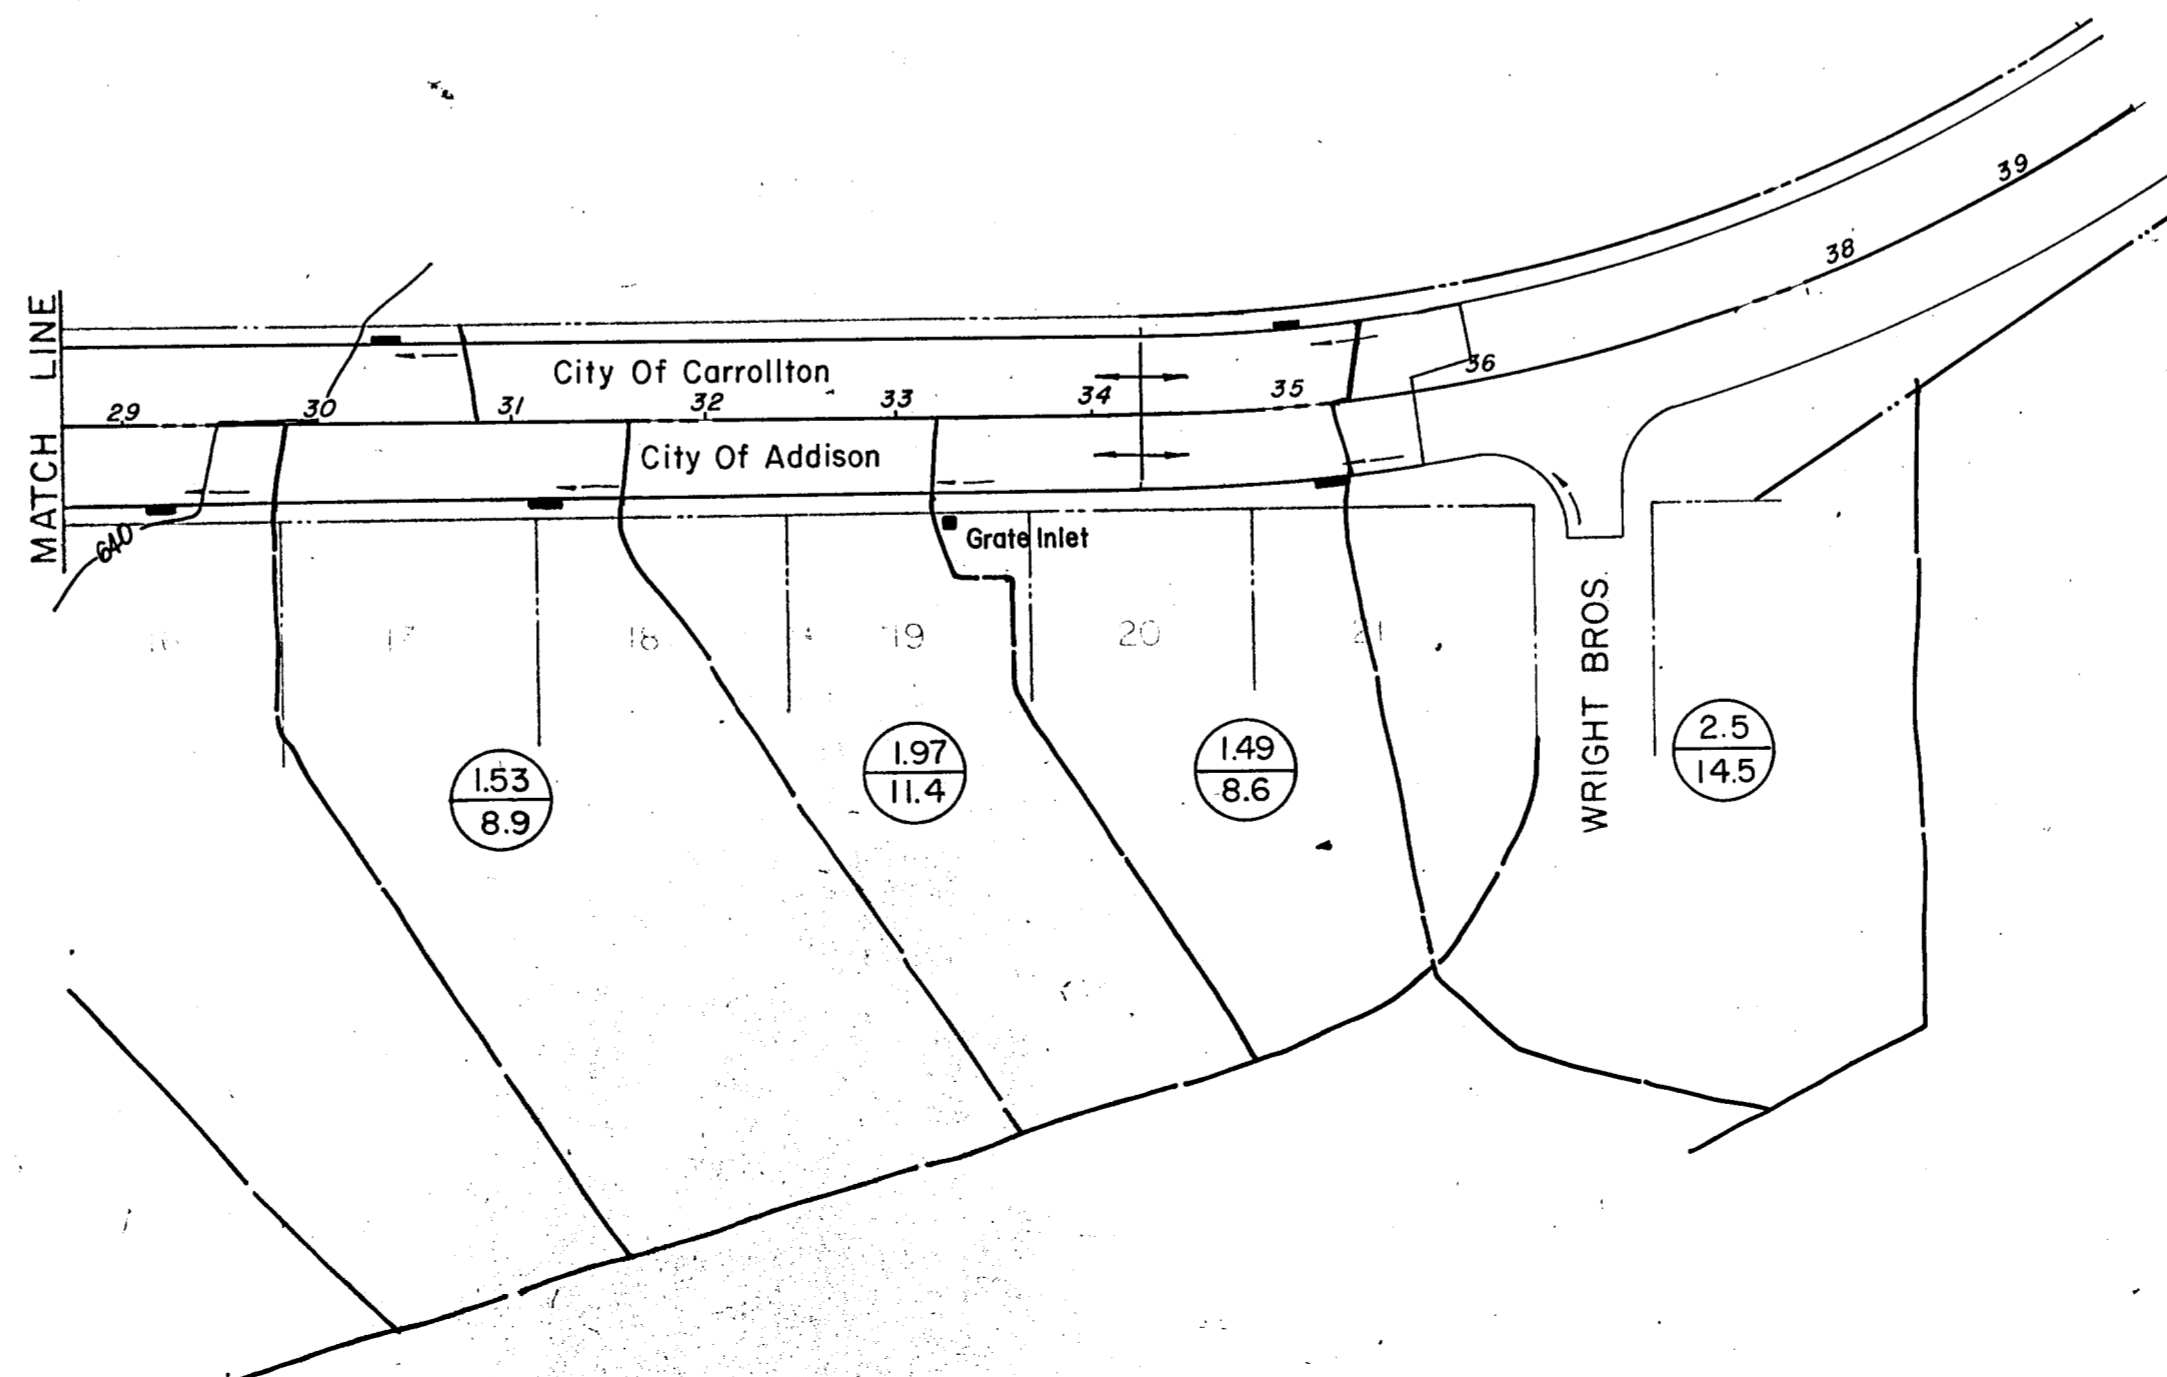

City of Addison			
MIDWAY ROAD IMPROVEMENTS			
Drainage Area Map			
DESIGNED	DRAWN R.G.B.	DATE MARCH, 1981	FILE
CHECKED		SCALE 1"=100'	SHEET 14 OF

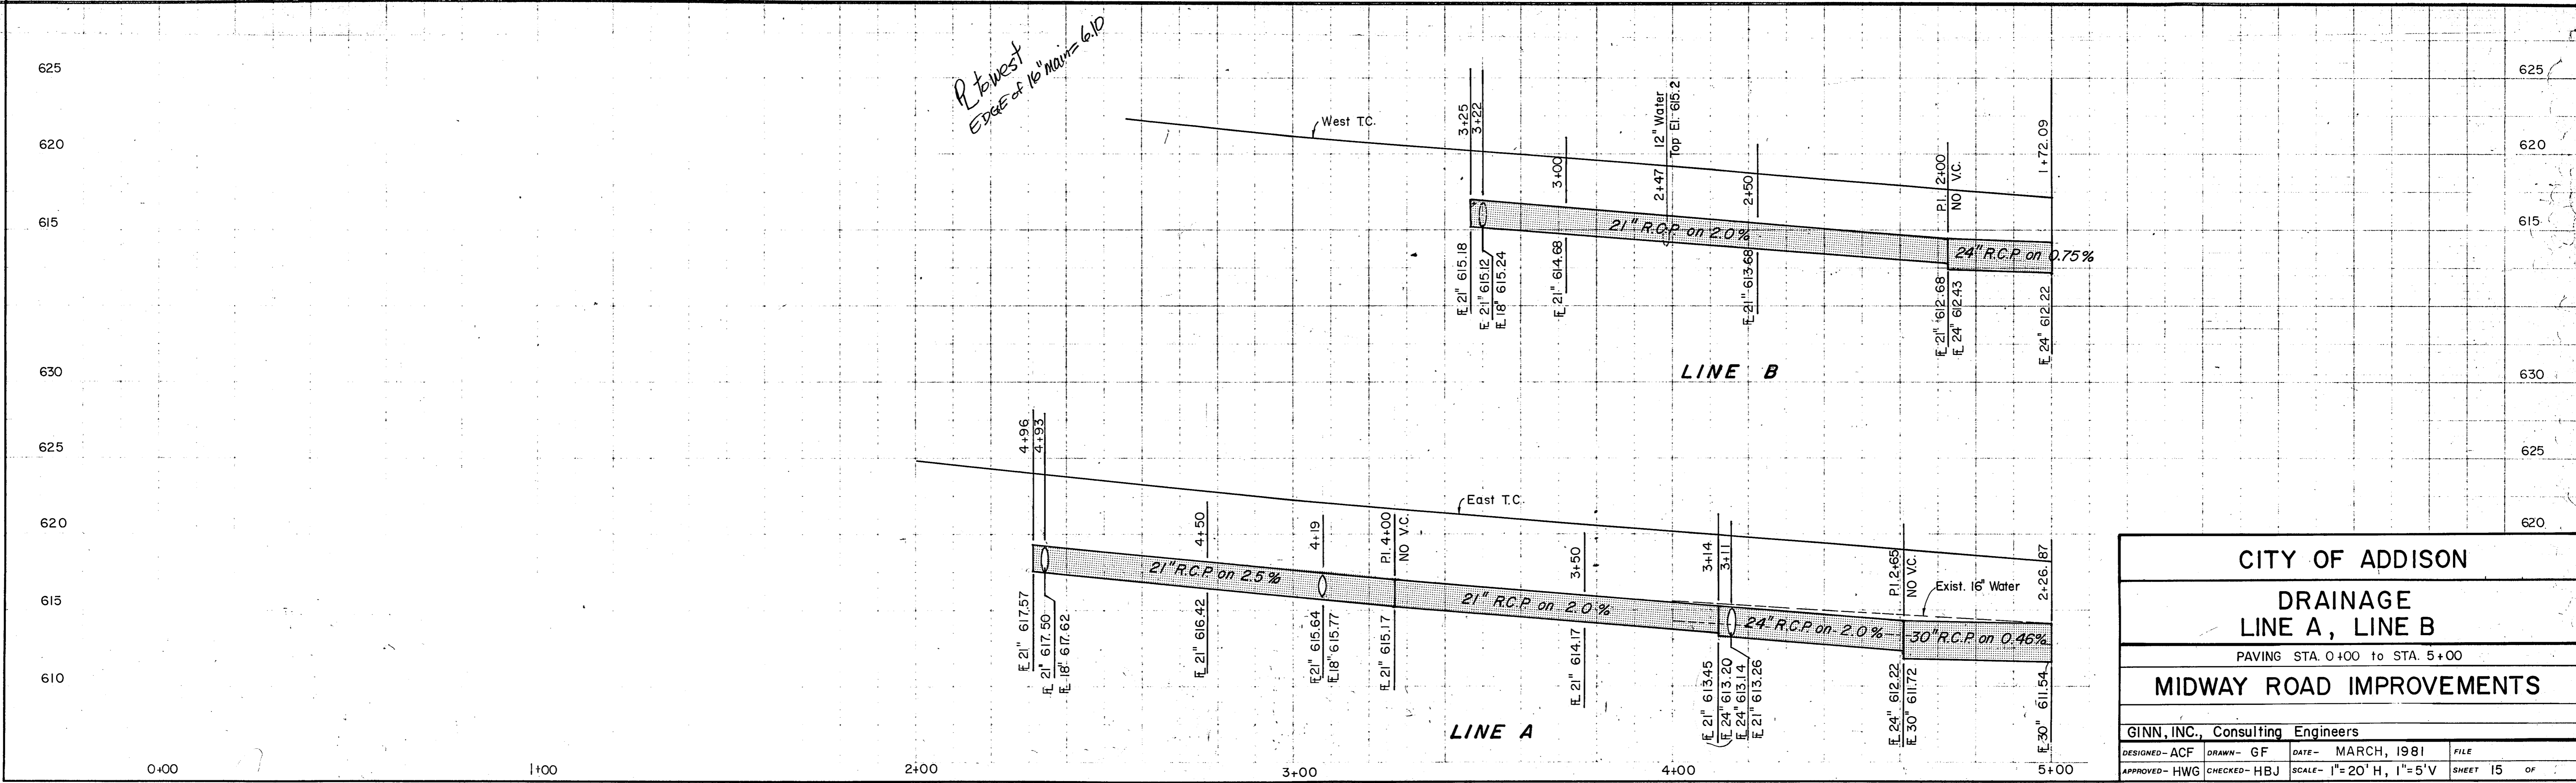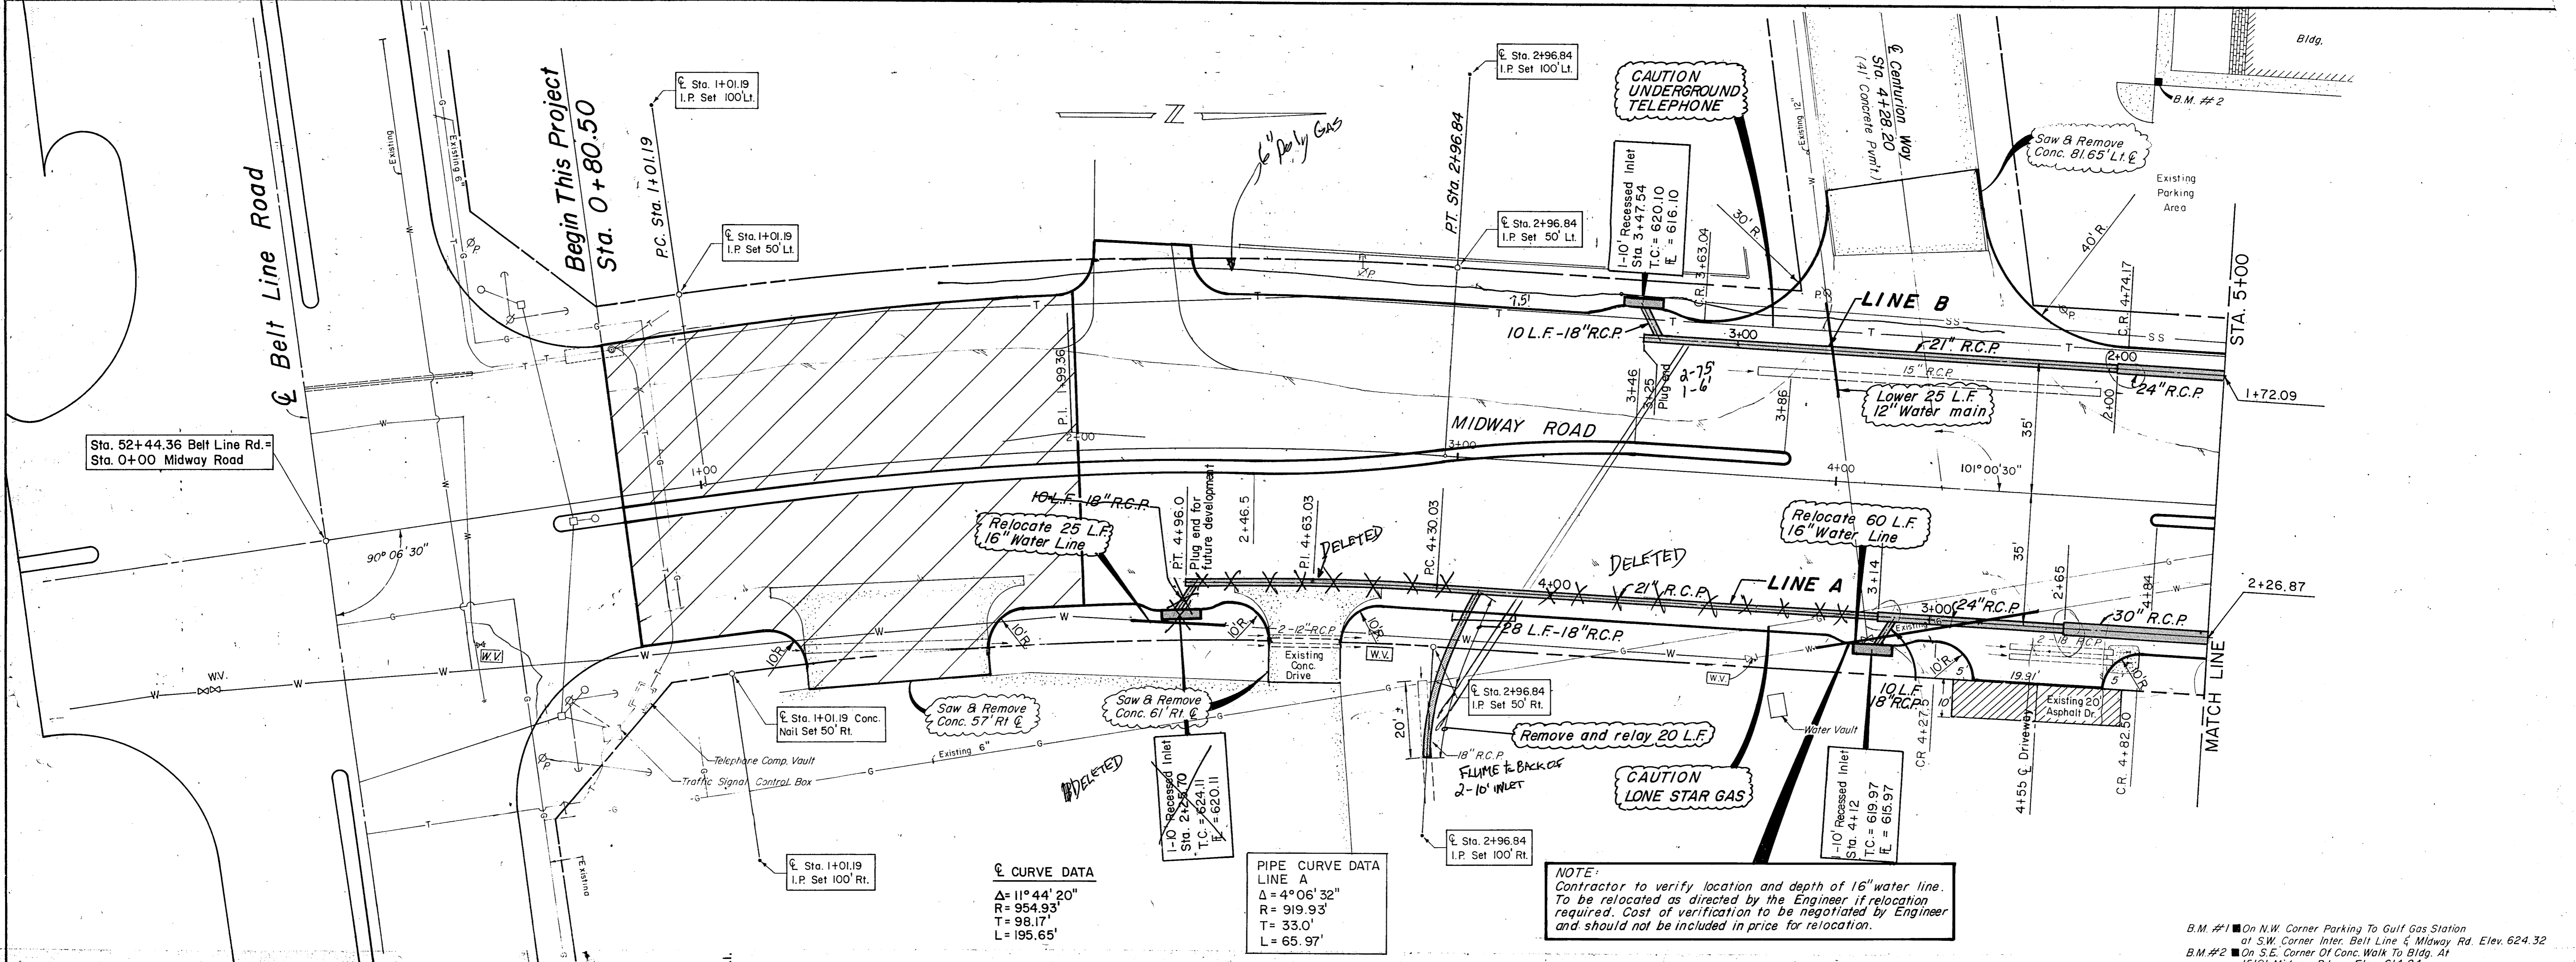

CITY OF ADDISON			
DRAINAGE			
LINE A, LINE B			
PAVING STA. 0+00 TO STA. 5+00			
MIDWAY ROAD IMPROVEMENTS			
GINN, INC., Consulting Engineers			
DESIGNED- ACF	DRAWN- GF	DATE- MARCH, 1981	FILE
APPROVED- HWG	CHECKED- HBJ	SCALE- 1"=20' H, 1"=5' V	SHEET 15 OF

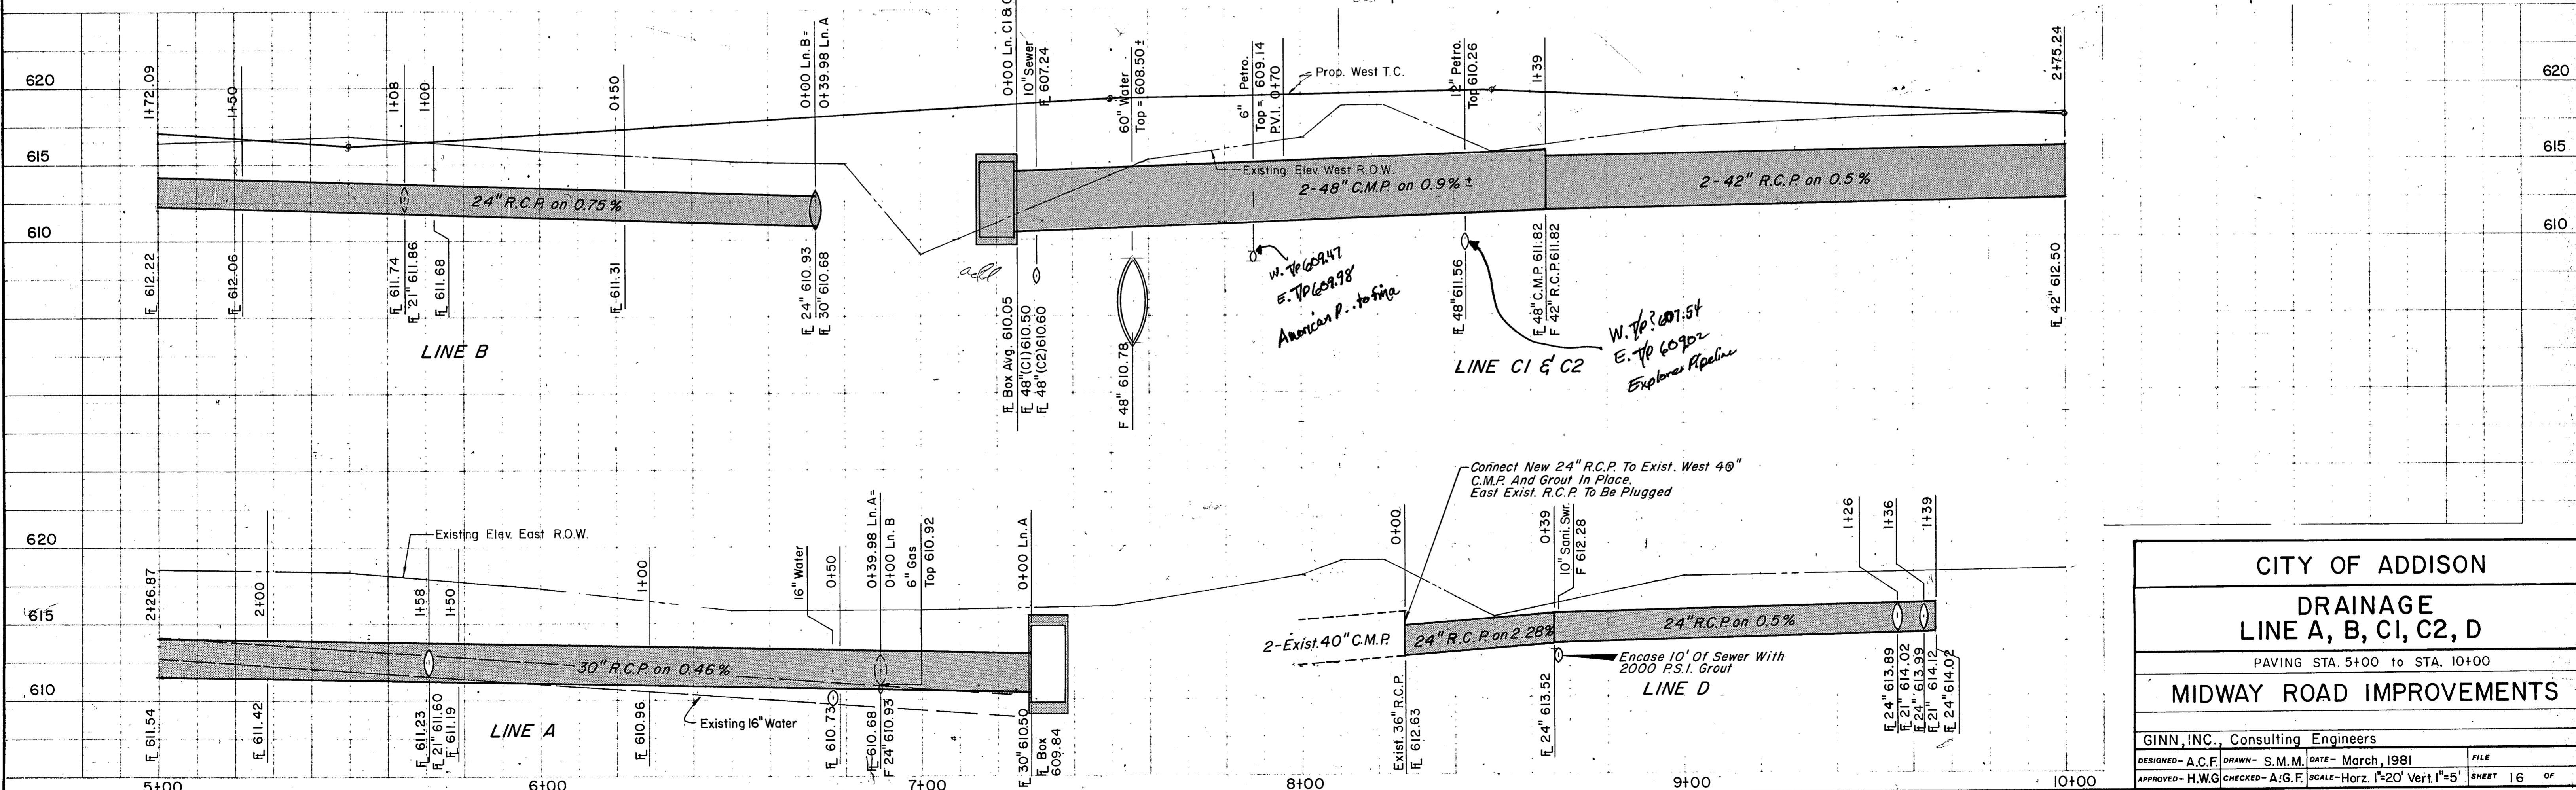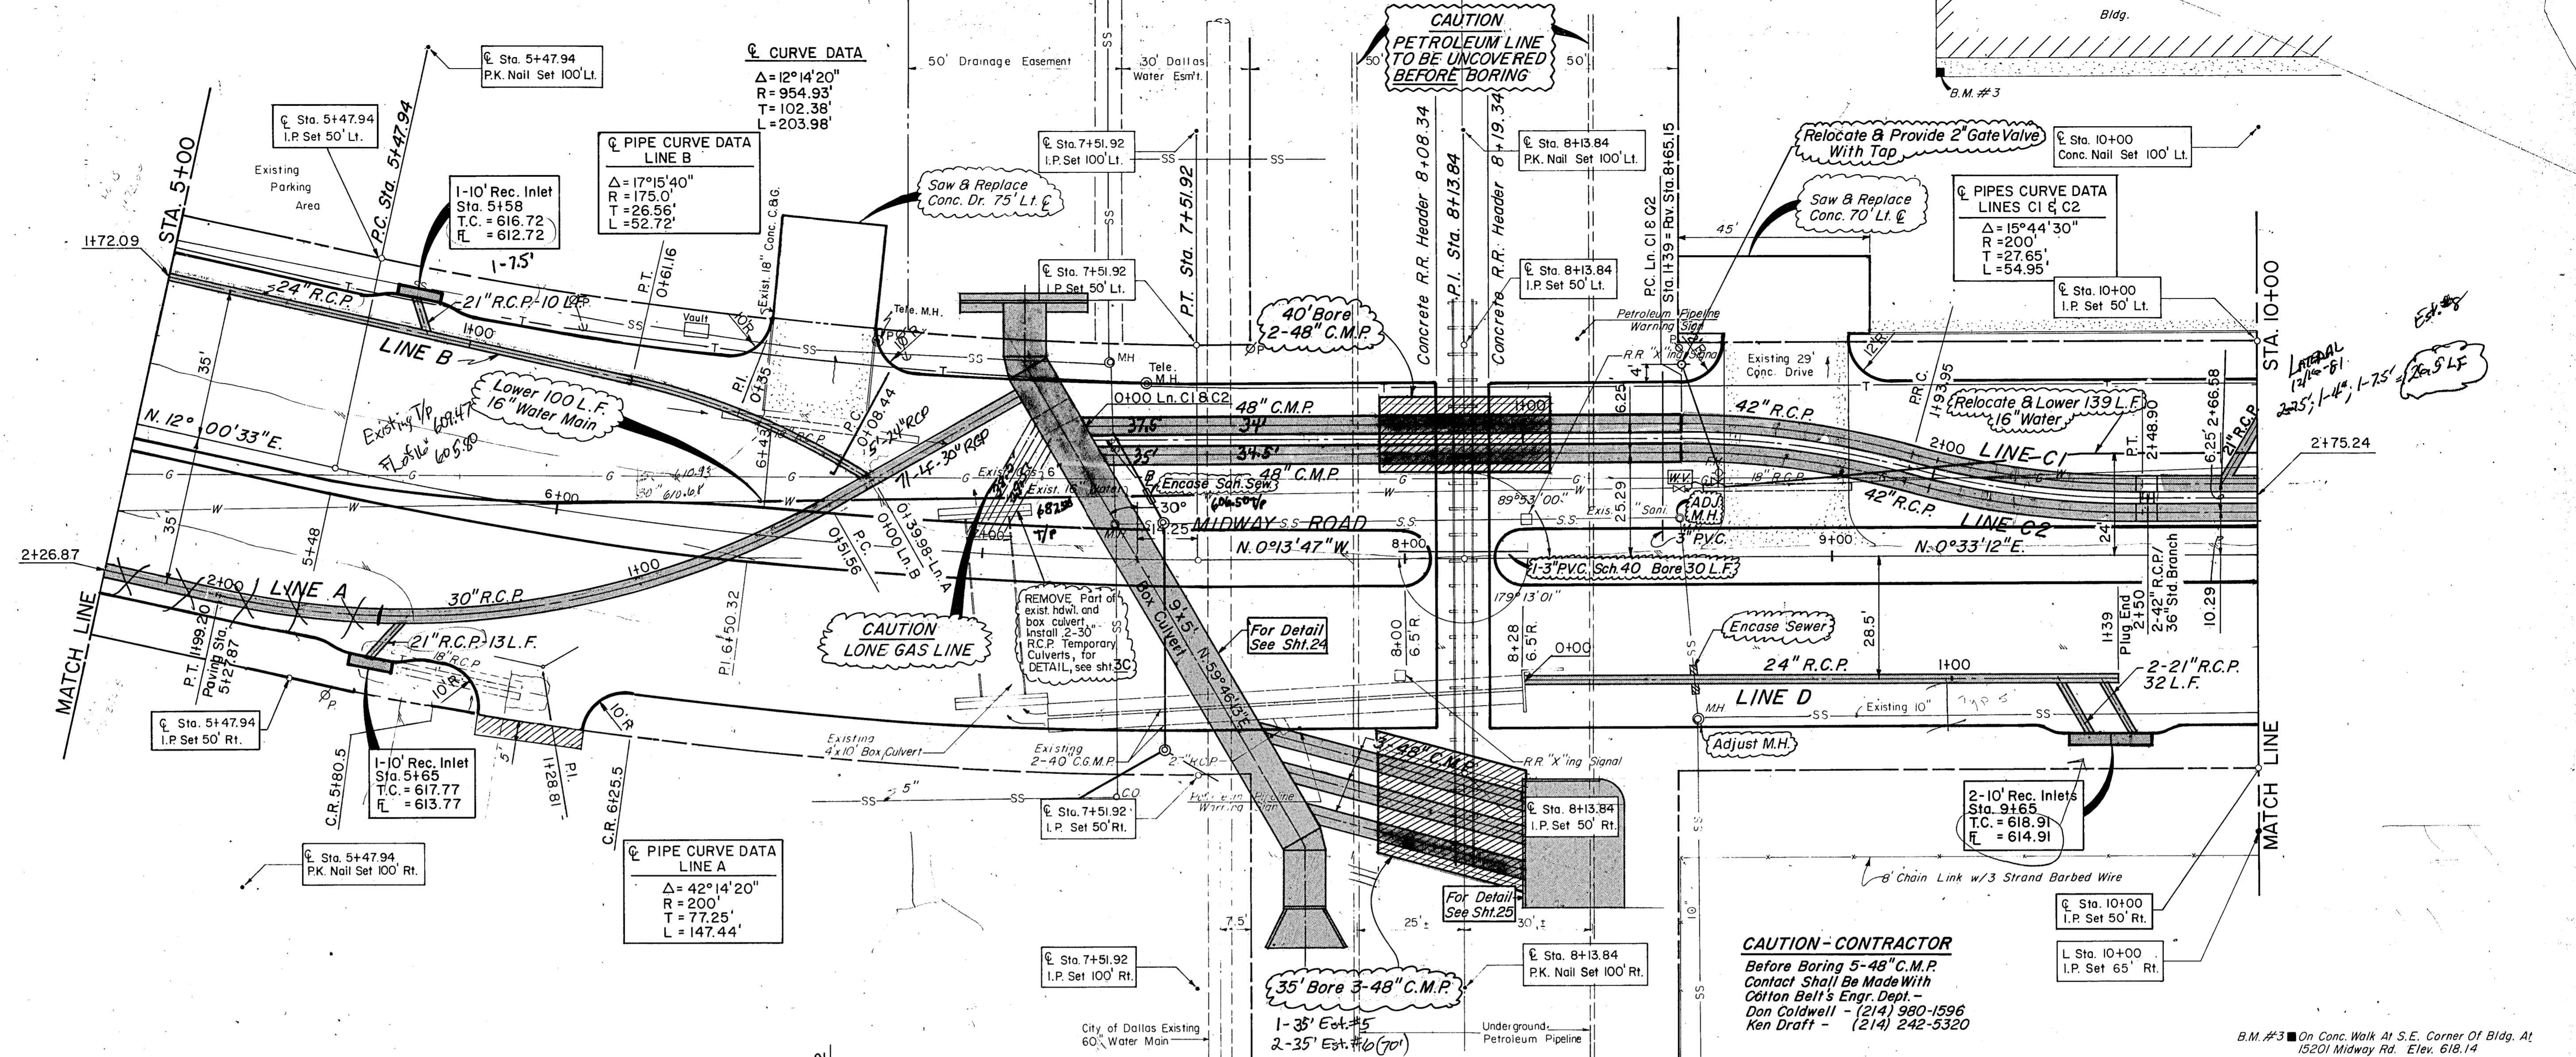

CITY OF ADDISON
DRAINAGE
LINE A, B, C1, C2, D
 PAVING STA. 5+00 to STA. 10+00
MIDWAY ROAD IMPROVEMENTS

GINN, INC., Consulting Engineers
 DESIGNED - A.C.F. DRAWN - S.M.M. DATE - March, 1981
 APPROVED - H.W.G. CHECKED - A.G.F. SCALE - Horz. 1"=20' Vert. 1"=5' SHEET 16 OF

CAUTION - CONTRACTOR
 Before Boring 5-48" C.M.P.
 Contact Shall Be Made With
 Cotton Belt's Engr. Dept. -
 Don Caldwell - (214) 980-1596
 Ken Draff - (214) 242-5320

B.M. #3 On Conc. Walk At S.E. Corner Of Bldg. At
 15201 Midway Rd. Elev. 618.14

*W. Tp. 609.47
 E. Tp. 609.98
 American P. to City*

*W. Tp. 601.54
 E. Tp. 609.2
 Explorer Pipeline*

CAUTION
 LONE GAS LINE

CAUTION
 PETROLEUM LINE
 TO BE UNCOVERED
 BEFORE BORING

PIPE CURVE DATA
 LINE A
 $\Delta = 42^\circ 14' 20''$
 $R = 200'$
 $T = 77.25'$
 $L = 147.44'$

PIPE CURVE DATA
 LINE B
 $\Delta = 17^\circ 15' 40''$
 $R = 175.0'$
 $T = 26.56'$
 $L = 52.72'$

PIPE CURVE DATA
 LINES C1 & C2
 $\Delta = 15^\circ 44' 30''$
 $R = 200'$
 $T = 27.65'$
 $L = 54.95'$

CURVE DATA
 $\Delta = 12^\circ 14' 20''$
 $R = 954.93'$
 $T = 102.38'$
 $L = 203.98'$

1-10' Rec. Inlet
 Sta. 5+65
 T.C. = 617.77
 I.P. = 613.77

1-10' Rec. Inlet
 Sta. 5+58
 T.C. = 616.72
 I.P. = 612.72

2-10' Rec. Inlets
 Sta. 9+65
 T.C. = 618.91
 I.P. = 614.91

Sta. 7+51.92
 I.P. Set 100' Rt.

Sta. 8+13.84
 I.P. Set 50' Rt.

Sta. 10+00
 I.P. Set 50' Rt.

Sta. 10+00
 I.P. Set 65' Rt.

Sta. 5+47.94
 I.P. Set 50' Rt.

Sta. 5+47.94
 P.K. Nail Set 100' Rt.

Sta. 7+51.92
 I.P. Set 100' Lt.

Sta. 8+13.84
 P.K. Nail Set 100' Lt.

Sta. 10+00
 Conc. Nail Set 100' Lt.

Sta. 5+100

Sta. 10+00

5+00

6+00

7+00

8+00

9+00

10+00

620

615

610

620

615

610

620







615

610

620

615

610

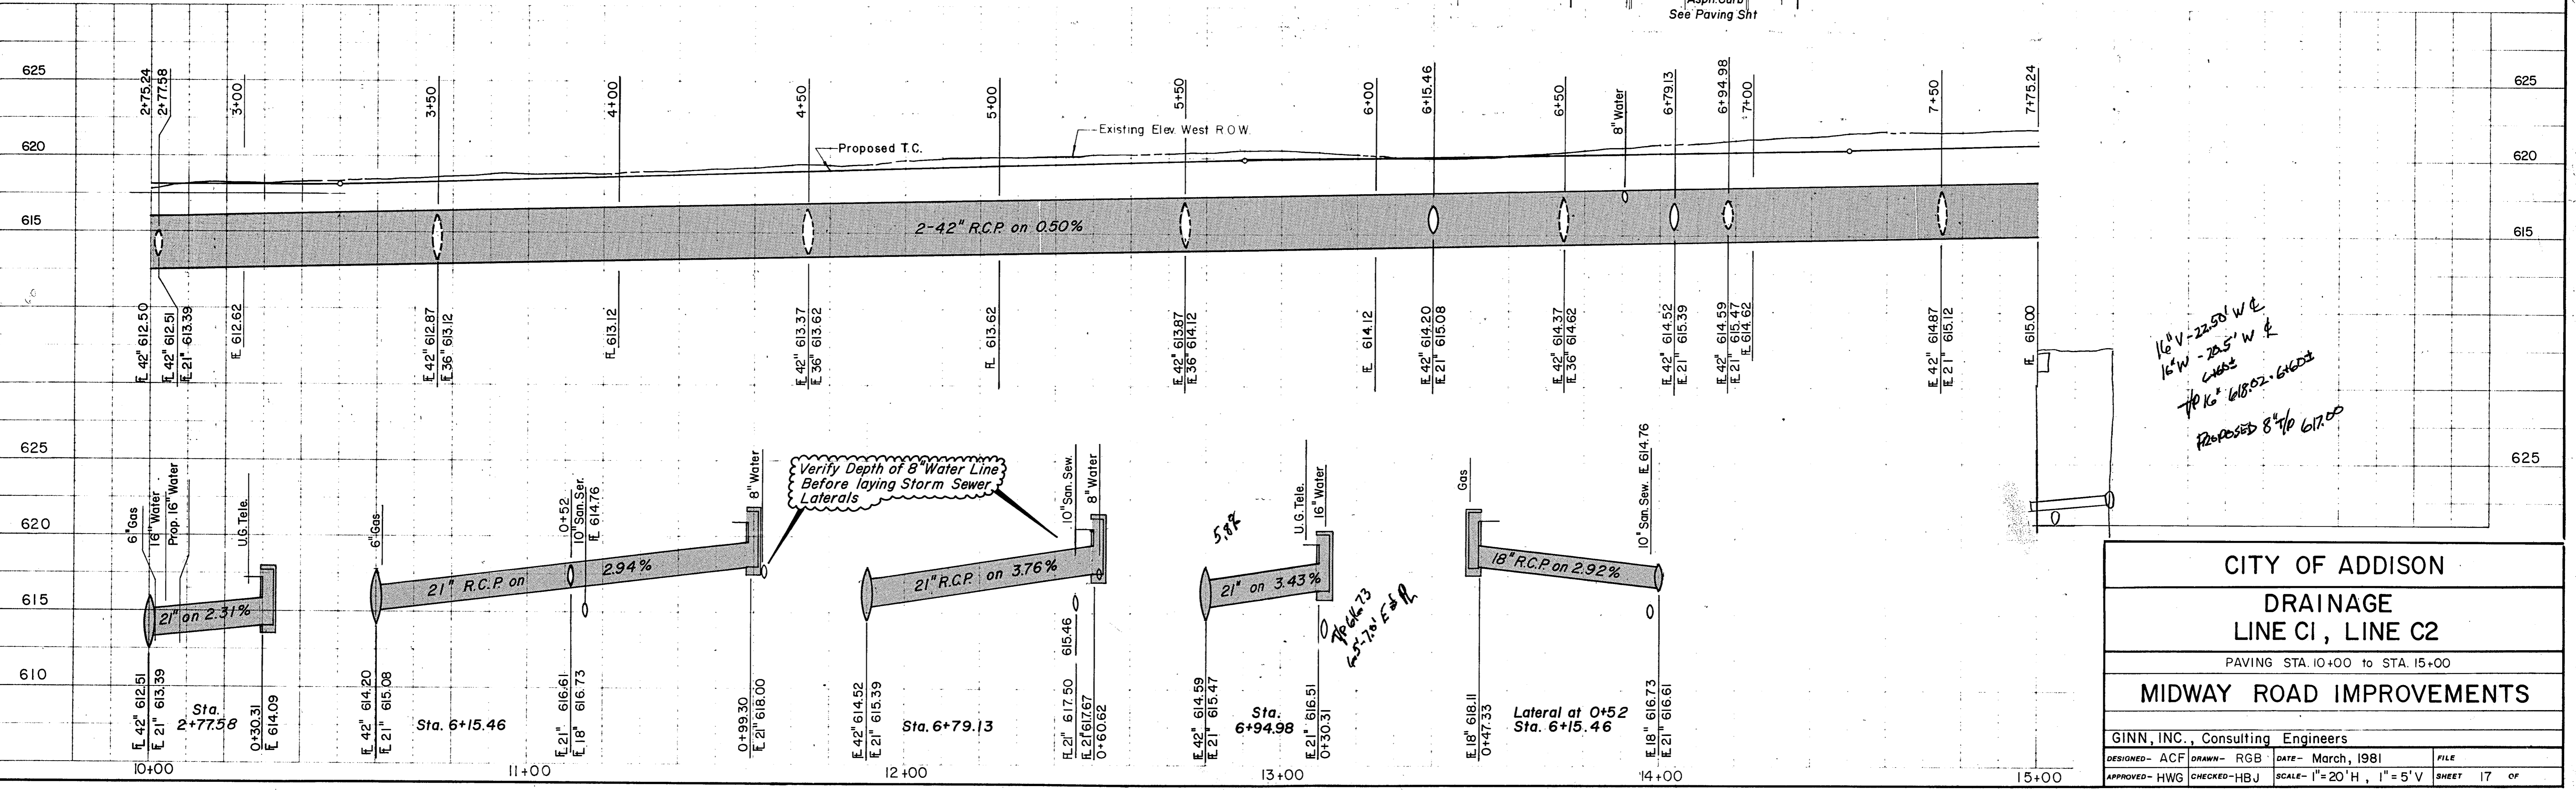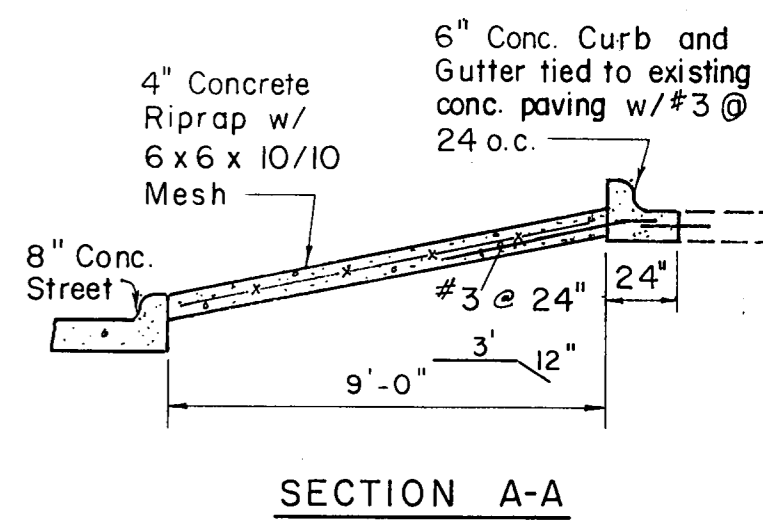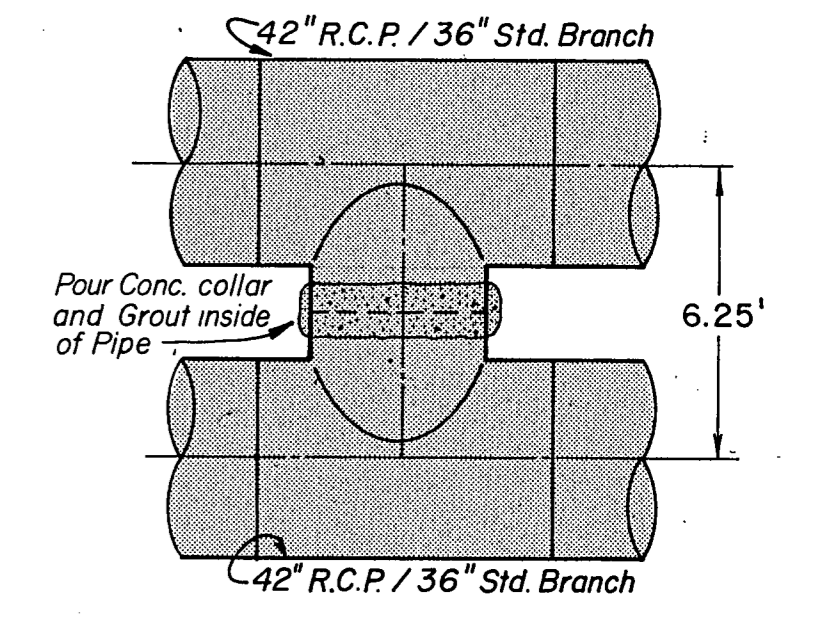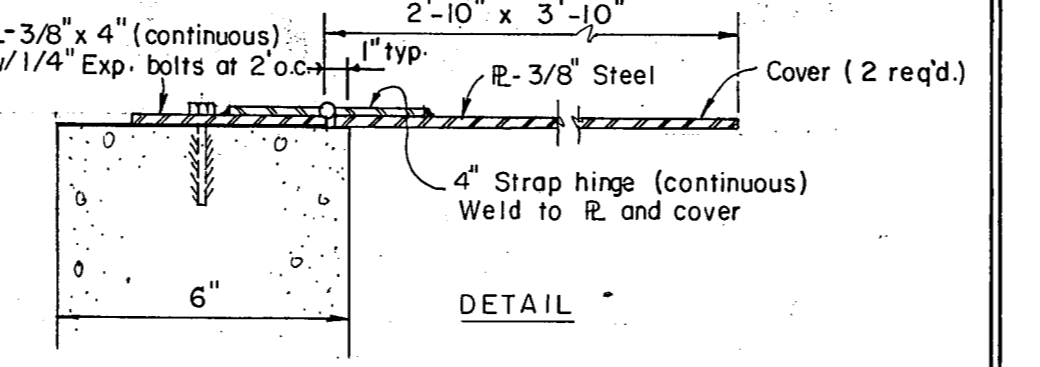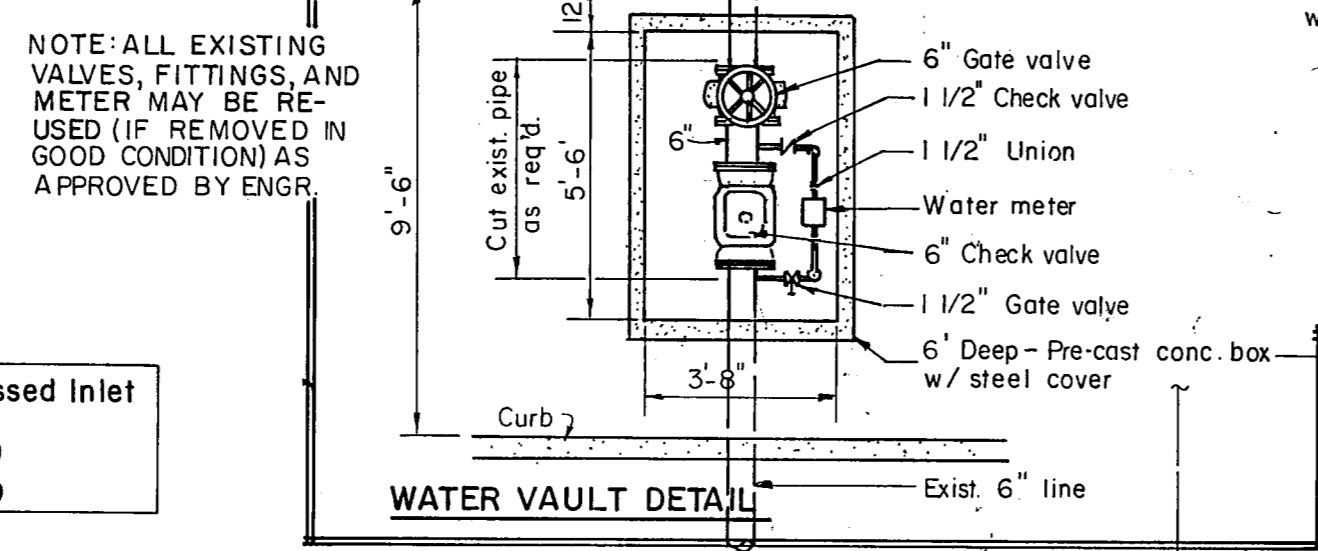
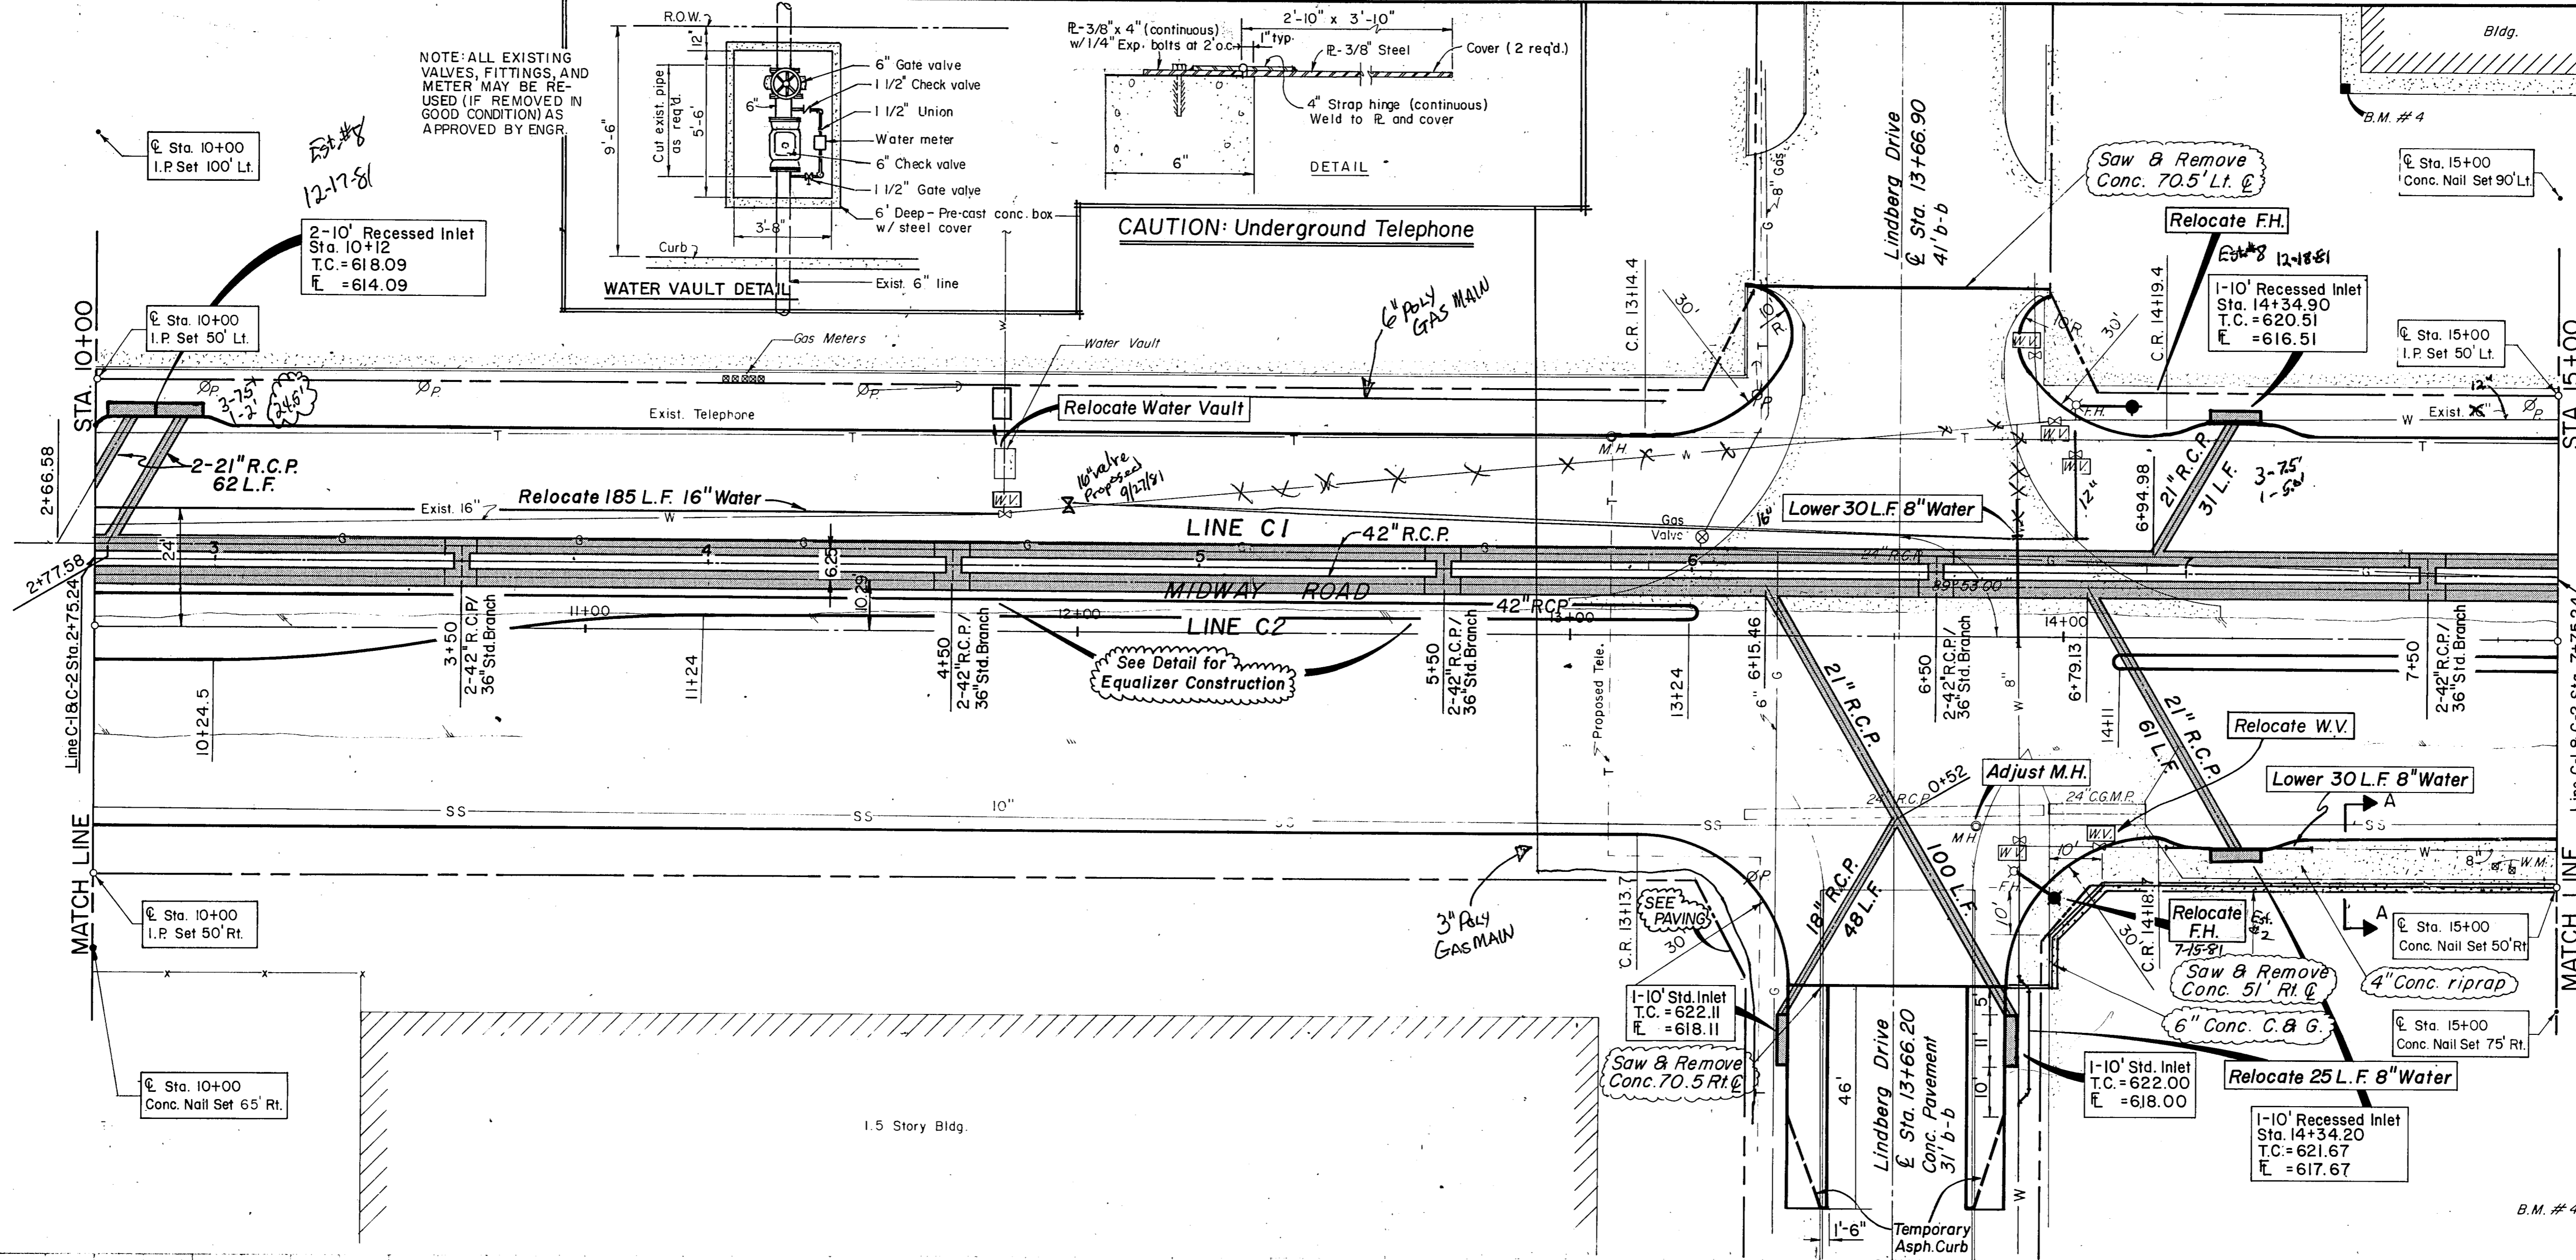


16" V - 22.50' W @
 16" W - 22.5' W @
 16" R.C.P. 618.02 - 617.00
 PROPOSED 8" @ 617.00


Verify Depth of 8" Water Line Before laying Storm Sewer Laterals

CITY OF ADDISON
DRAINAGE
LINE C1, LINE C2
 PAVING STA. 10+00 TO STA. 15+00
MIDWAY ROAD IMPROVEMENTS

GINN, INC., Consulting Engineers
 DESIGNED - ACF DRAWN - RGB DATE - March, 1981 FILE
 APPROVED - HWG CHECKED - HBJ SCALE - 1" = 20' H, 1" = 5' V SHEET 17 OF

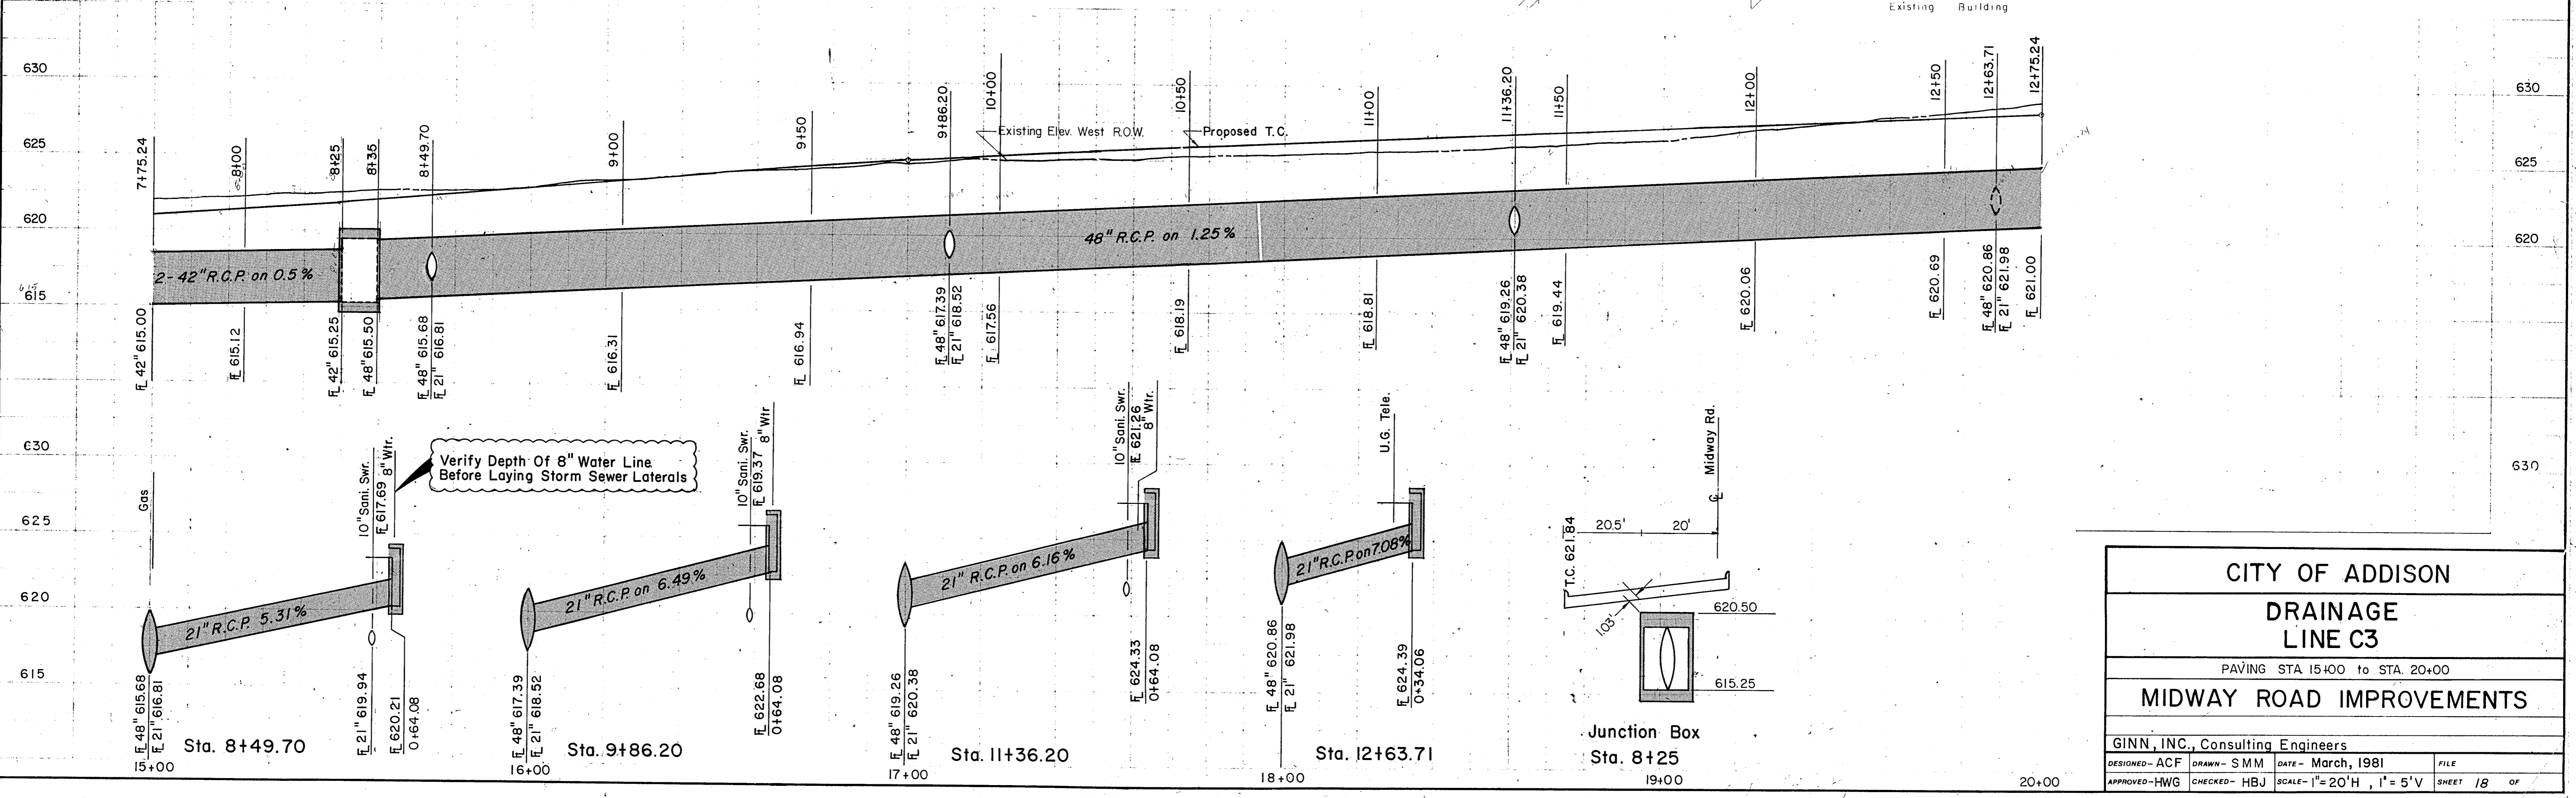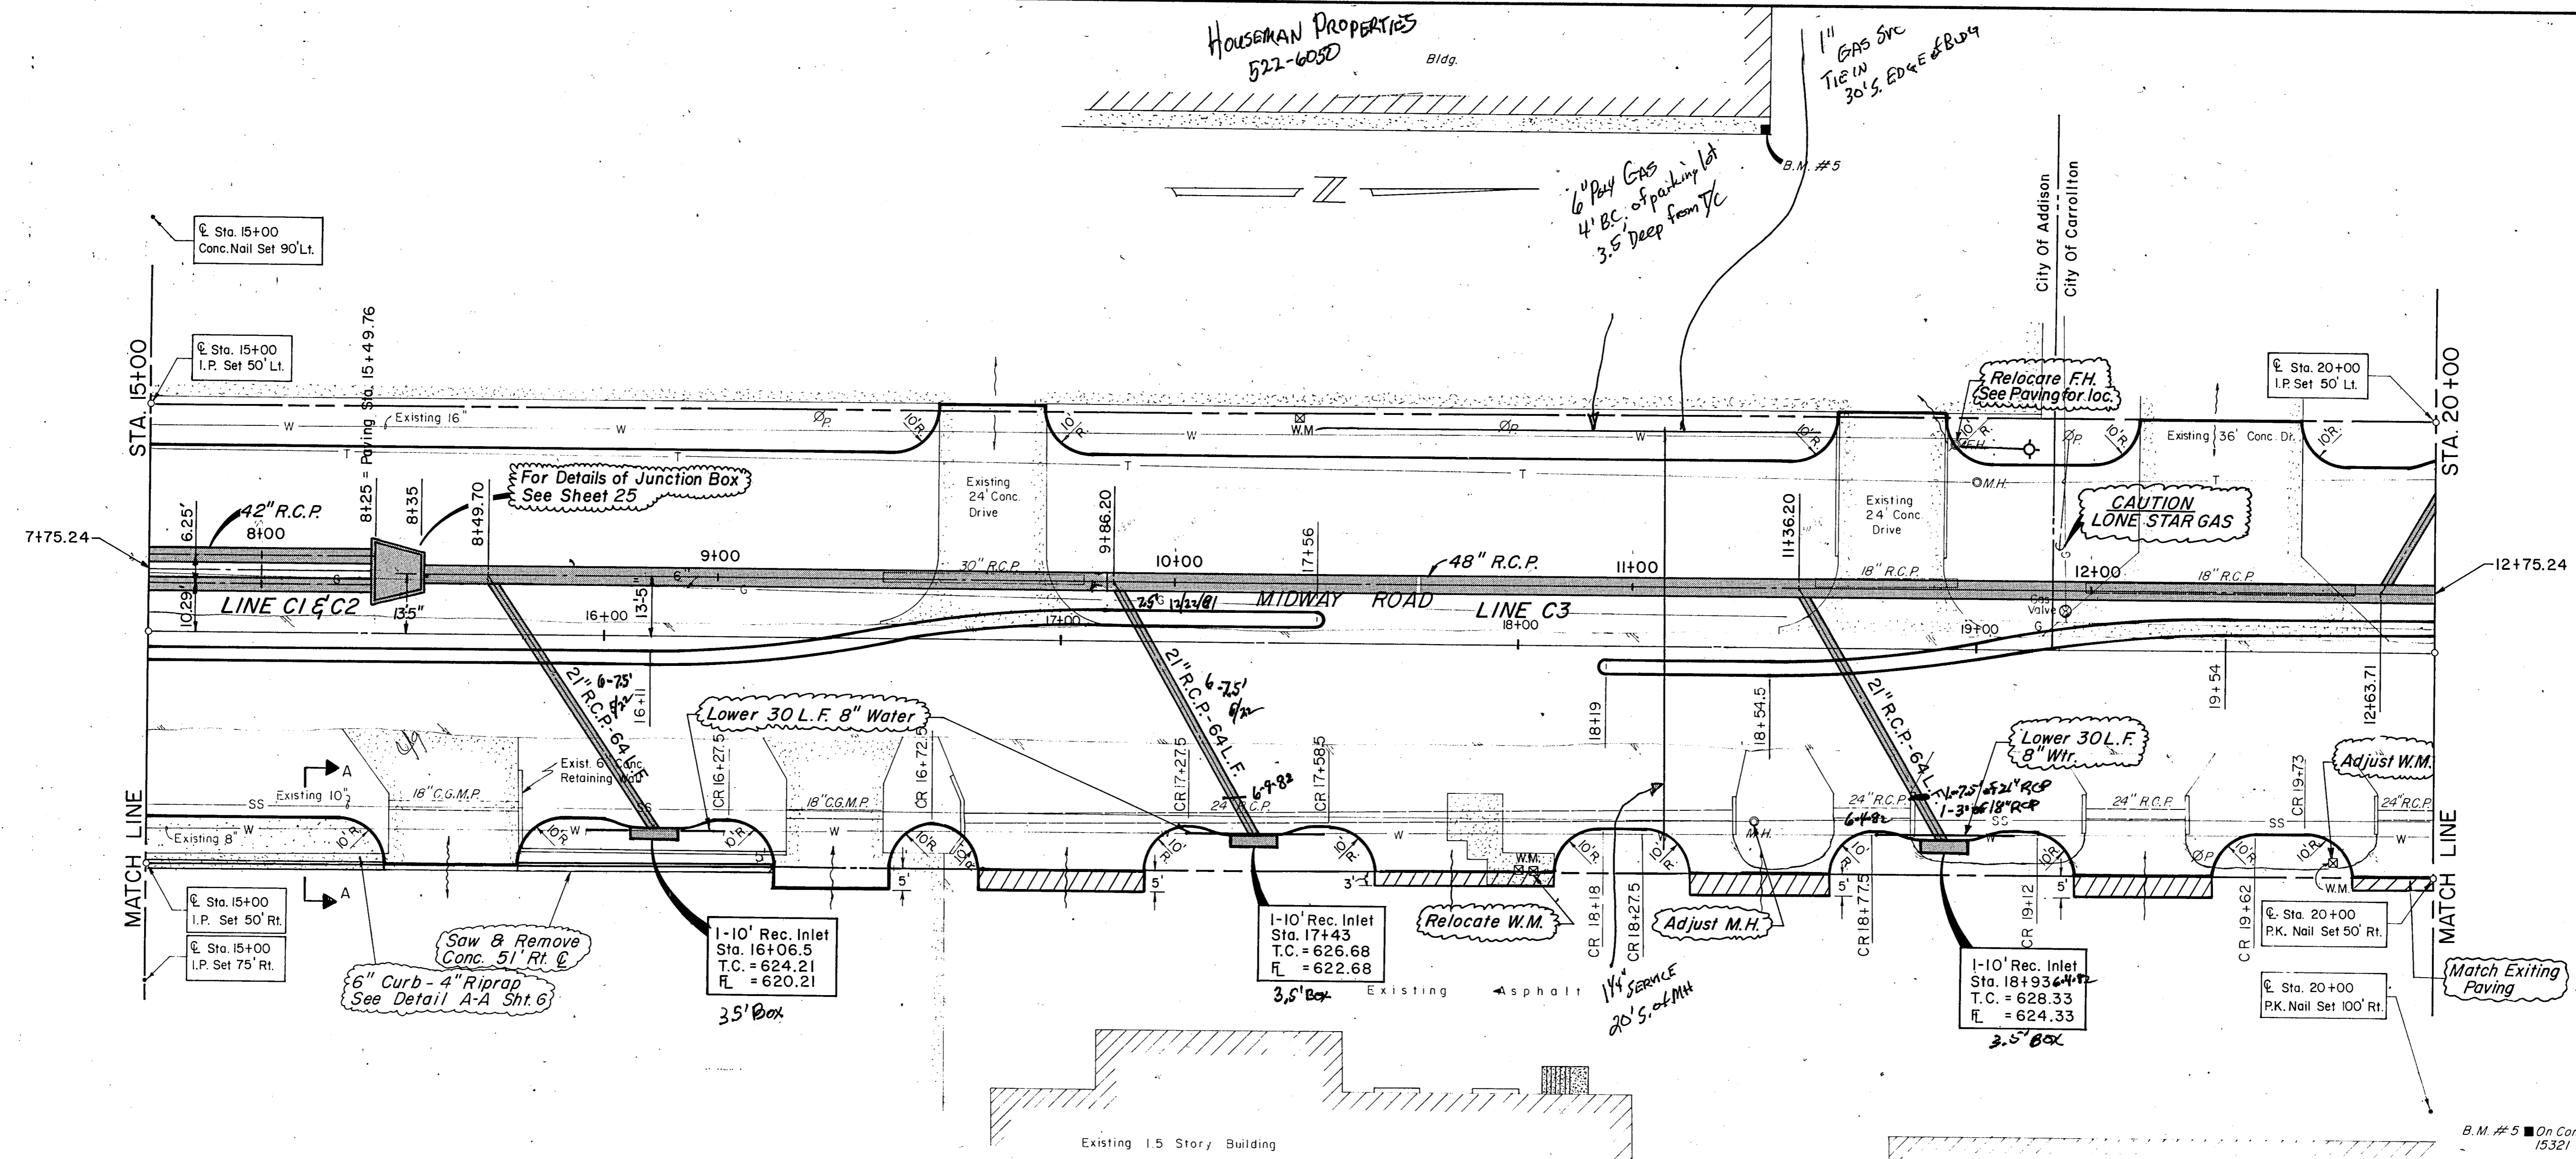

CITY OF ADDISON			
DRAINAGE LINE C3			
PAVING STA 15+00 to STA. 20+00			
MIDWAY ROAD IMPROVEMENTS			
GINN, INC., Consulting Engineers			
DESIGNED - ACF	DRAWN - SMM	DATE - March, 1981	FILE
APPROVED - HWG	CHECKED - HBJ	SCALE - 1" = 20'H, 1" = 5'V	SHEET 18 OF

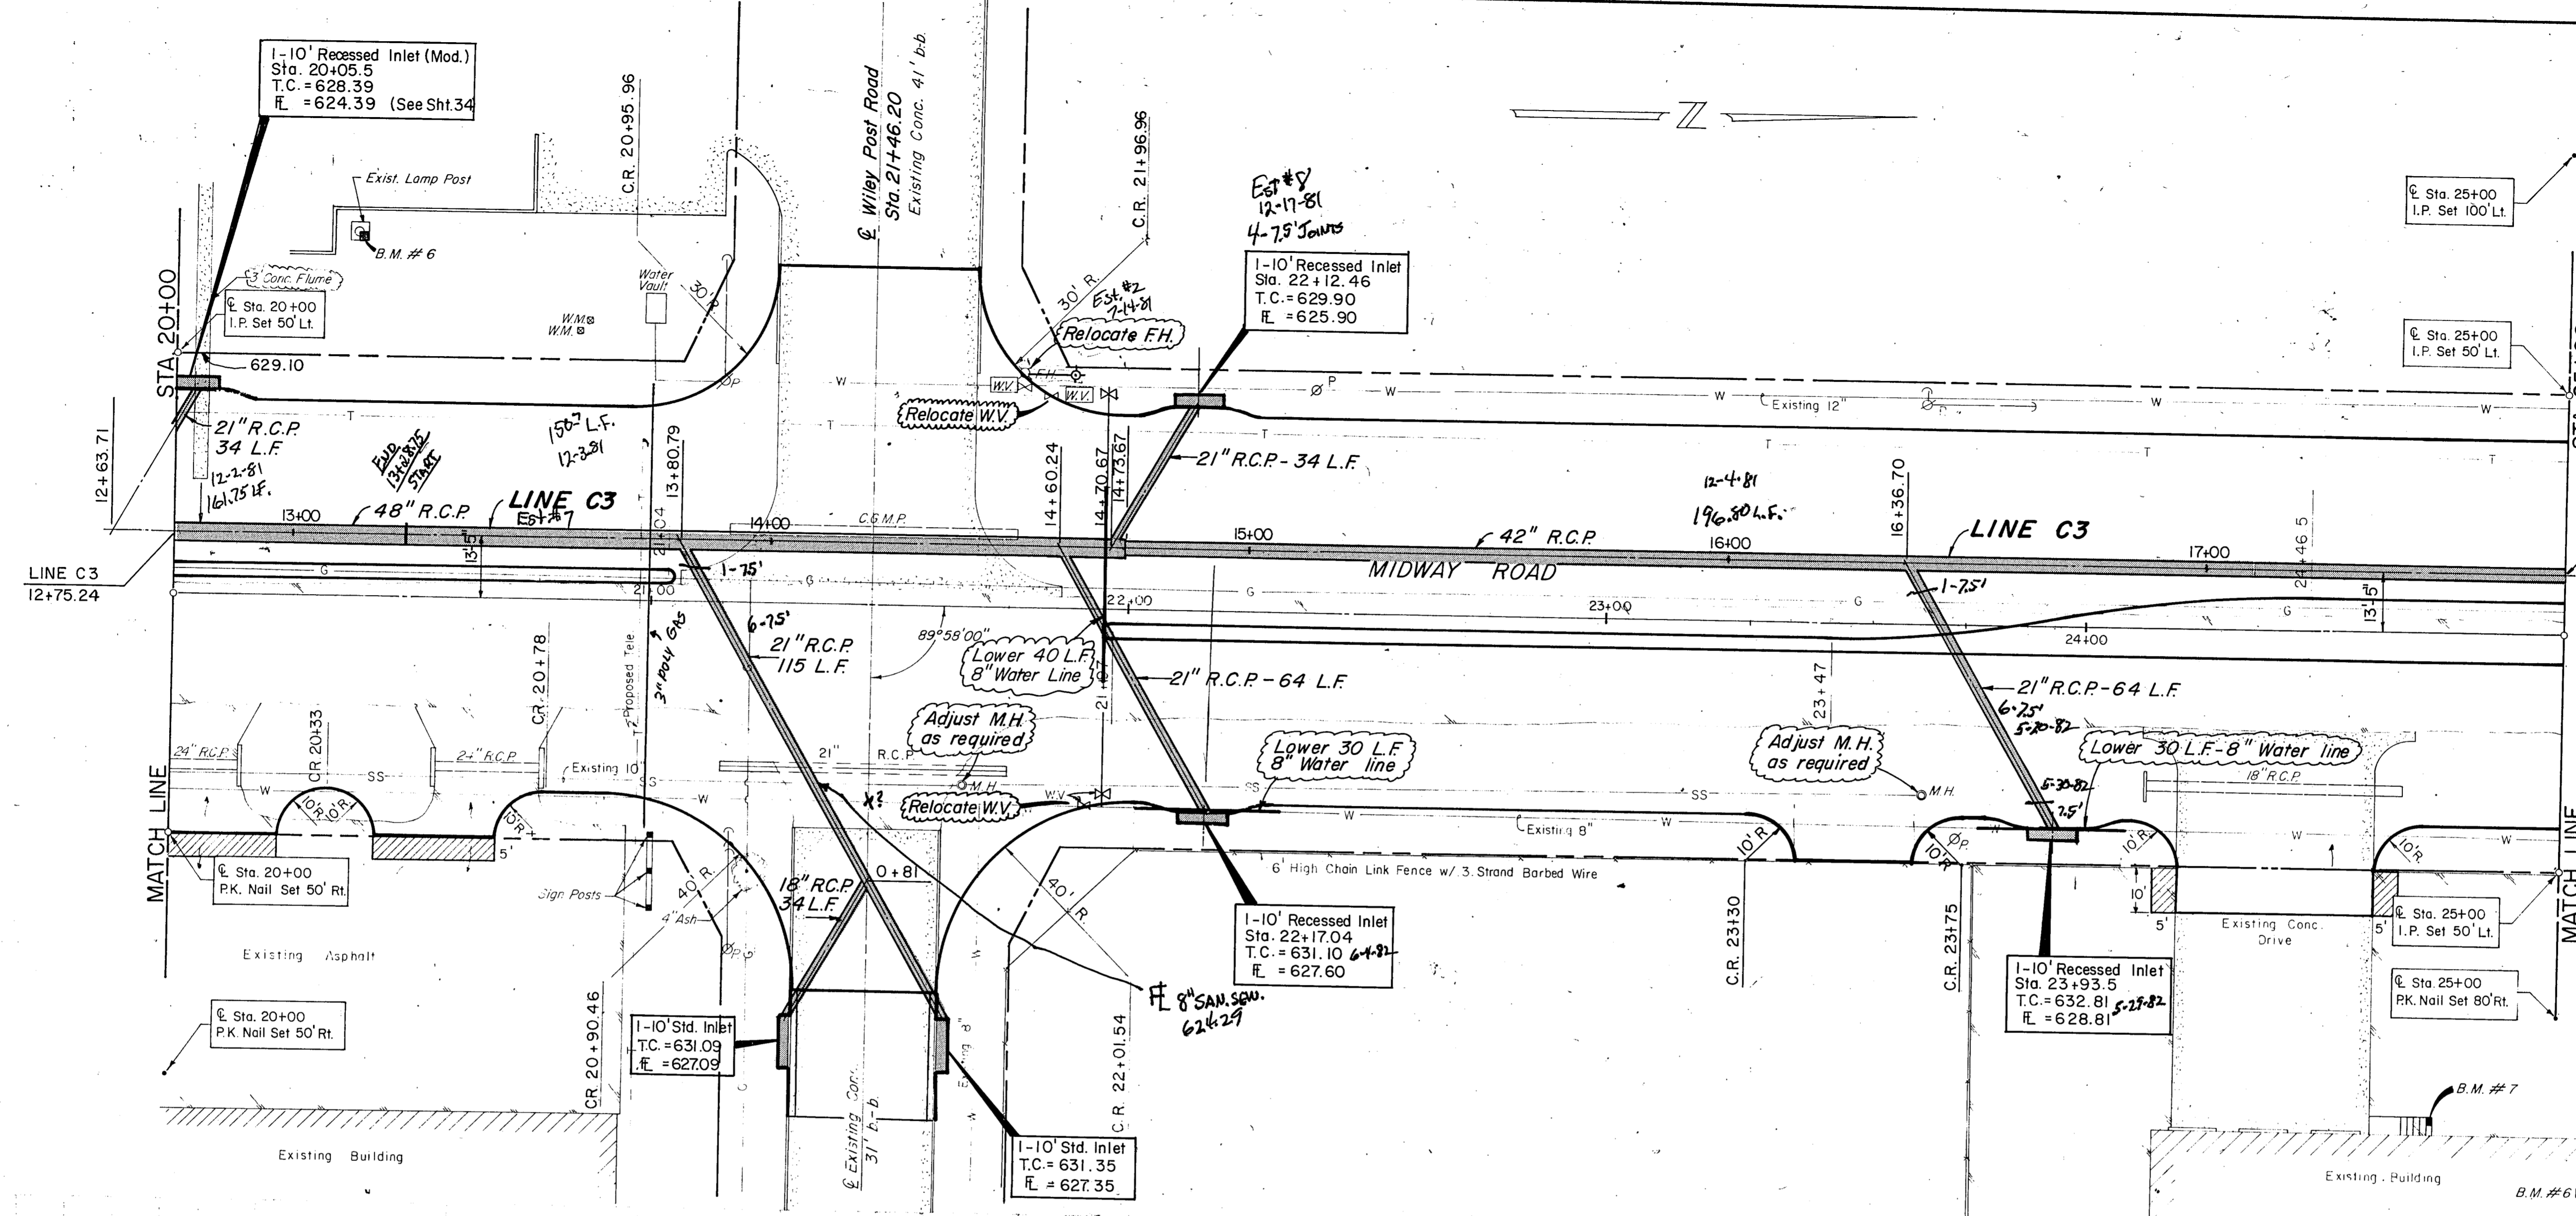


Sta. 25+00
I.P. Set 100' Lt.

Sta. 25+00
I.P. Set 50' Lt.




Sta. 25+00
I.P. Set 50' Lt.

Sta. 25+00
P.K. Nail Set 80' Rt.

B.M. #6 On Conc. Base To Lamp Post At S.W. Corner Of Inter. Wiley Post Rd & Midway Rd. Elev. 631.34
B.M. #7 On Bottom Step To Loading Dock At 15502 Midway Rd. Elev. 636.05

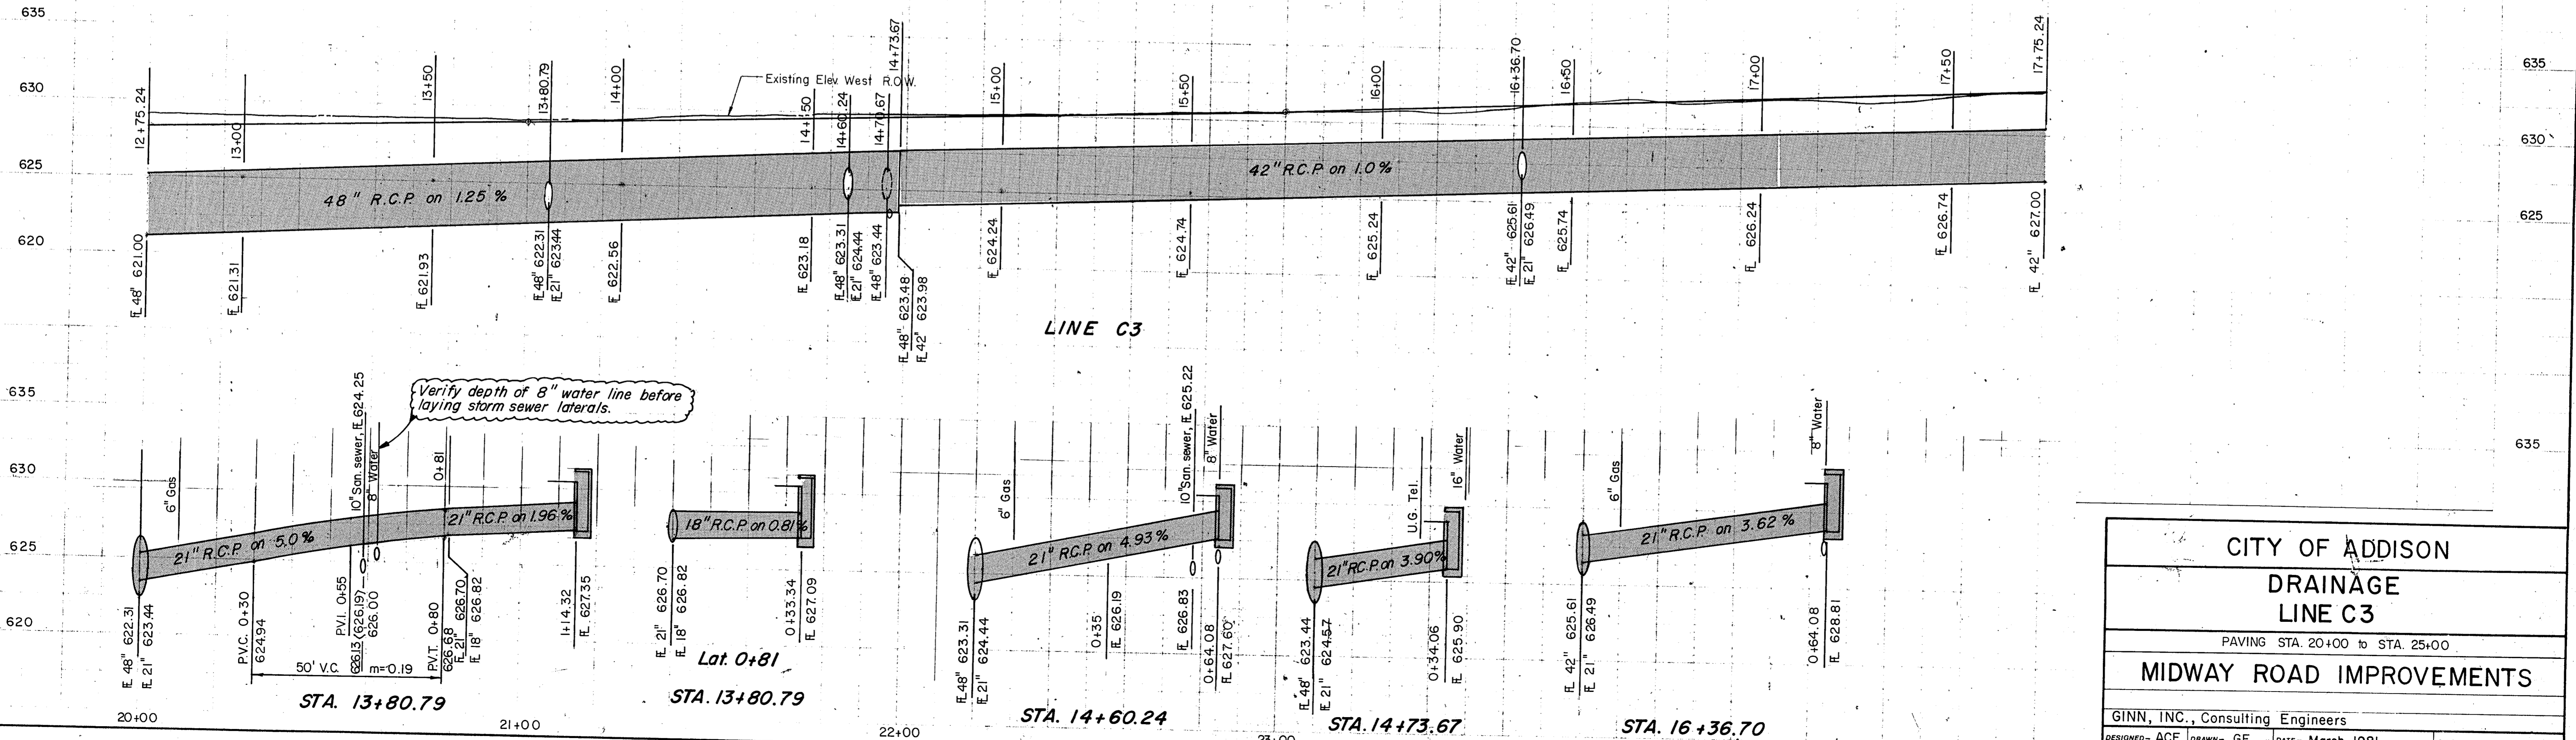

CITY OF ADDISON			
DRAINAGE			
LINE C3			
PAVING STA. 20+00 to STA. 25+00			
MIDWAY ROAD IMPROVEMENTS			
GINN, INC., Consulting Engineers			
DESIGNED - ACF	DRAWN - GF	DATE - March, 1981	FILE
APPROVED - HWG	CHECKED - HBJ	SCALE - 1"=20'H, 1"=5'V	SHEET 19 OF

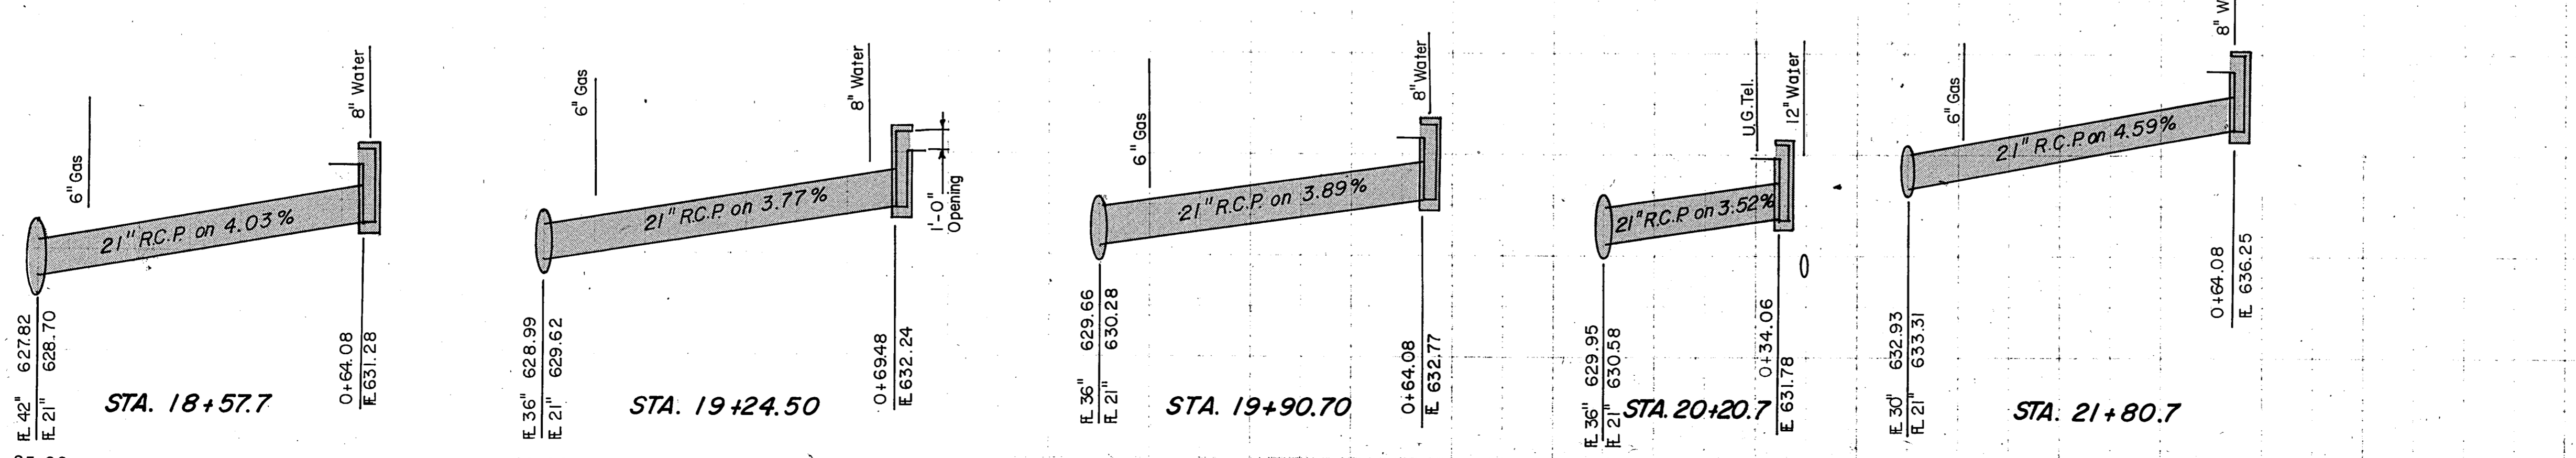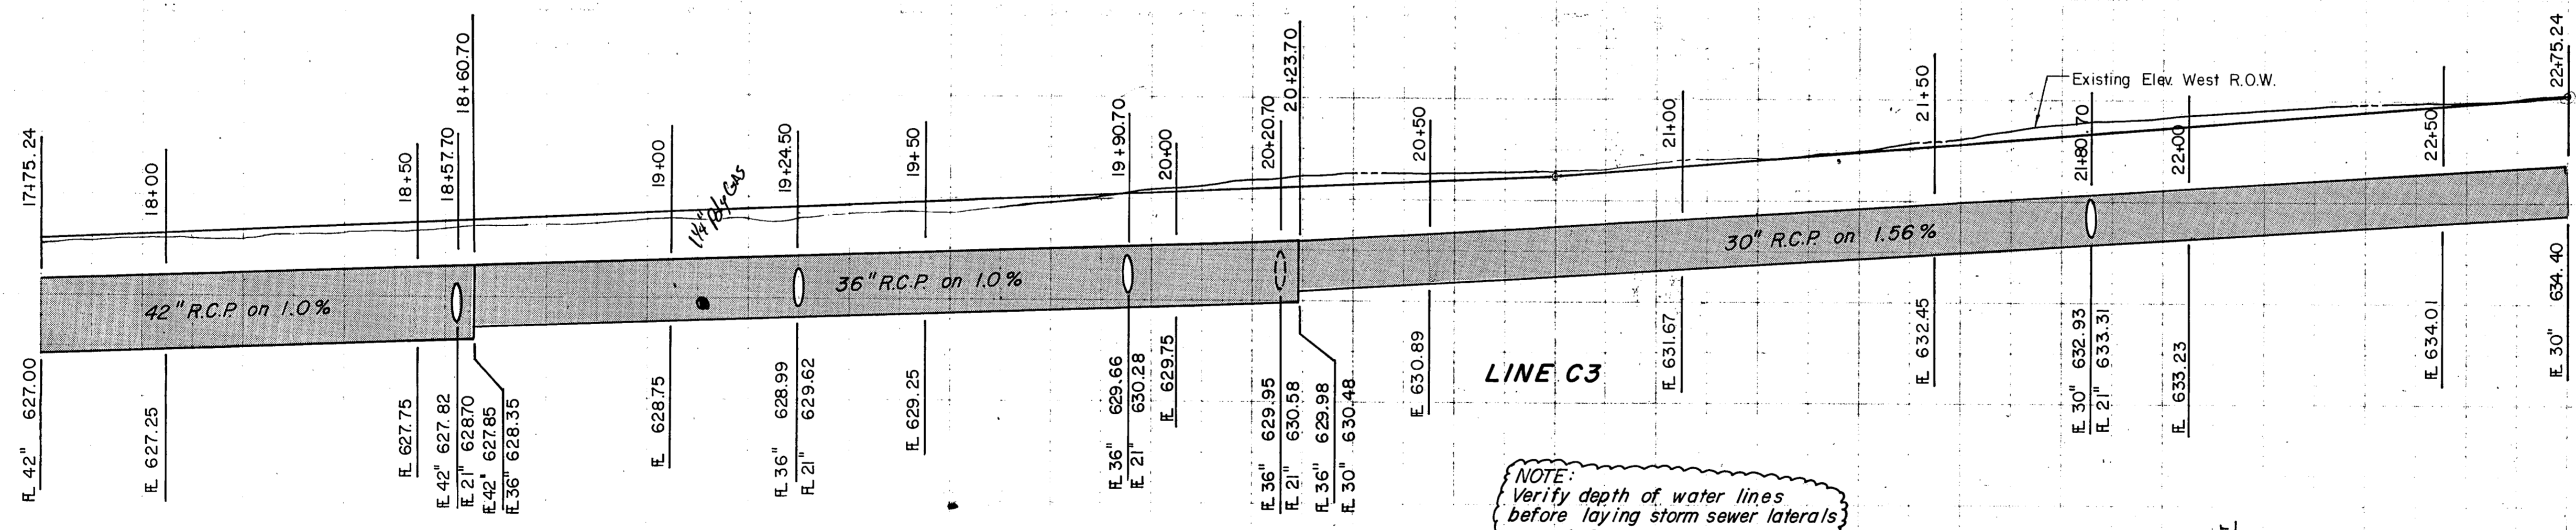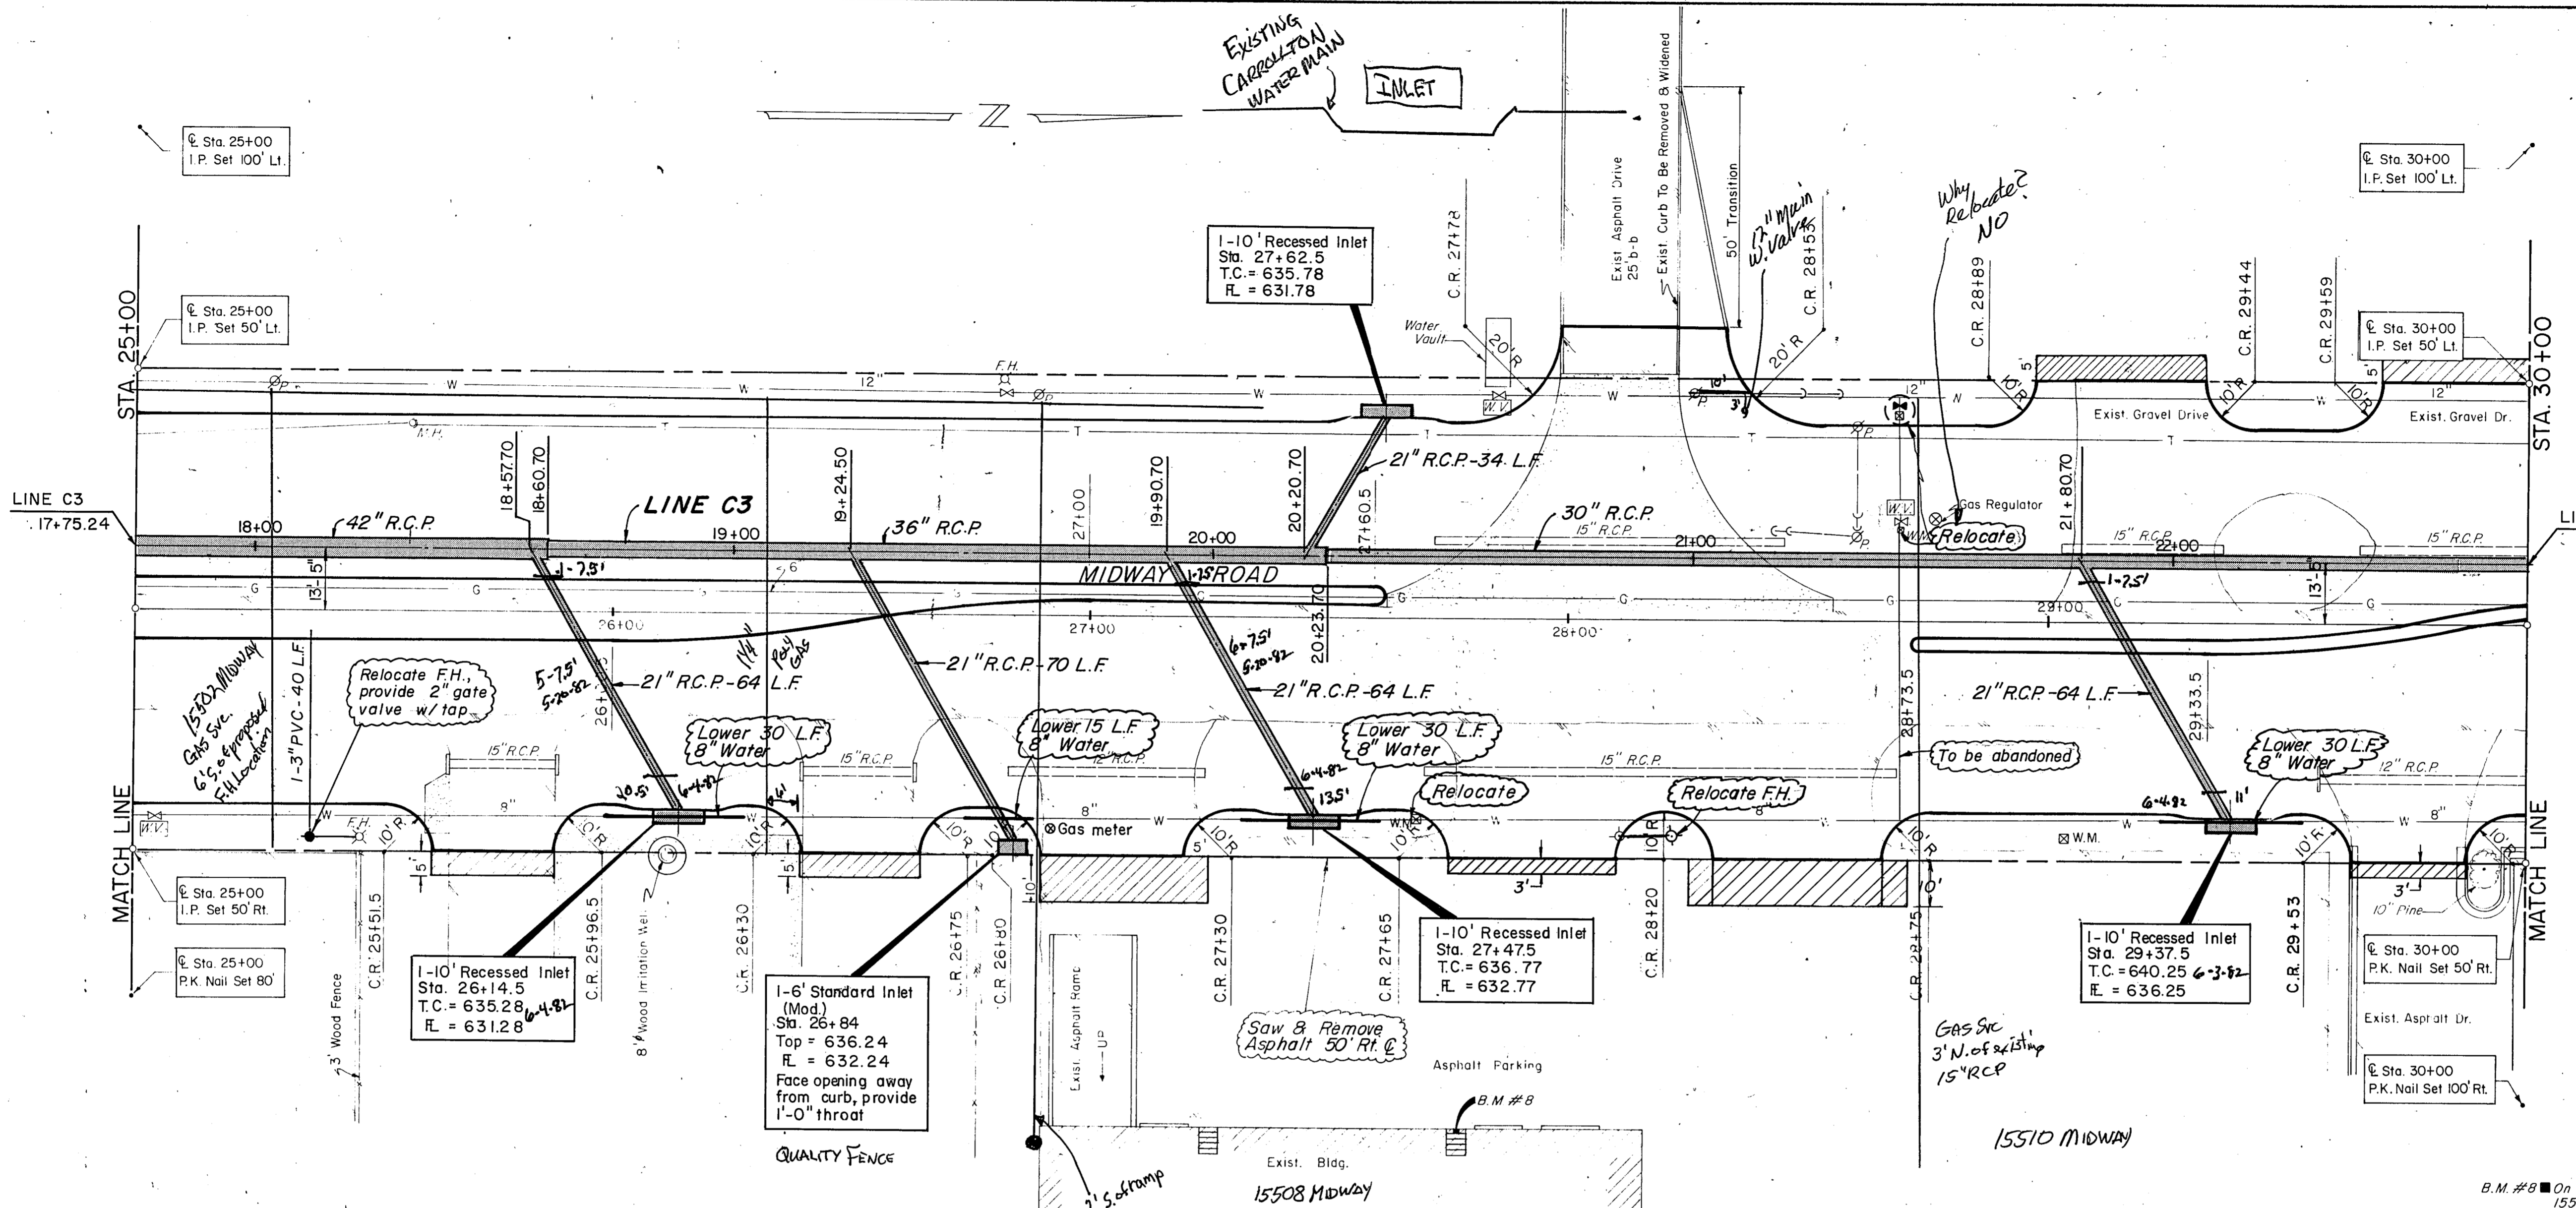

NOTE: Verify depth of water lines before laying storm sewer laterals

CITY OF ADDISON
DRAINAGE
LINE C3

PAVING STA. 25+00 to STA. 30+00

MIDWAY ROAD IMPROVEMENTS

GINN, INC., Consulting Engineers			
DESIGNED- ACF	DRAWN- GF	DATE- MARCH, 1981	FILE
APPROVED- HWG	CHECKED- HBJ	SCALE- 1"=20'H, 1"=5'V	SHEET 20 OF

Sta. 30+00
I.P. Set 100' Lt.

Sta. 30+00
I.P. Set 50' Lt.

Sta. 30+00
I.P. Set 50' Rt.

Sta. 30+00
I.P. Set 100' Rt.



Sta. 35+00
I.P. Set 100' Lt.

Sta. 35+00
I.P. Set 50' Lt.

Sta. 35+00
I.P. Set 50' Rt.


Sta. 35+00
I.P. Set 100' Rt.

CAUTION: Underground Telephone

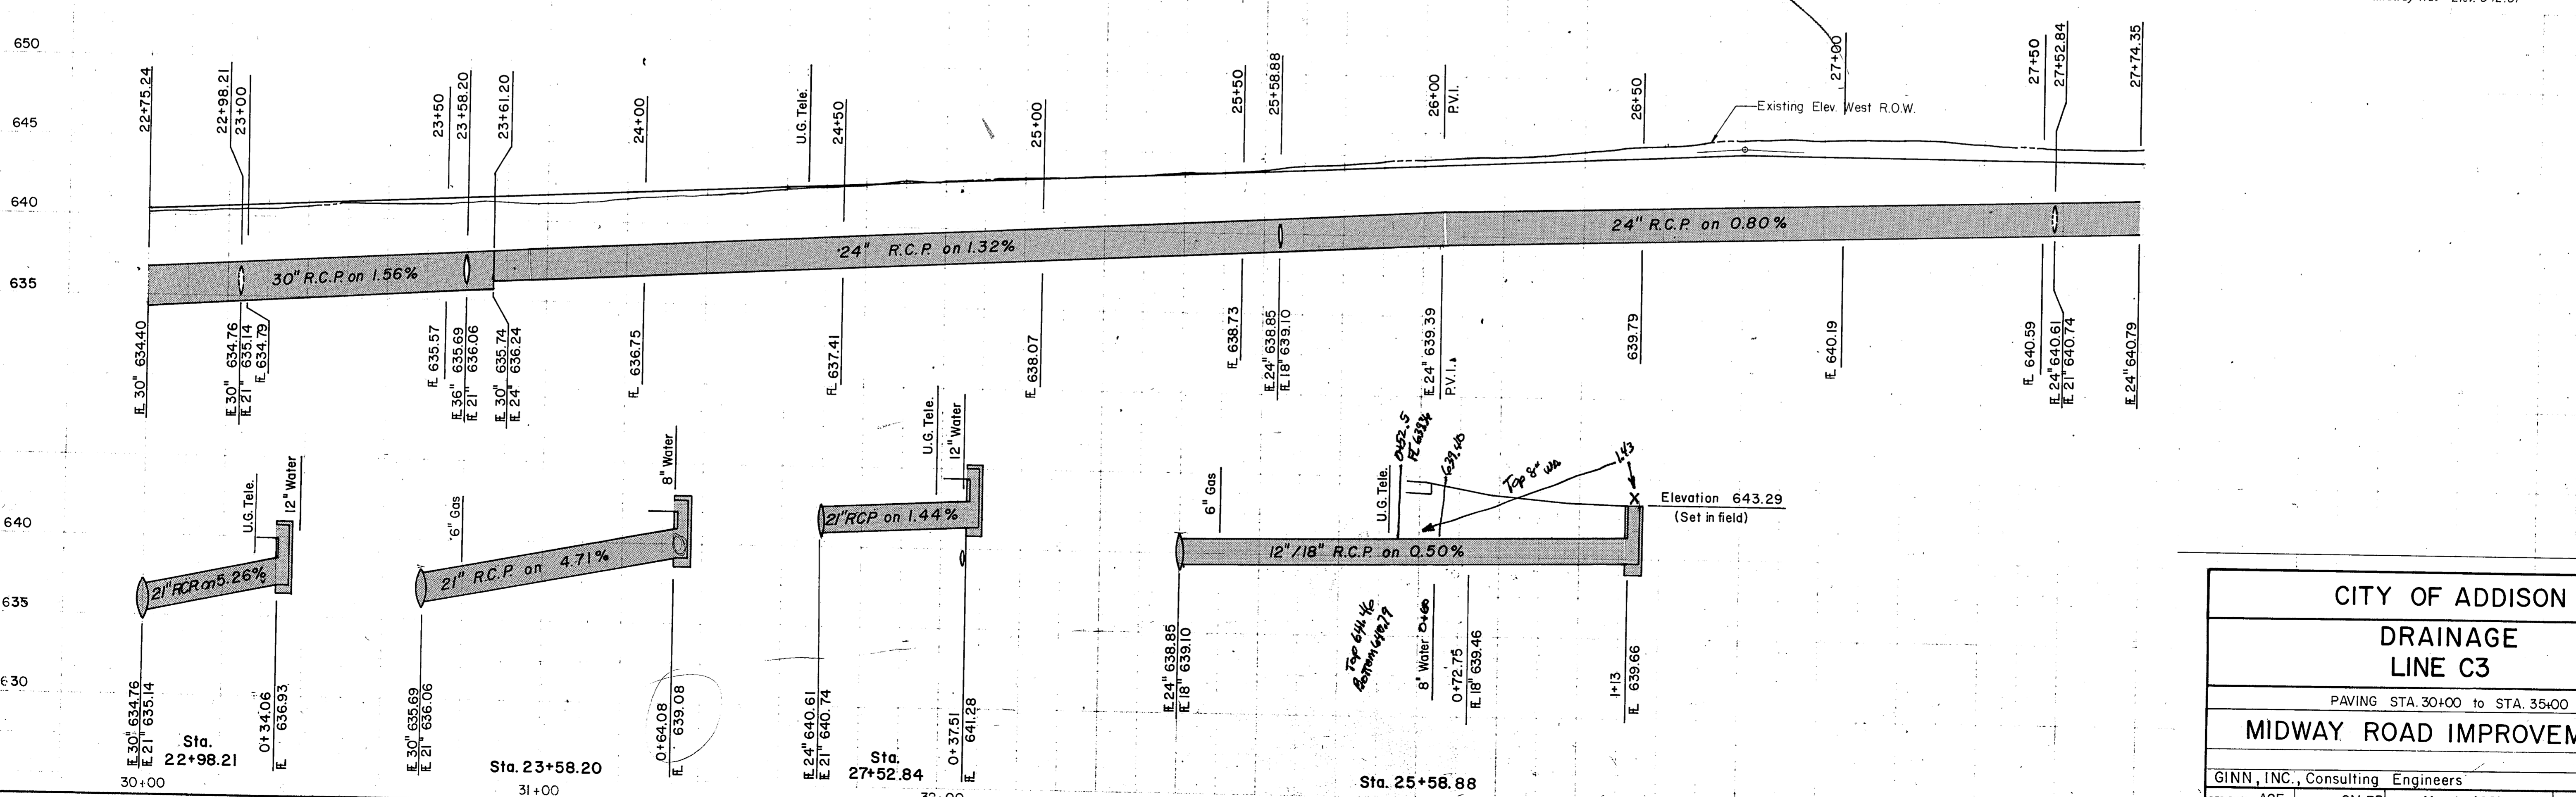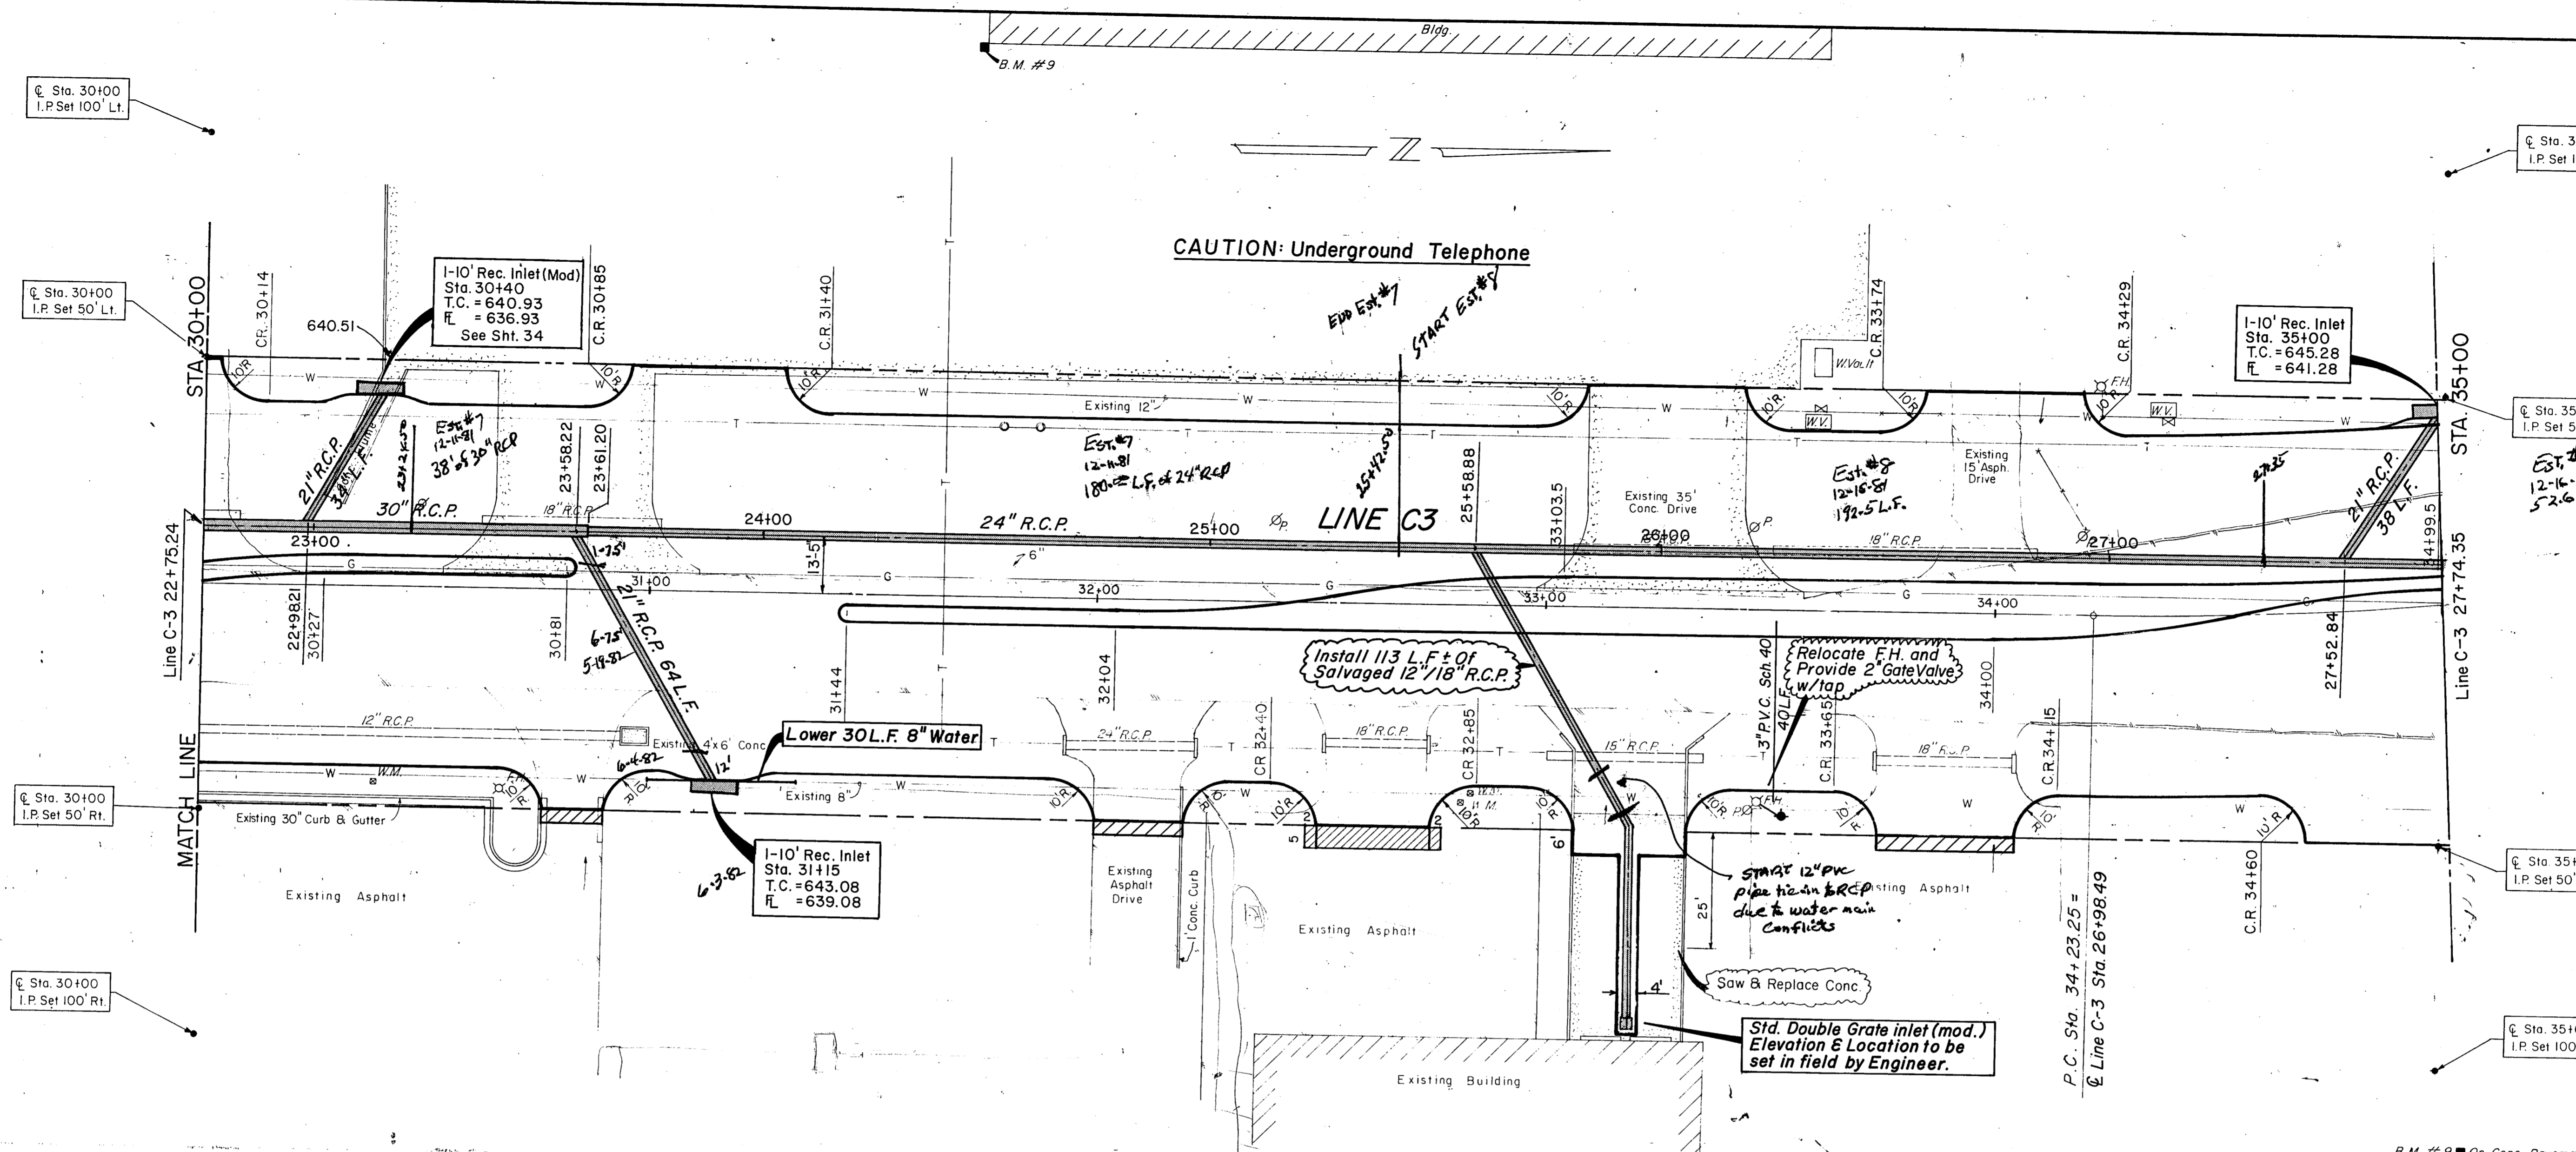


B.M. #9 On Conc. Pavement At S.E. Corner Of Bldg. At 15635 Midway Rd. Elev. 642.61


CITY OF ADDISON			
DRAINAGE LINE C3			
PAVING STA. 30+00 TO STA. 35+00			
MIDWAY ROAD IMPROVEMENTS			
GINN, INC., Consulting Engineers			
DESIGNED - ACF	DRAWN - SM RB	DATE - March, 1981	FILE
APPROVED - HWG	CHECKED - HBJ	SCALE - 1" = 20' H, 1" = 5' V	SHEET 21 OF

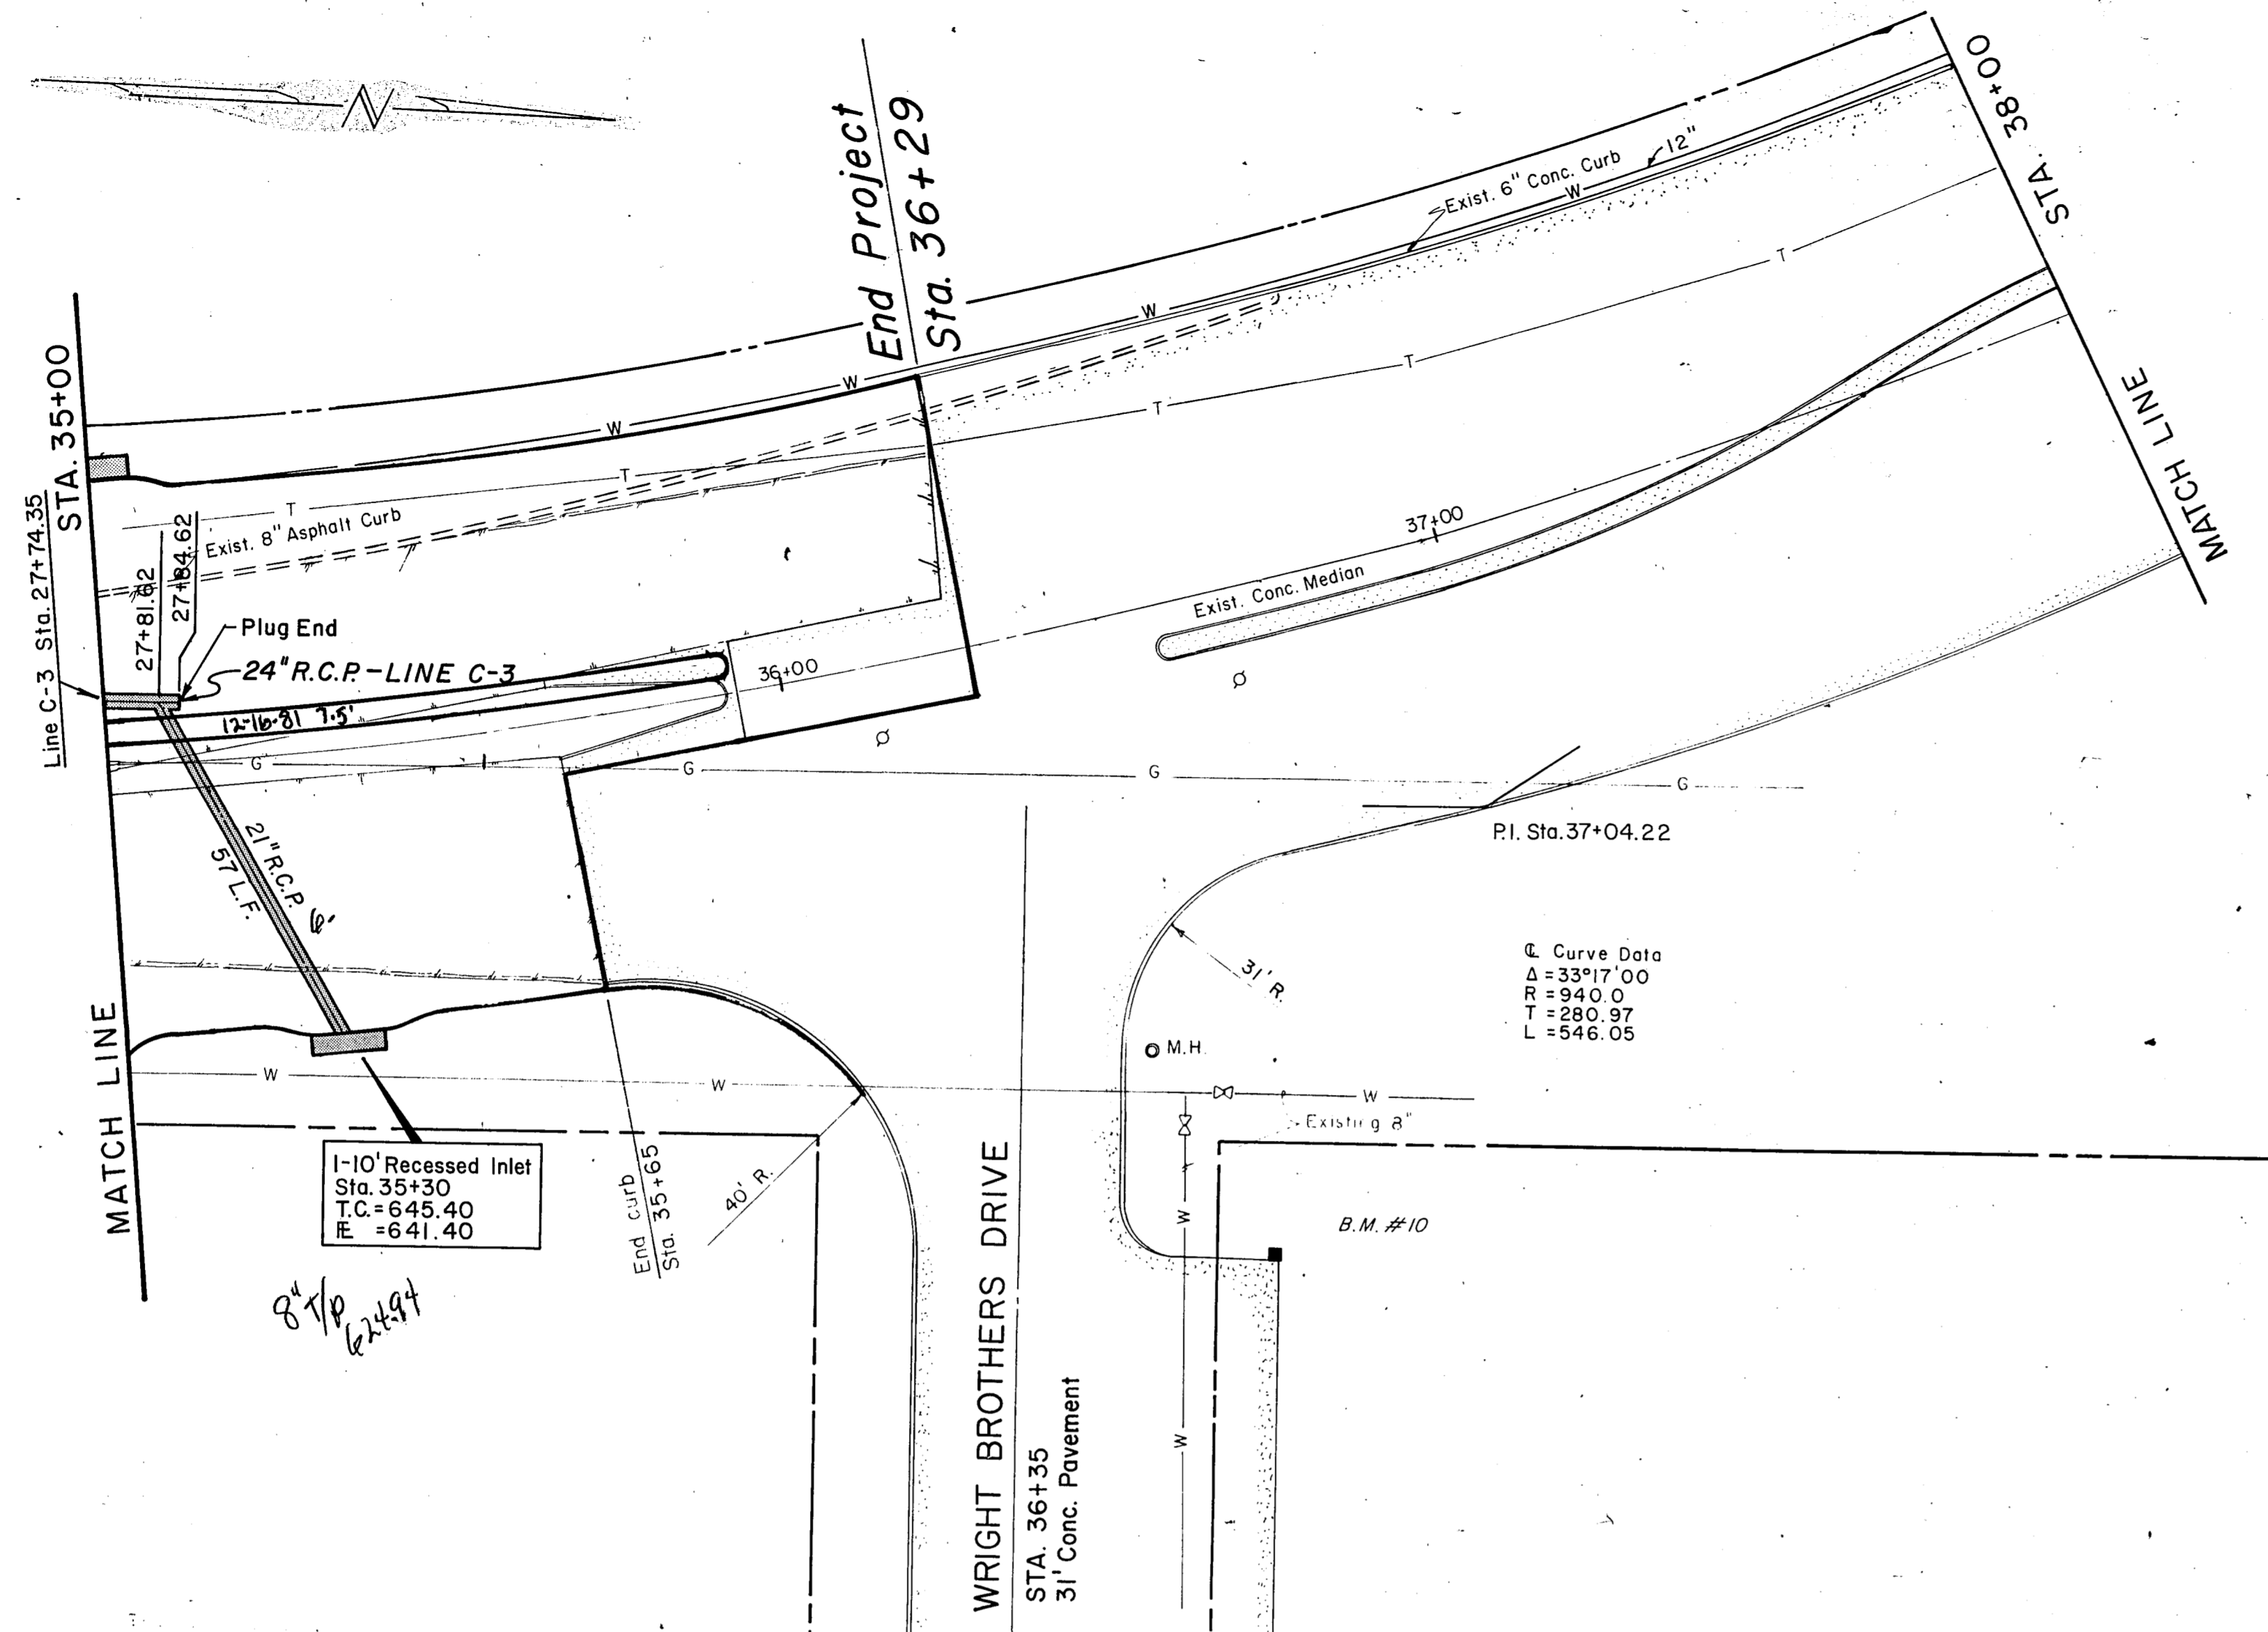


B.M. #10 On Corner Curb At N.W. Corner Of Parking At Wright Brothers Dr. E 15700 Midway Rd. Elev. 647.28

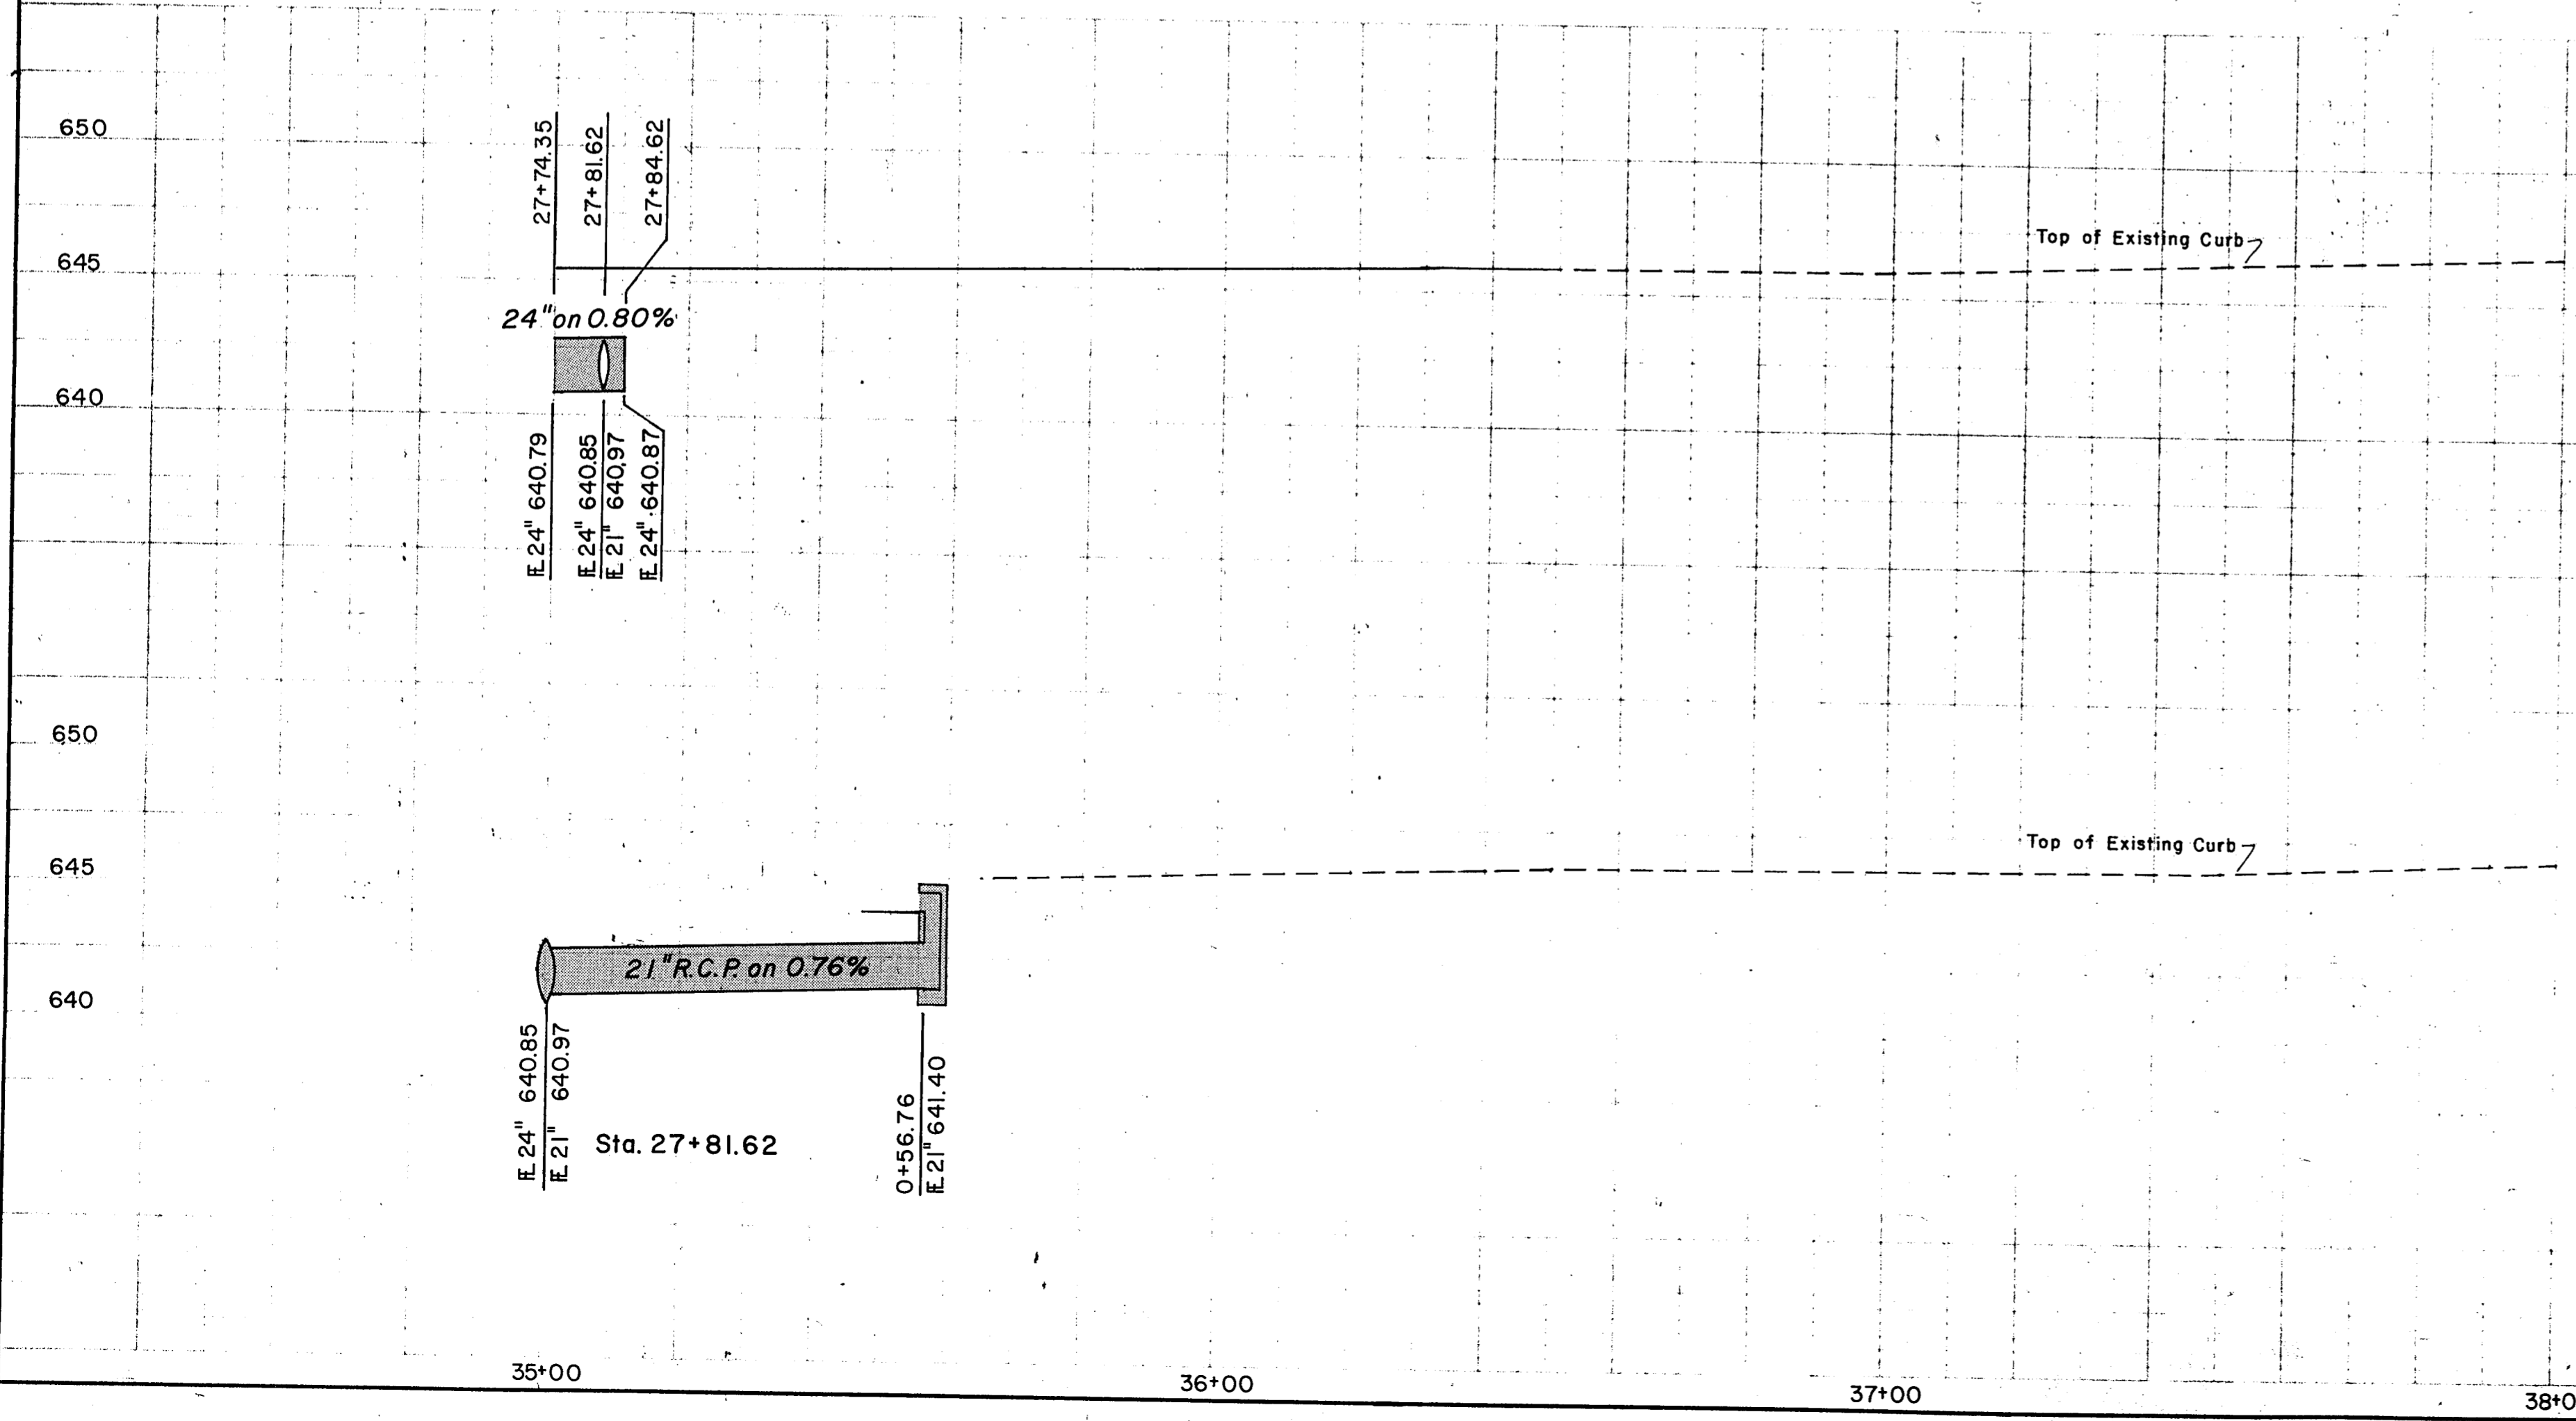




CITY OF ADDISON			
DRAINAGE LINE C3			
PAVING STA. 35+00 to STA 36+29			
MIDWAY ROAD IMPROVEMENTS			
GINN, INC., Consulting Engineers			
DESIGNED - ACF	DRAWN - RGB	DATE - MARCH, 1981	FILE
APPROVED - HWG	CHECKED - HBJ	SCALE - 1" = 20'H, 1" = 5'V	SHEET 22 OF

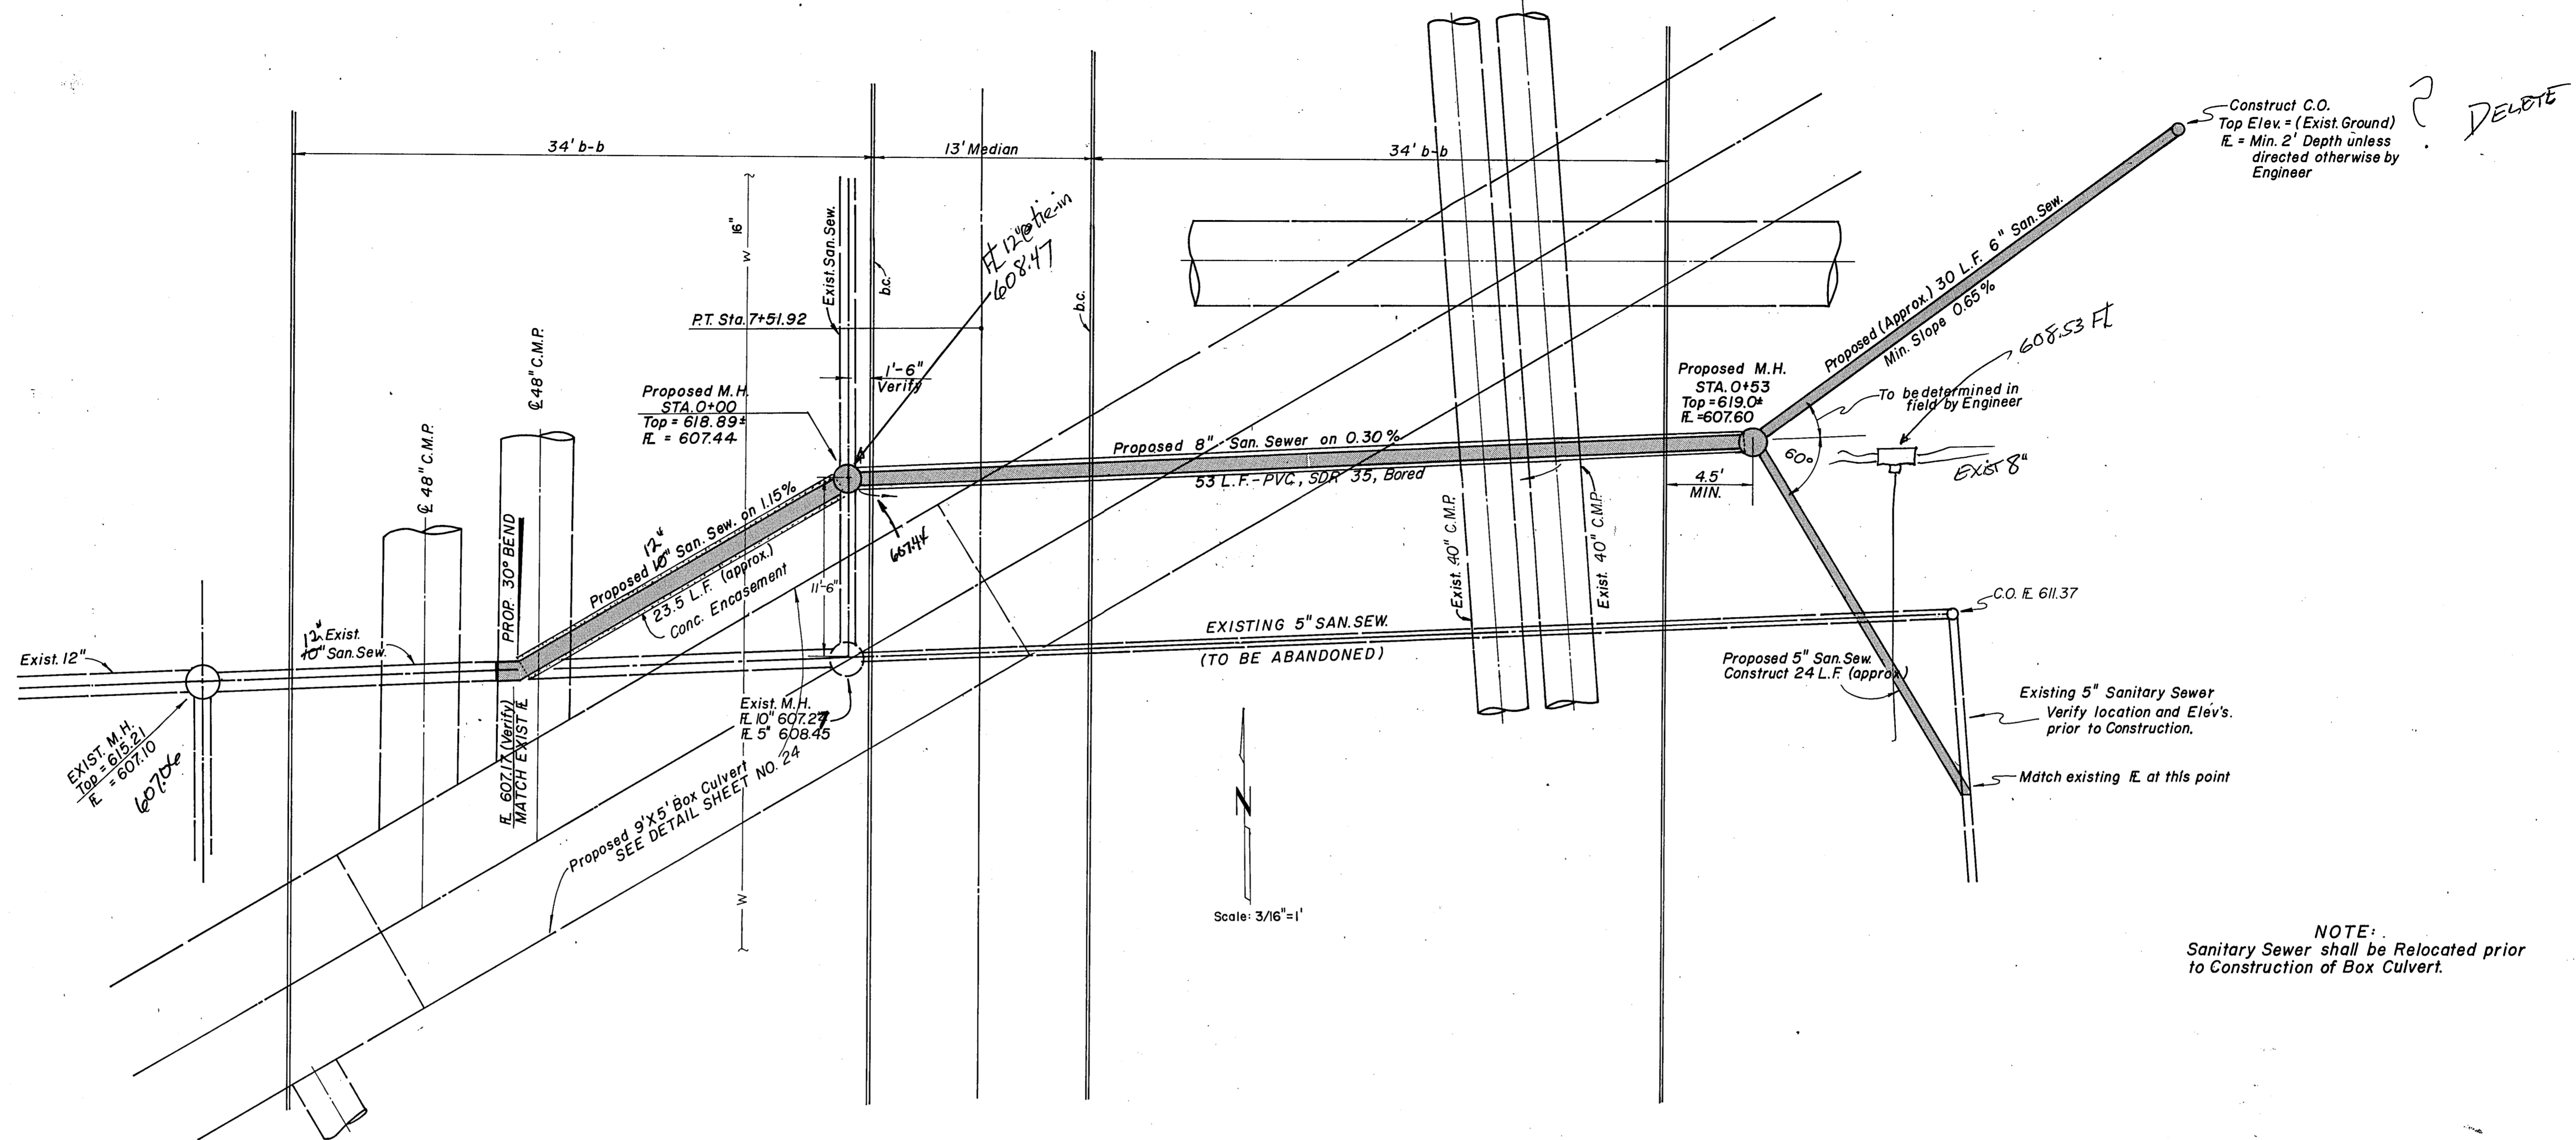

NOTE:
Sanitary Sewer shall be Relocated prior to Construction of Box Culvert.

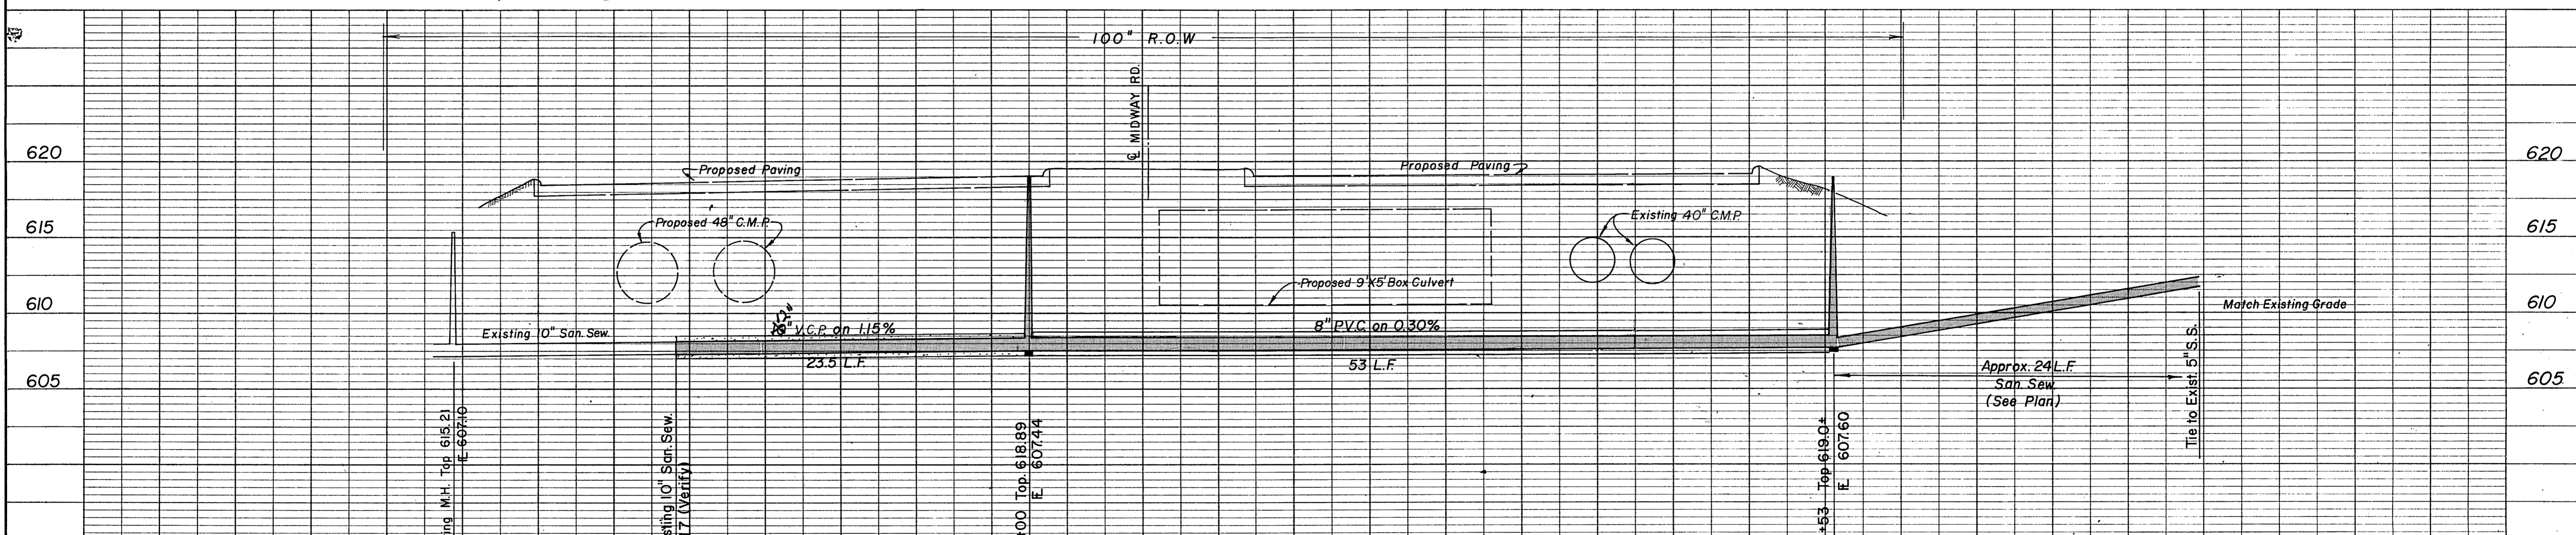

CITY OF ADDISON			
SANITARY SEWER			
RELOCATION			
MIDWAY ROAD IMPROVEMENTS			
GINN, INC., Consulting Engineers	DESIGNED-ACF	DRAWN-RGB	DATE-MARCH, 1981
APPROVED-HWJ	CHECKED-HBJ	SCALE-3/16"=1'H. 1"=5'V	FILE SHEET 23 OF 1

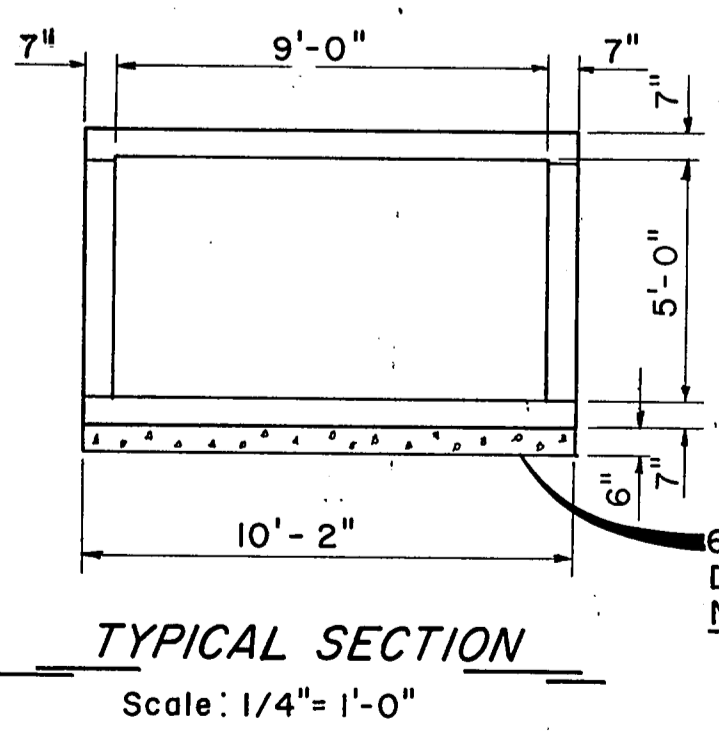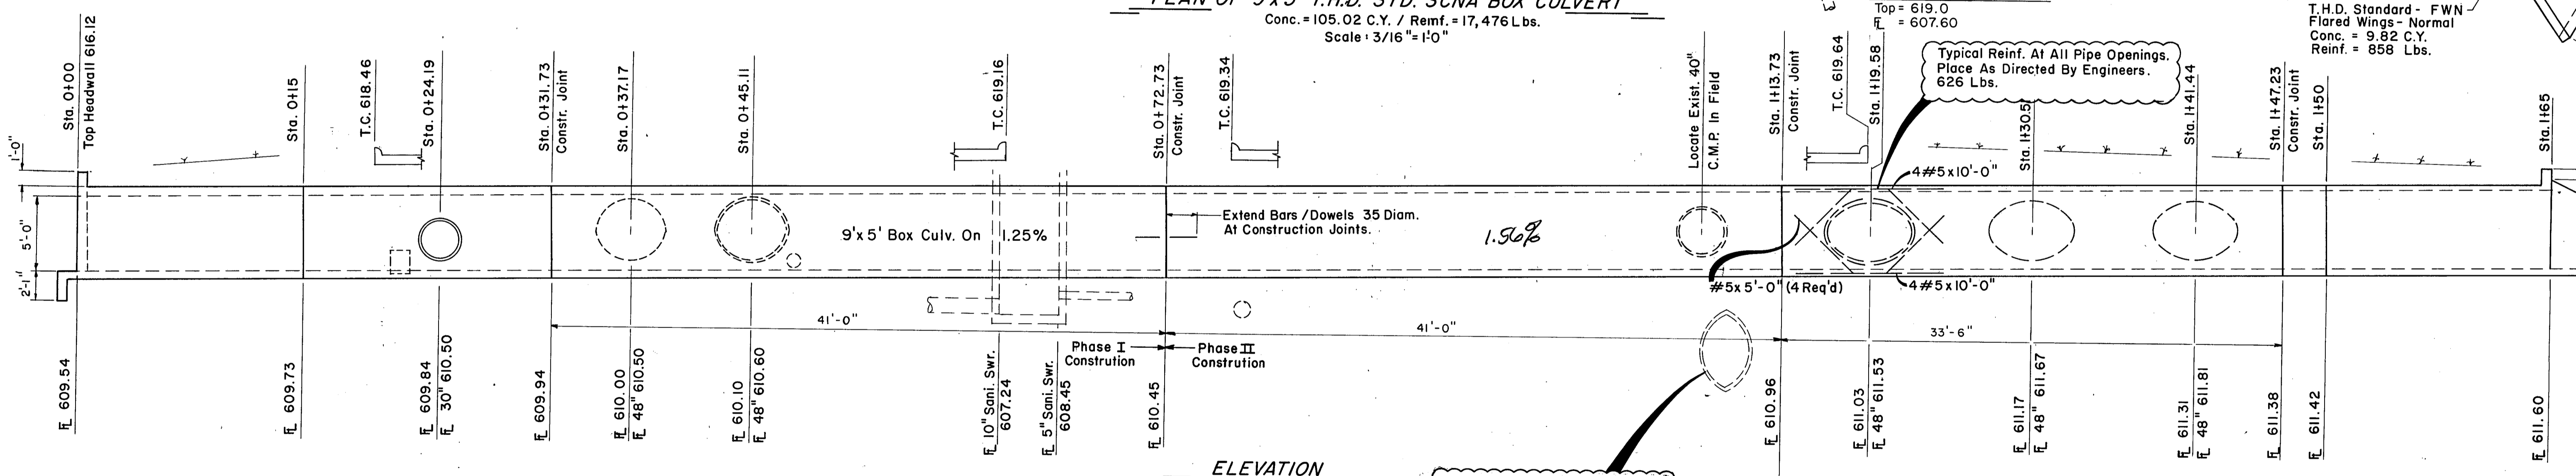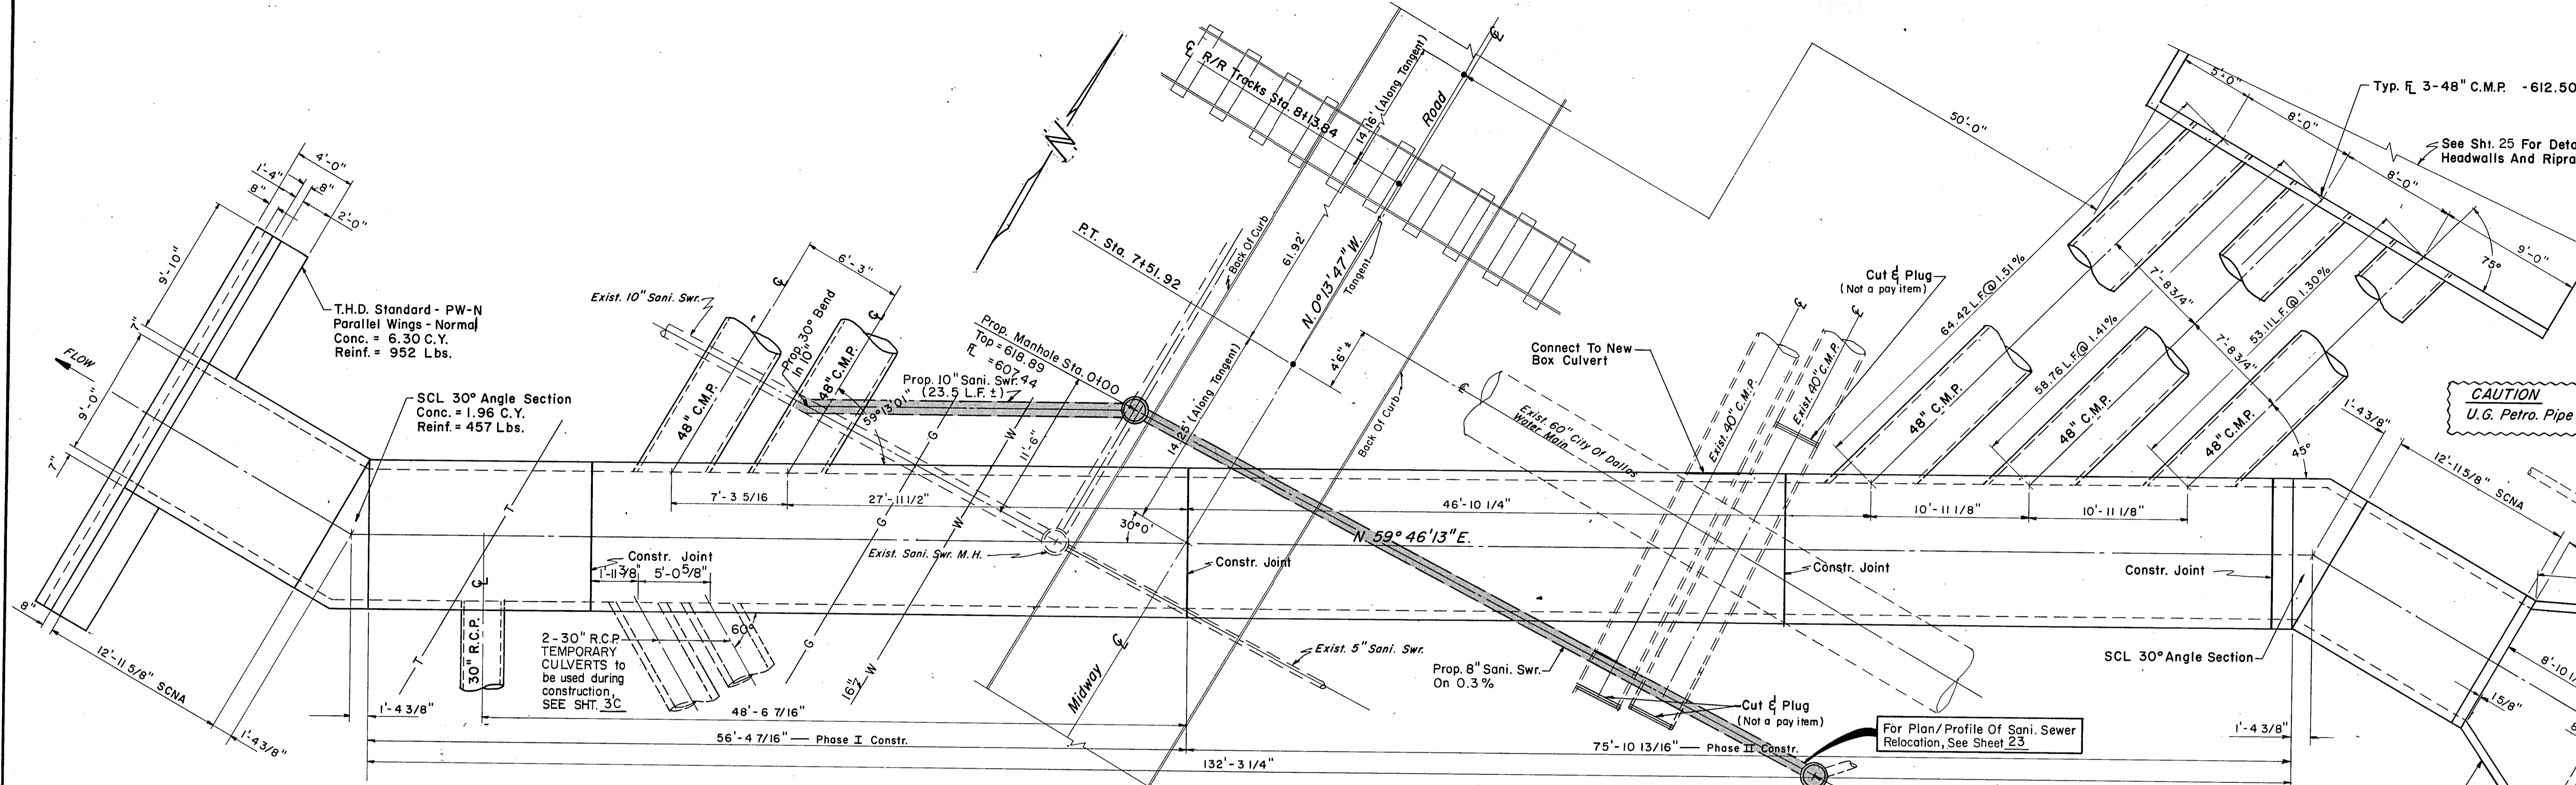

Note:
 Subgrade material below 6" gravel base must be of a compactible nature. All undesirable material must be removed and replaced by dry embankment material compacted as directed by the Engineer. Cost of subgrade excavation to be considered subsidiary to cost of box culvert. Areas of concern fall within old channel both ends.

ESTIMATED QUANTITIES	
Class A Concrete (Box Culvert)	109.1 C.Y.
Reinf. (Box Culvert)	19,016.0 Lbs.
Gravel Base (6")	35.0 C.Y.
Class A Concrete (Wingwalls)	16.1 C.Y.
Reinf. (Wingwalls)	1,810.0 Lbs.


GENERAL NOTES:
 For notes and details not shown see the following Texas Highway Department Standards:
 Single Culverts - Normal SC-NA Direct Traffic to 10'-0" Fill Lengthening Details 30° Skew SCL 30°
 Parallel Wings - Normal Single Box Culverts PW-N
 Flared Wings - Normal Single Box Culverts FW-N

CITY OF ADDISON
 DALLAS COUNTY, TEXAS
MIDWAY ROAD

9'x5' BOX CULVERT DET.

GINN, INC.
 Consulting Engineers - Dallas, Texas

Designed-C.F.	Drawn-S.M.M	Date- MARCH, 1981
Approved-H.W.G.	Checked-G.F.	Scale- AS SHOWN

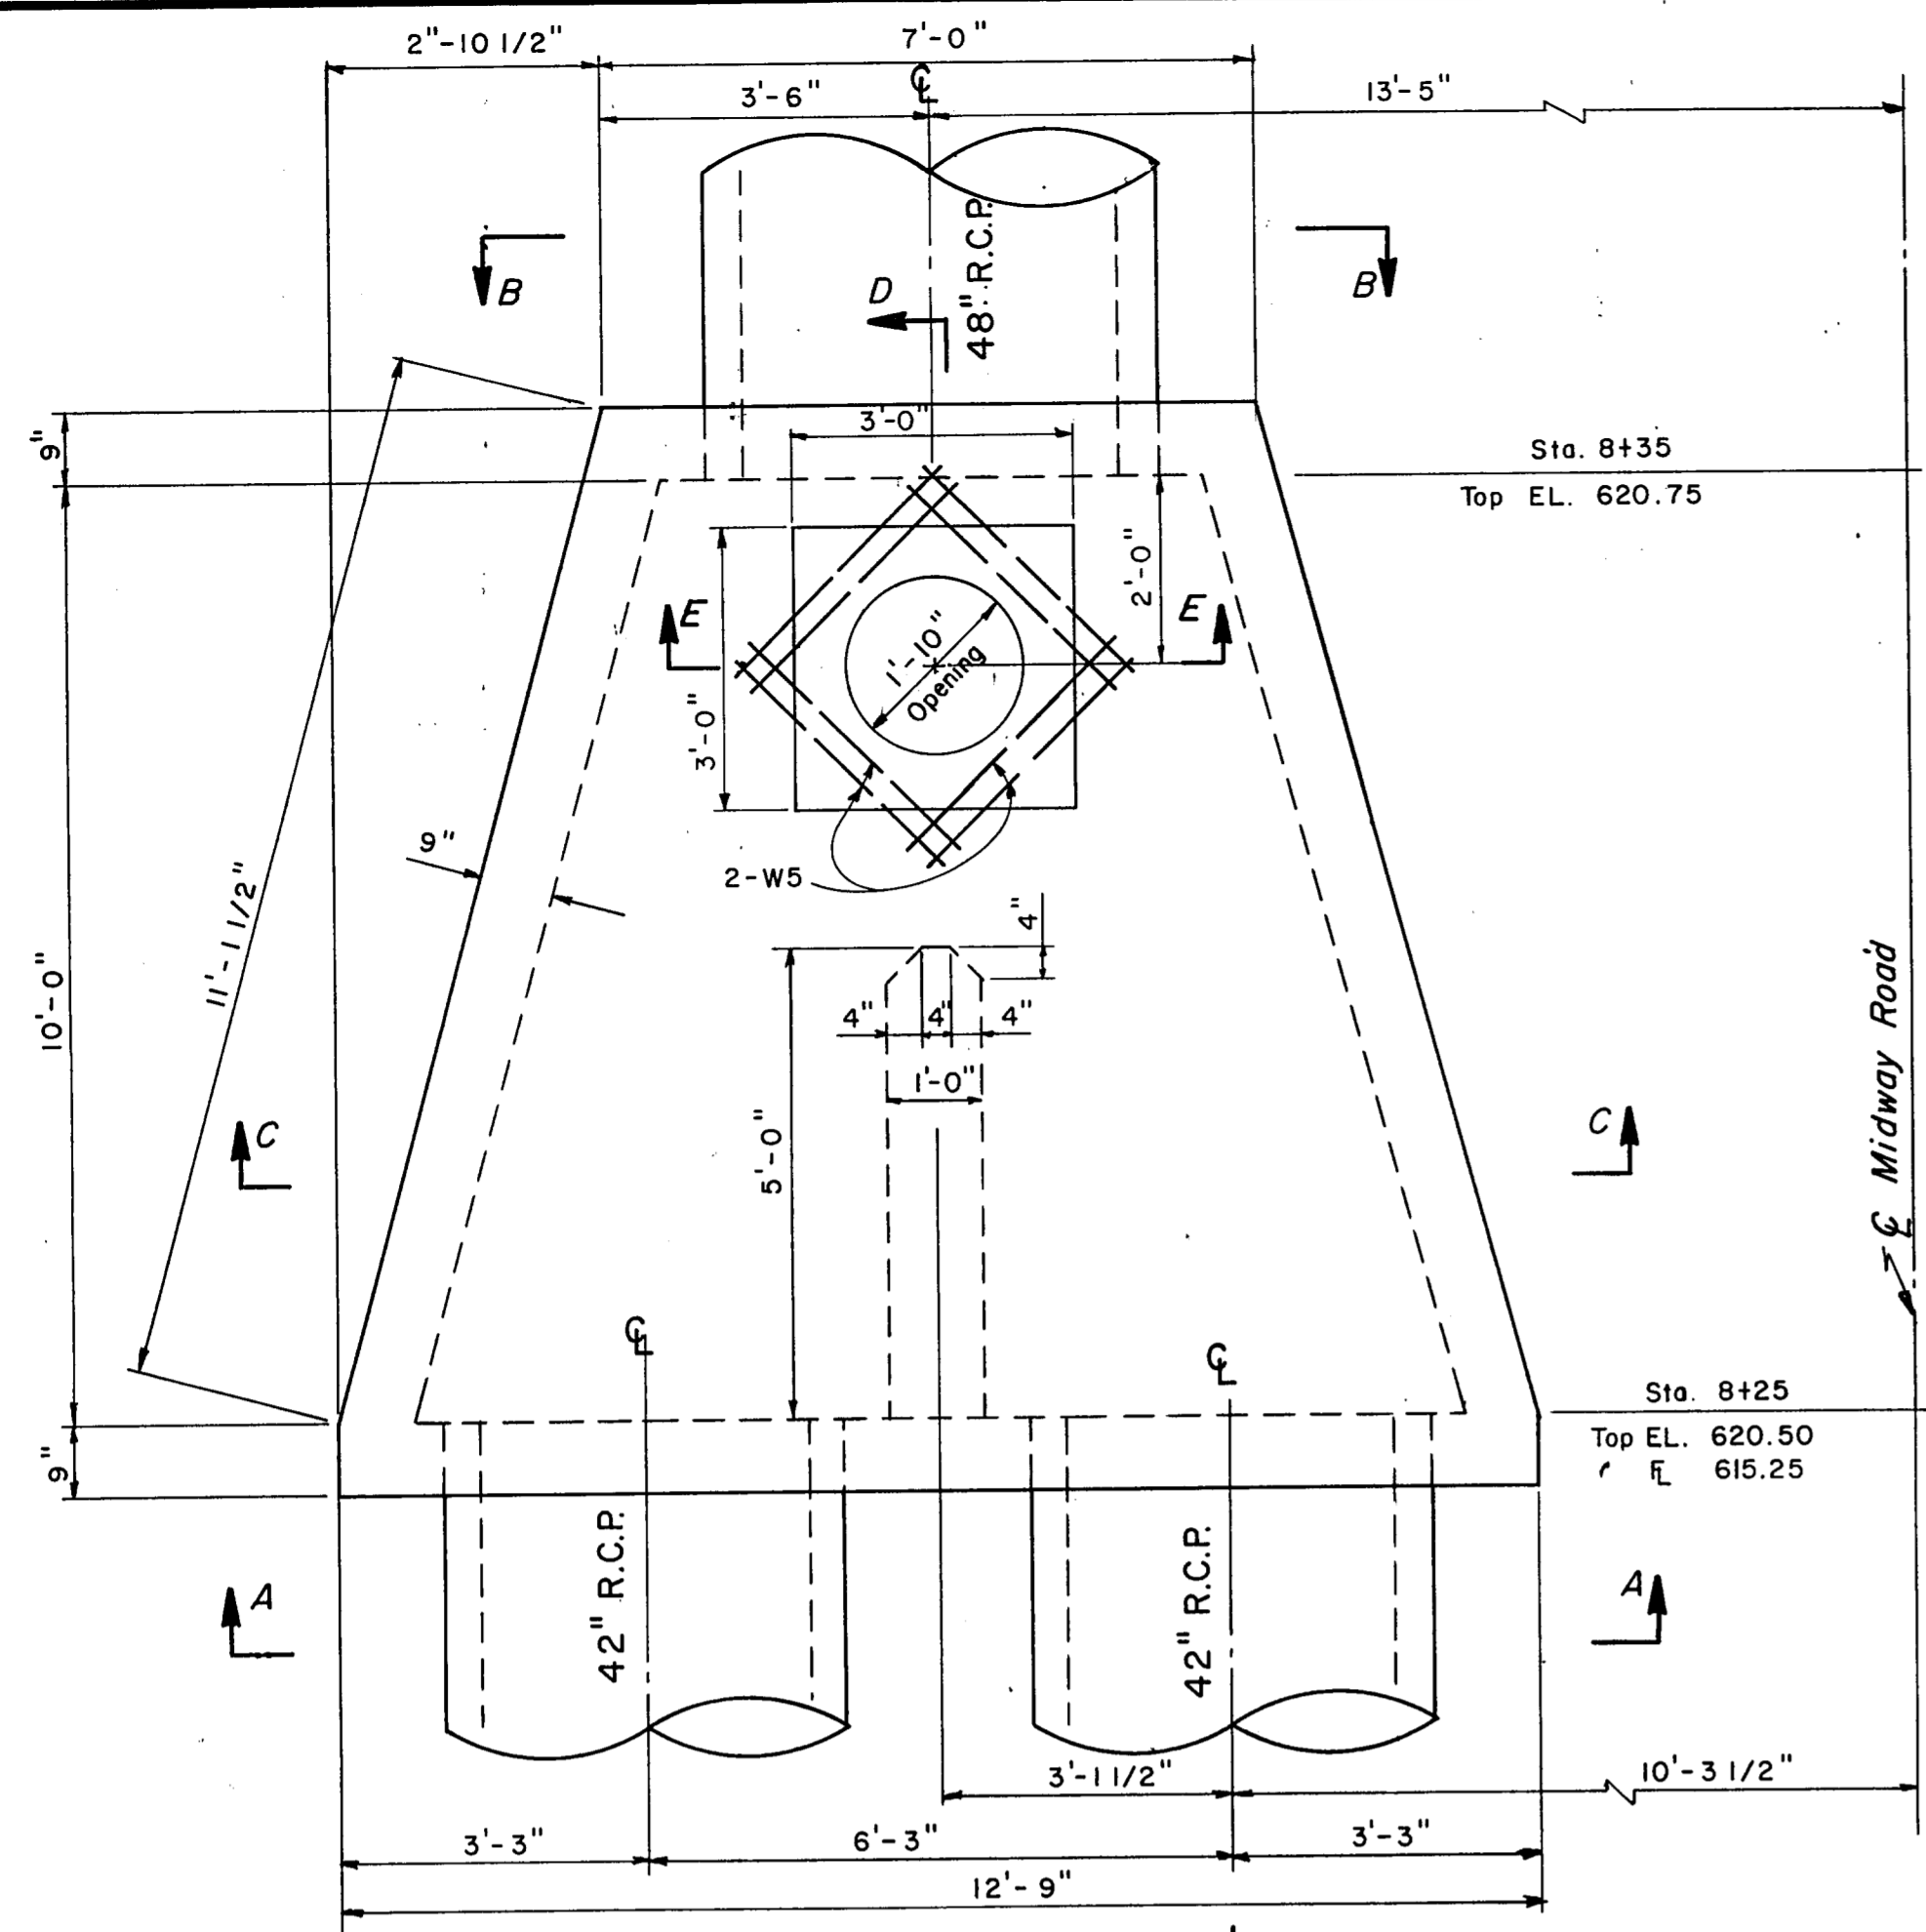


PLAN
Scale: 1/2" = 1'-0"

BAR SCHEDULE					
BAR	TYPE	SIZE	NO.	LENGTH	WEIGHT
B1	Str.	#5	11	9'-8" Avg.	111
B2	do	5	10	9'-8" Avg.	101
B3	do	5	1	12'-6"	13
B4	do	5	1	6'-9"	7
B5	do	5	12	11'-4" Avg.	142
B6	do	5	12	11'-4" Avg.	142
B7	Bt.	5	2	11'-7"	24
S1	Bt.	5	26	8'-5"	228
S2	Str.	4	32	5'-2"	110
S3	Str.	5	12	7'-2"	90
S4	do	5	6	8'-4"	52
H1	Bt.	4	16	11'-7"	124
H2	do	4	8	6'-2"	33
H3	do	4	16	2'-0"	21
W1	Str.	5	8	4'-0"	33
W2	do	5	8	3'-0"	25
W3	do	5	4	3'-6"	15
W4	do	5	4	3'-9"	16
W5	do	5	16	4'-6"	75
T1	Str.	5	11	9'-8" Avg.	111
T2	do	7	15	9'-8" Avg.	293
T3	do	5	1	12'-6"	13
T4	do	5	1	6'-9"	7
T5	do	4	12	11'-4" Avg.	91
T6	do	5	12	11'-4" Avg.	142
T7	Bt.	4	2	11'-7"	16
Total					2035


BAR SCHEDULE RET. WALL 'A' & 'B'					
BAR	TYPE	SIZE	NO.	LENGTH	WEIGHT
A1	Str.	#4	2	31'-1"	42
A2	do	4	2	17'-1"	23
E1	do	5	2	30'-4"	63
E2	do	5	8	16'-4"	136
E3	do	5	6	6'-6"	41
E4	do	5	12	3'-4"	42
E5	do	5	6	2'-11"	18
F1	do	5	40	6'-5"	267
F2	Bt.	5	40	7'-5"	309
G	do	5	4	3'-0"	13
Total For Walls 'A' & 'B'					954

B1 & T1 - 7'-0" To 12'-5" In 10 Equal Steps
 B2 - 7'-4" To 12'-1" In 9 Equal Steps
 B5 & T5 - 11'-2" To 11'-7" In 5 Equal Steps
 B6 & T6 - 11'-2" To 11'-7" In 5 Equal Steps
 T2 - 7'-4" To 12'-1" In 14 Equal Steps


BARS B1, T1, B2, T2, B5, T5, B6, & T6

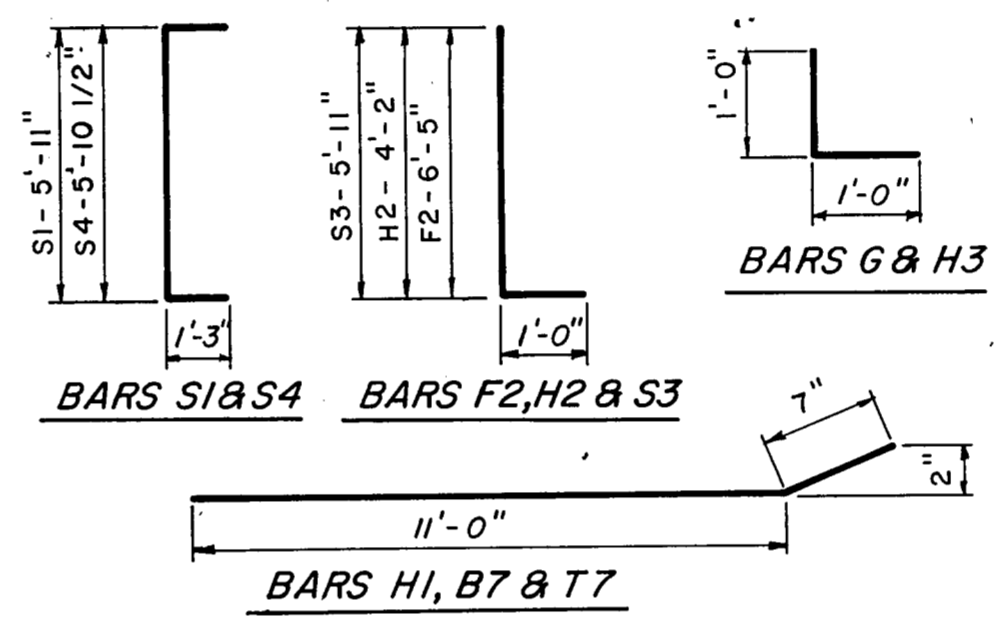


ESTIMATED QUANTITIES		
Class A Concrete (Spec. Manhole)	13.0 C.Y.	
Reinforced Steel (Spec. Manhole)	2035.0 LBS.	
Frame and Cover	1.0 EA.	

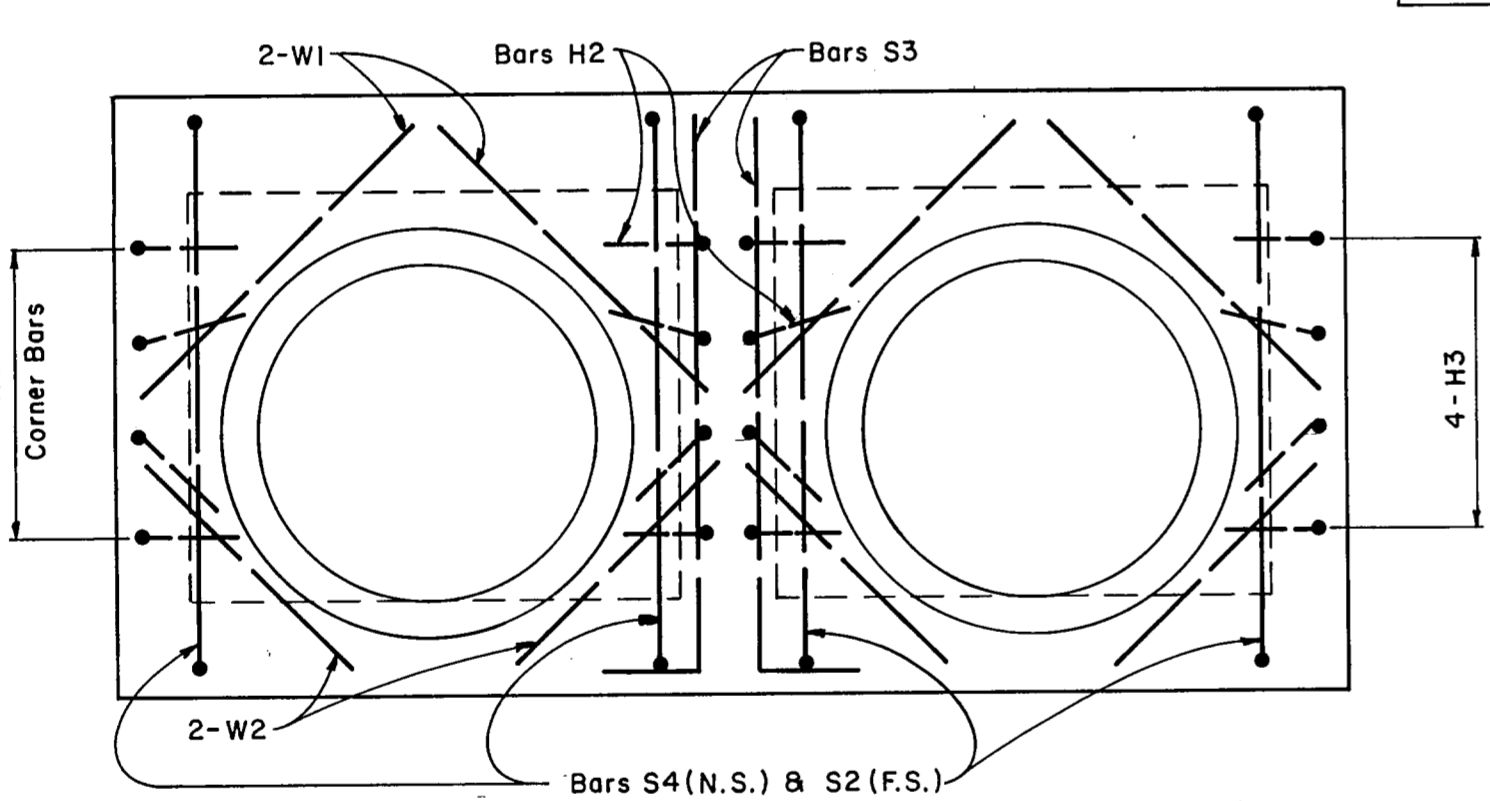


ELEV. A-A
Scale: 1/2" = 1'-0"

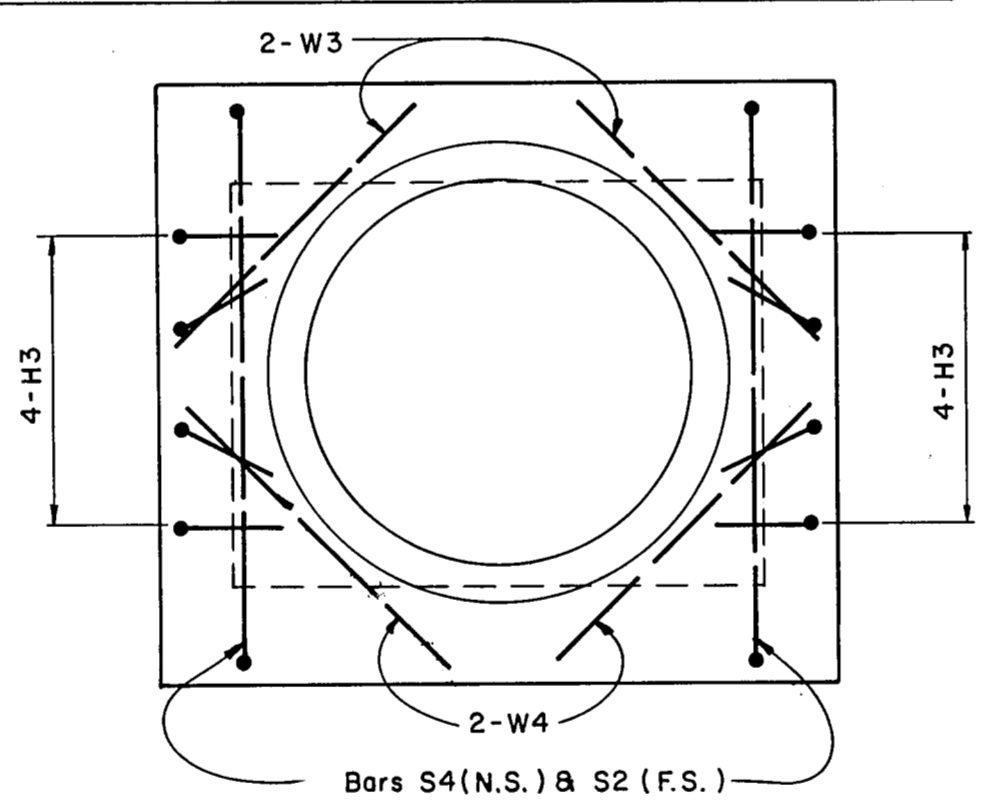


ELEV. B-B
Scale: 1/2" = 1'-0"

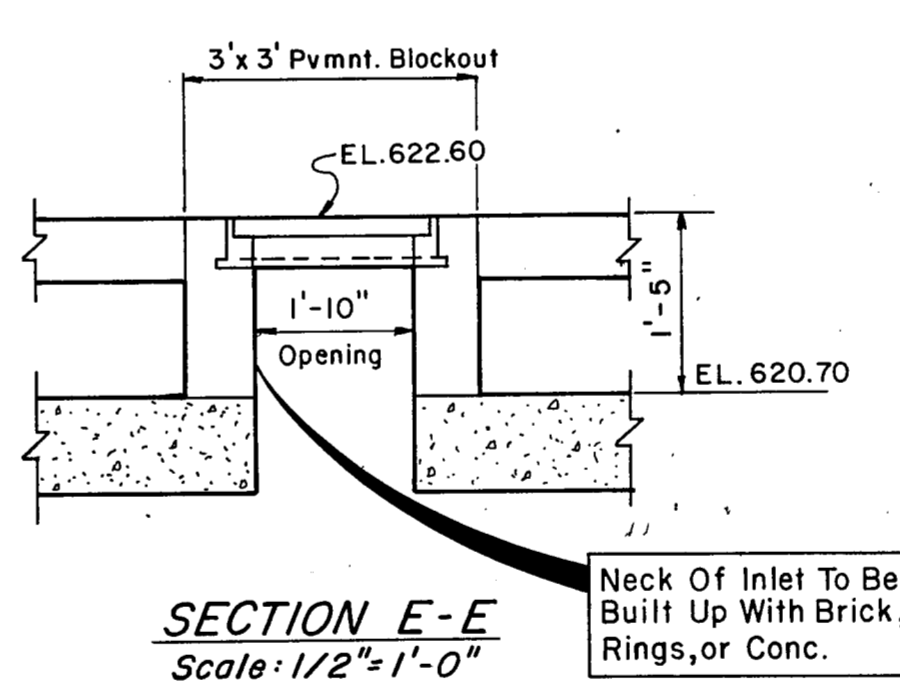

SECTION E-E
Scale: 1/2" = 1'-0"

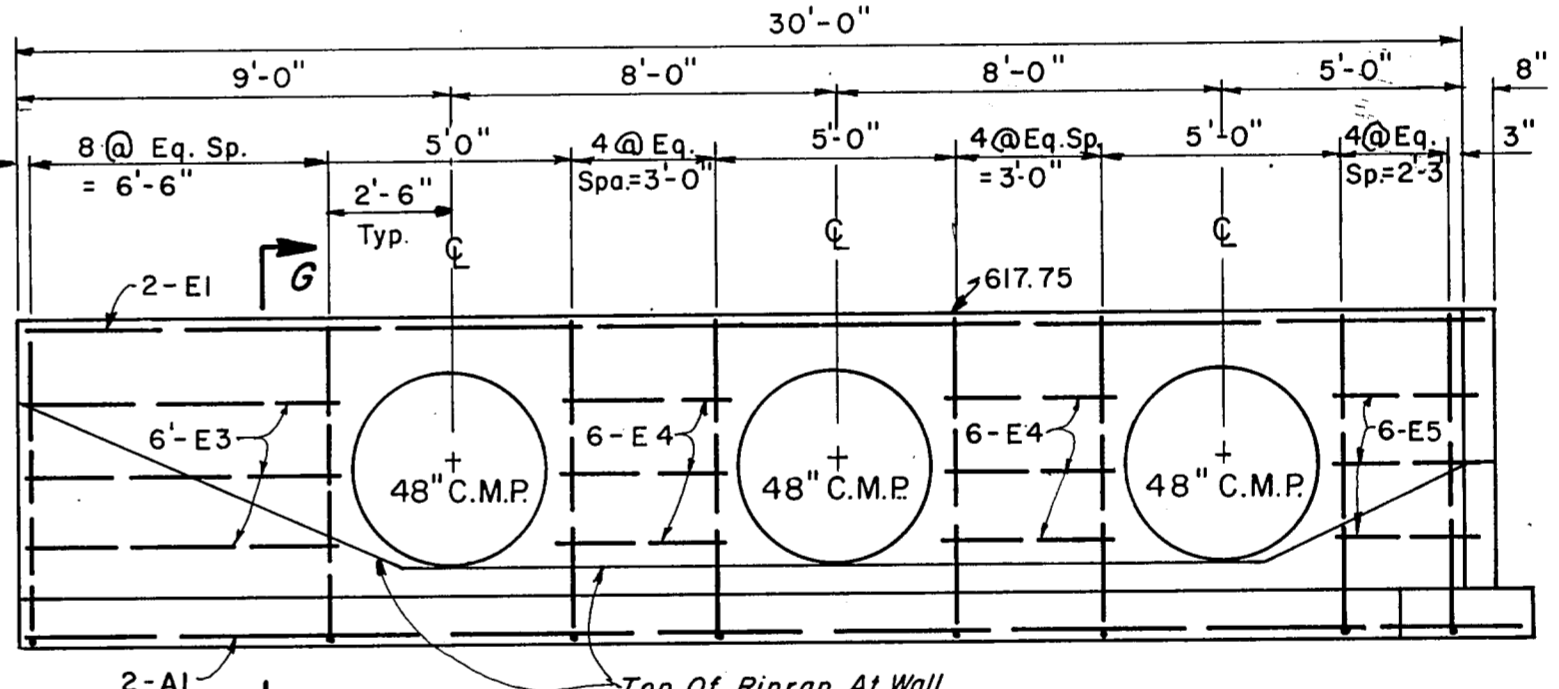


ELEVATION WALL 'A'
Scale: 1/4" = 1'-0"

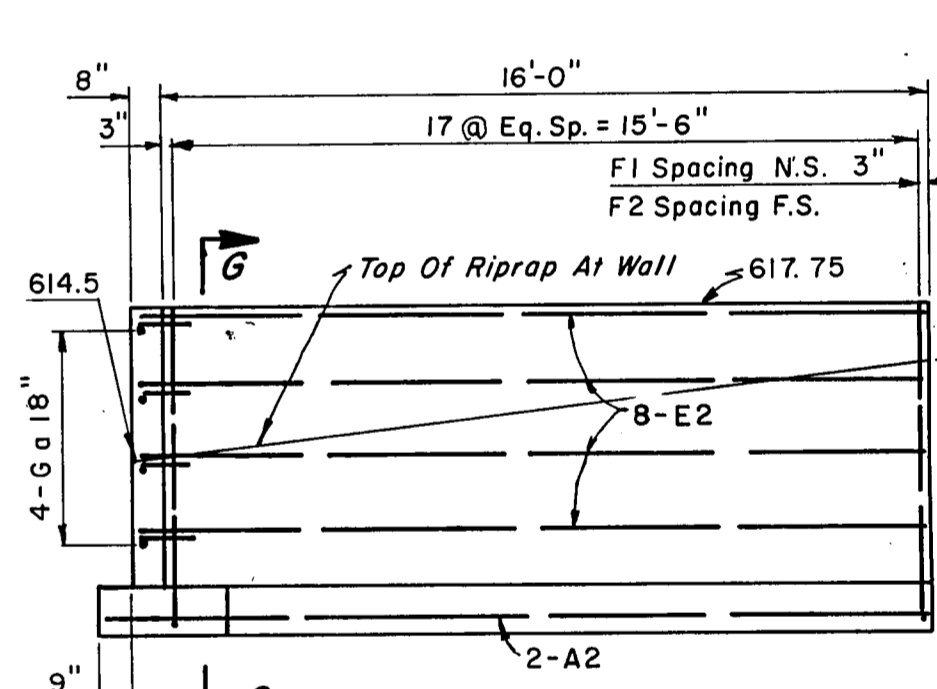


ELEVATION WALL 'B'
Scale: 1/4" = 1'-0"

Class A. Concrete (Retaining Walls)	11.7 c.y.
Reinf. Steel (Retaining Walls)	954.0 lbs.
Class A Concrete (Riprap)	15.35 c.y.


General Notes:
 All concrete shall be Class A. All exposed corners of Walls 'A' & 'B' shall be chamfered 3/4".
 All dimensions relating to reinforcing steel are to centers of bars. Reinforcing bars to be A.S.T.M. Grade 40.

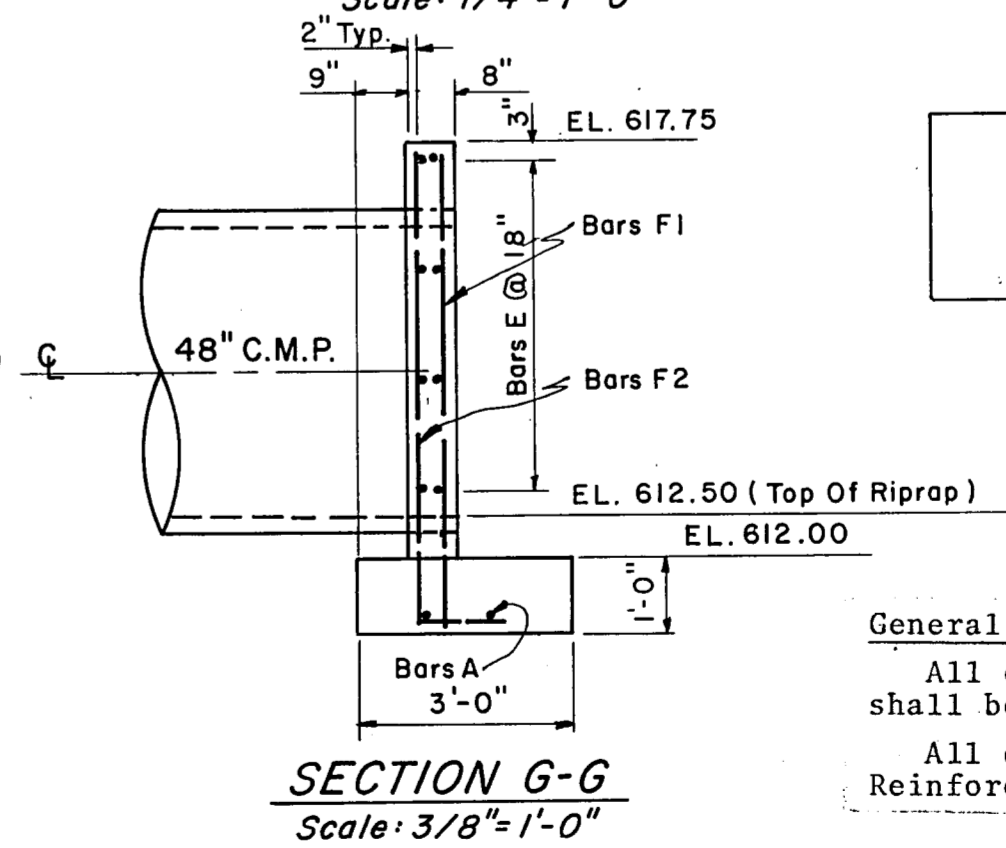


SECTION G-G
Scale: 3/8" = 1'-0"

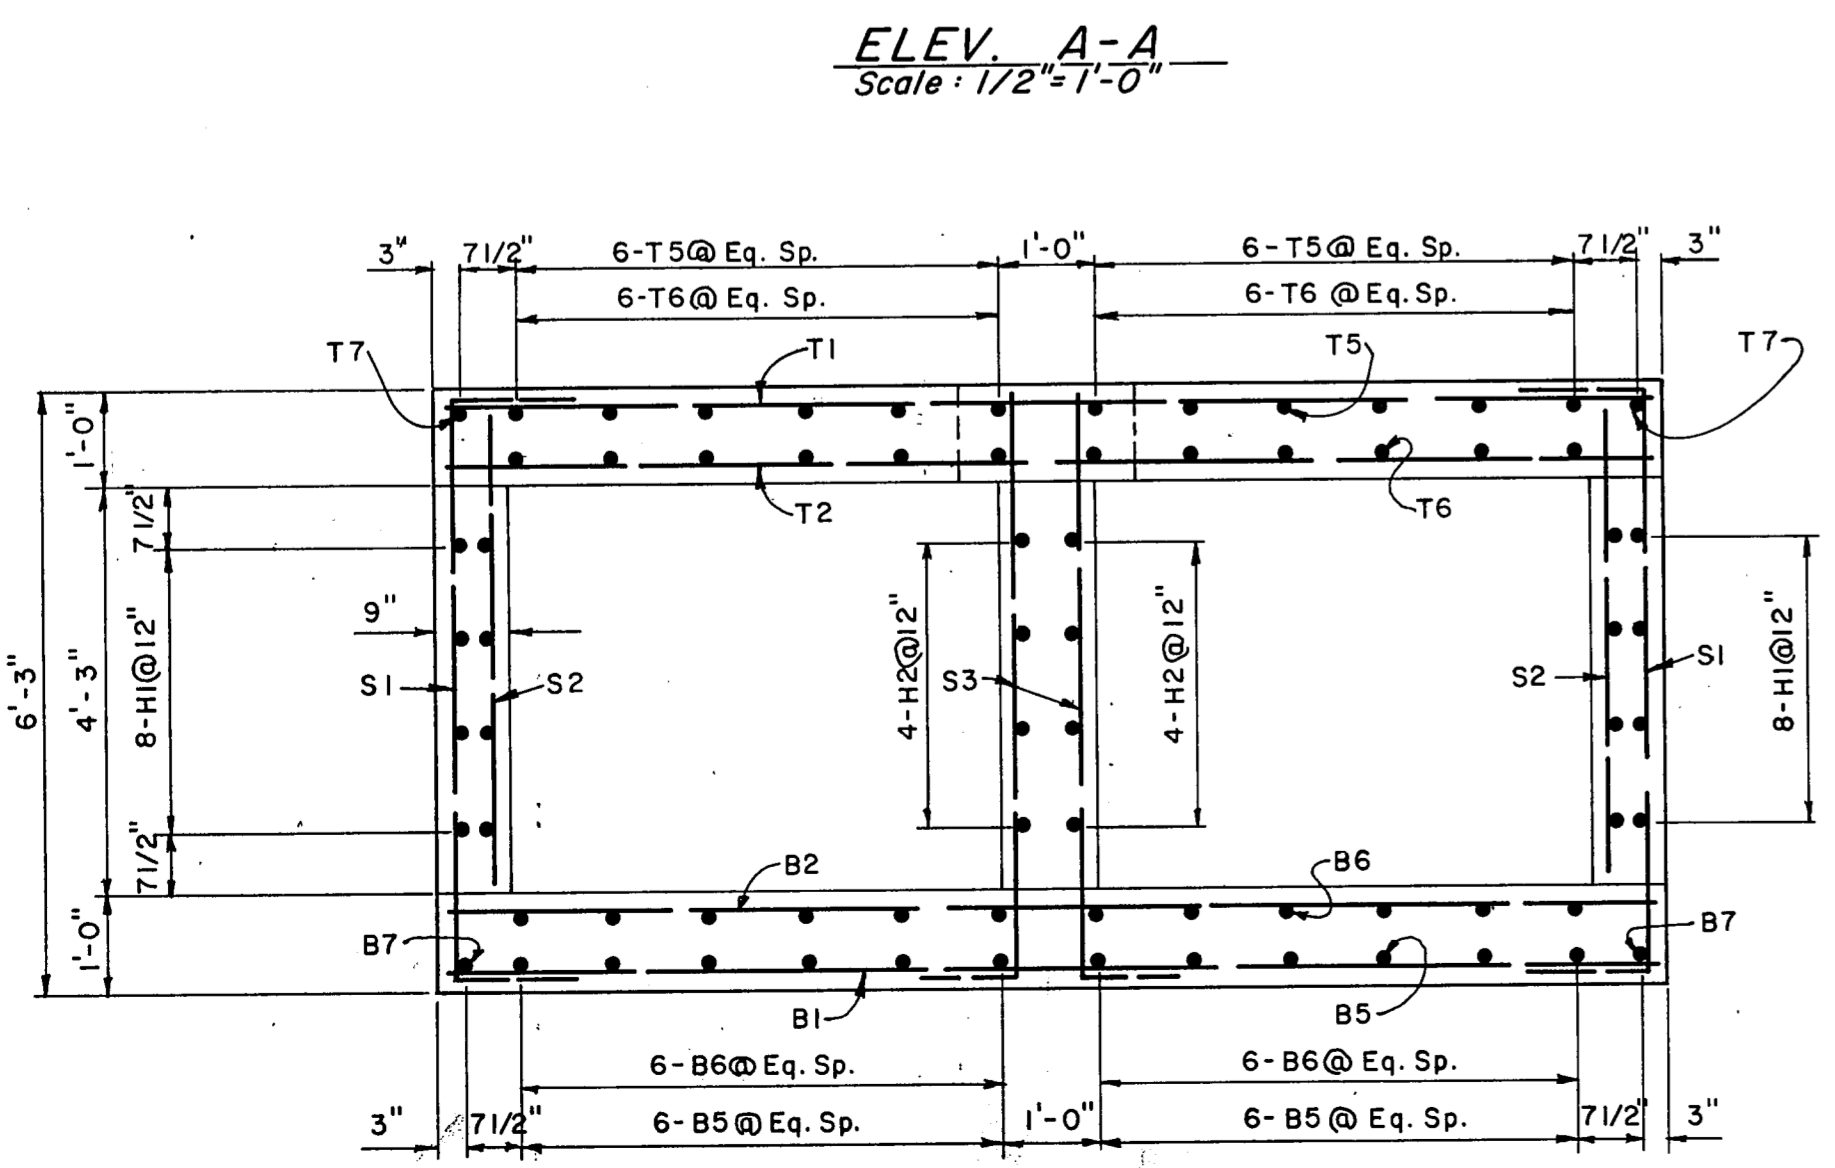


SECTION C-C
Scale: 1/2" = 1'-0"

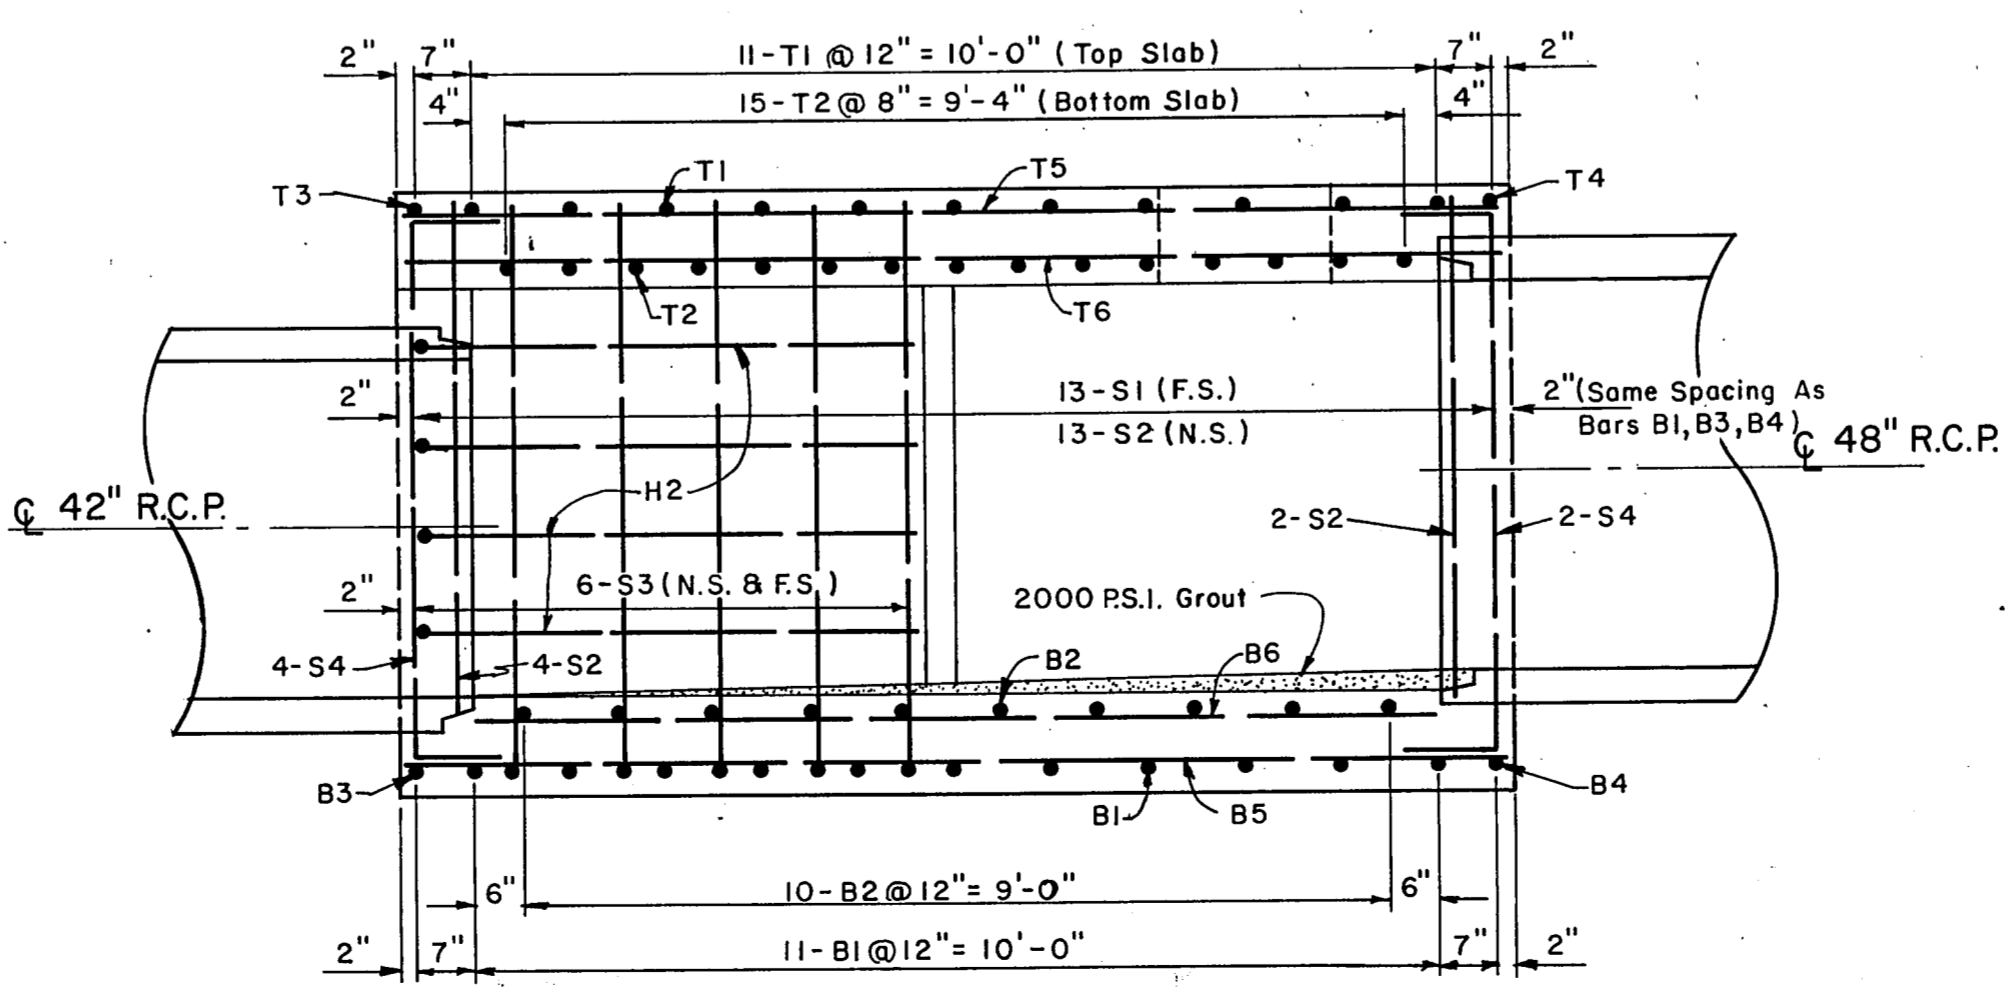

SECTION D-D
Scale: 1/2" = 1'-0"

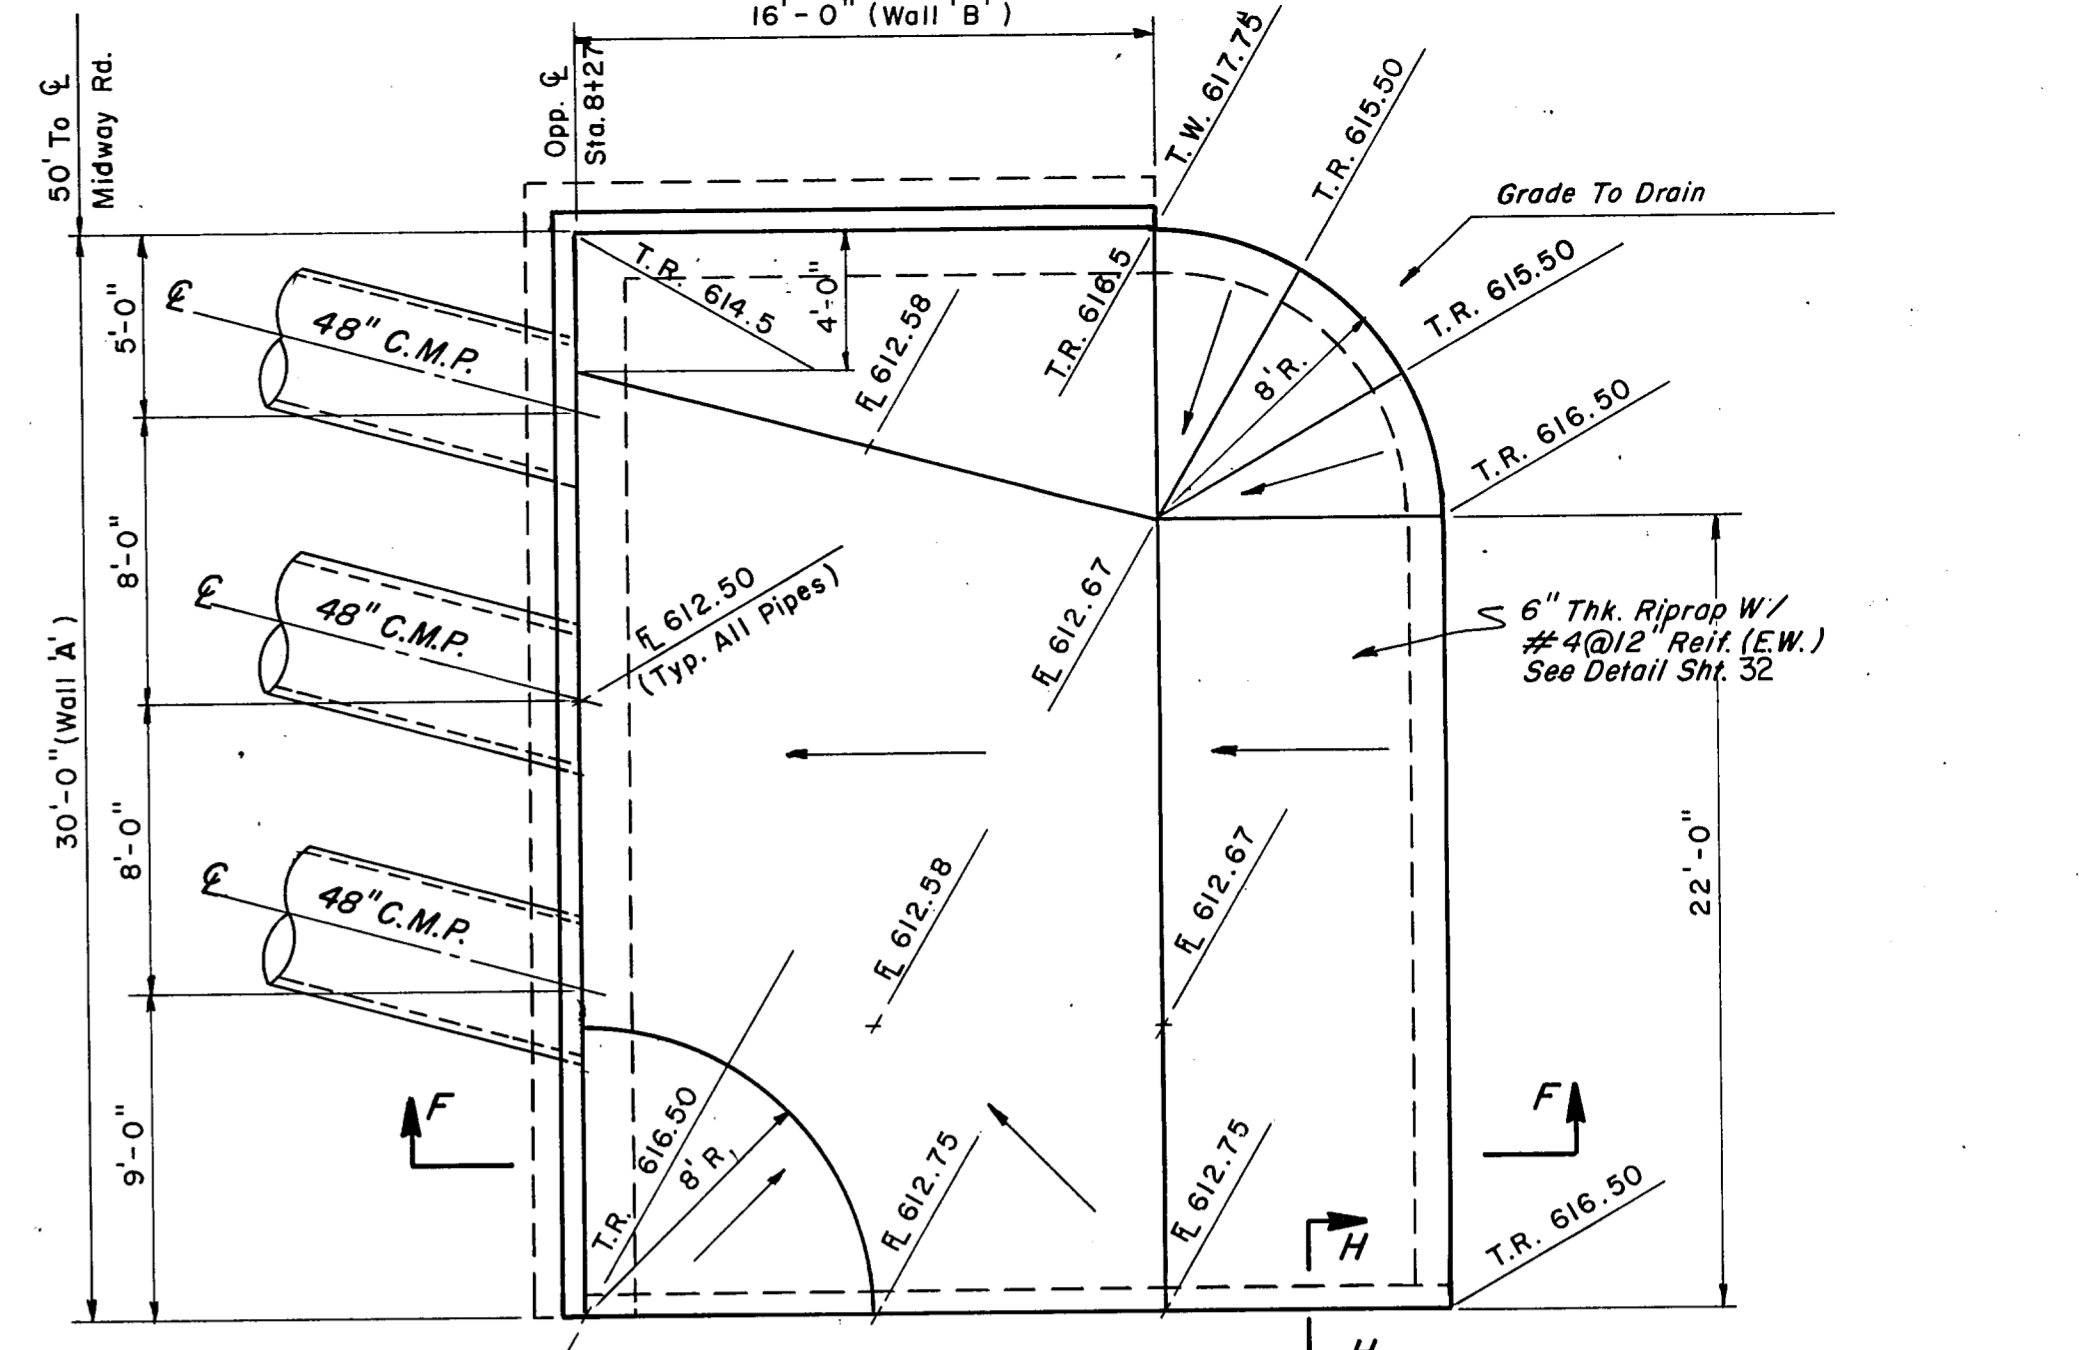

RIPRAP PLAN
Scale: 3/16" = 1'-0"

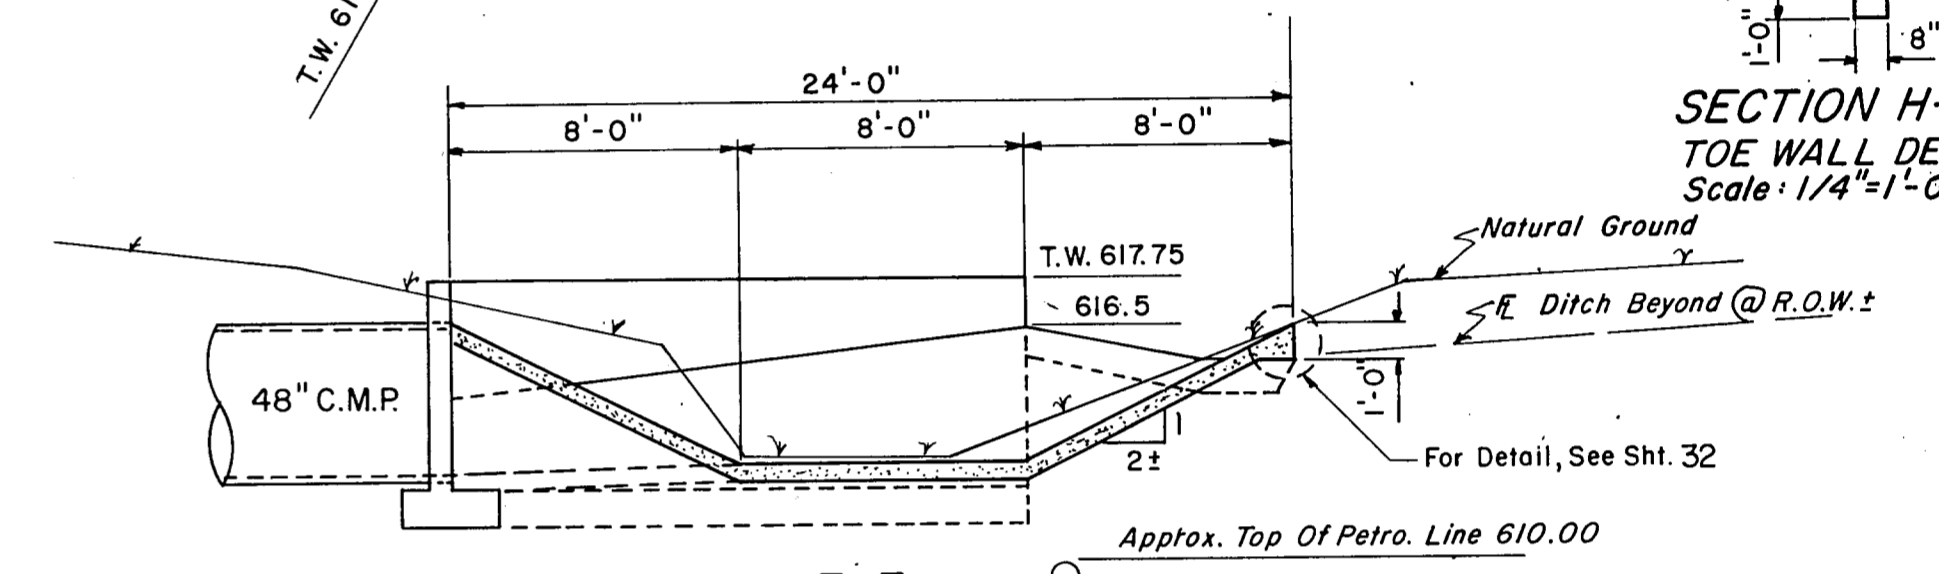

SECTION F-F
Scale: 3/16" = 1'-0"

SECTION H-H TOE WALL DET.
Scale: 1/4" = 1'-0"



CITY OF ADDISON
 DALLAS COUNTY, TEXAS
MIDWAY ROAD

JUNCTION BOX DETAIL


GINN, INC.
 Consulting Engineers - Dallas, Texas

Designed - A.C.F. Drawn - S.M.M. Date - MARCH, 1981
 Approved - H.W.G. Checked - A.G.F. Scale - As Shown Sheet 25 of

B.M. 3 - "□" on concrete walk @ S.E. corner of building @ 15201 Midway. (Elev. 618.14)

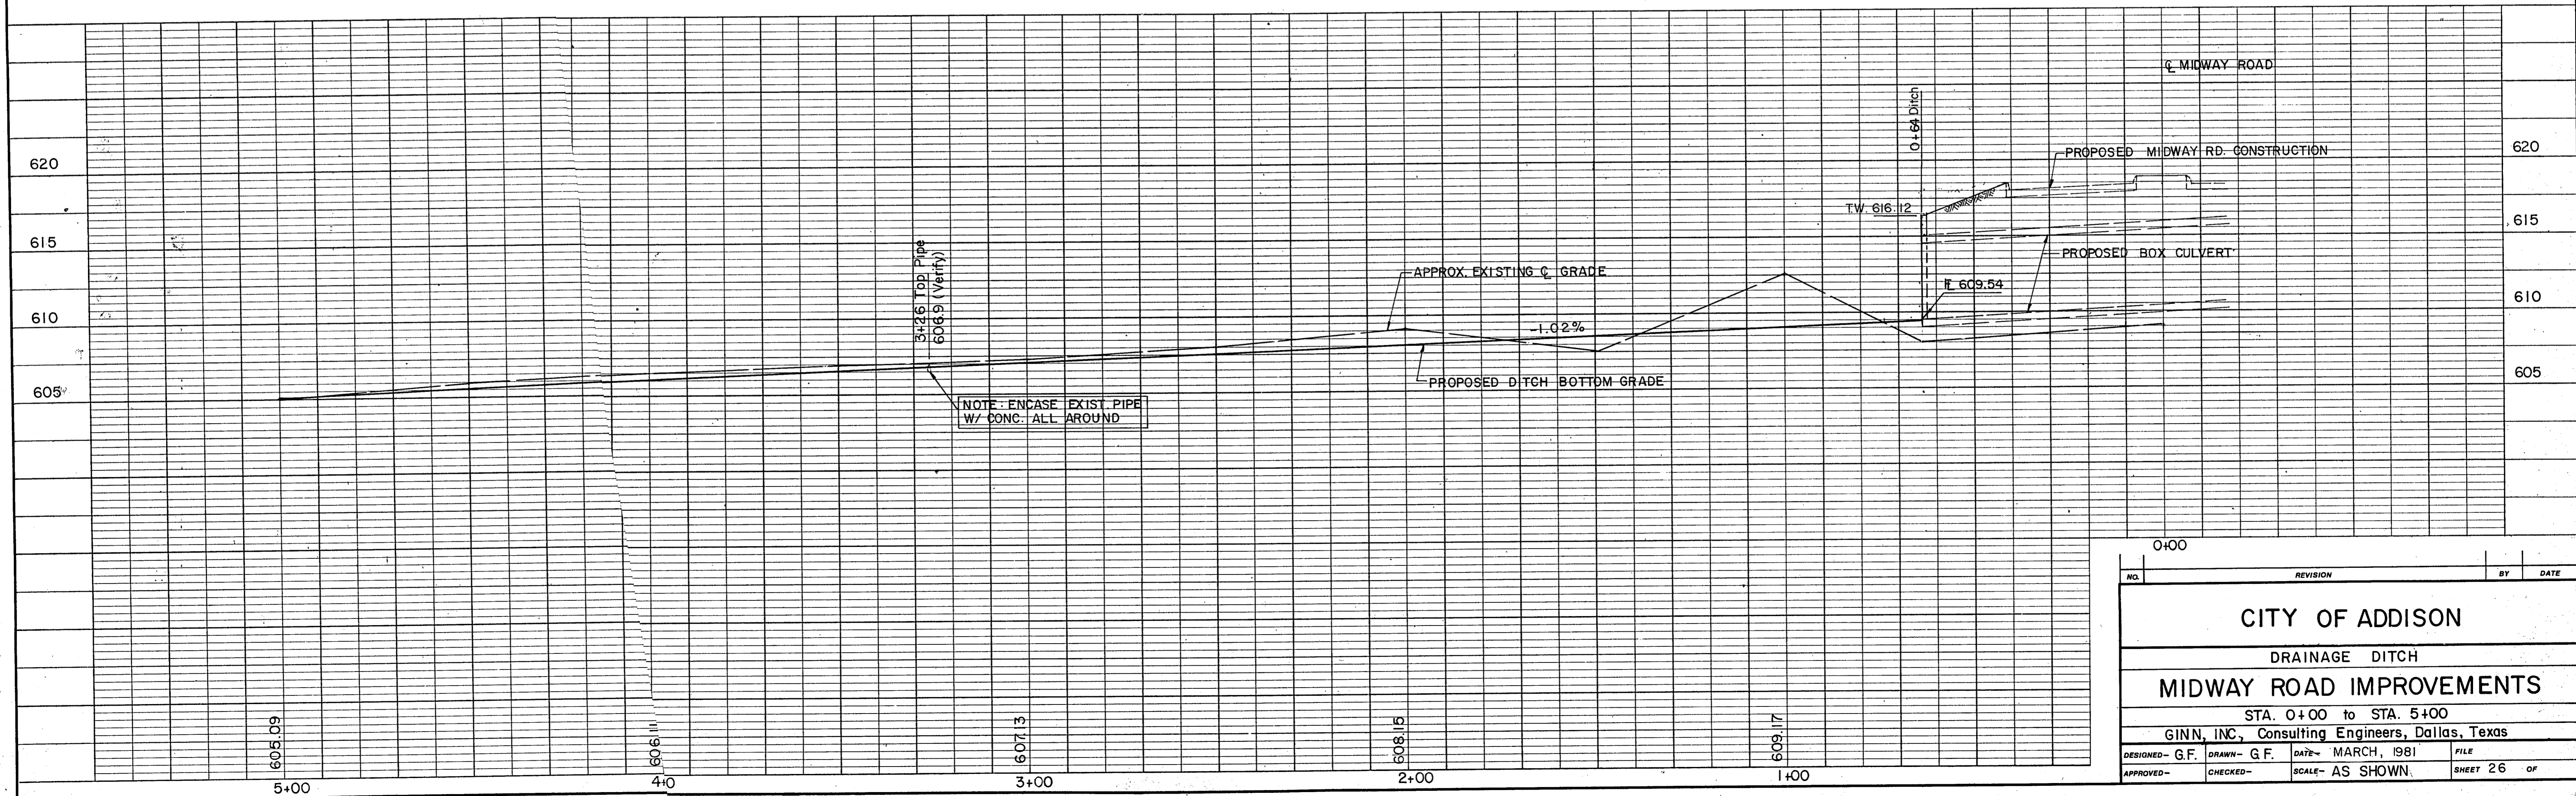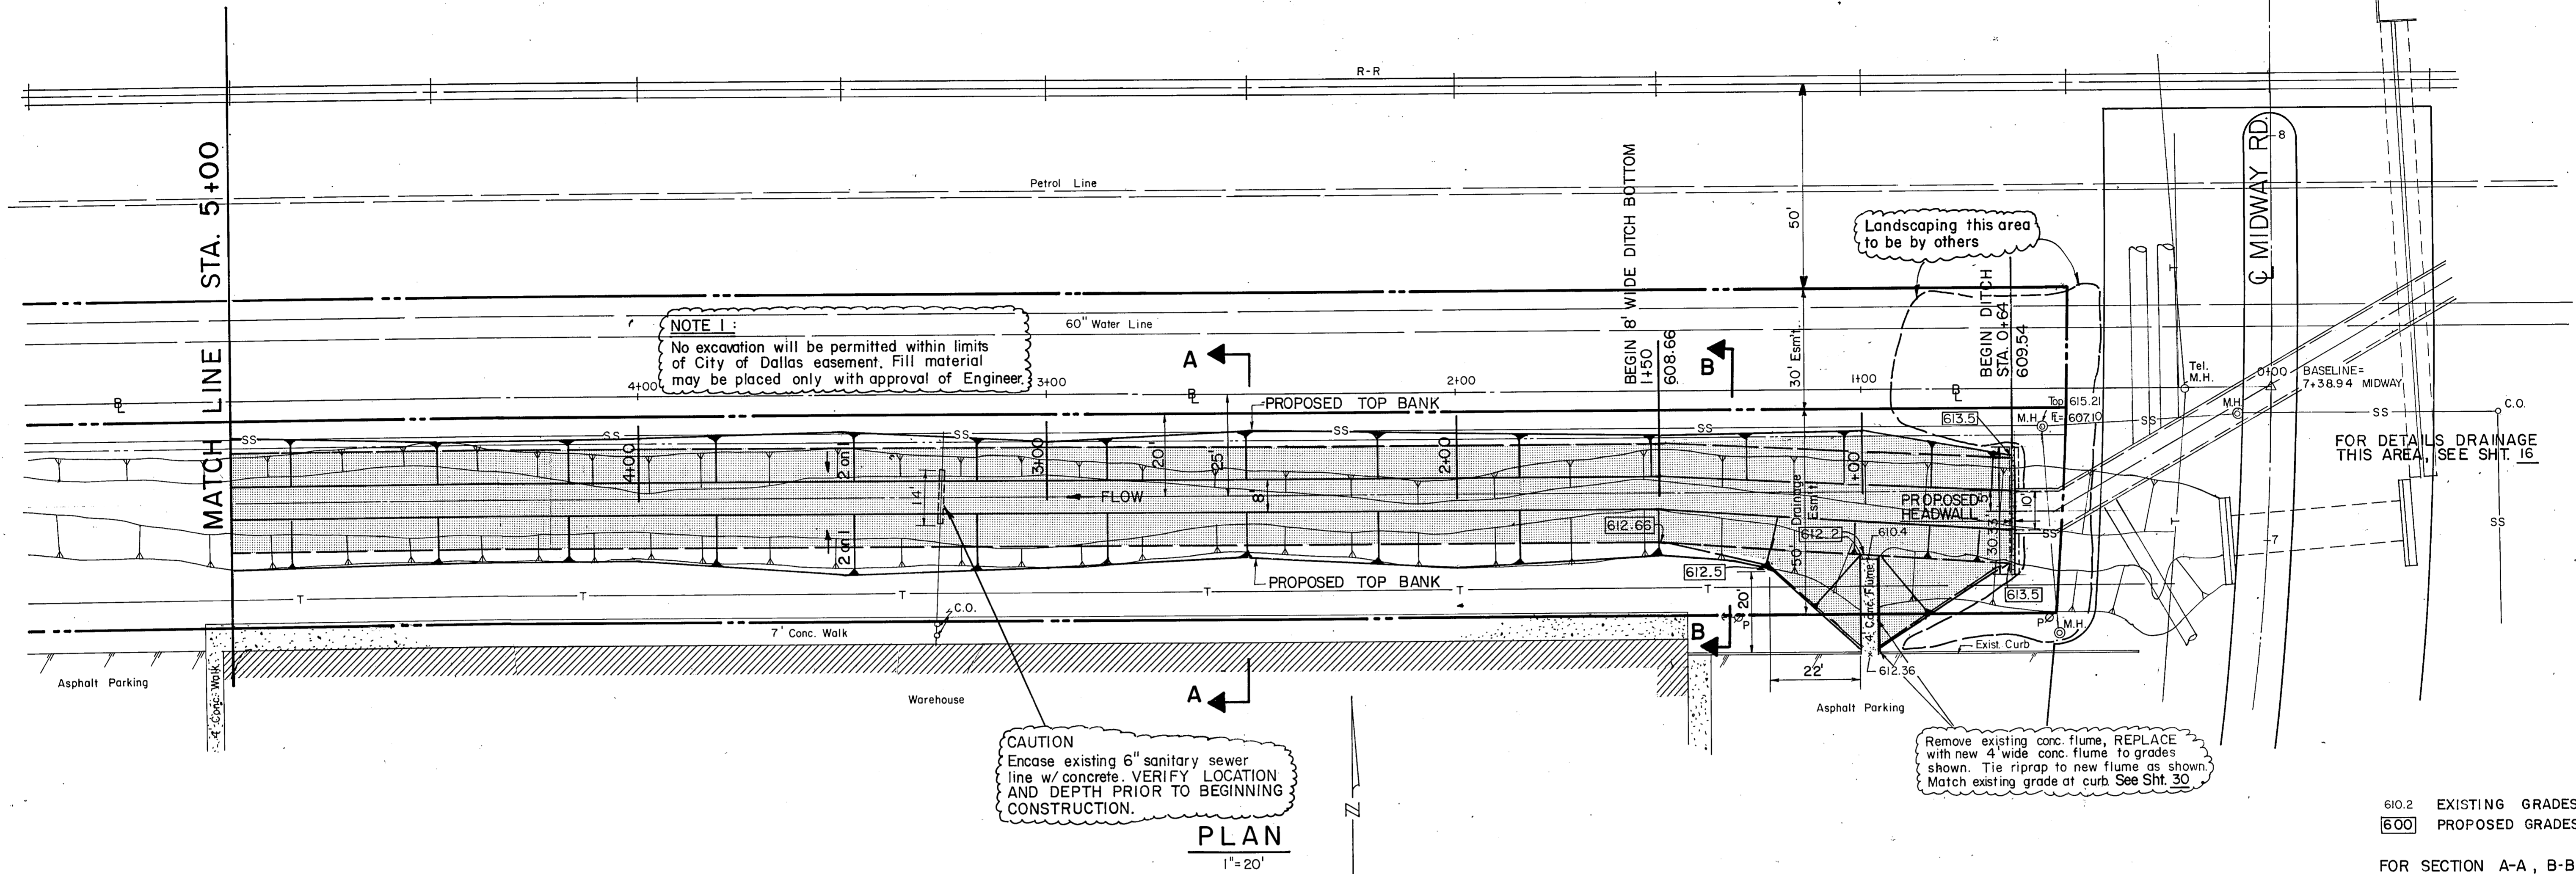


NO.	REVISION	BY	DATE
CITY OF ADDISON			
DRAINAGE DITCH			
MIDWAY ROAD IMPROVEMENTS			
STA. 0+00 to STA. 5+00			
GINN, INC., Consulting Engineers, Dallas, Texas			
DESIGNED - G.F.	DRAWN - G.F.	DATE - MARCH, 1981	FILE
APPROVED -	CHECKED -	SCALE - AS SHOWN	SHEET 26 OF

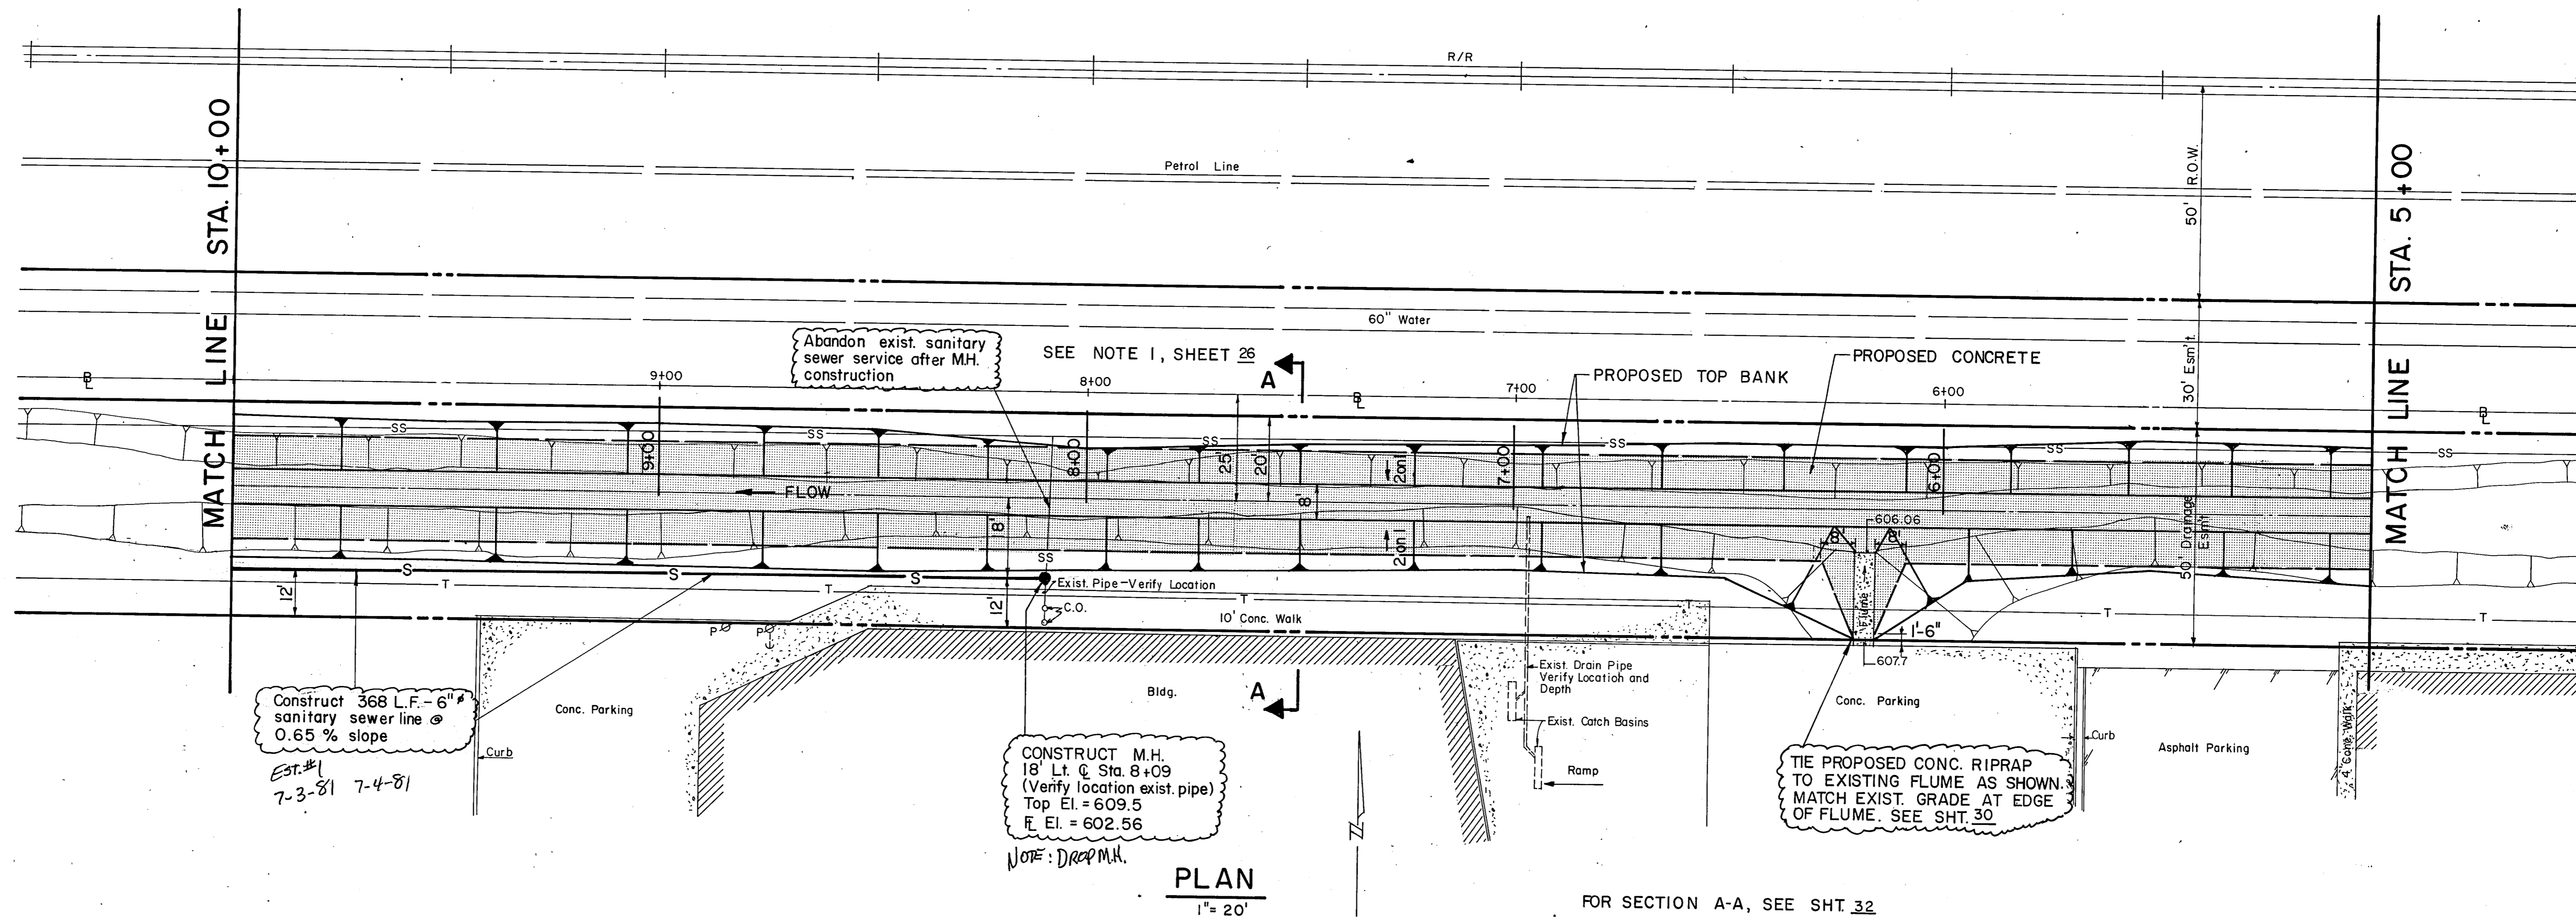


PLAN
1" = 20'

FOR SECTION A-A, SEE SHT. 32

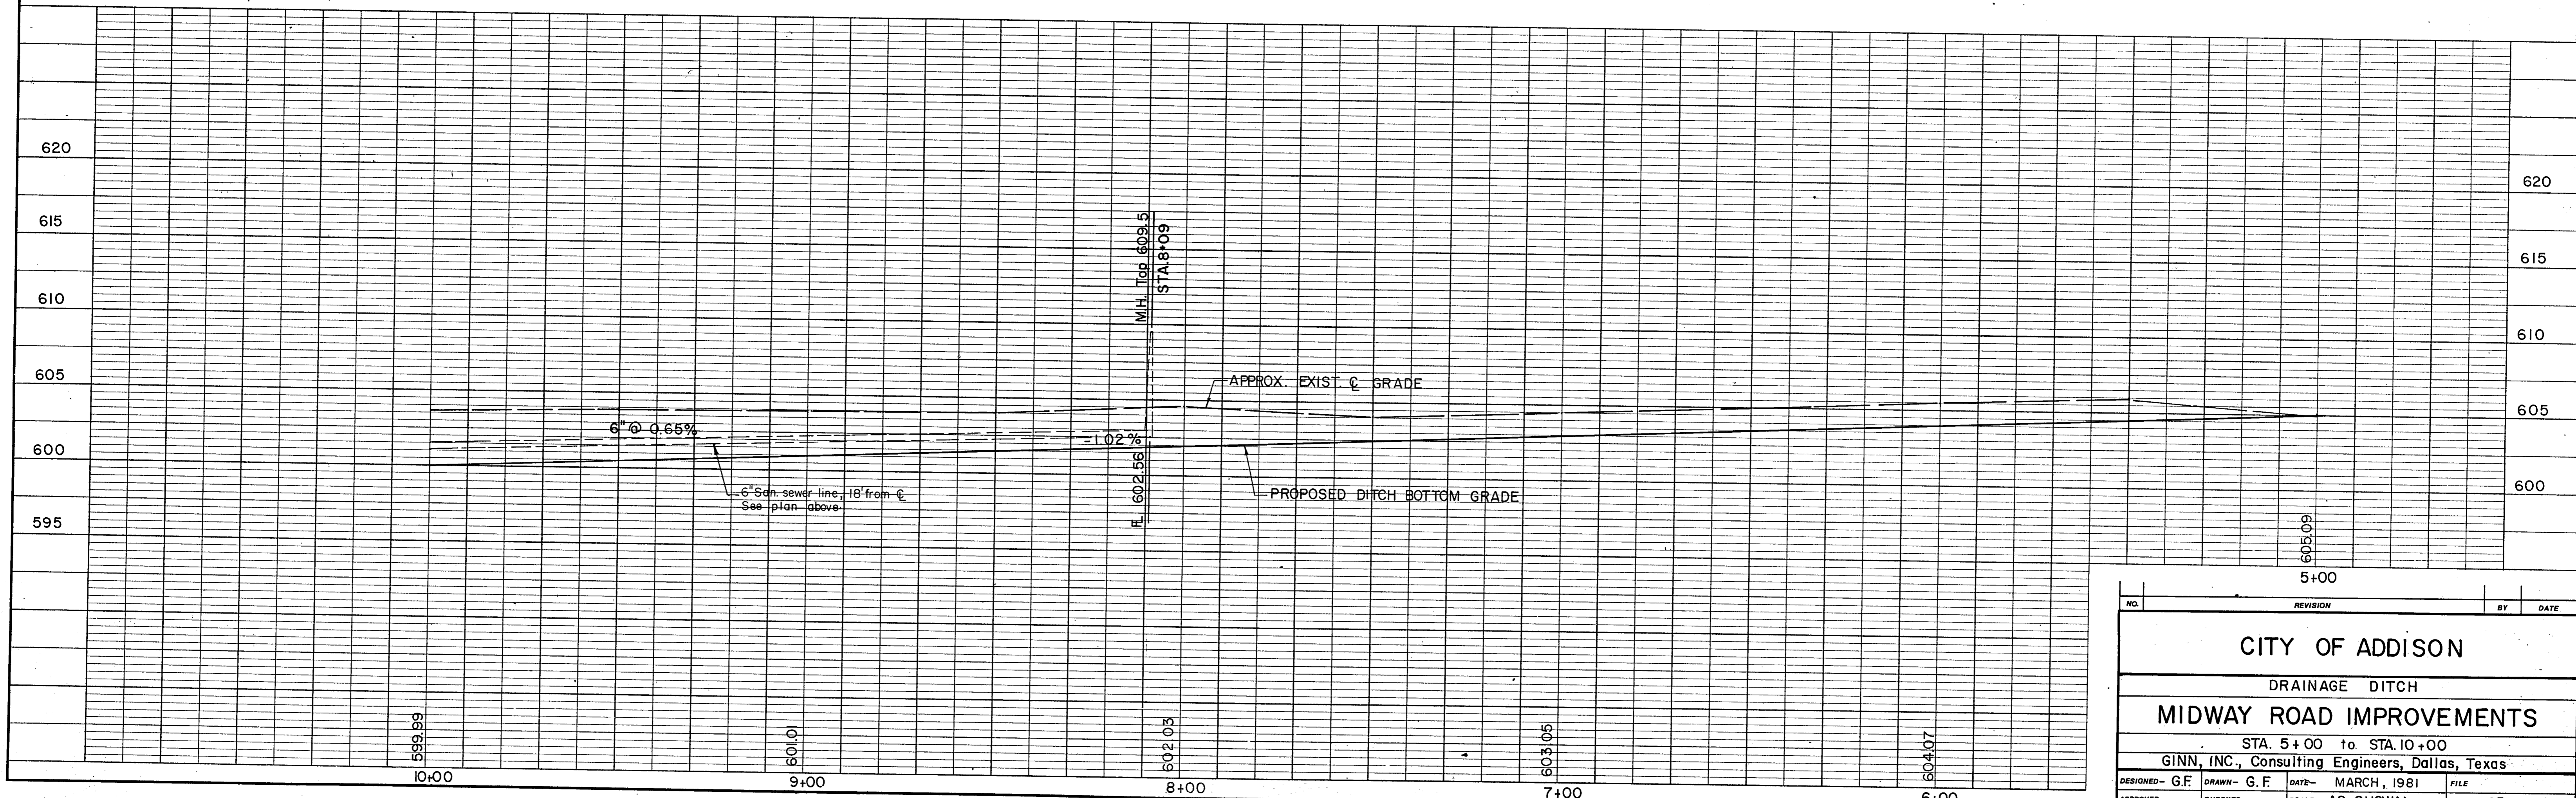


NO.	REVISION	BY	DATE
CITY OF ADDISON DRAINAGE DITCH MIDWAY ROAD IMPROVEMENTS STA. 5+00 to STA. 10+00 GINN, INC., Consulting Engineers, Dallas, Texas			
DESIGNED - G.F.	DRAWN - G.F.	DATE - MARCH, 1981	FILE
APPROVED -	CHECKED -	SCALE - AS SHOWN	SHEET 27 OF

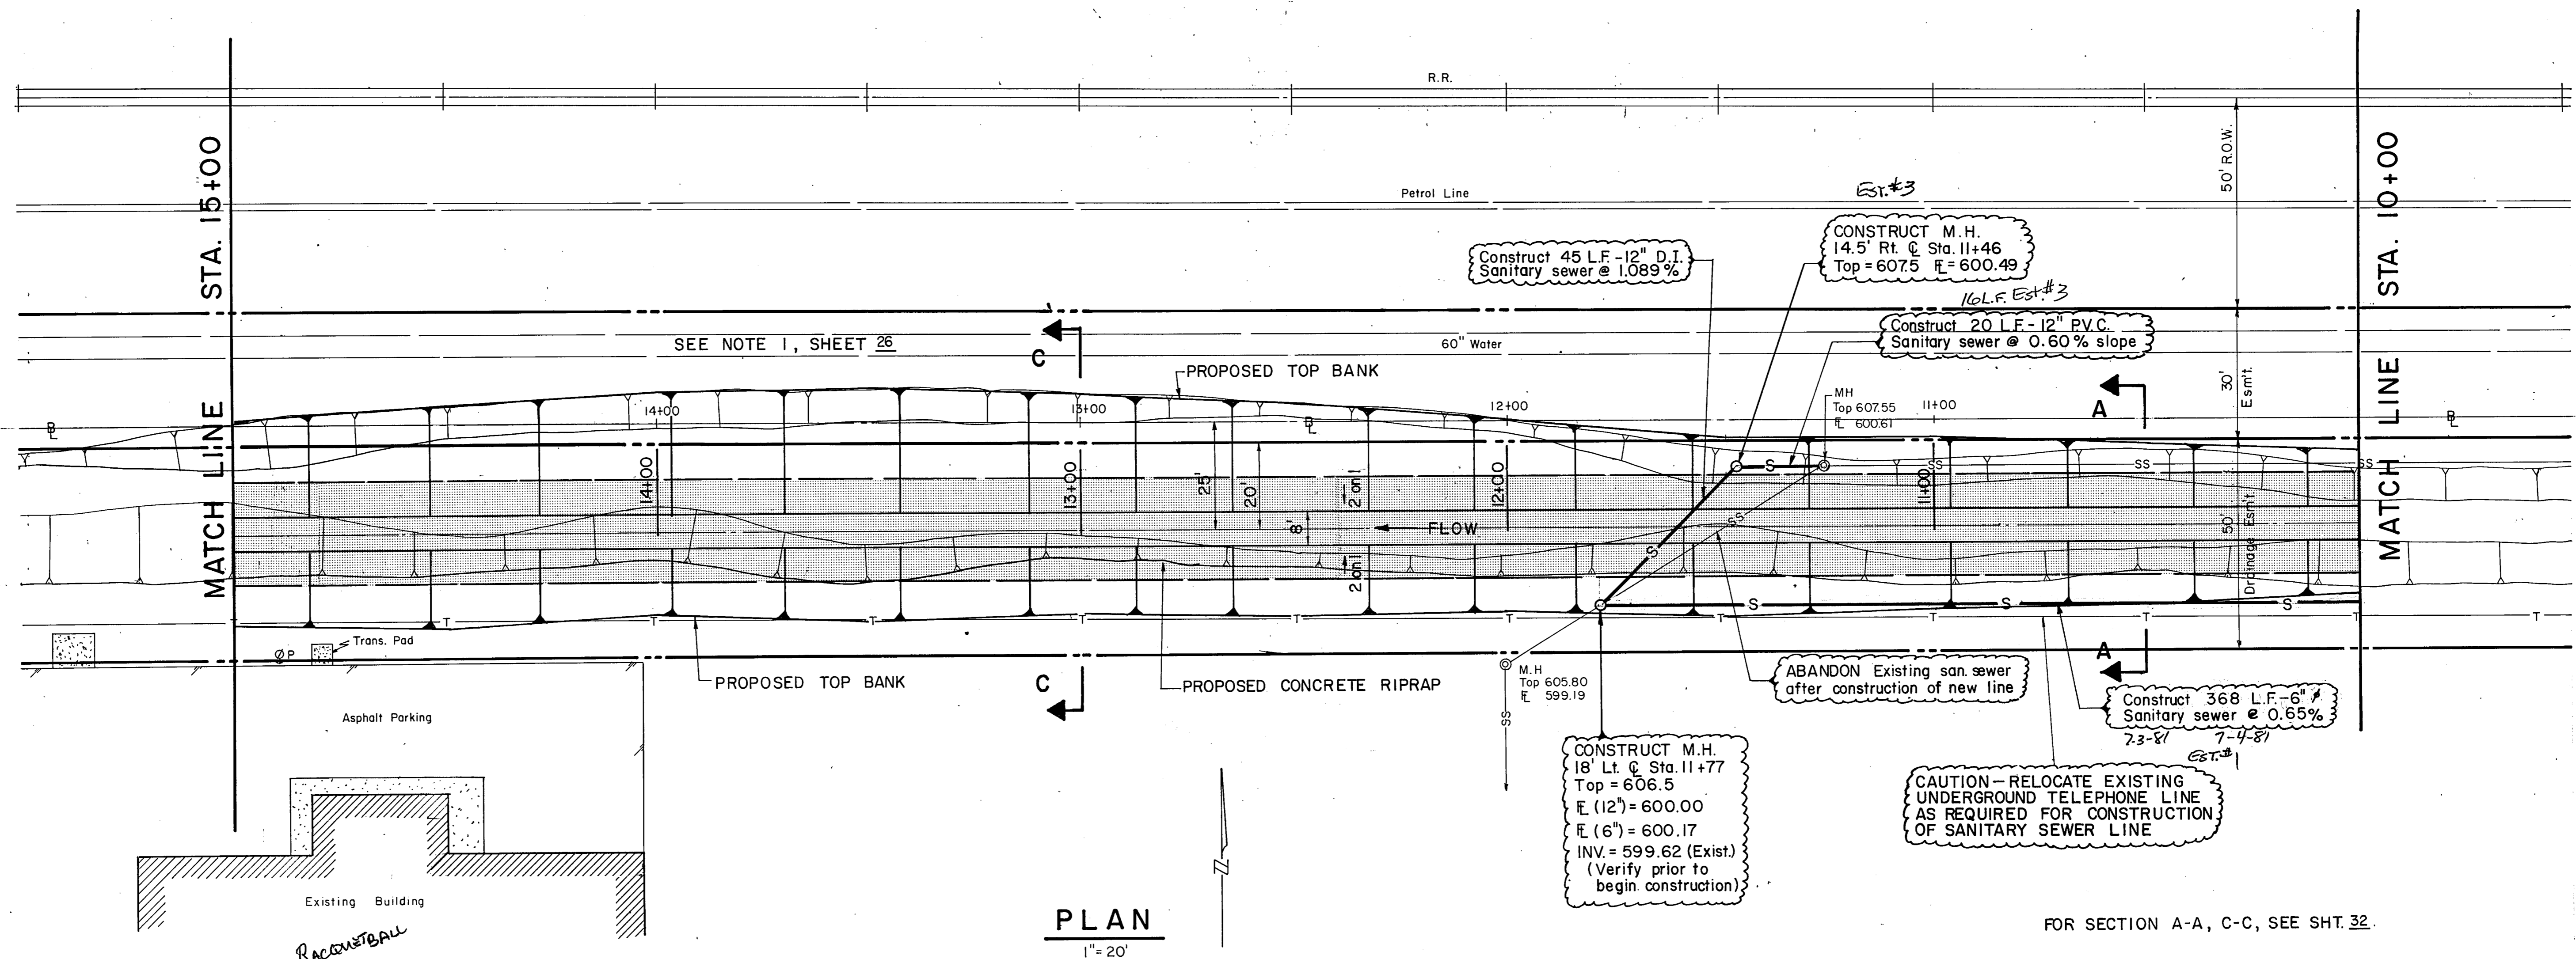


PLAN
1" = 20'

FOR SECTION A-A, C-C, SEE SHT. 32.

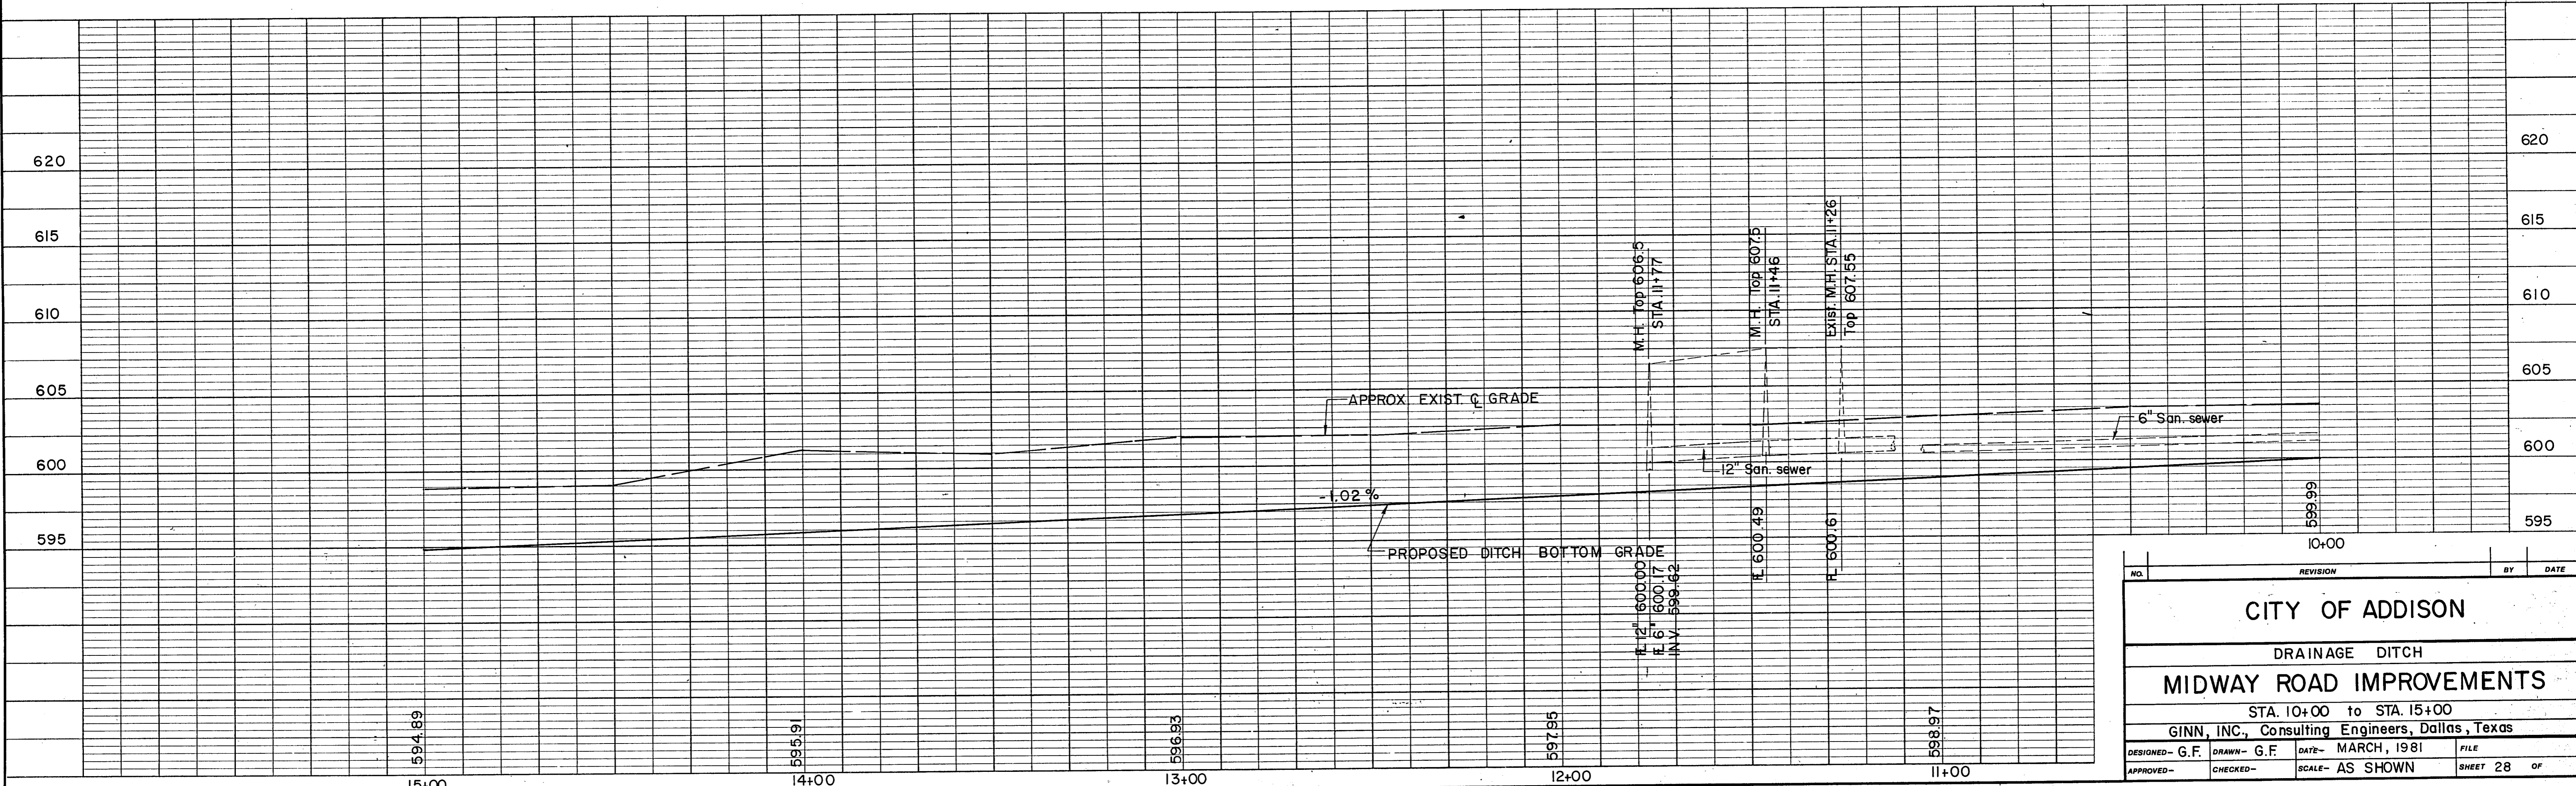


NO.	REVISION	BY	DATE
CITY OF ADDISON			
DRAINAGE DITCH			
MIDWAY ROAD IMPROVEMENTS			
STA. 10+00 to STA. 15+00			
GINN, INC., Consulting Engineers, Dallas, Texas			
DESIGNED - G.F.	DRAWN - G.F.	DATE - MARCH, 1981	FILE
APPROVED -	CHECKED -	SCALE - AS SHOWN	SHEET 28 OF

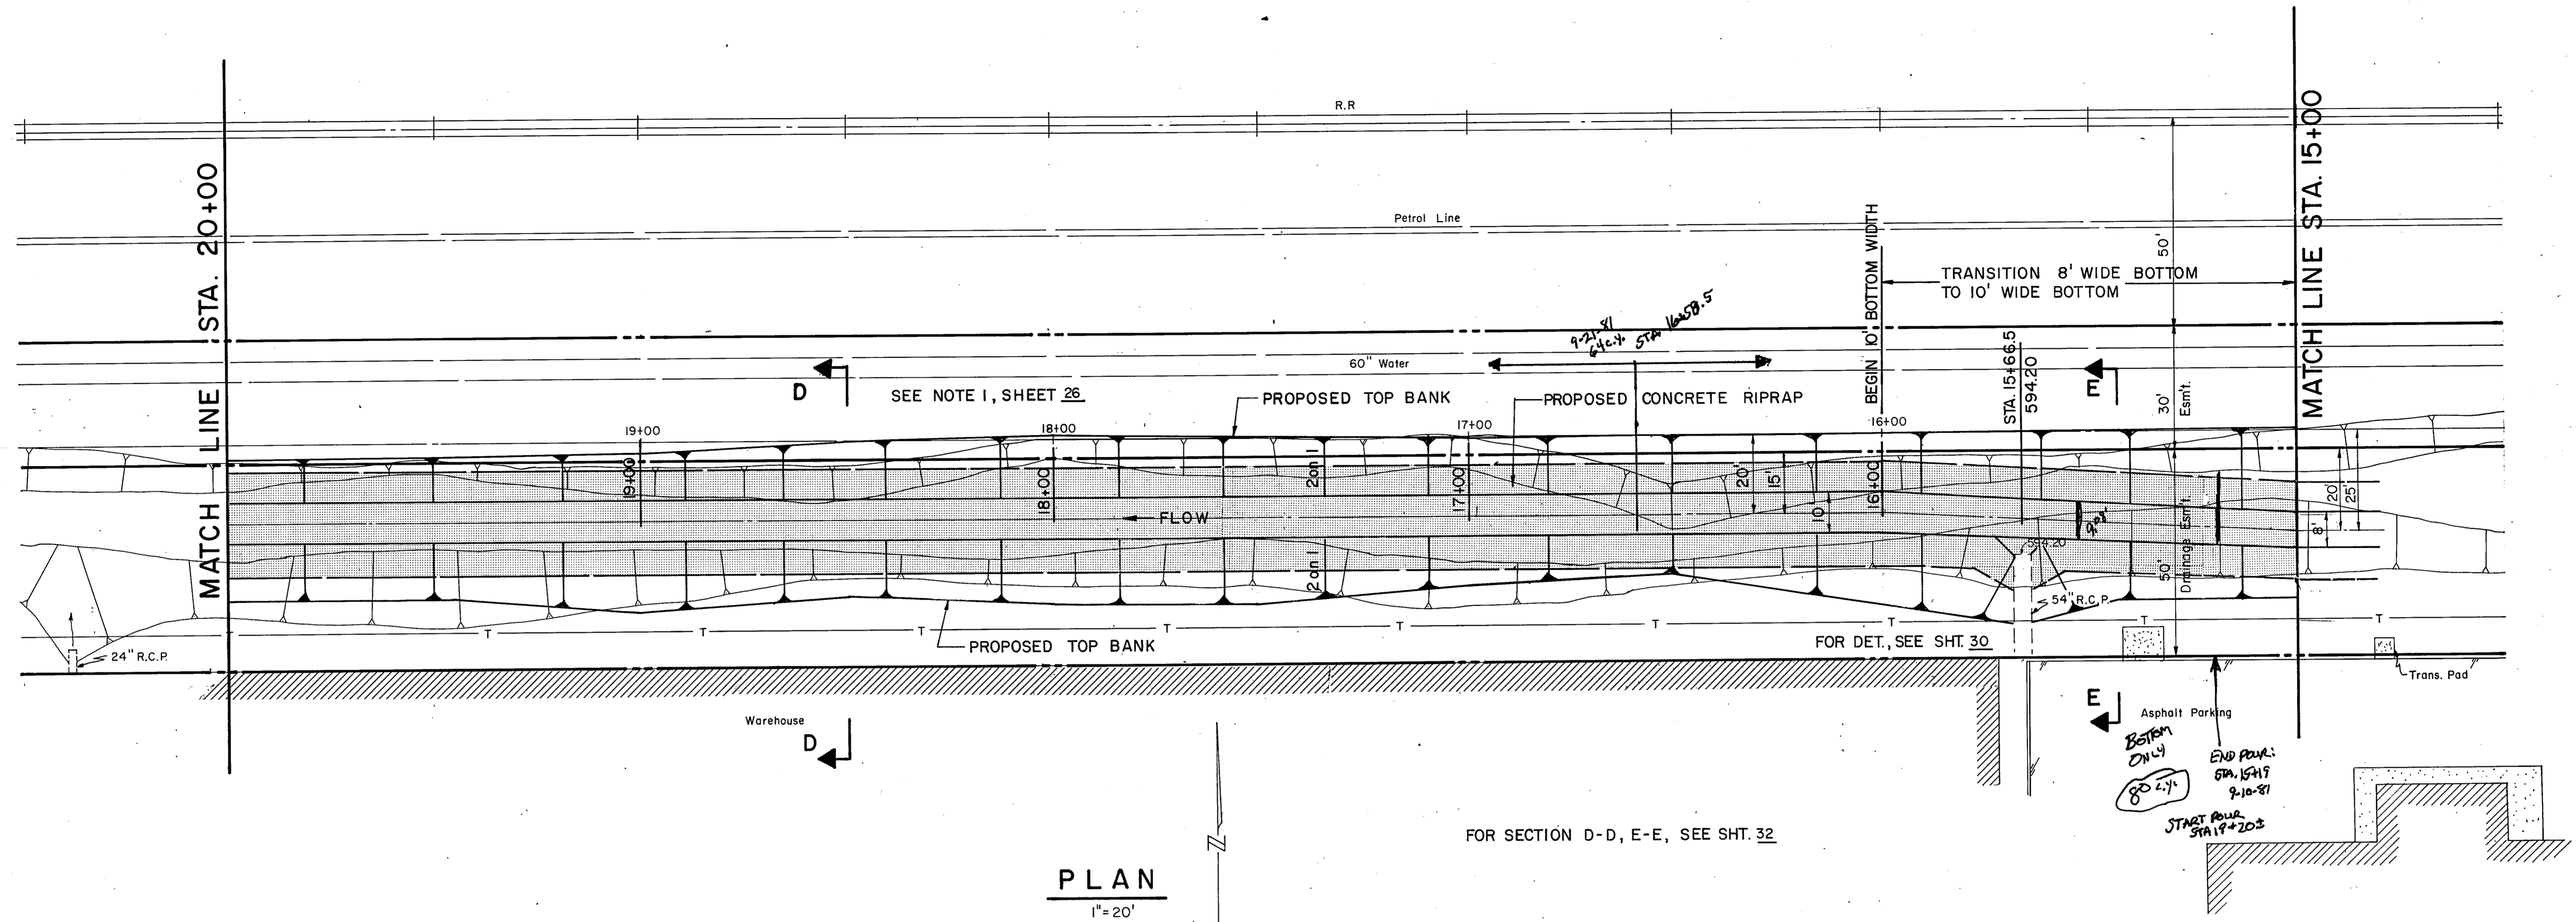


PLAN
1" = 20'

FOR SECTION D-D, E-E, SEE SHT. 32

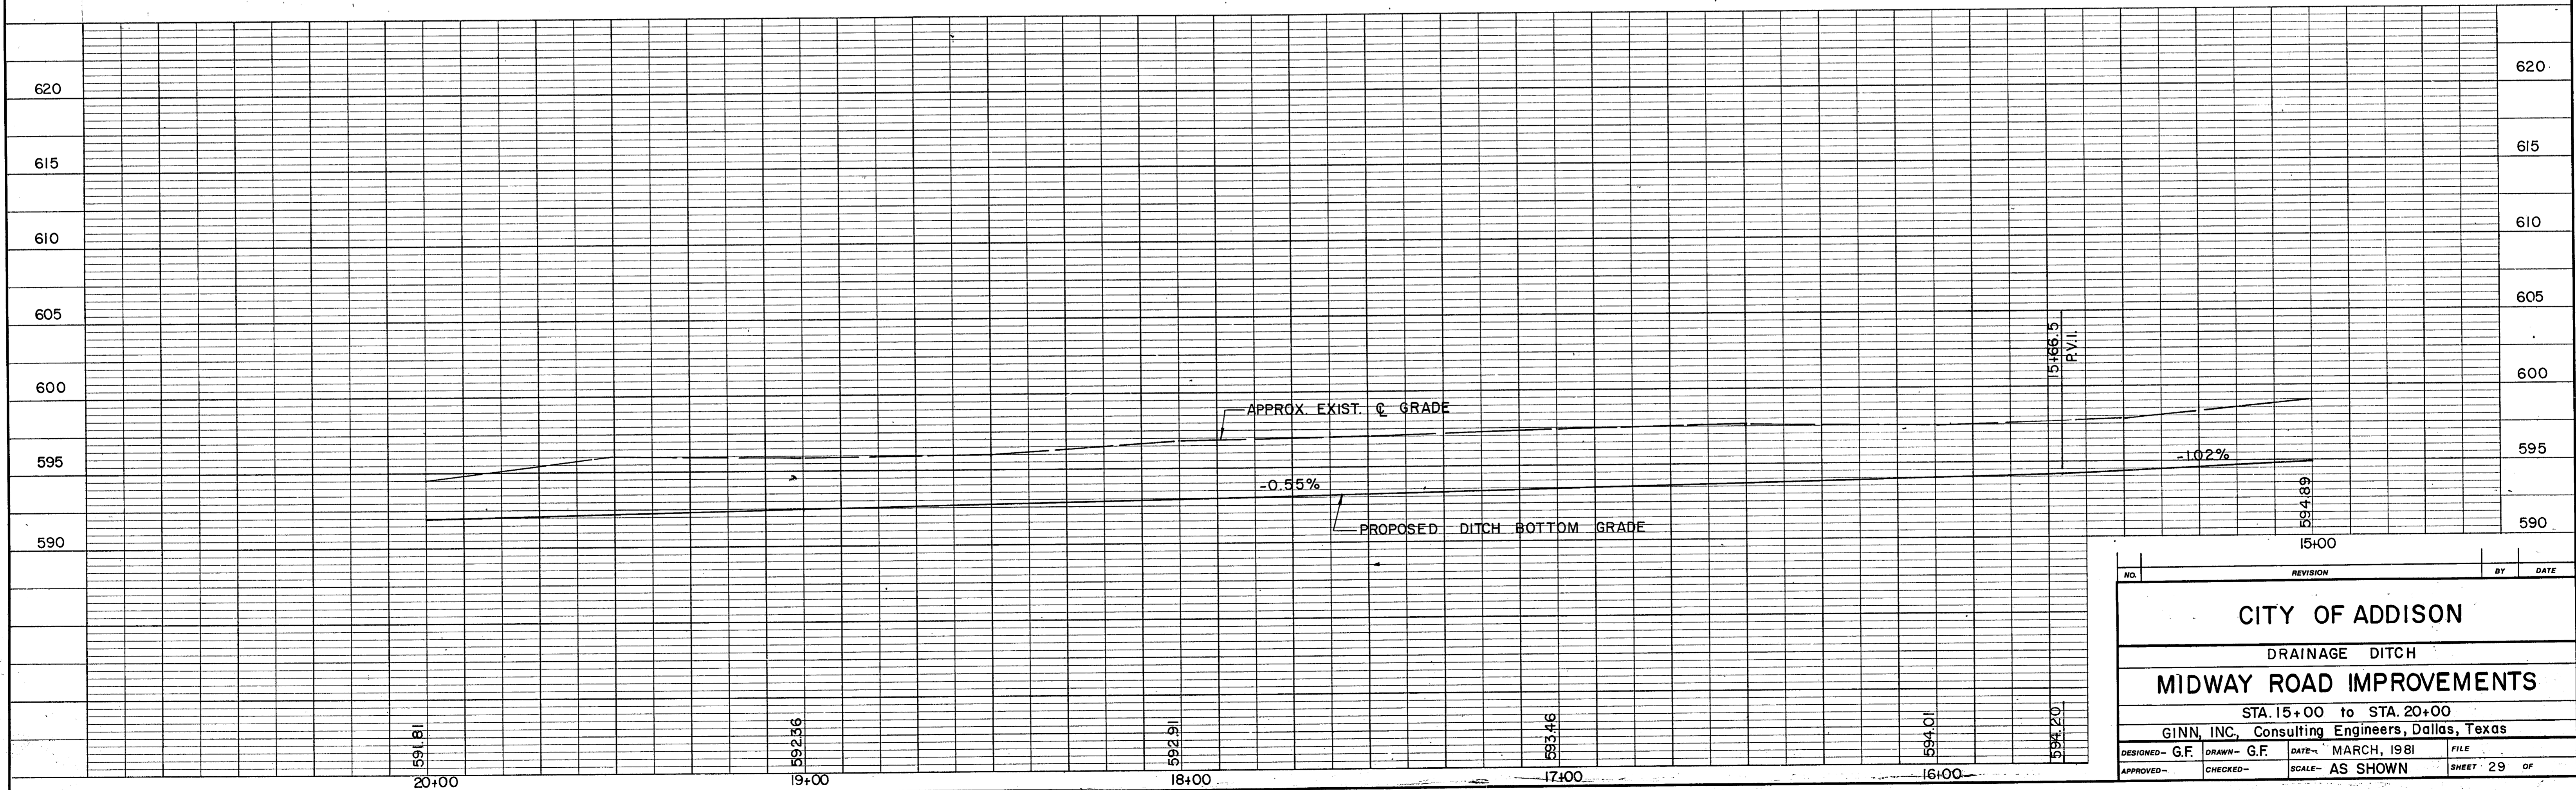


NO.	REVISION	BY	DATE
CITY OF ADDISON			
DRAINAGE DITCH			
MIDWAY ROAD IMPROVEMENTS			
STA. 15+00 to STA. 20+00			
GINN, INC., Consulting Engineers, Dallas, Texas			
DESIGNED - G.F.	DRAWN - G.F.	DATE - MARCH, 1981	FILE
APPROVED -	CHECKED -	SCALE - AS SHOWN	SHEET 29 OF

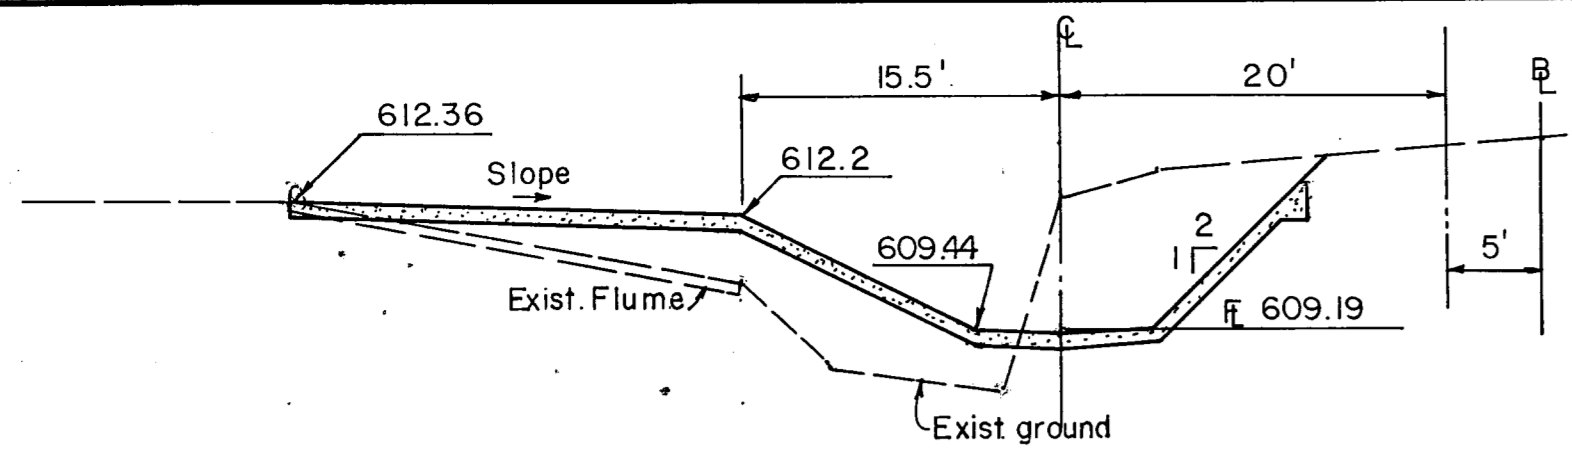


FLUME AT STA. 0+98.5

N.T.S.

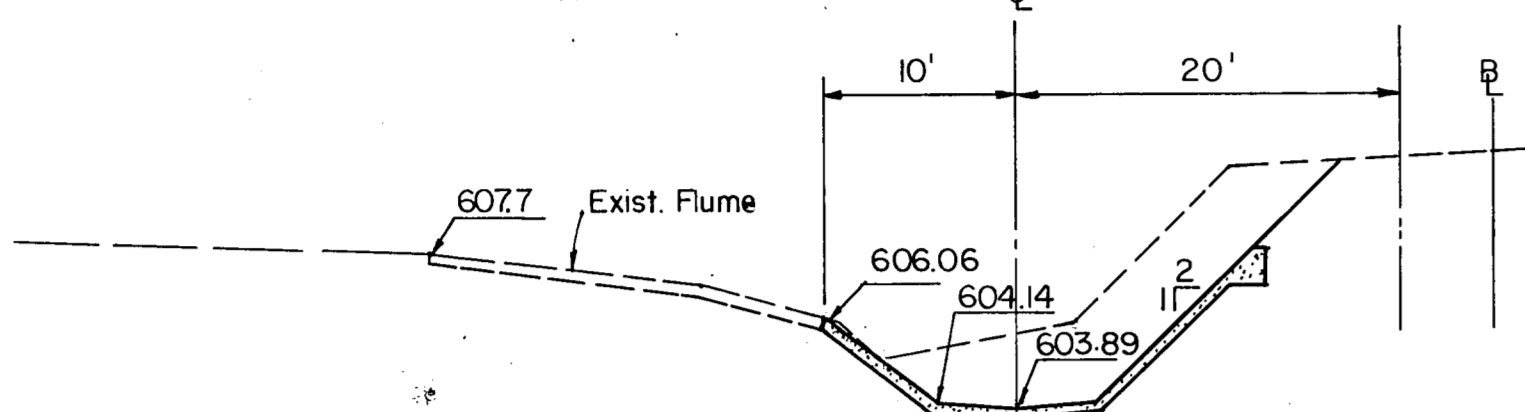


FLUME AT STA. 6+18.0

N.T.S.

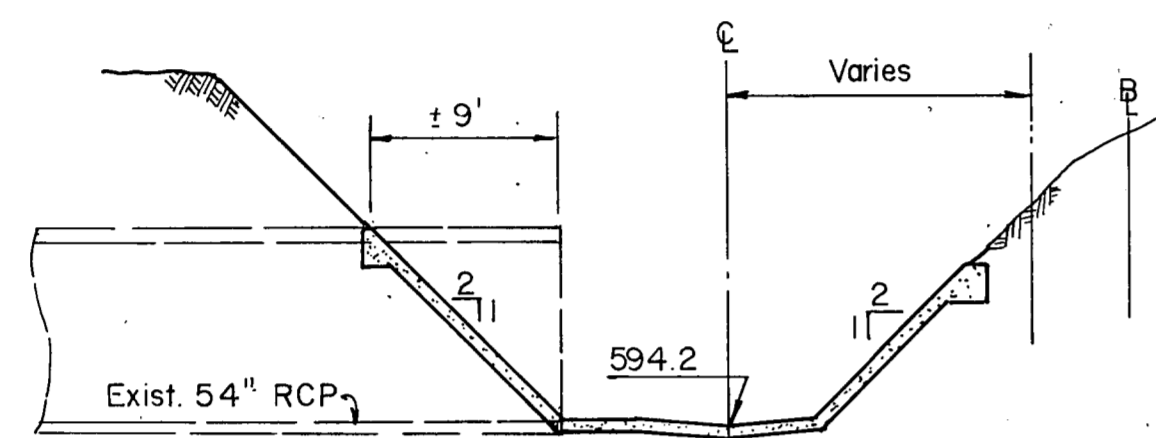


PIPE AT STA. 15+66.5

N.T.S.

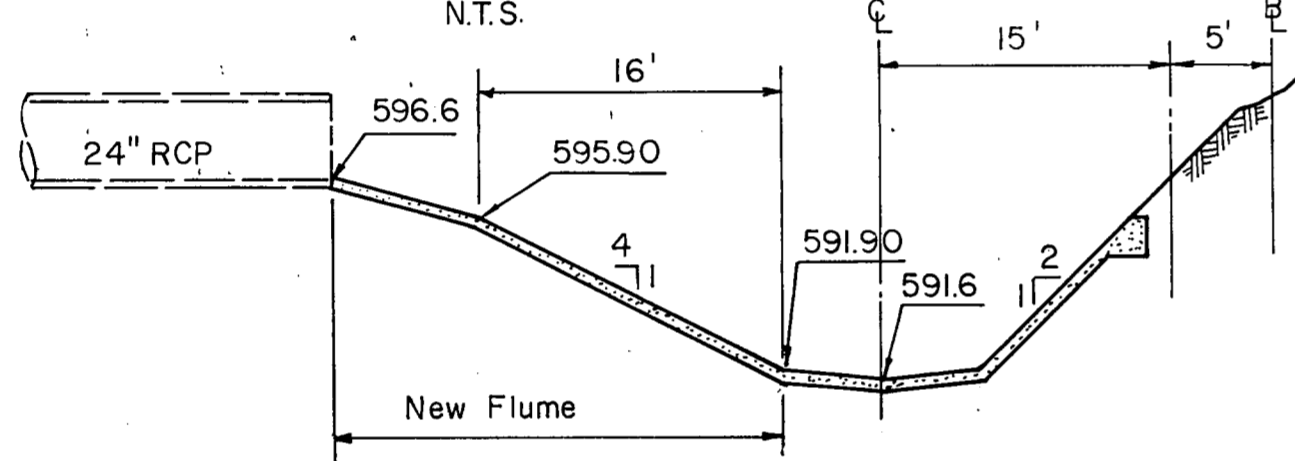

FLUME AT STA. 20+38


N.T.S.

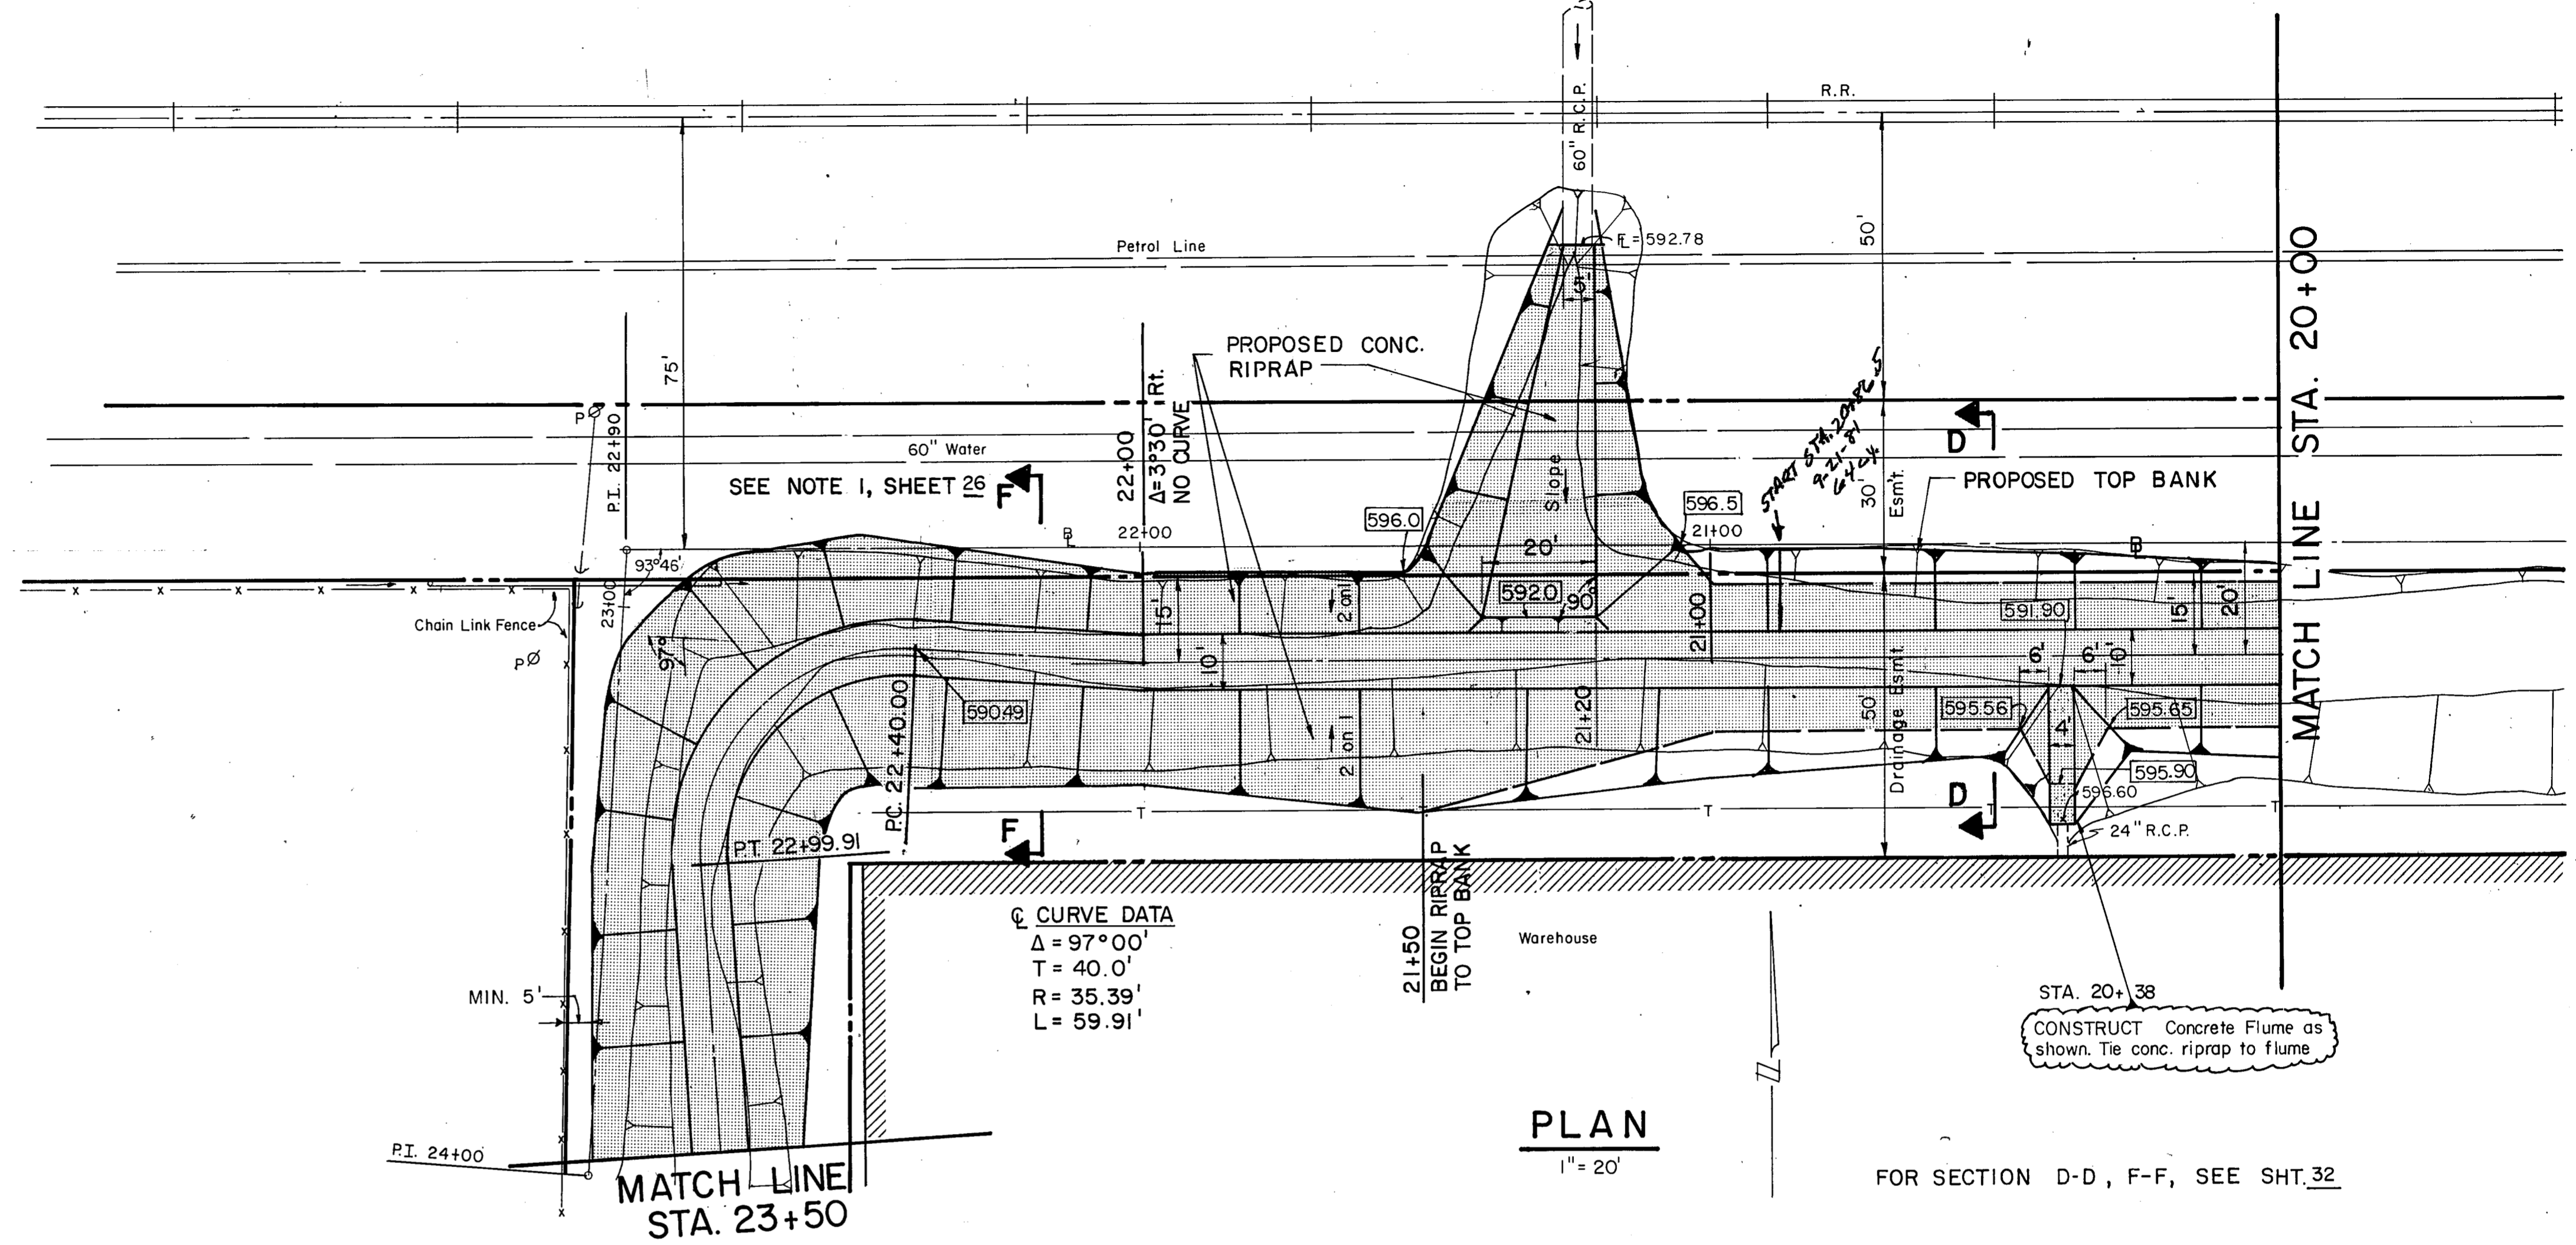

PLAN


1" = 20'

FOR SECTION D-D, F-F, SEE SHT. 32

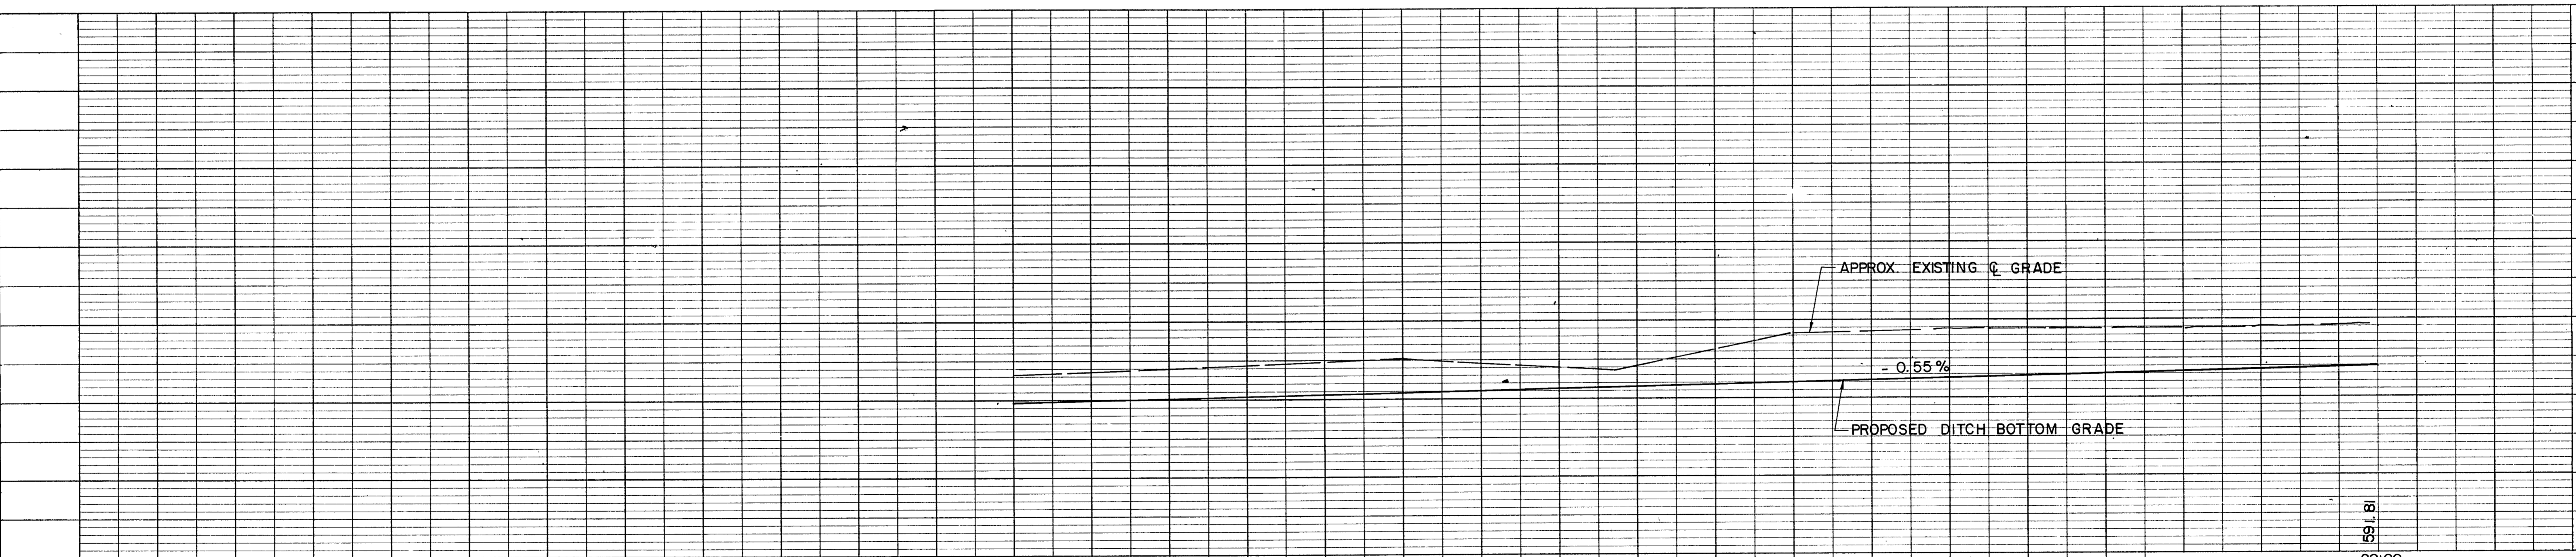


20:00


NO.	REVISION	BY	DATE
CITY OF ADDISON			
DRAINAGE DITCH			
MIDWAY ROAD IMPROVEMENTS			
STA. 20+00 to STA. 23+50			
GINN, INC., Consulting Engineers, Dallas, Texas			
DESIGNED - G.F.	DRAWN - G.F.	DATE - MARCH, 1981	FILE
APPROVED -	CHECKED -	SCALE - AS SHOWN	SHEET 30 OF

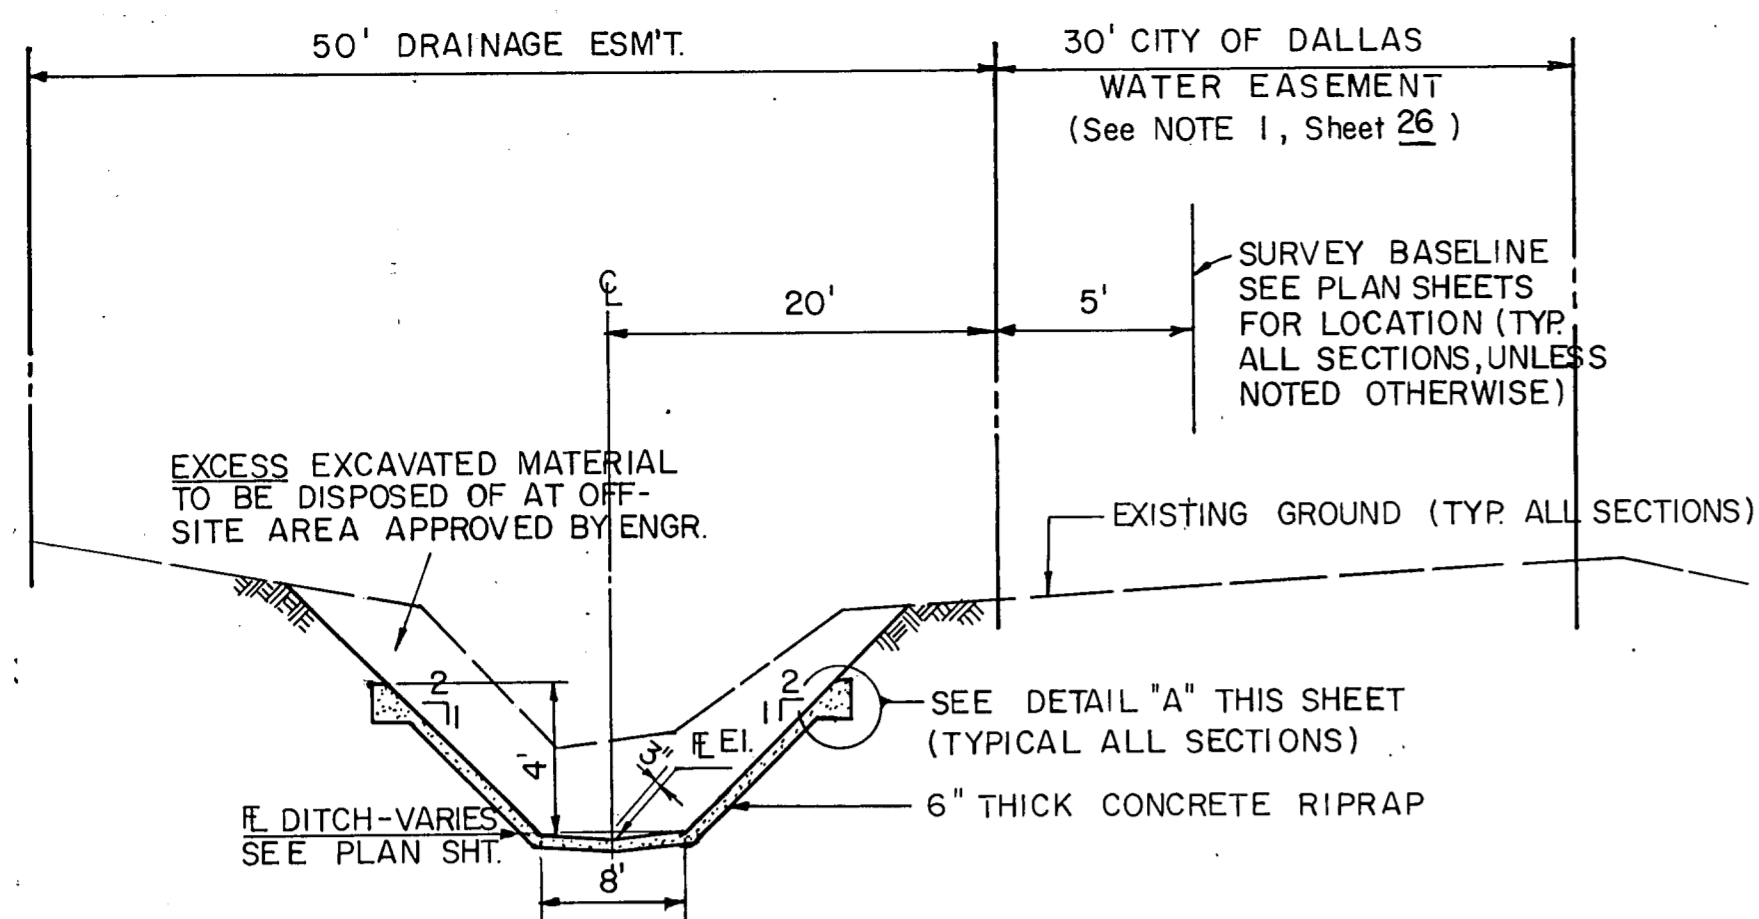


SECTION A-A TYPICAL STA. 1+50 to 11+50

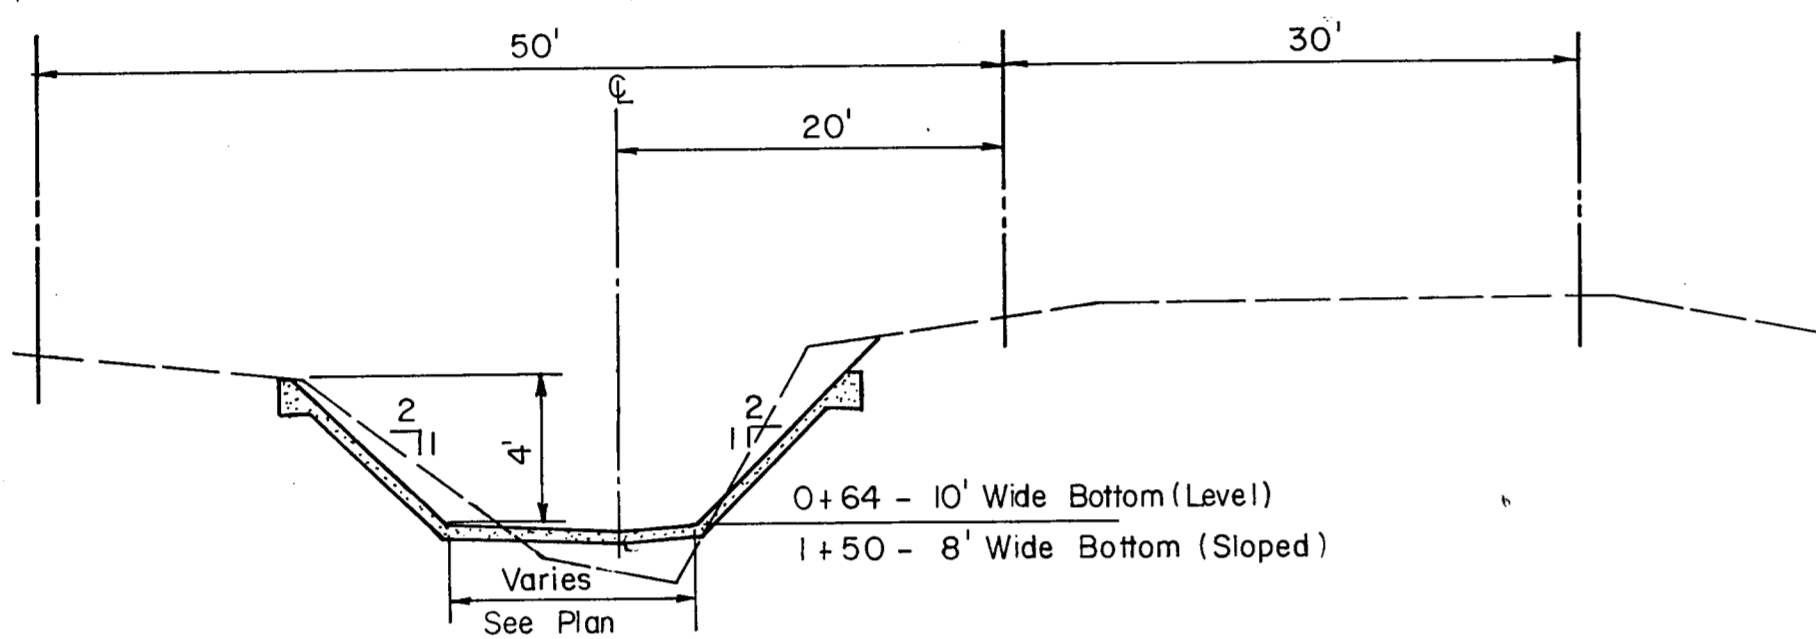


SECTION B-B TYPICAL STA. 0+64 to 1+50

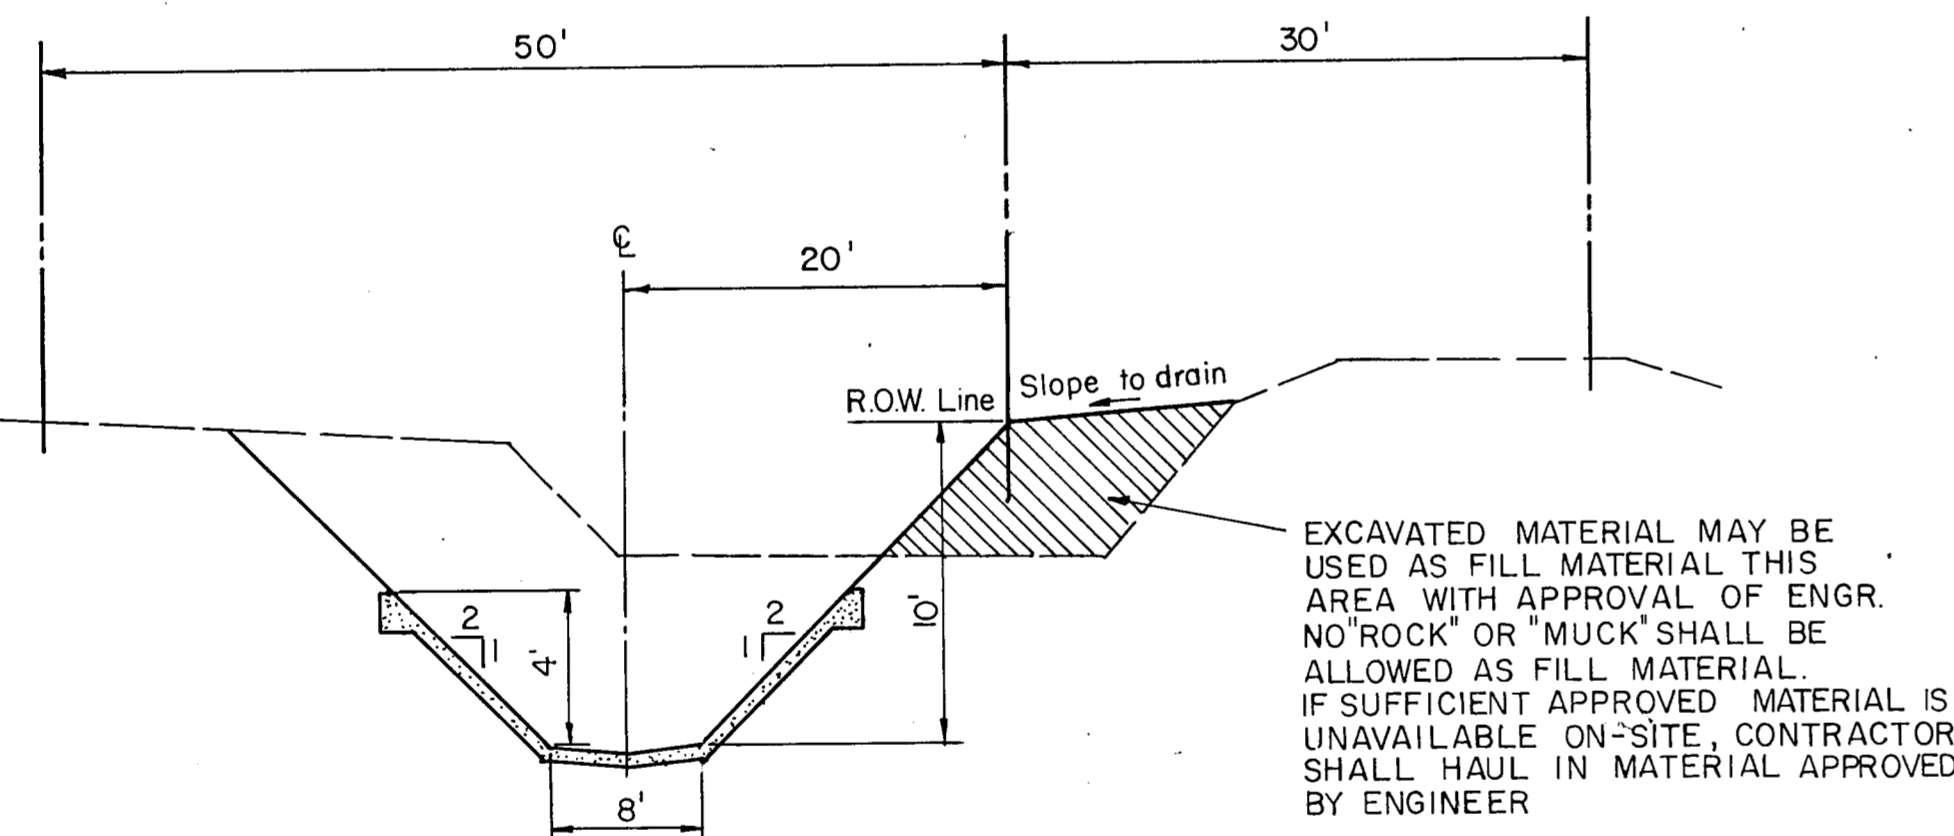


SECTION C-C TYPICAL STA. 11+50 to 15+00

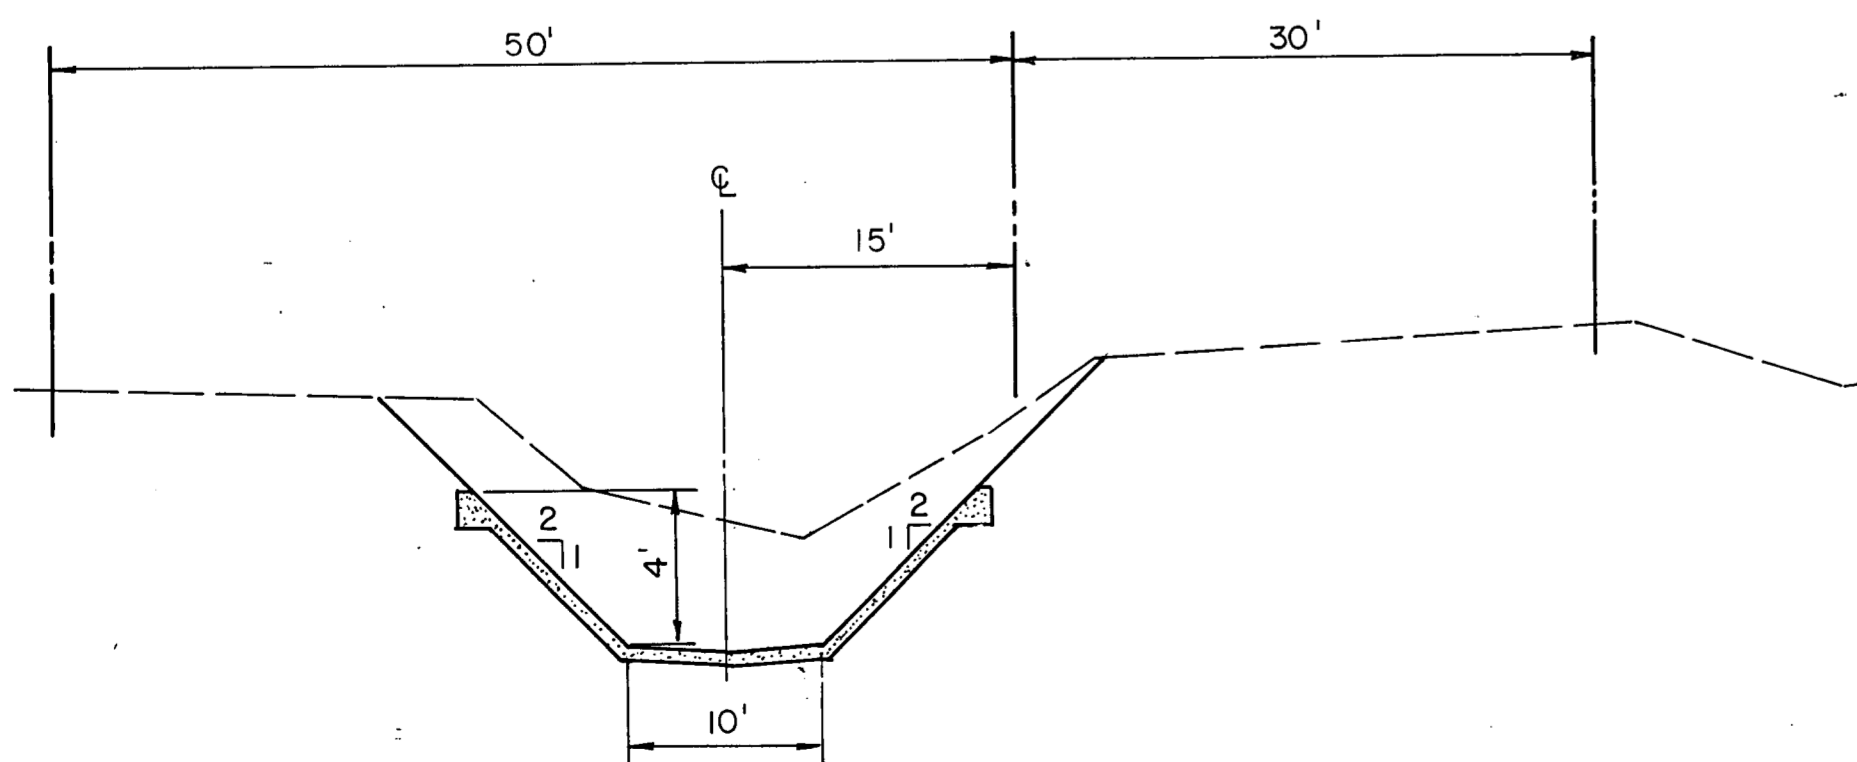


SECTION D-D TYPICAL STA. 16+00 to 21+00

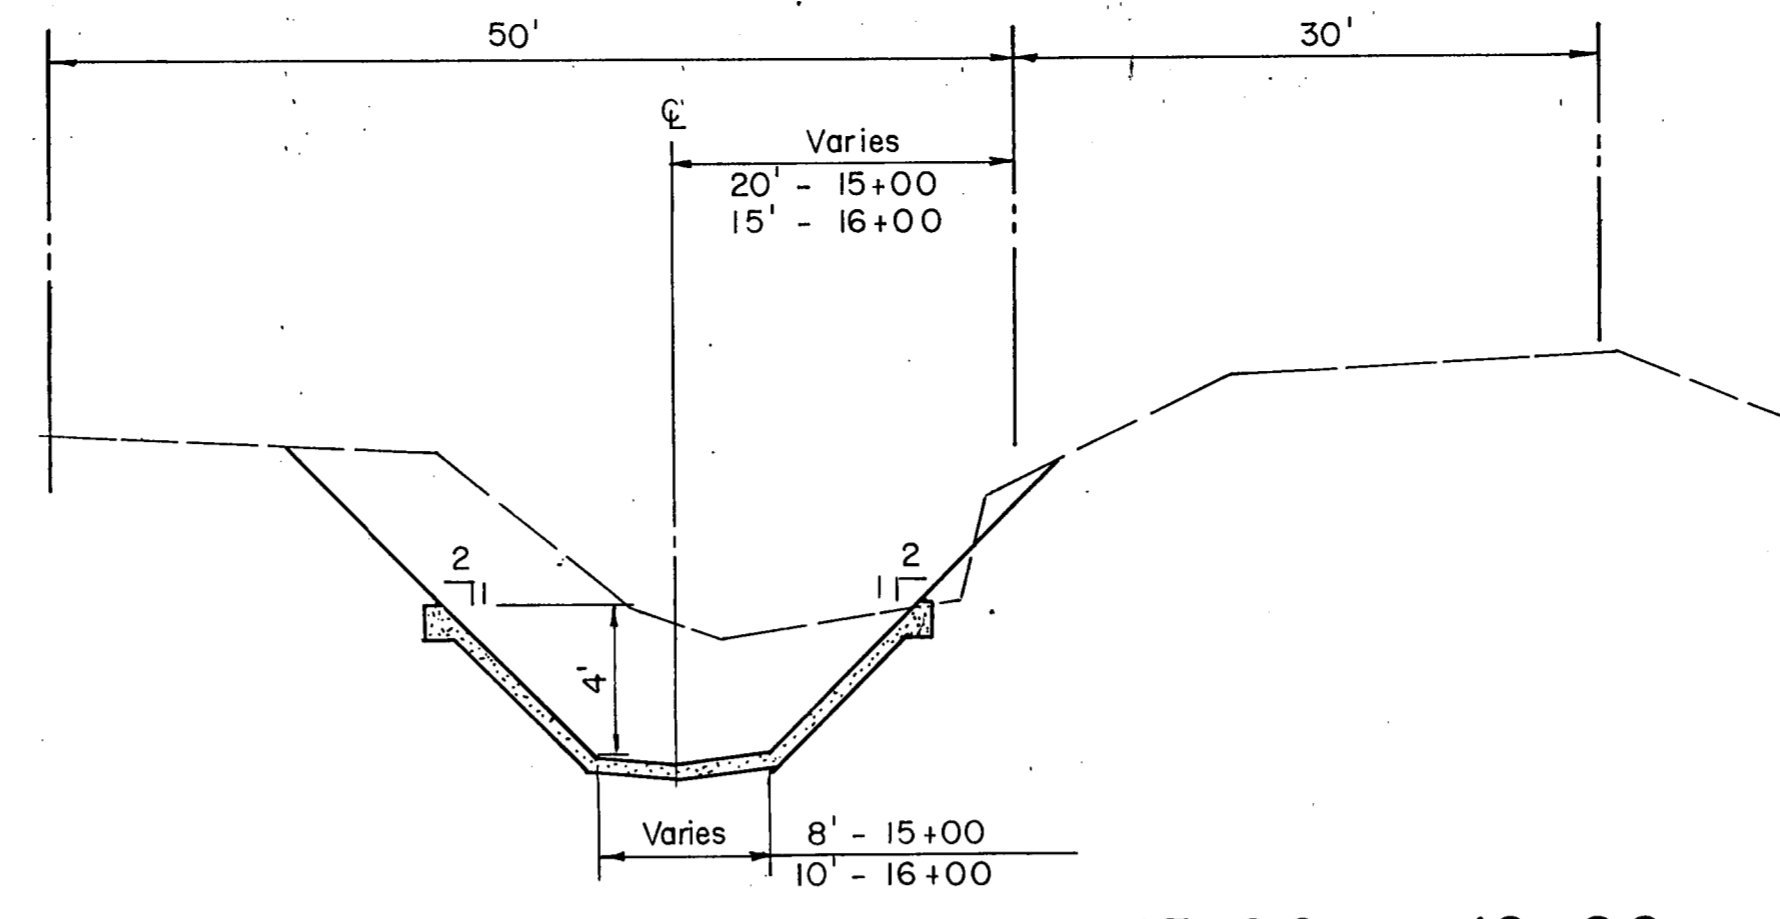

SECTION E-E TYPICAL STA. 15+00 to 16+00

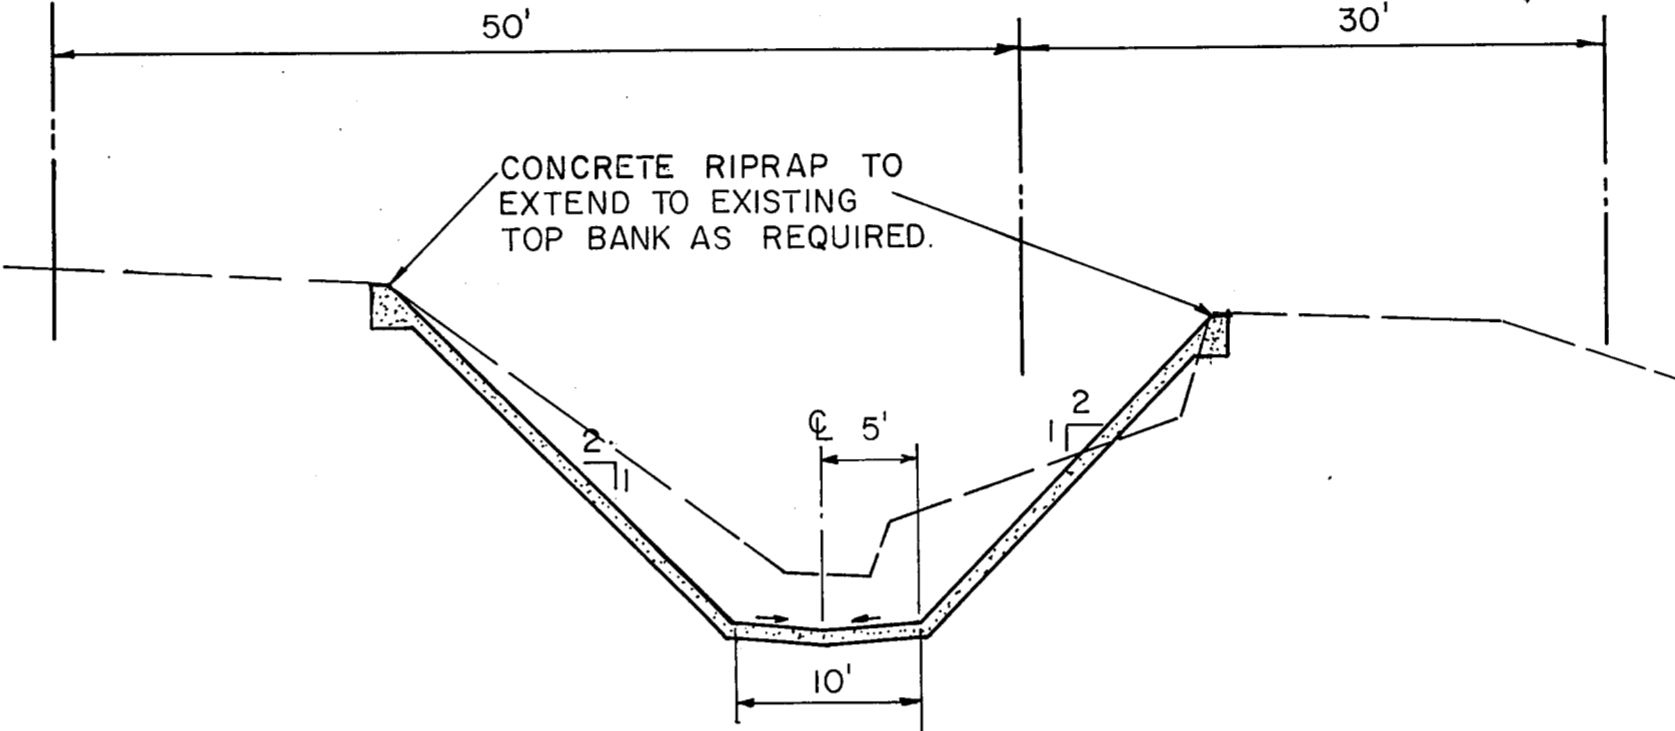

SECTION F-F TYPICAL STA. 21+00 to 23+57

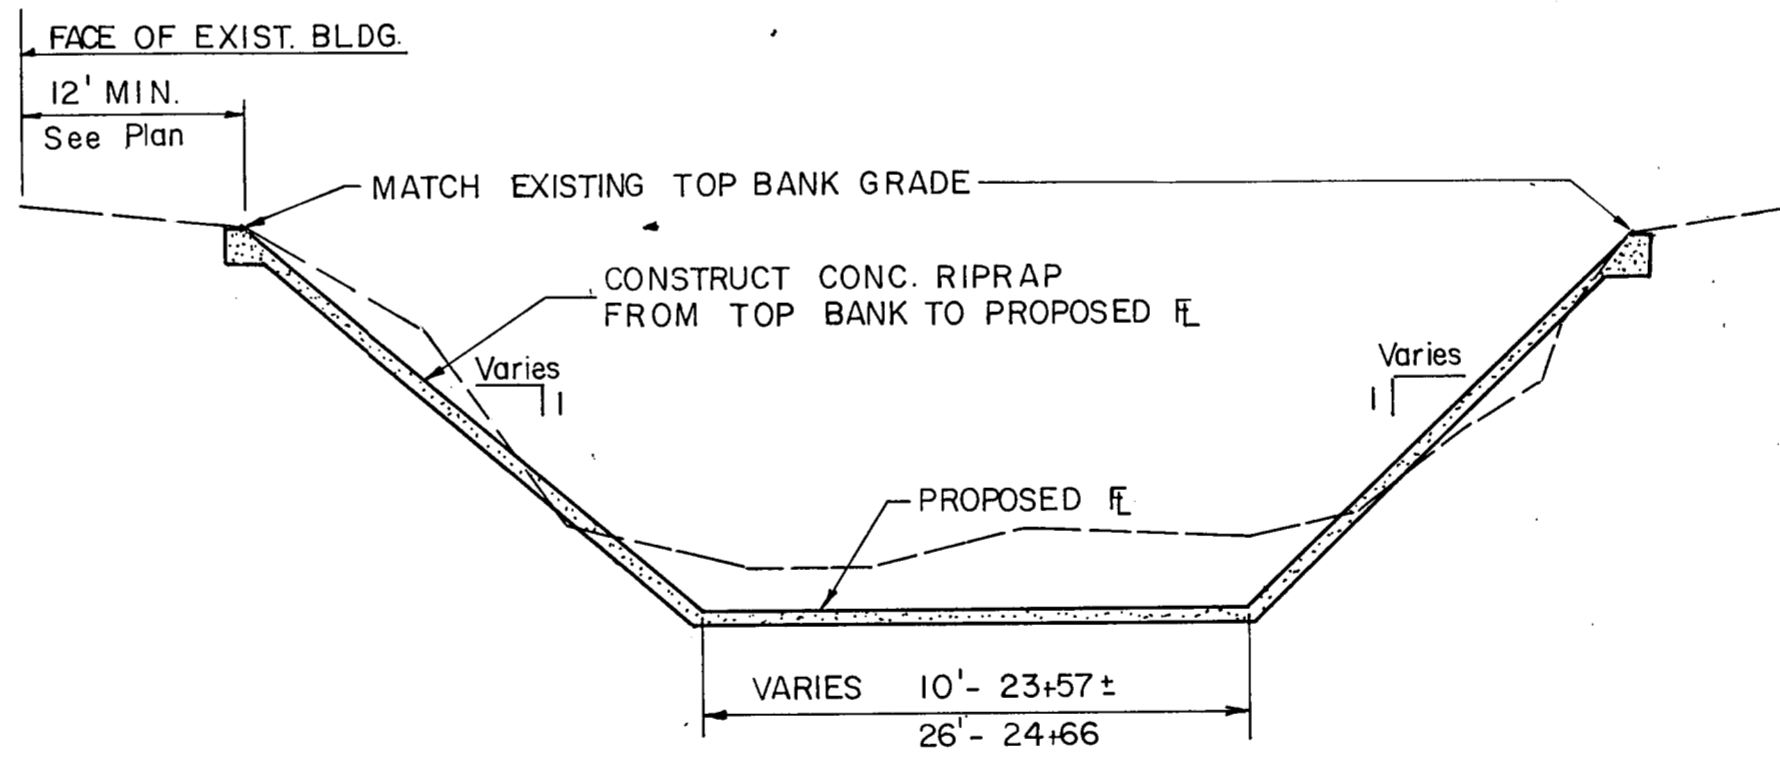


SECTION G-G TYPICAL STA. 23+57 to 24+66


TYPICAL DITCH SECTIONS

Scale: 1" = 10' Horiz, 1" = 5' Vert.


1. CONCRETE SHALL ATTAIN A MINIMUM COMPRESSIVE STRENGTH OF 3000 psi @ 28 DAYS.
2. CONSTRUCTION JOINTS WHERE BOTTOM SLOPE MEETS SIDE SLOPE IS OPTIONAL; MONOLITHIC CONSTRUCTION MAY BE USED.
3. USE A FLOAT FINISH ON BOTTOM AND SLOPED SURFACES (TO BE EXPOSED).
4. ALL REINF. STEEL SHALL BE #4 @ 12" o.c., E.W. UNLESS OTHERWISE NOTED.
5. PROVIDE TRANSVERSE EXPANSION JOINTS AT 80' o.c., TOOLED JOINTS AT 20' o.c.. CONSTRUCTION JOINTS MAY BE USED IN LIEU OF TOOLED JOINTS. JOINTS SHALL EXTEND UP SIDE SLOPES.
6. DESIGNATION OF TYPICAL SECTIONS BY STATIONS IS APPROXIMATE AND MAY BE MODIFIED AS FIELD CONDITIONS DICTATE.

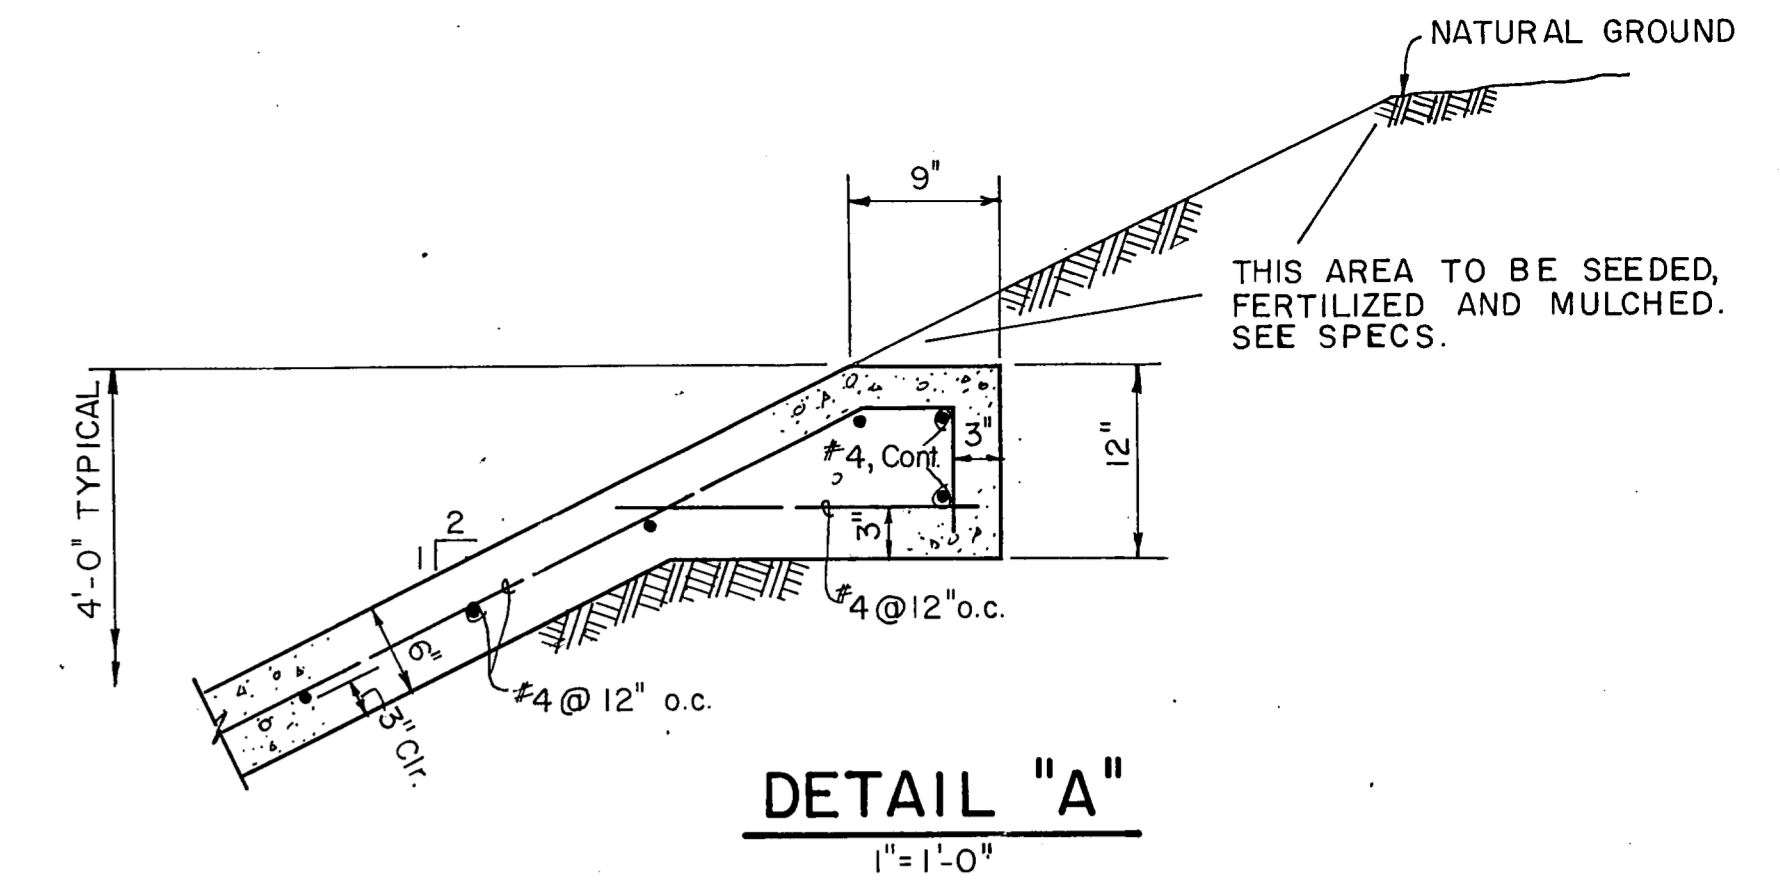

DETAIL "A"
1" = 1'-0"

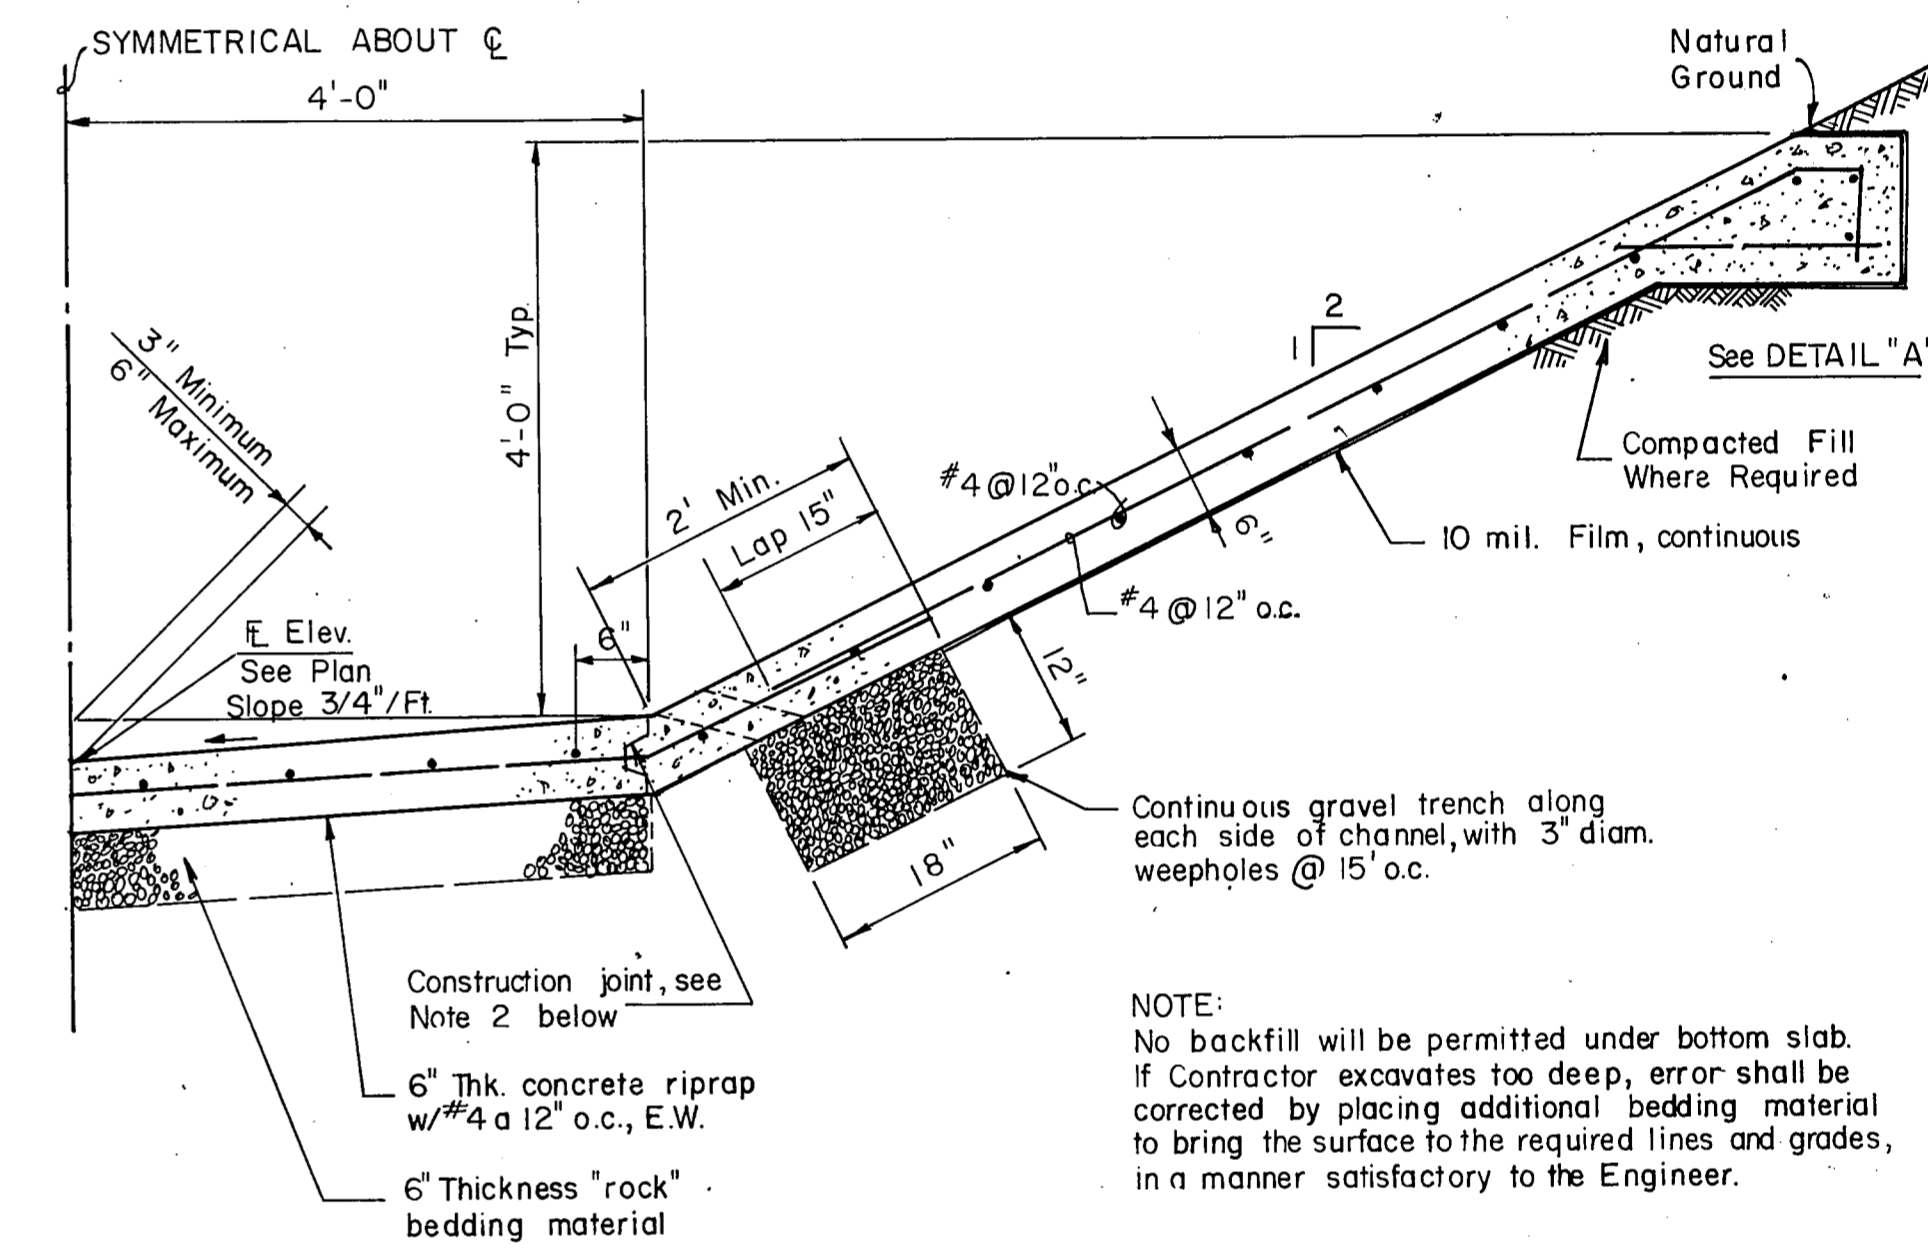


TYPICAL CHANNEL SECTION
3/4" = 1'-0"

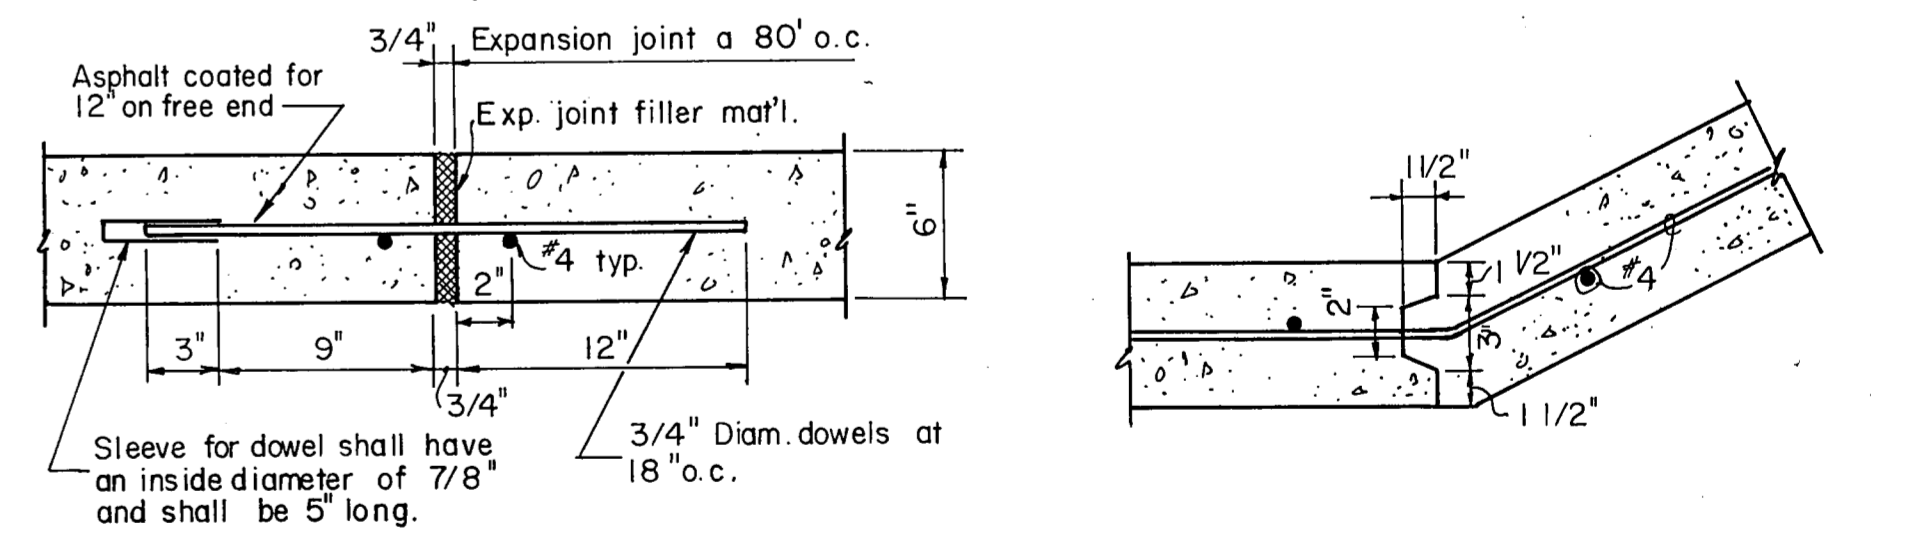


TRANSVERSE EXPANSION JOINT 1 1/2" = 1'-0"
CONSTRUCTION JOINT 1 1/2" = 1'-0"

CITY OF ADDISON			
DRAINAGE DITCH DETAILS			
MIDWAY ROAD IMPROVEMENTS			
GINN, INC., Consulting Engineers, Dallas, Texas			
Designed-G.F.	Drawn-G.F.	Date- MARCH, 1981	Sheet 32 of
Approved-	Checked-	Scale- AS SHOWN	

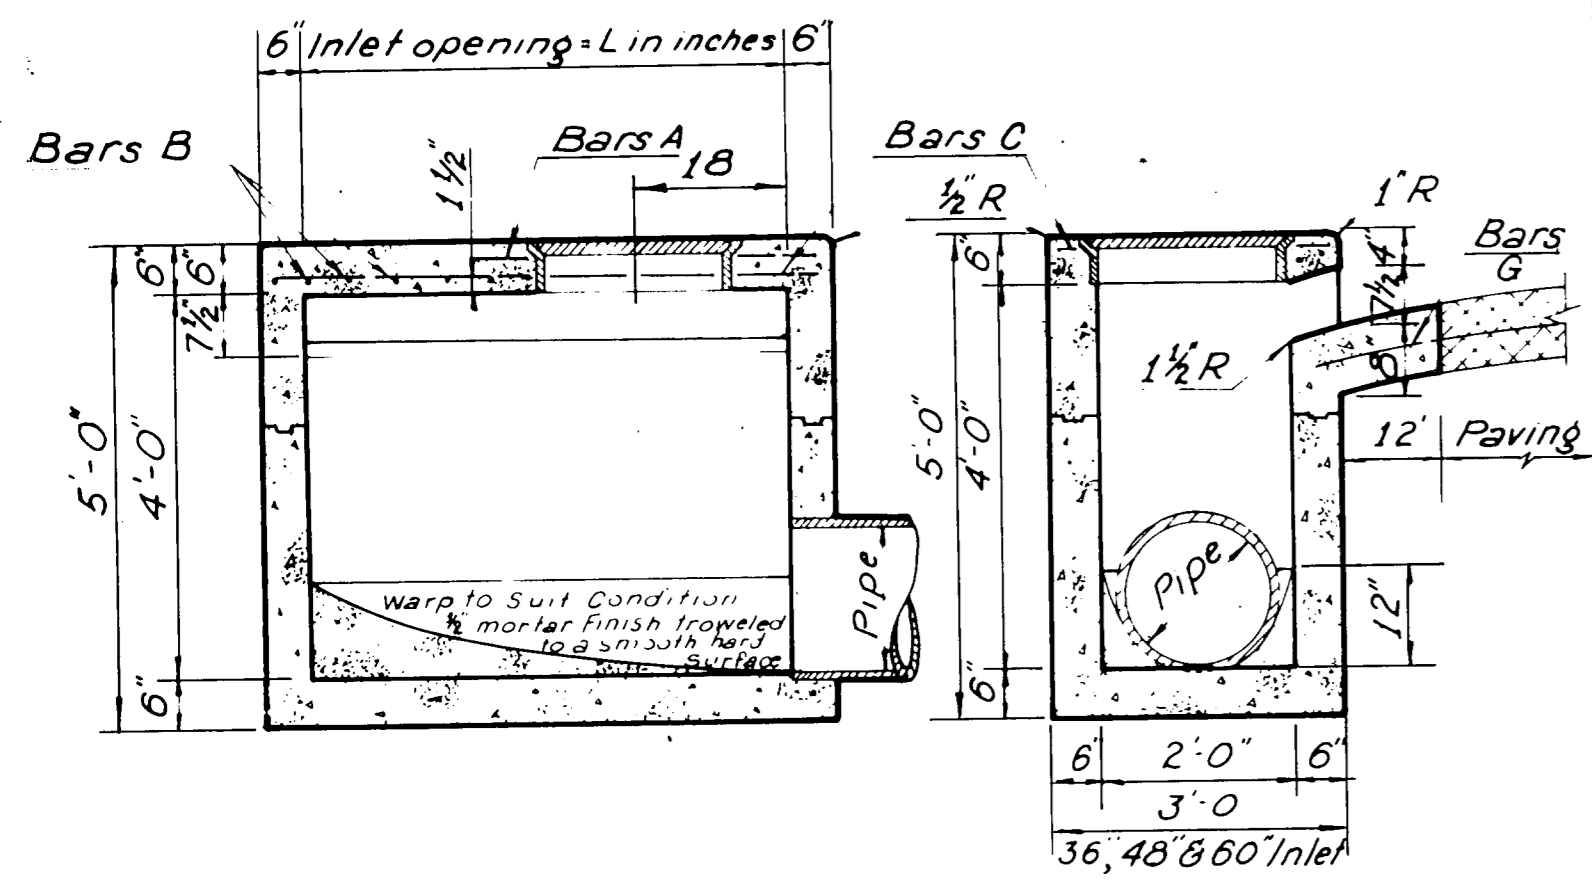


SECTION B-B


SECTION C-C

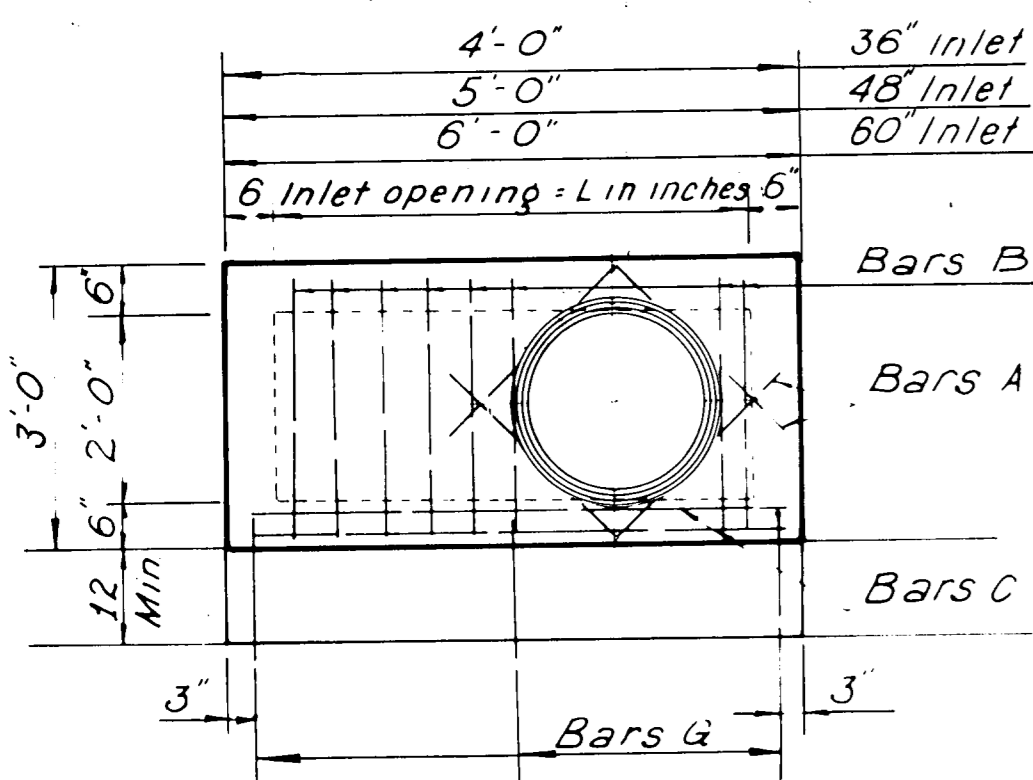


REINFORCING PLAN

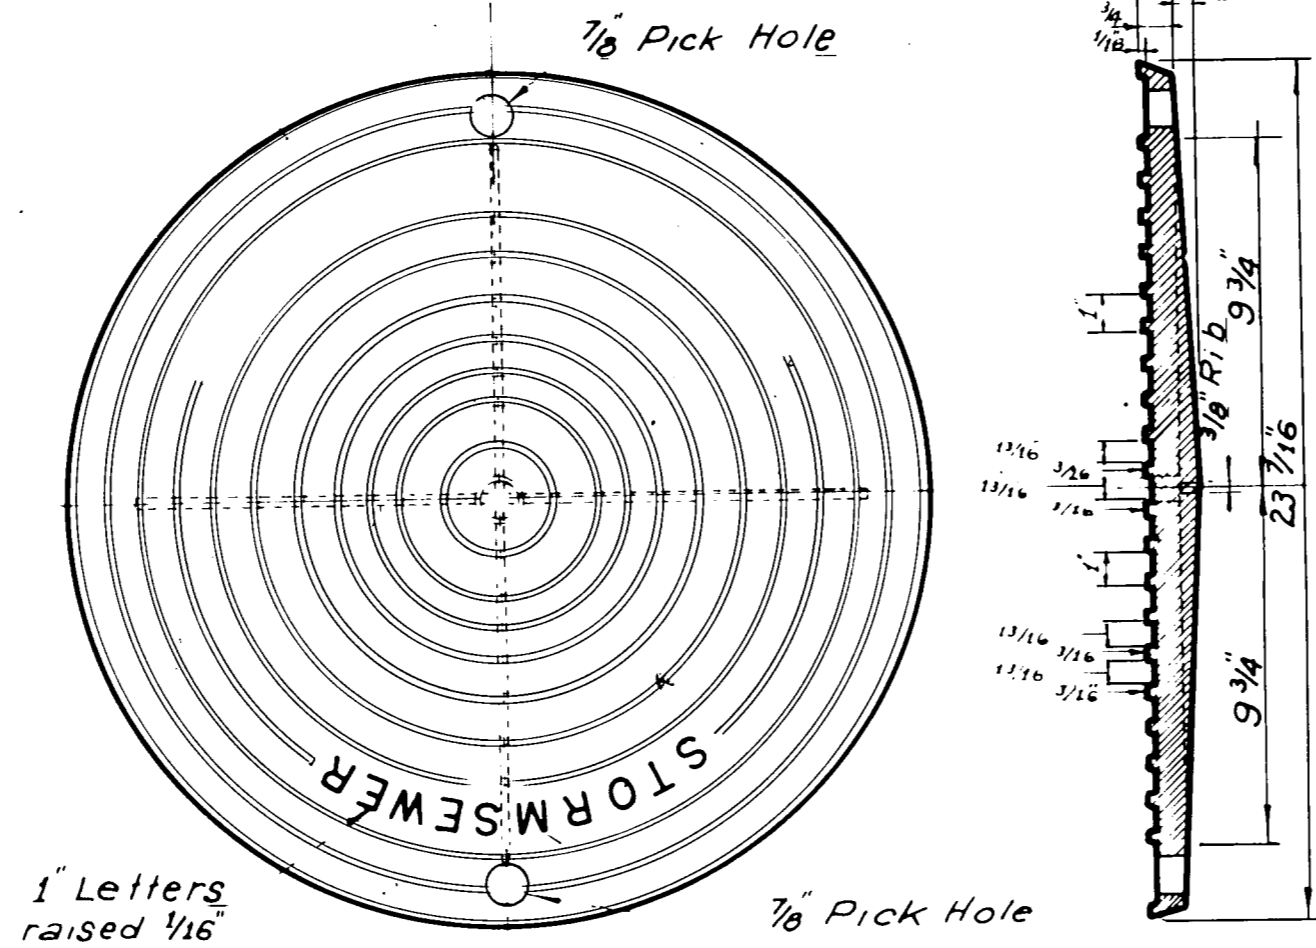

PLAN OF COVER

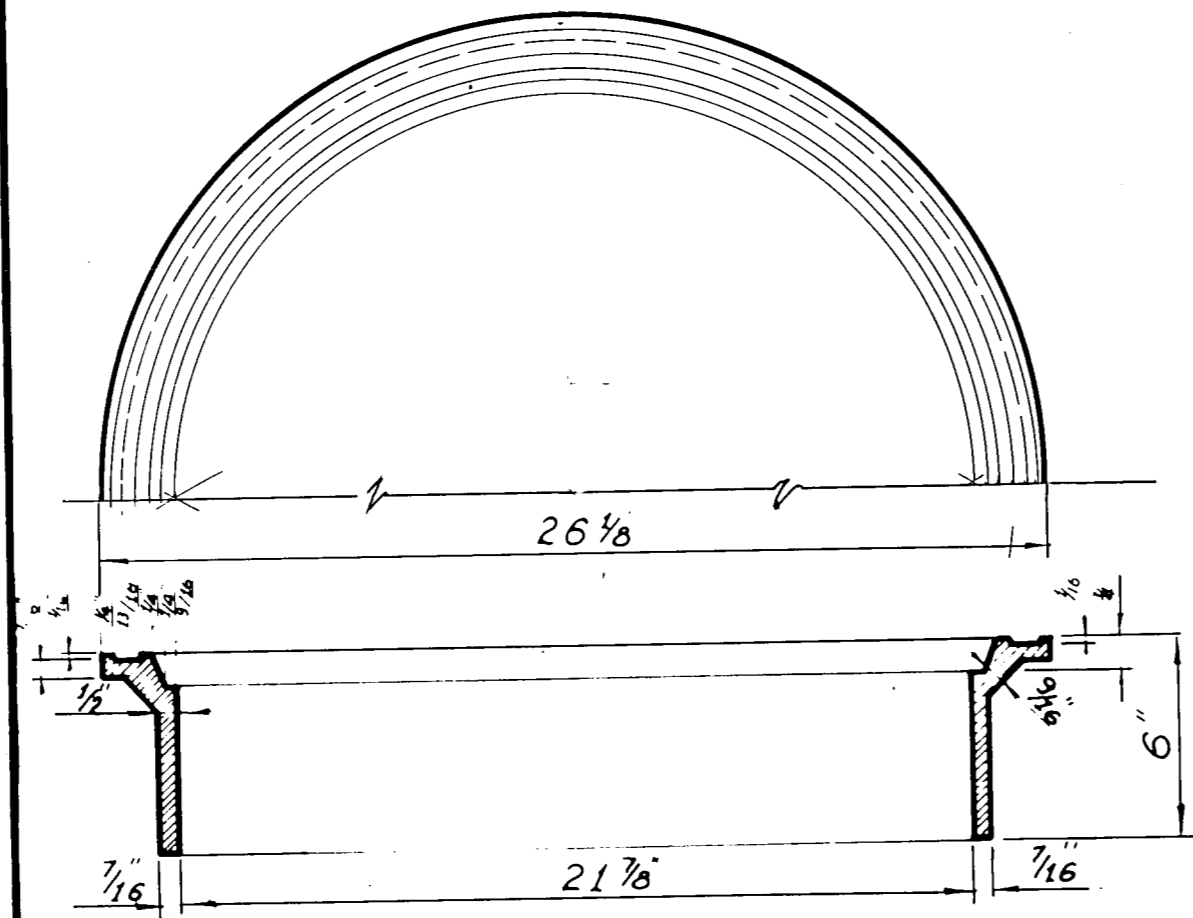


SECTION OF FRAME INLET FRAME AND COVER

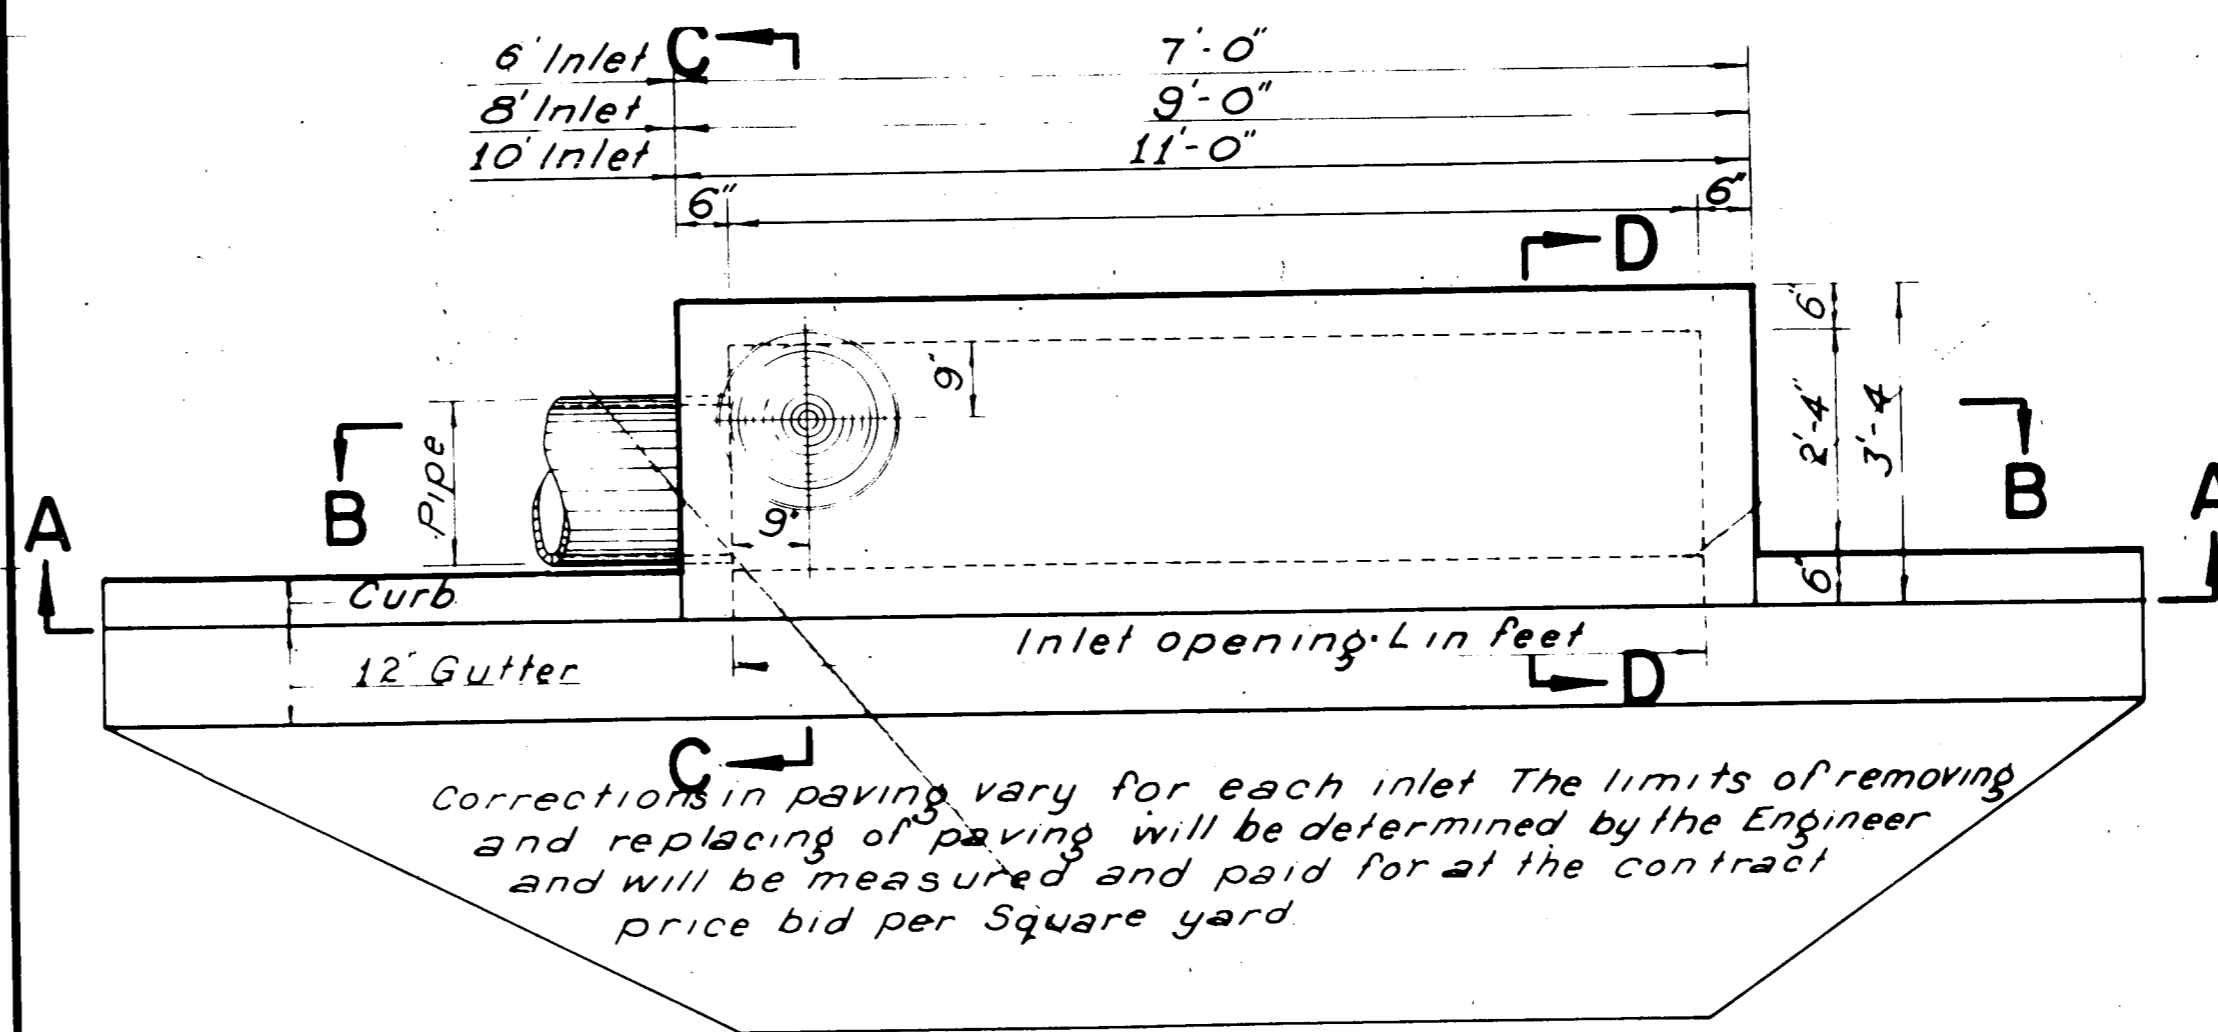


PLAN


SECTION A-A

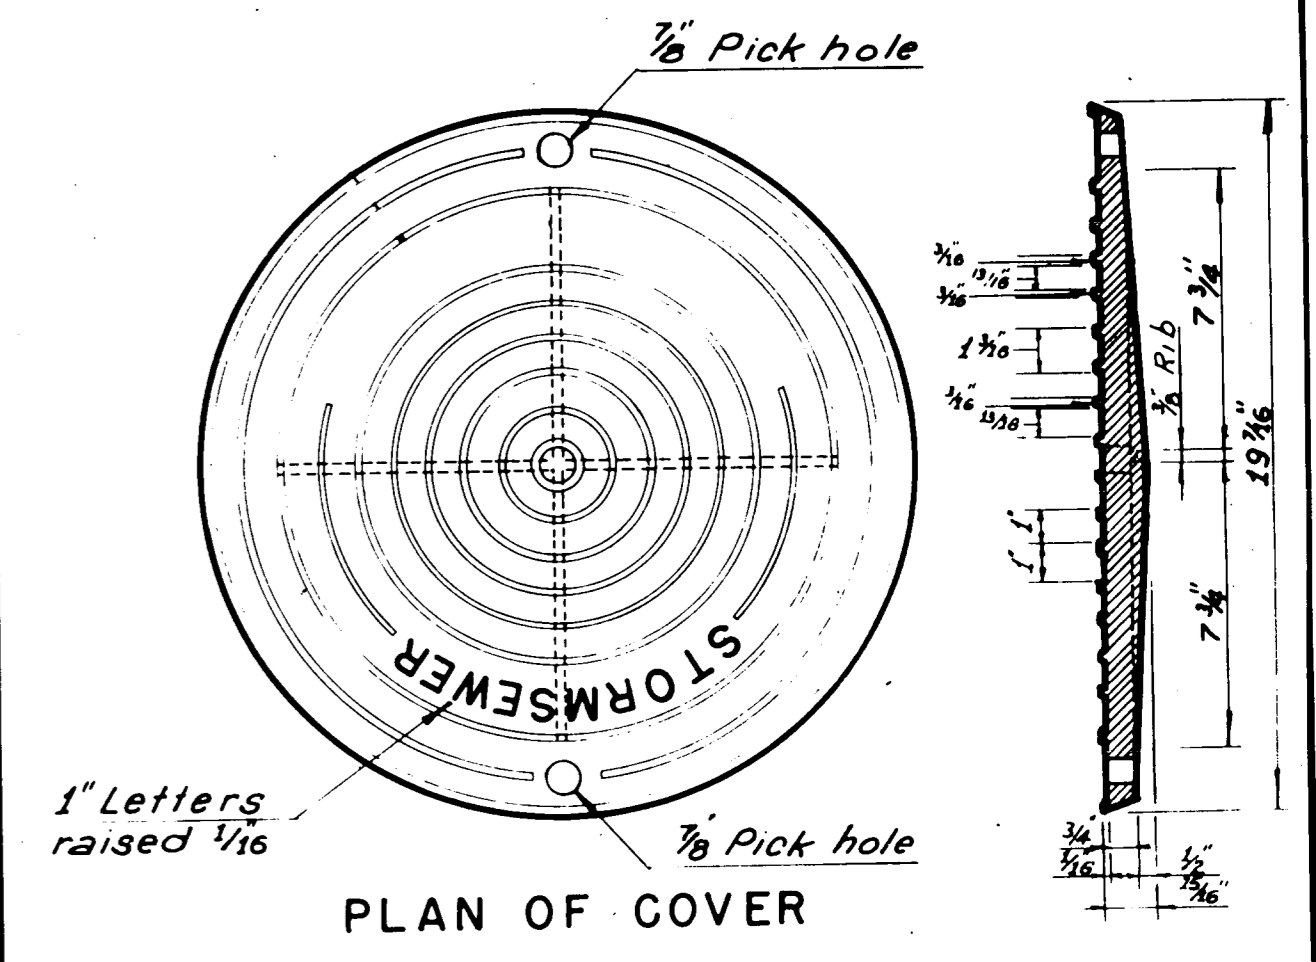

PLAN OF COVER

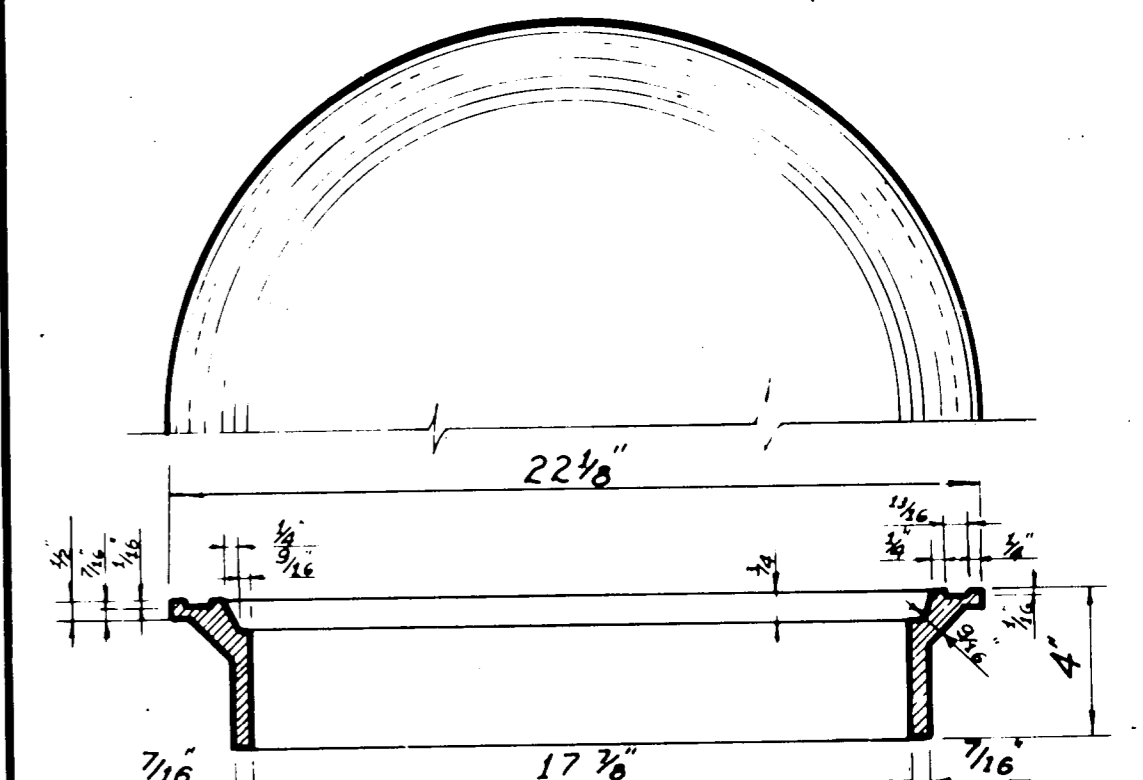


SECTION OF FRAME INLET FRAME AND COVER

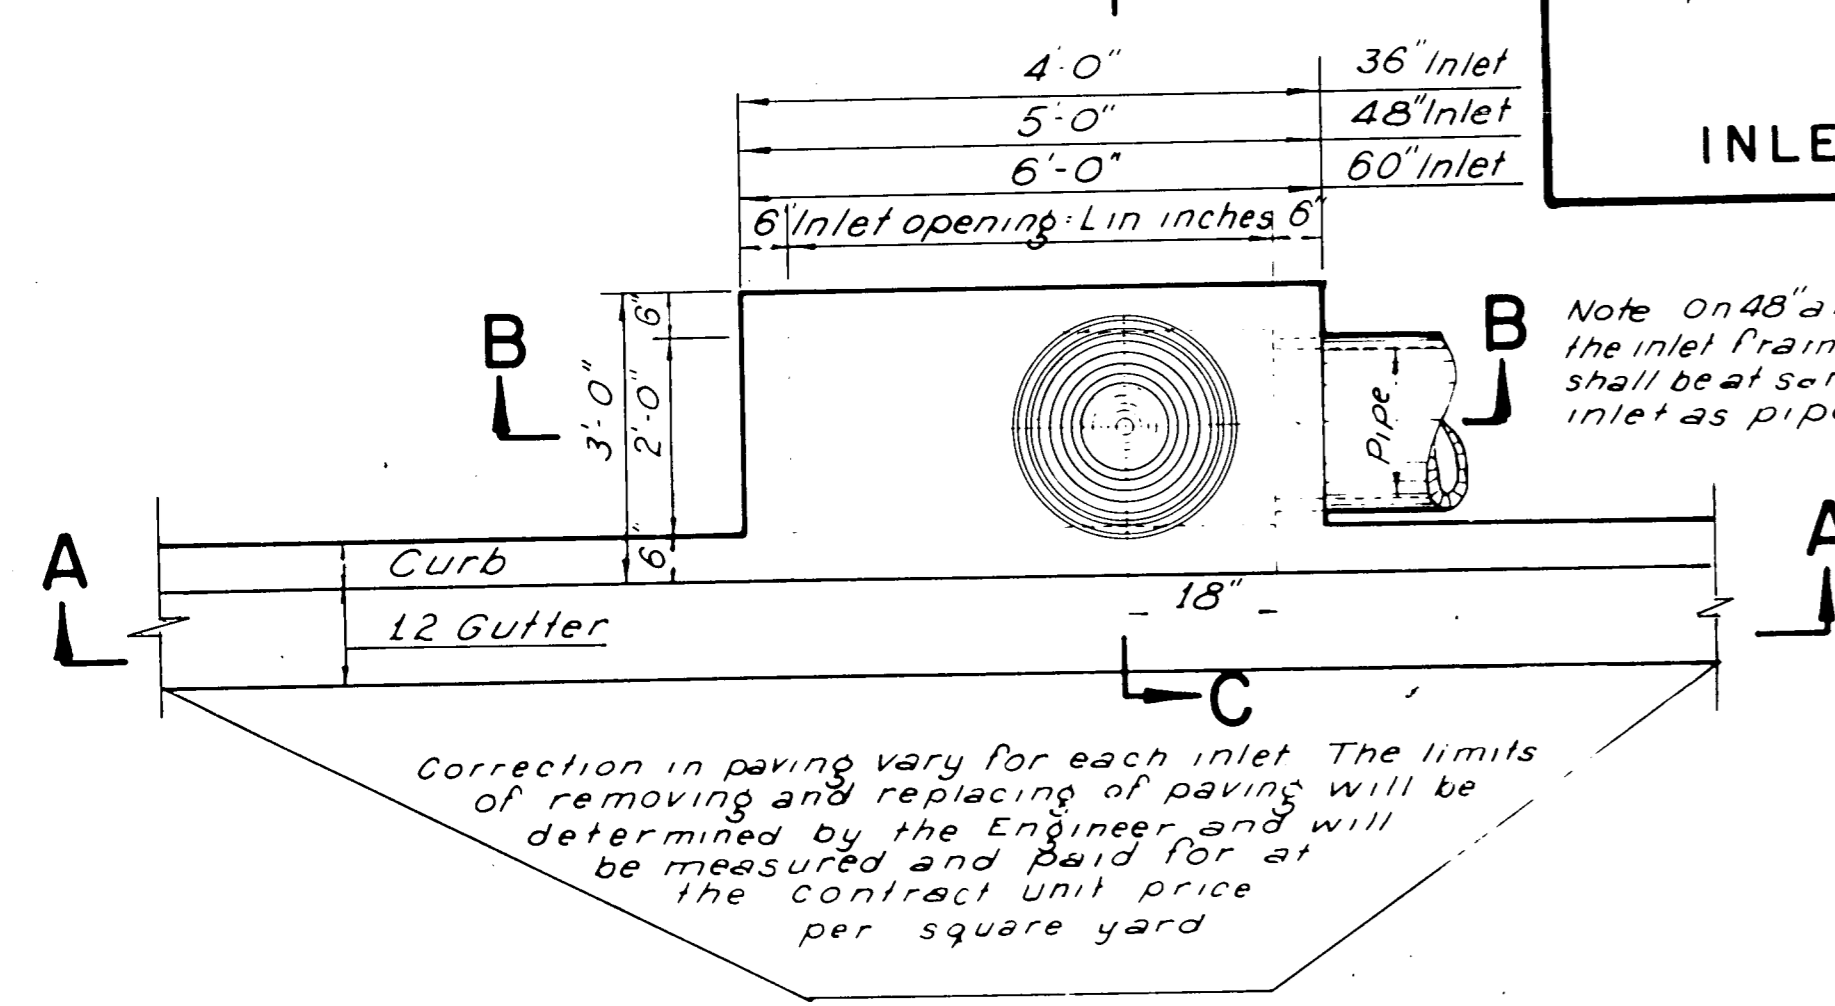

PLAN

SECTION A-A

36, 48 AND 60 INCH INLETS

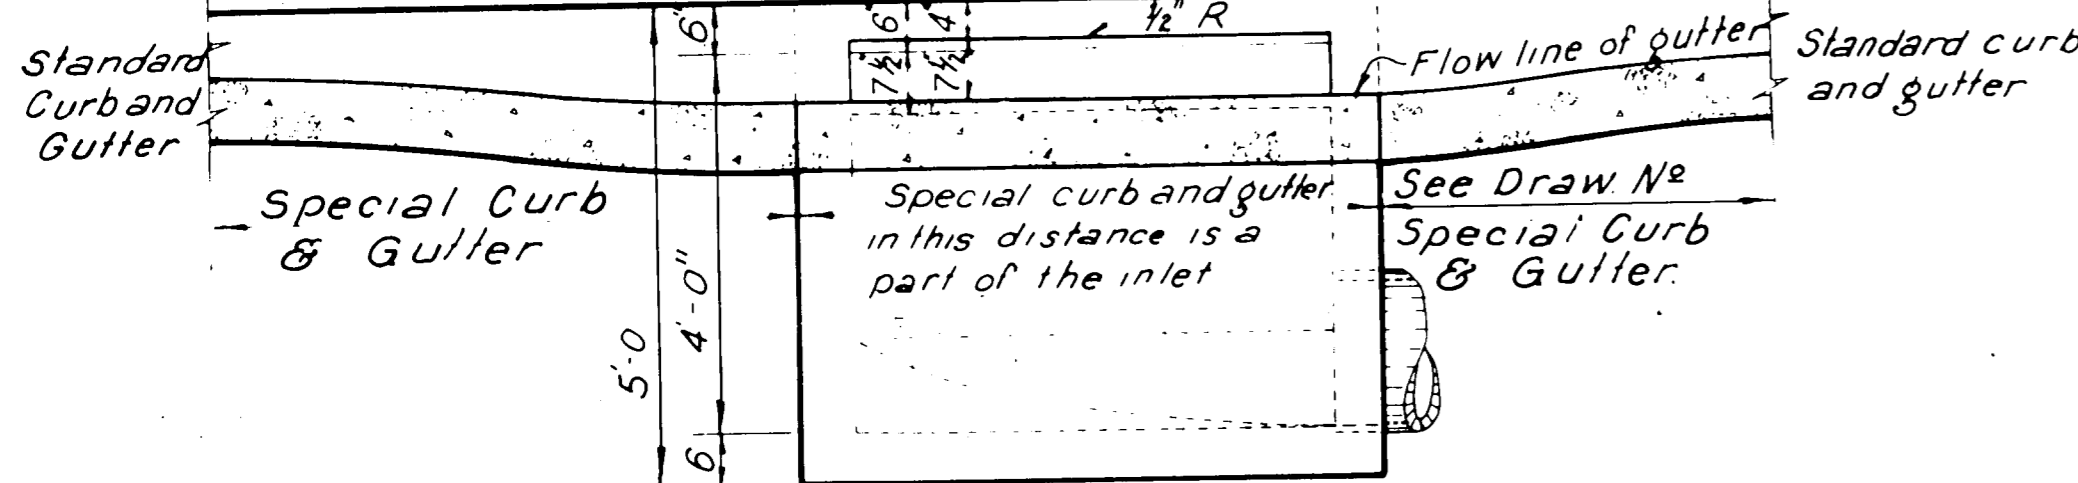

Note: On 48" and 60" inlets the inlet frame and cover shall be at same end of inlet as pipe.

2'-6"	36" Inlet - #5-4 required
2'-6"	48" Inlet - #5-4 required
2'-6"	60" Inlet - #5-4 required
BARS A	
2'-9"	36" Inlet - #5-4 required
2'-9"	48" Inlet - #5-6 required
2'-9"	60" Inlet - #5-8 required
BARS B	
3'-3"	36" Inlet - #5-2 required
4'-8"	48" Inlet - #5-2 required
5'-9"	60" Inlet - #5-2 required
BARS C	
3'-0"	36, 48 & 60" Inlets #3-3 required
BARS G	

BARS H

3'-0"	6" Inlet - #3-10 required
3'-0"	8" Inlet - #3-13 required
3'-0"	10" Inlet - #3-16 required

BARS A

4'-10"	6" Inlet - #3-1 required
6'-10"	8" Inlet - #3-1 required
8'-10"	10" Inlet - #3-3 required

BARS B


6'-8"	6" Inlet - #4-15 required
8'-8"	8" Inlet - #4-15 required
10'-8"	10" Inlet - #4-15 required

BARS C


4'-8"	6, 8 & 10" Inlet #4-5 required
3'-6"	6, 8 & 10" Inlet #4-1 required
3'-0"	6, 8 & 10" Inlet #3-5 required

BARS D


4'-8"	6, 8 & 10" Inlet #4-5 required
3'-6"	6, 8 & 10" Inlet #4-1 required
3'-0"	6, 8 & 10" Inlet #3-5 required

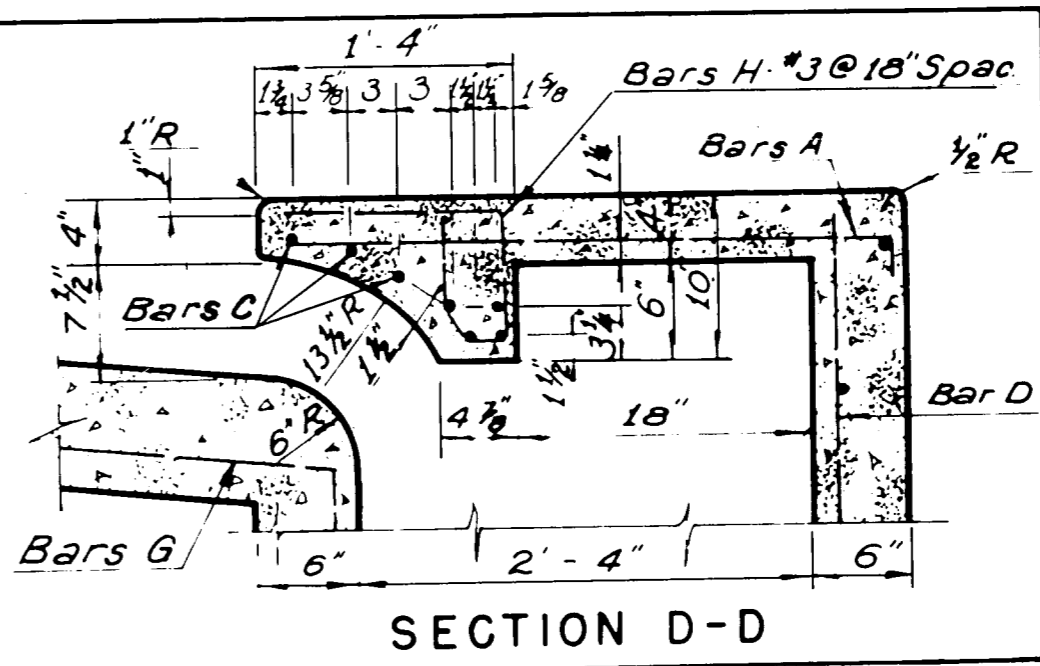


SECTION D-D

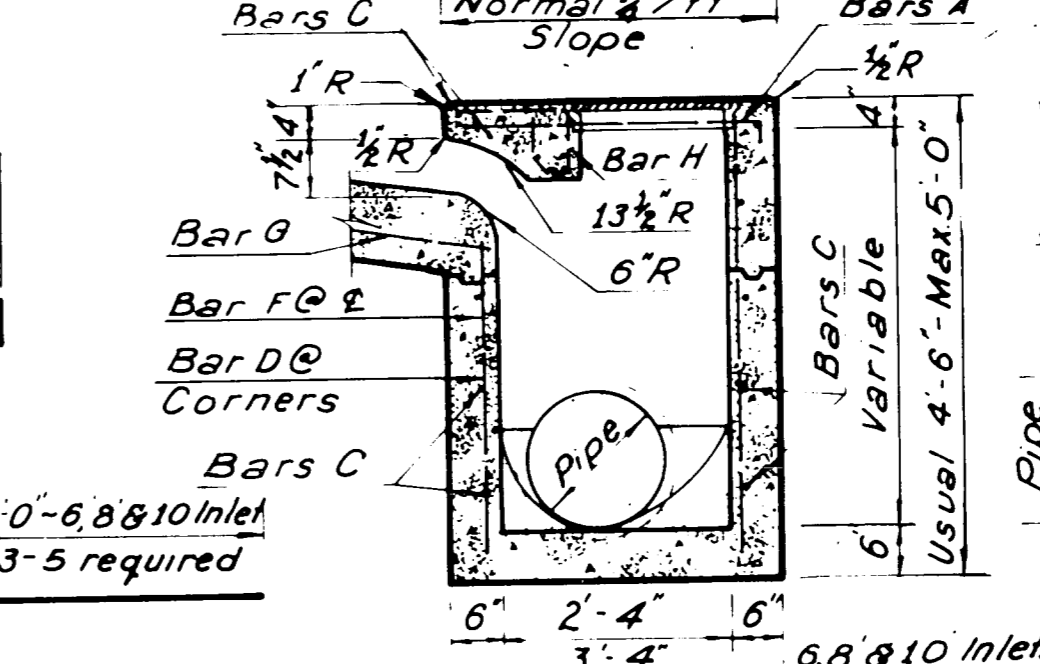

SECTION C-C

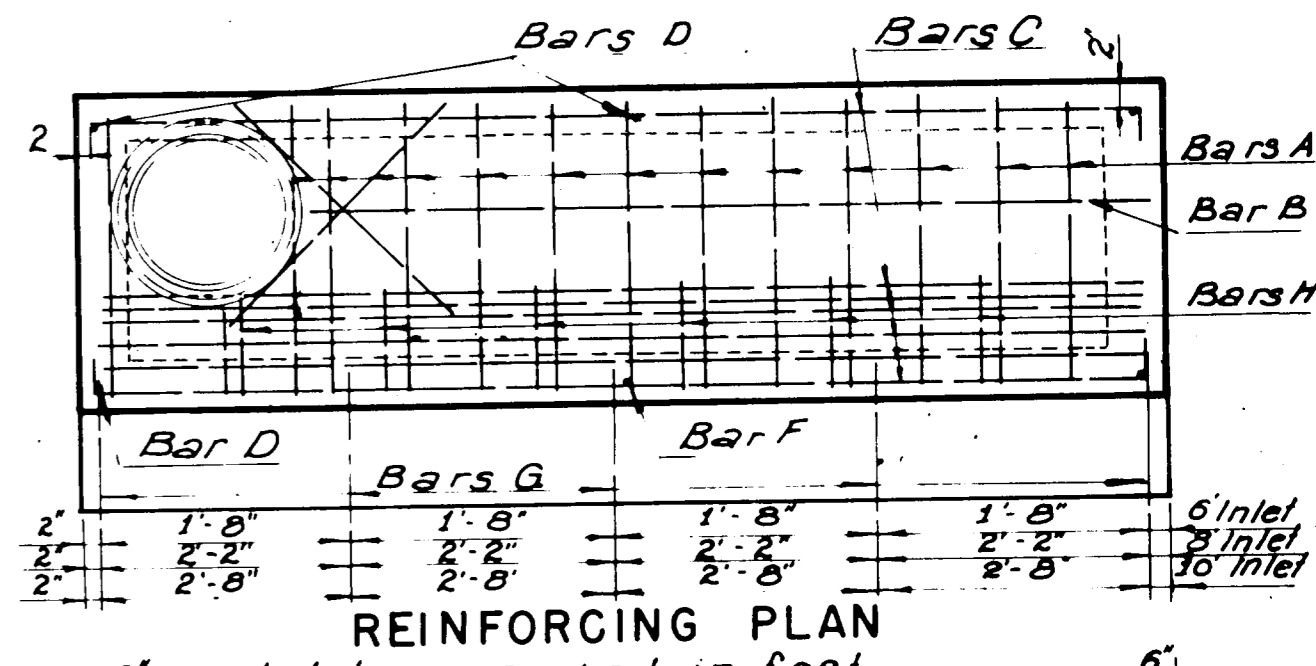

REINFORCING PLAN

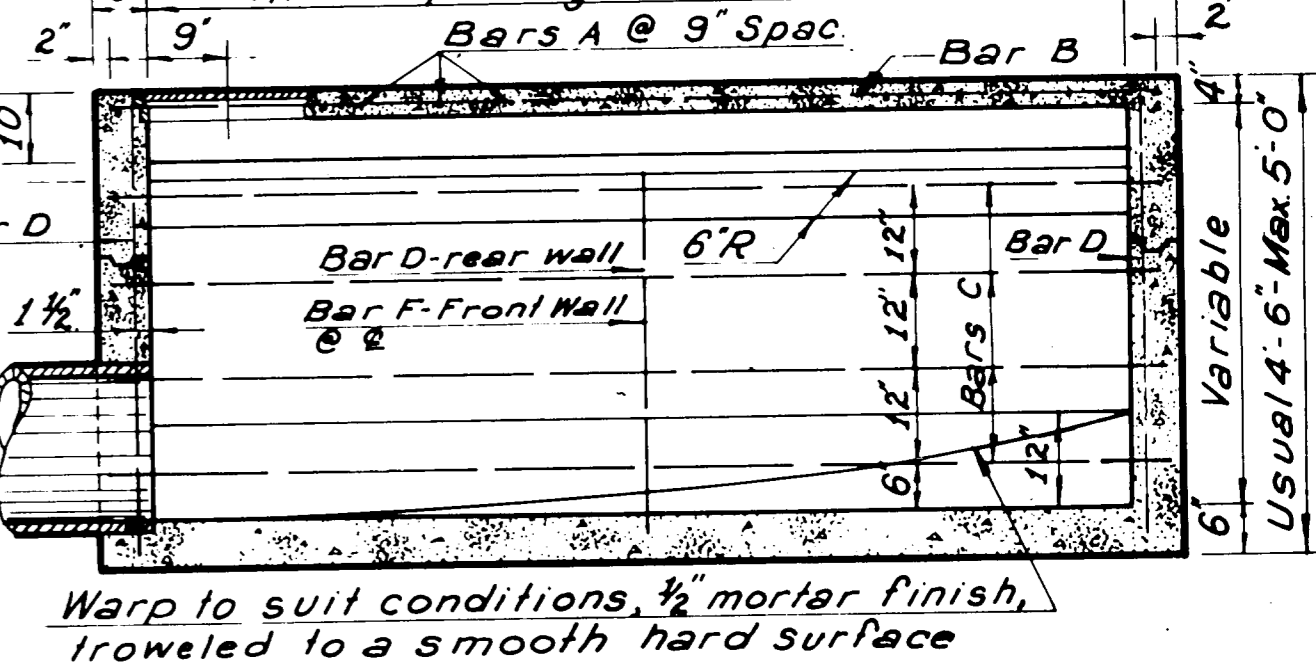

SECTION B-B

NOTES:

Concrete shall have a minimum compressive of 3,000 psi at 28 days.
Lateral pipe may enter inlet at any location.
The 12" gutter in front of inlet is a part of the inlet and shall be built with the inlet.
Top of inlet slope shall conform to adjacent parkway normal 1/4" ft Slope

6, 8 AND 10 FOOT INLETS

COUNTY OF DALLAS
DEPARTMENT OF PUBLIC WORKS
STANDARD CURB INLET

36, 48 & 60 INCH INLET
6, 8 & 10 FOOT INLET
FROM CITY OF DALLAS DRAWING NO. 424-D


CITY OF ADDISON

MIDWAY ROAD IMPROVEMENTS

STANDARD CURB INLET DETAILS

GINN, INC., Consulting Engineers


DESIGNED - S.M.M. DATE 11-20-1980
APPROVED - G.F. CHECKED - G.F. SCALE - NONE SHEET 33 OF

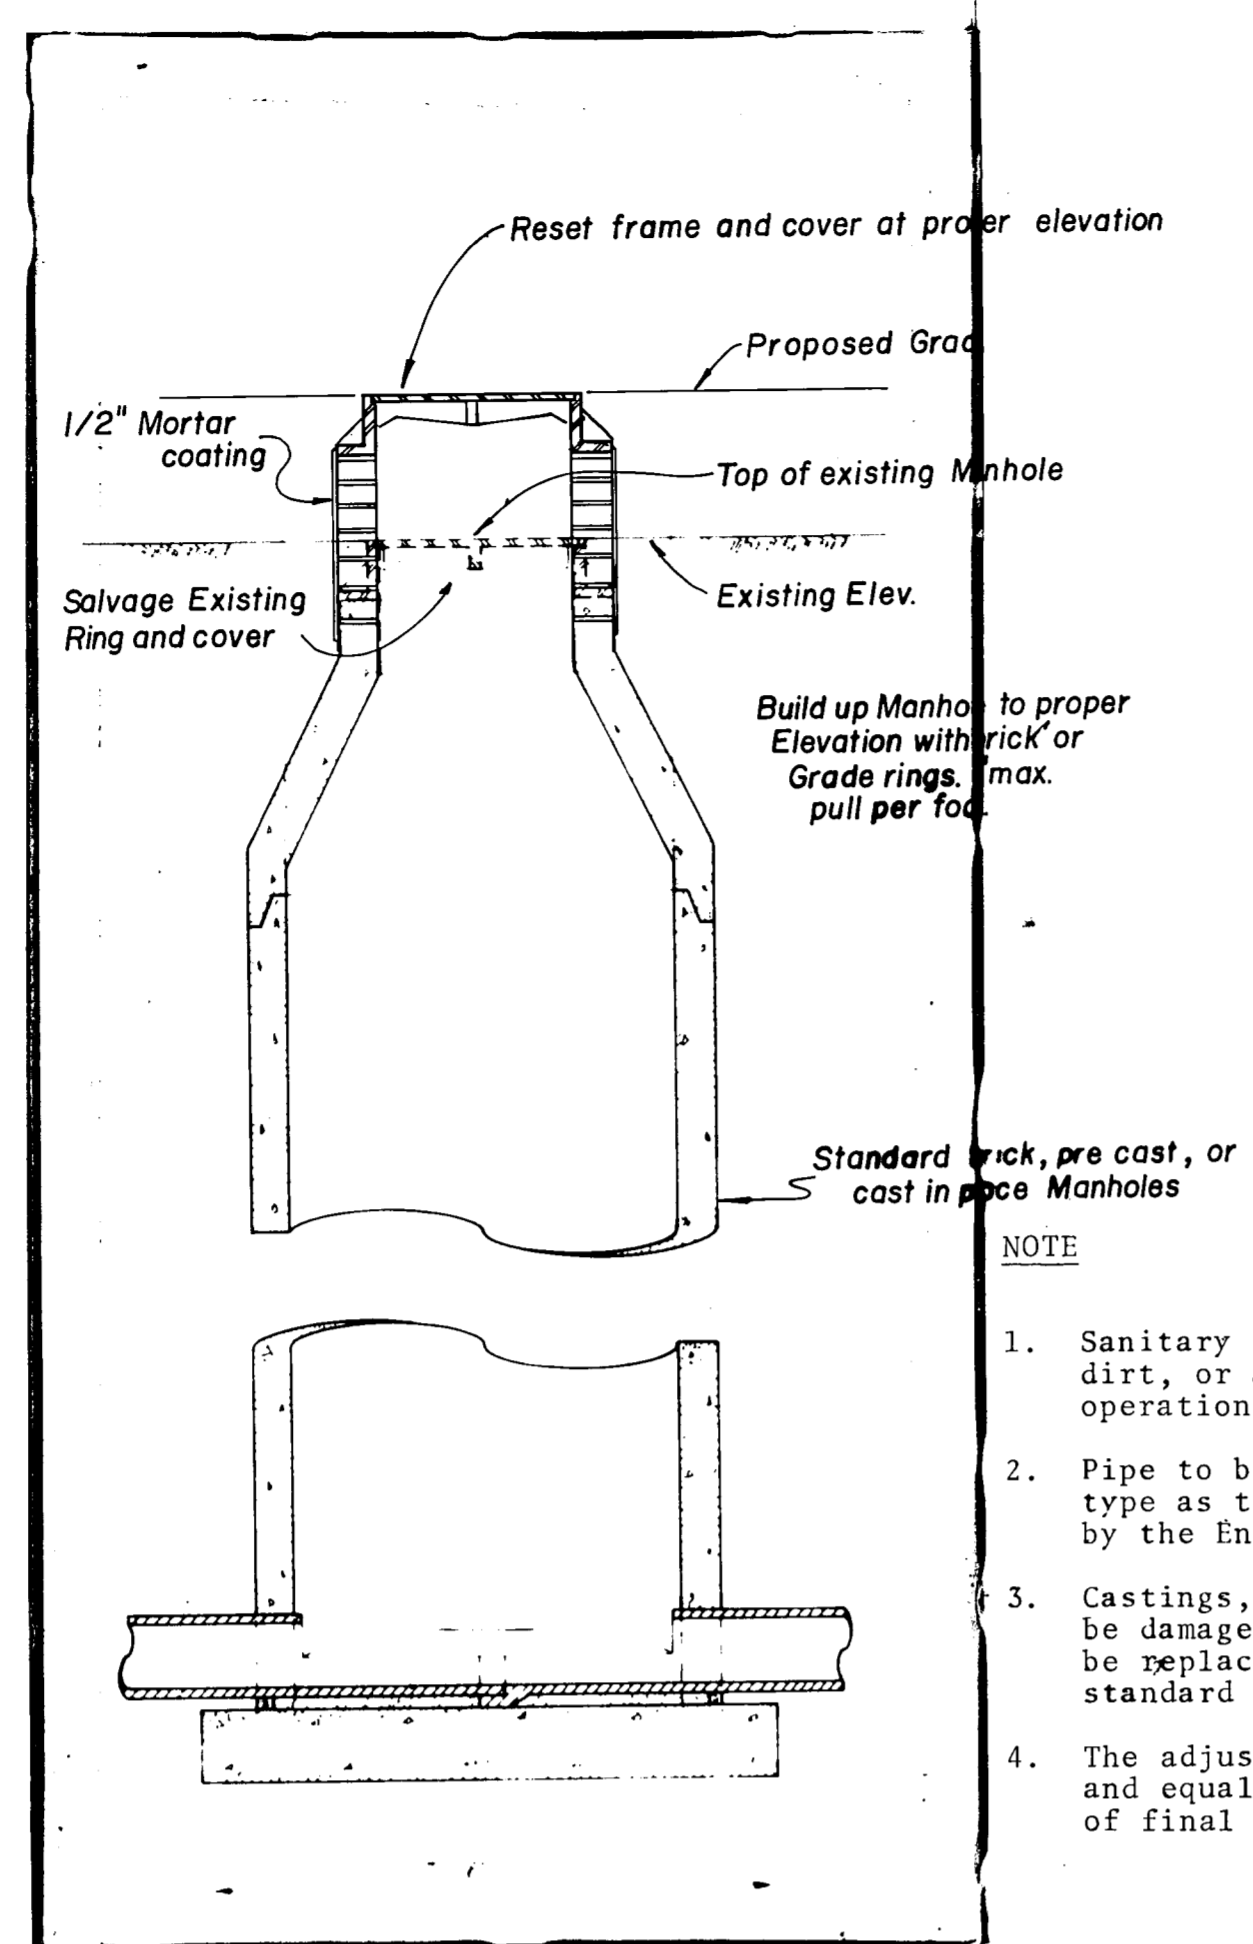


NOTE

1. Sanitary sewer shall be kept clear of broken concrete, dirt, or any other debris resulting from construction operations.
2. Pipe to be extended or replaced will be of the same type as the existing unless alternate type is approved by the Engineer.
3. Castings, covers or any other material parts which may be damaged or lost by the contractor's operations will be replaced at the contractor's expense with City standard appurtenances.
4. The adjusted facilities must be clean, fully operational and equal in quality with new construction at the time of final inspection of the project.


TYPICAL MANHOLE ADJUSTMENT

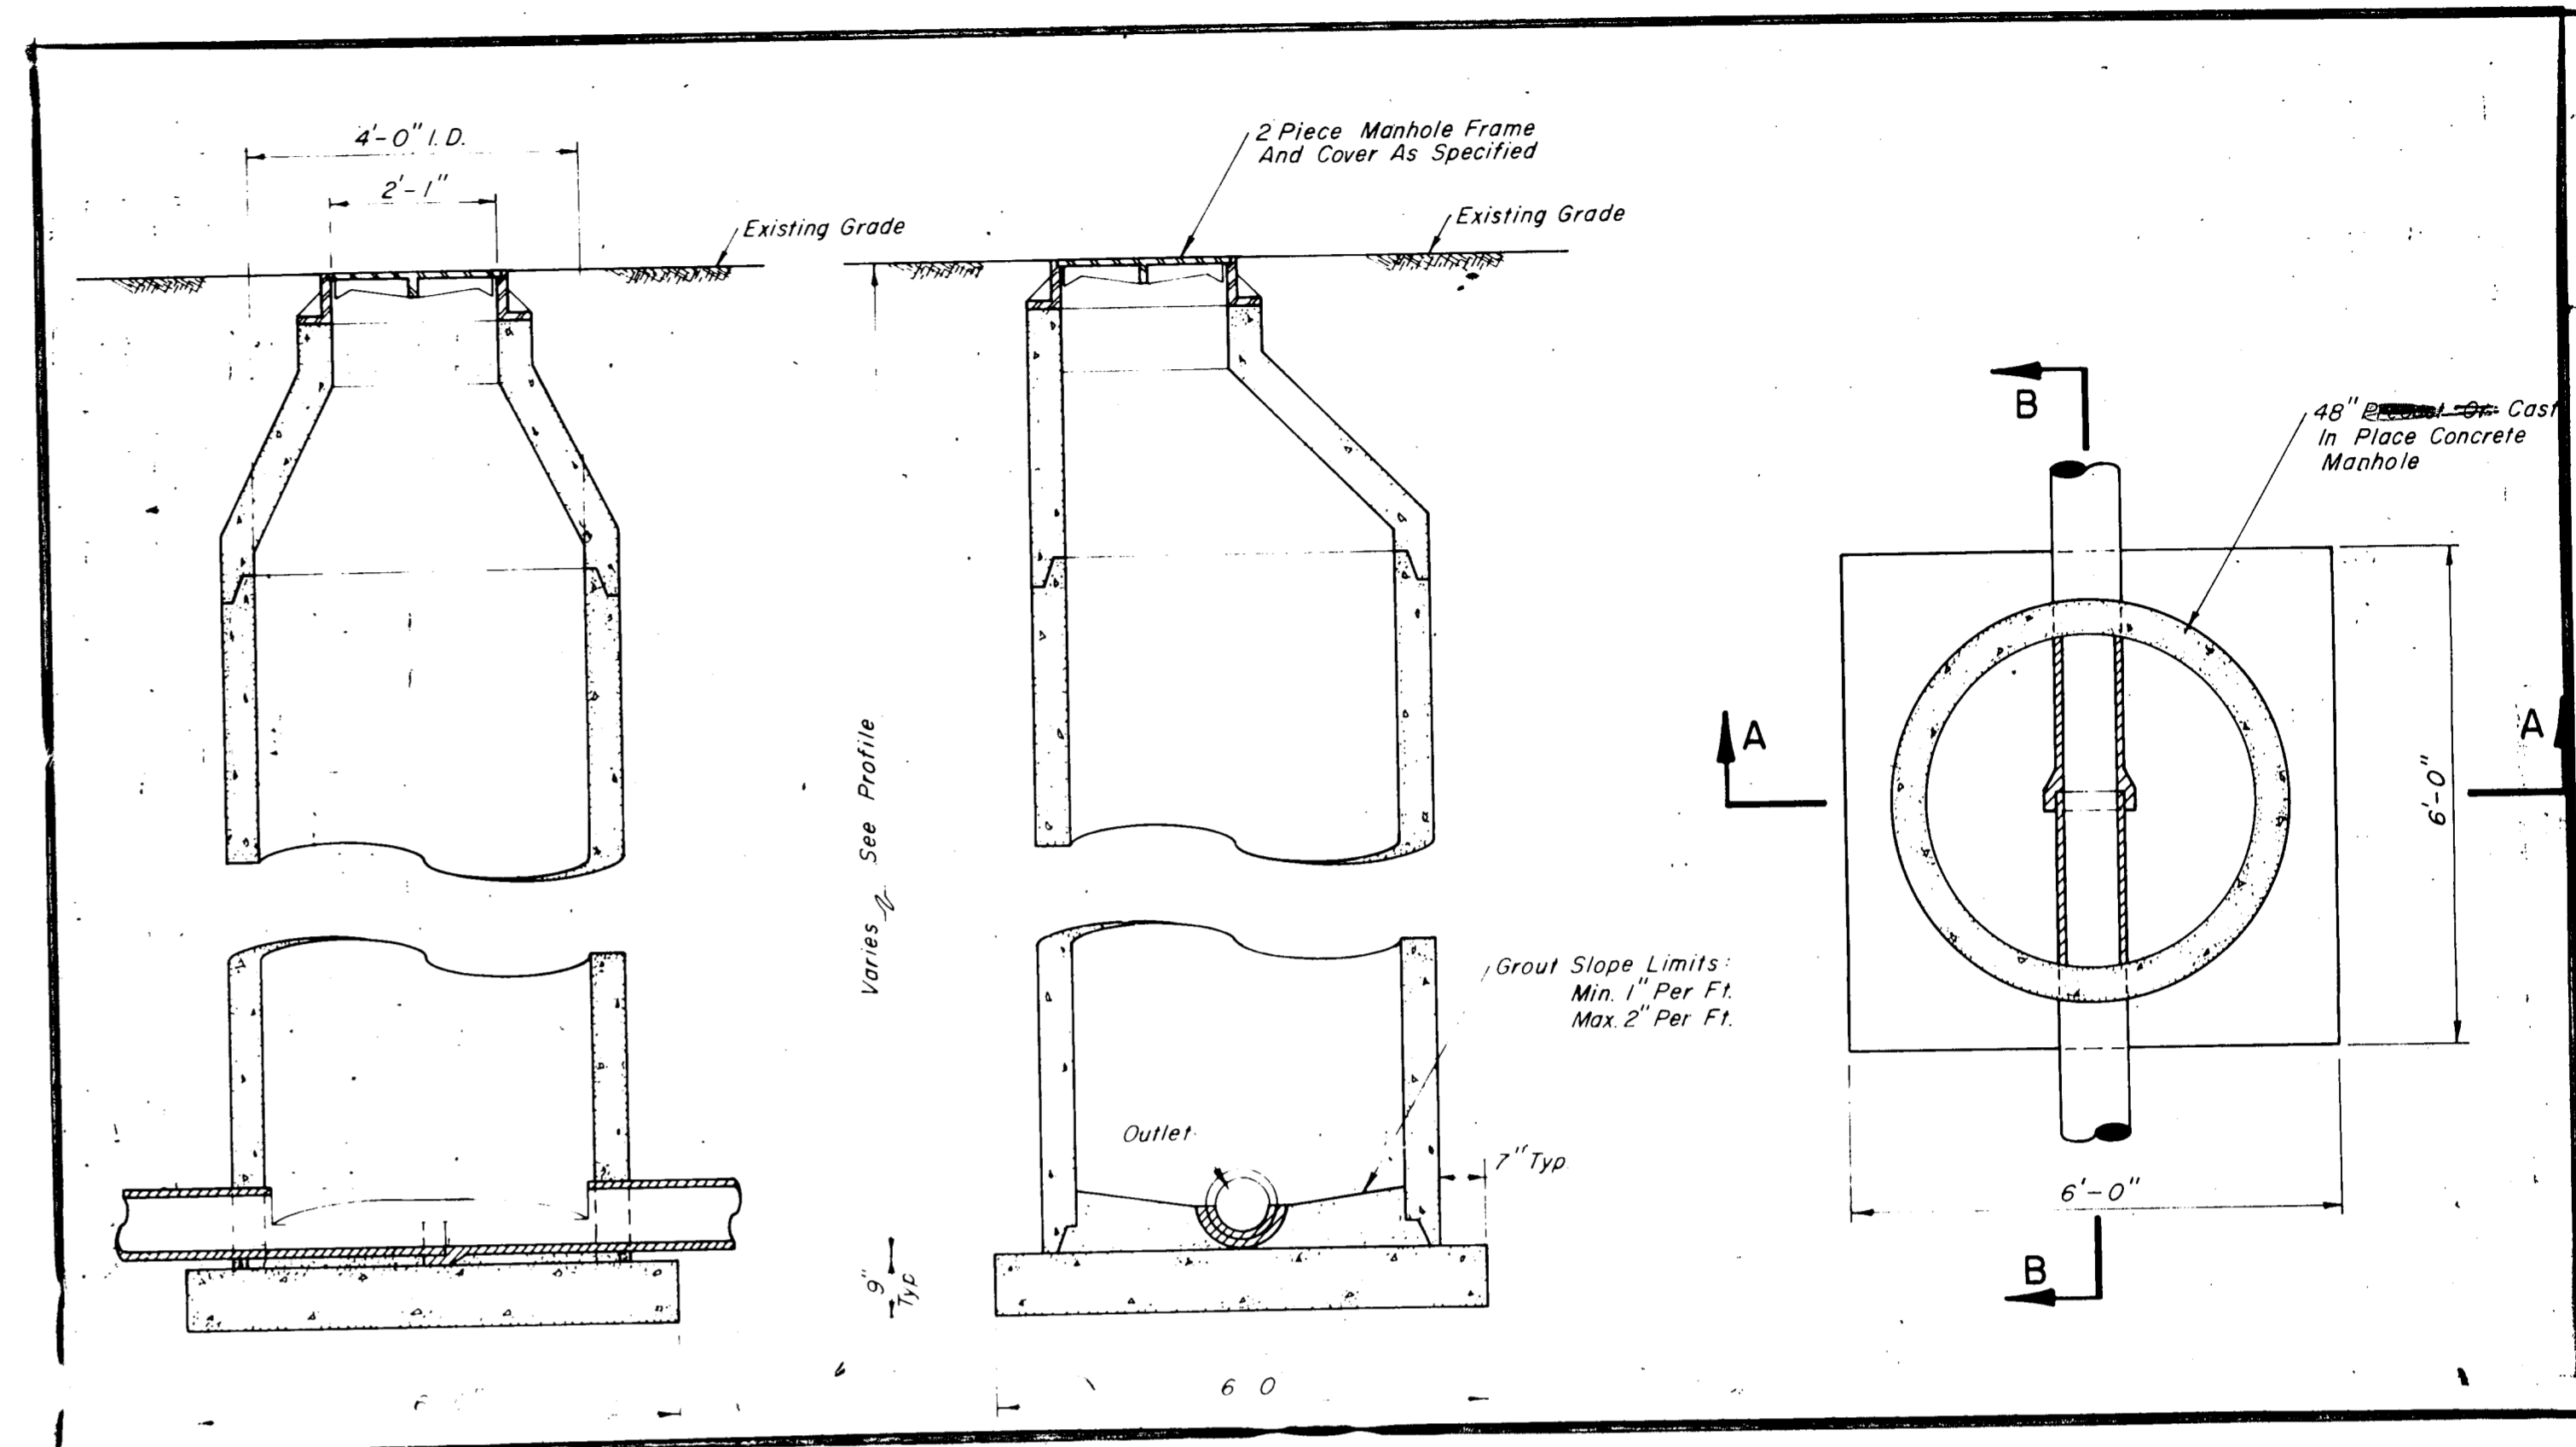

TYPICAL MANHOLE DETAIL

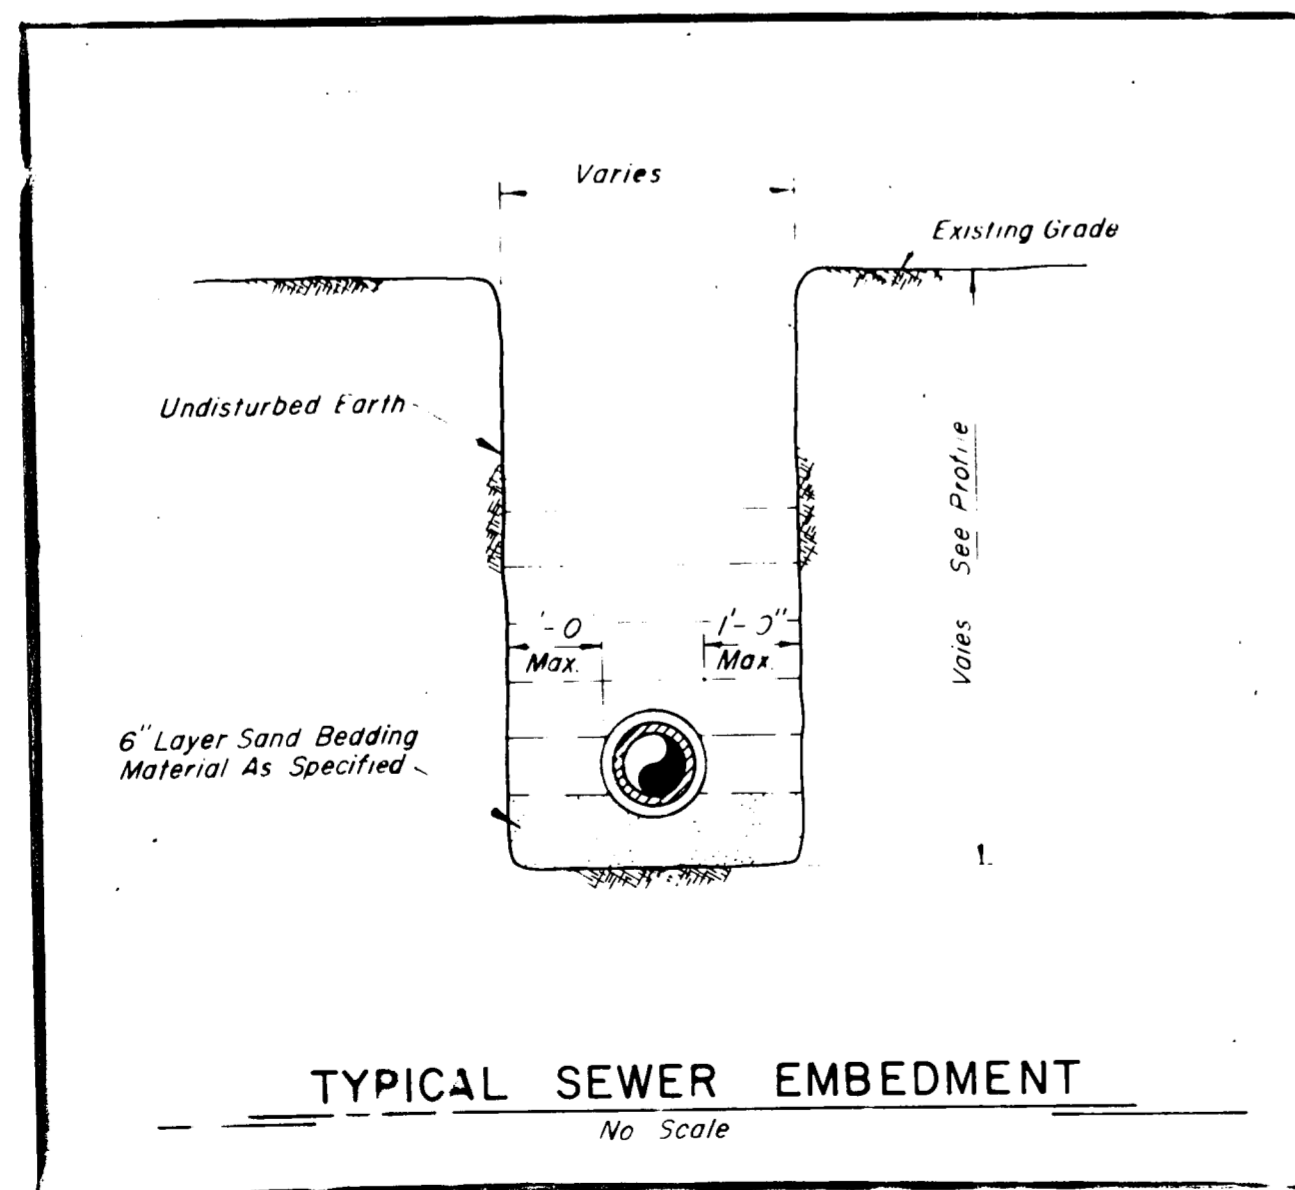


TYPICAL SEWER EMBEDMENT

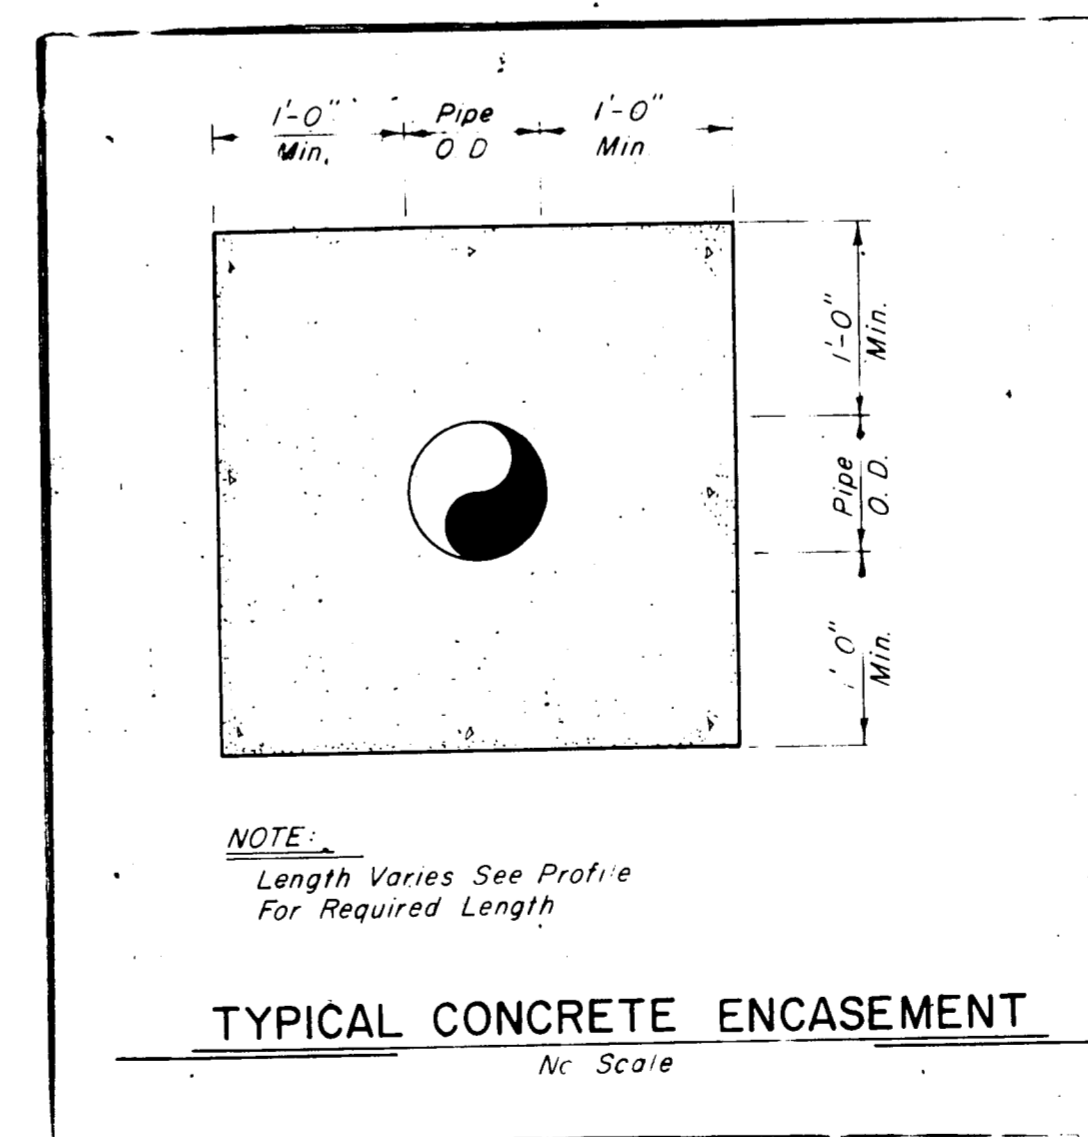

NOTE:
Length Varies See Profile For Required Length

TYPICAL CONCRETE ENCASEMENT

PIPE DIA.			CUBIC YARDS PER 100 L.F.	
I.D.	O.D.	Bd	GRAVEL	GRANULAR MATERIAL
15"	19"	39"	4.53	22.28
18"	22.5"	42"	5.13	25.15
21"	26"	45"	5.76	28.03
24"	29.5"	48"	6.42	30.94
27"	33"	51"	7.11	33.86
30"	37"	54"	7.85	36.72
33"	40.5"	57"	8.59	39.64
36"	44"	60"	9.36	42.58
39"	47.5"	63"	10.16	45.53
42"	51"	66"	10.99	48.51
48"	58"	72"	12.72	54.51

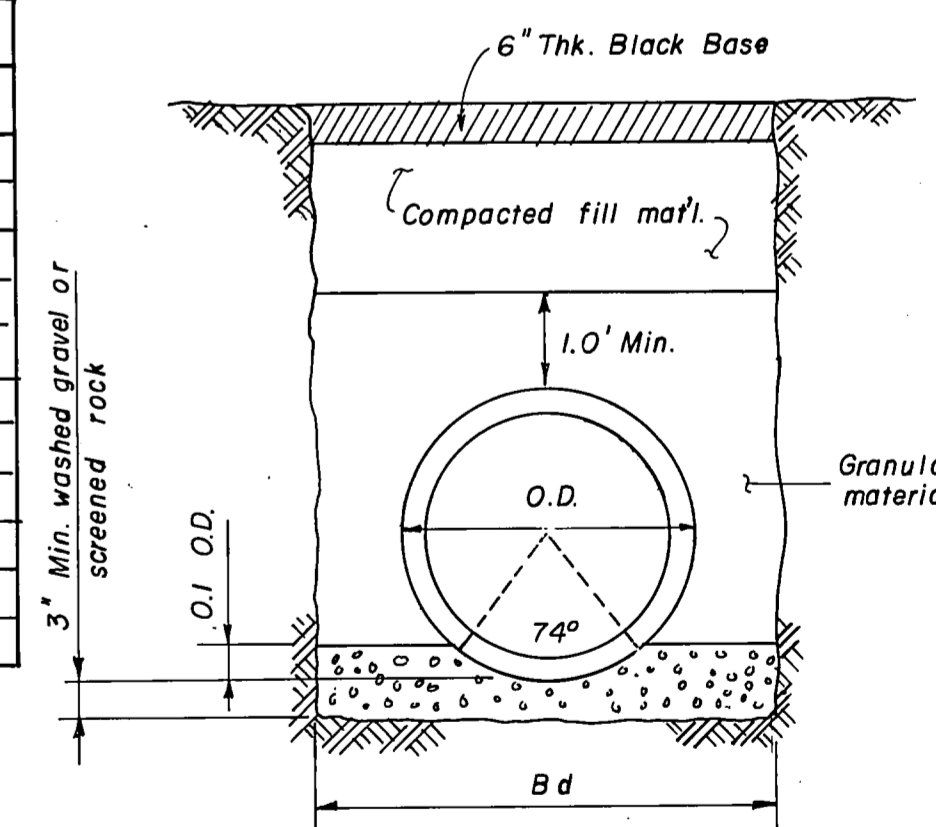

STORM SEWER EMBEDMENT

CITY OF ADDISON





MIDWAY ROAD IMPROVEMENTS

TYPICAL MANHOLE STANDARD DET.

GINN, INC., Consulting Engineers

DESIGNED - R.G.B. DRAWN - R.G.B. DATE - March, 1981


APPROVED - CHECKED - SCALE - None SHEET 35 OF

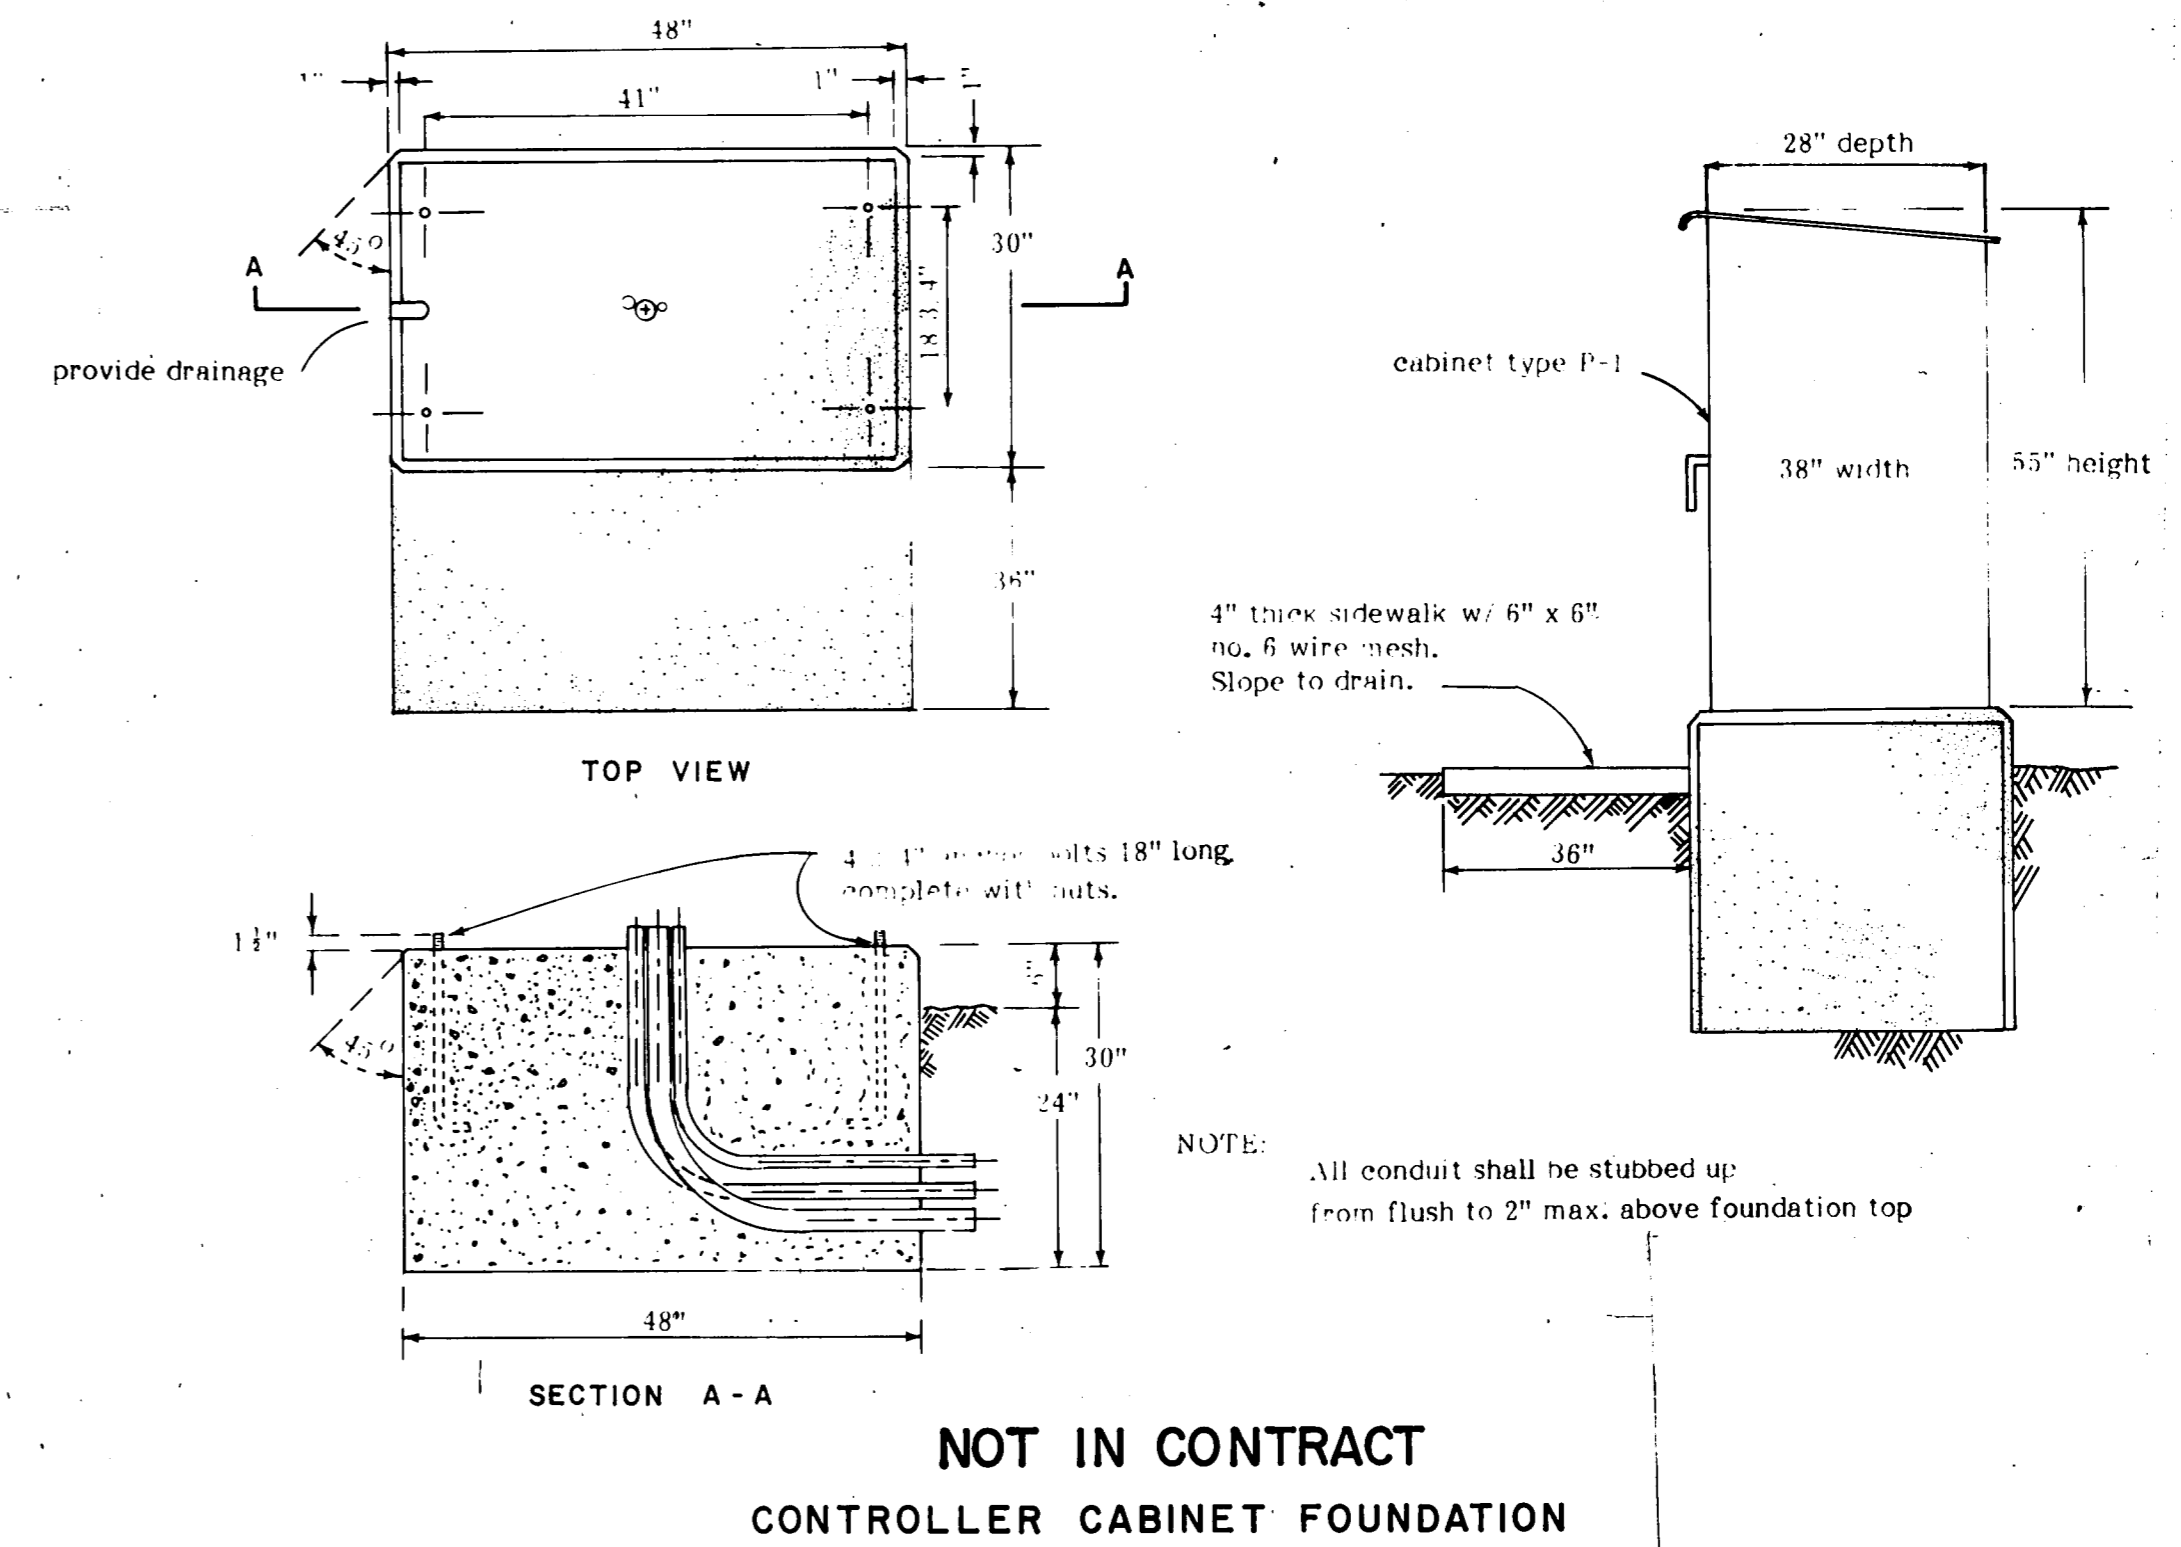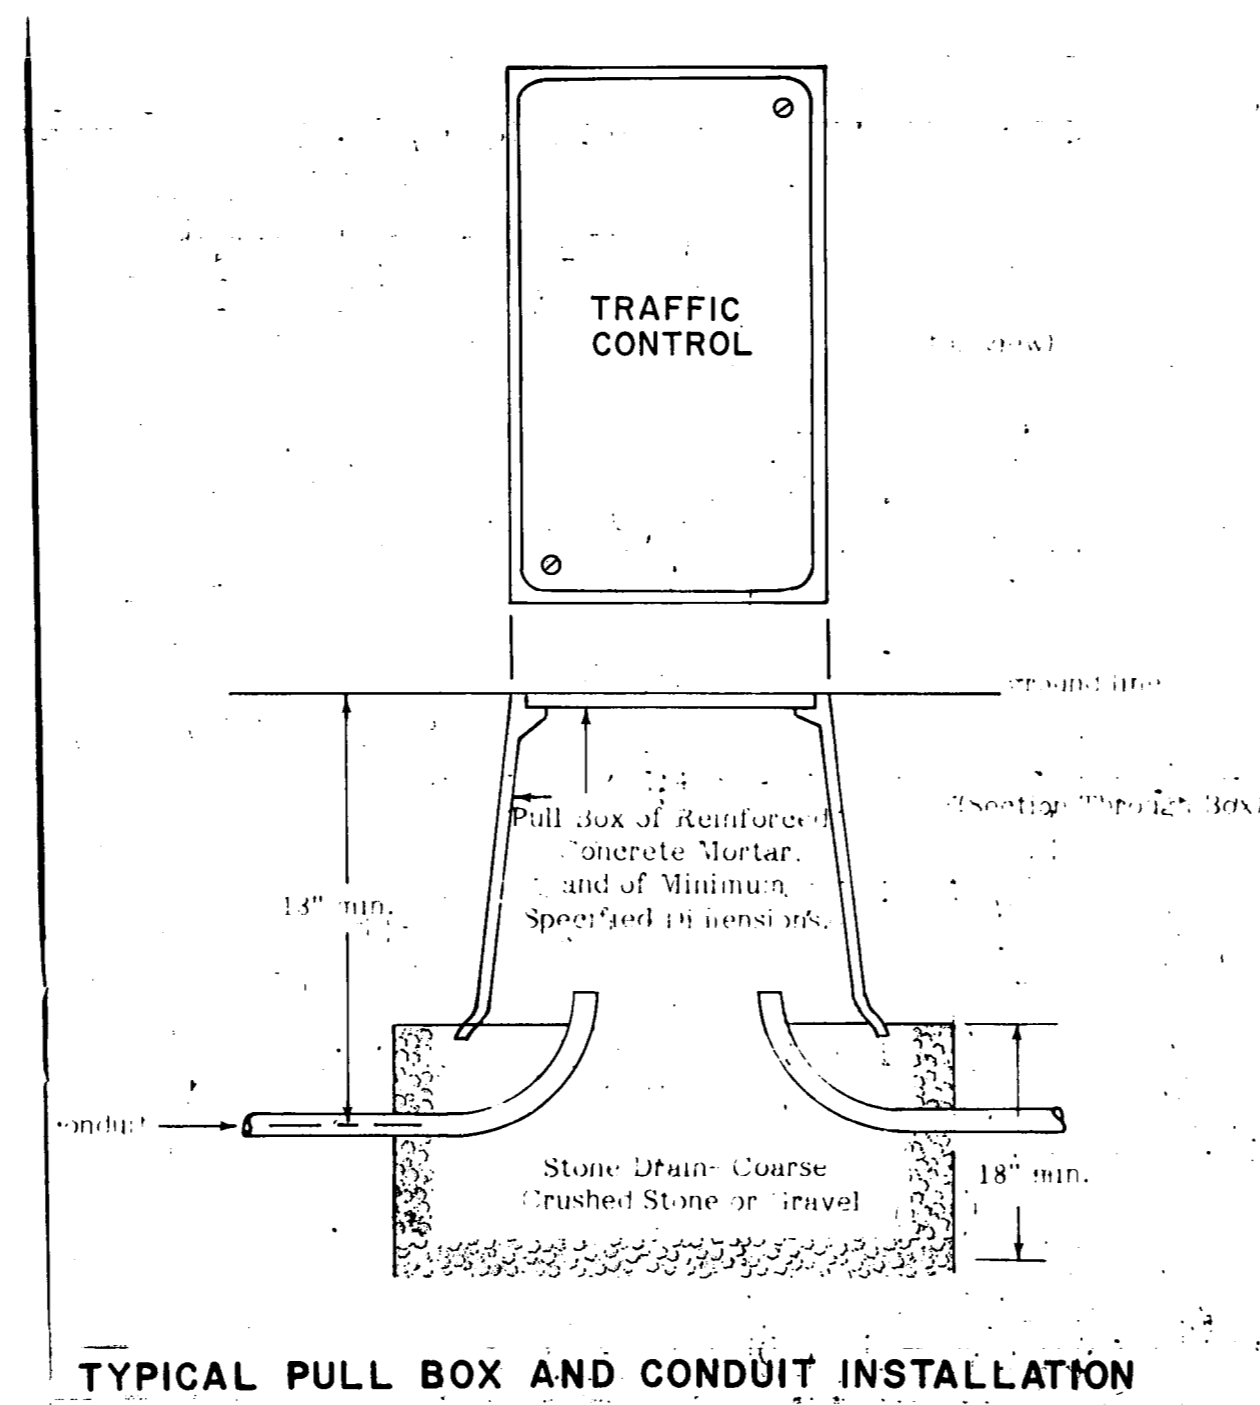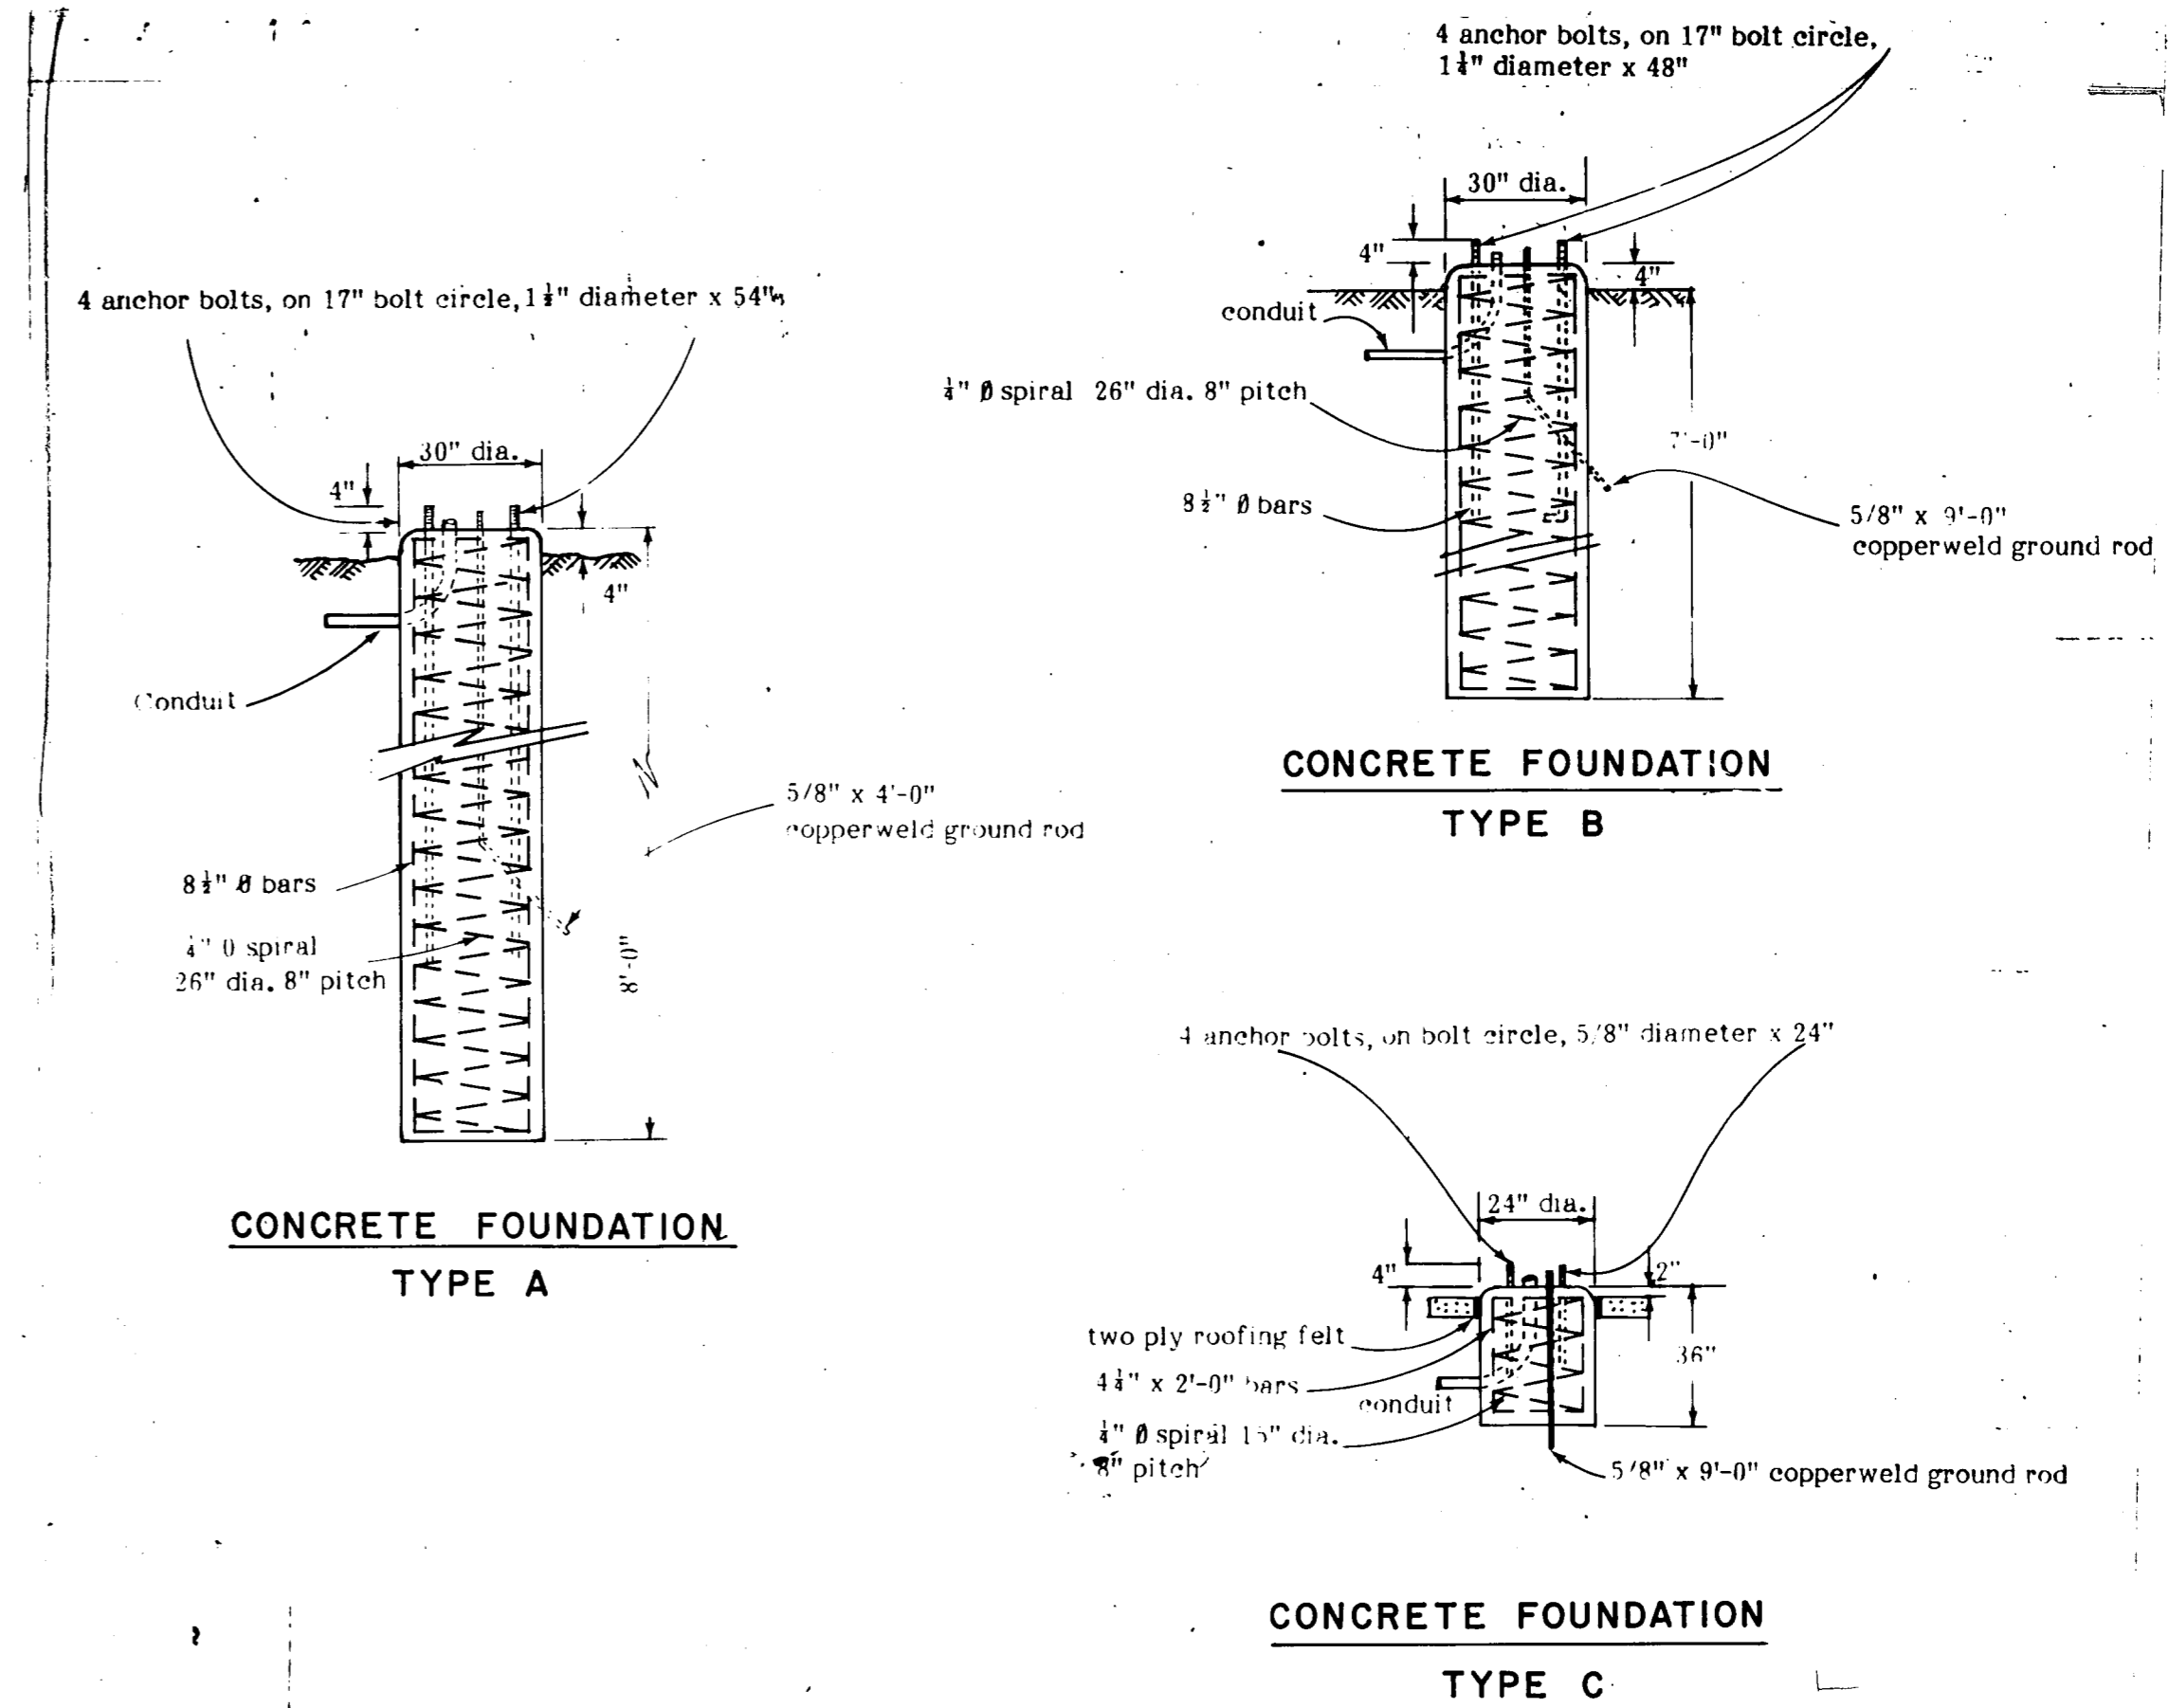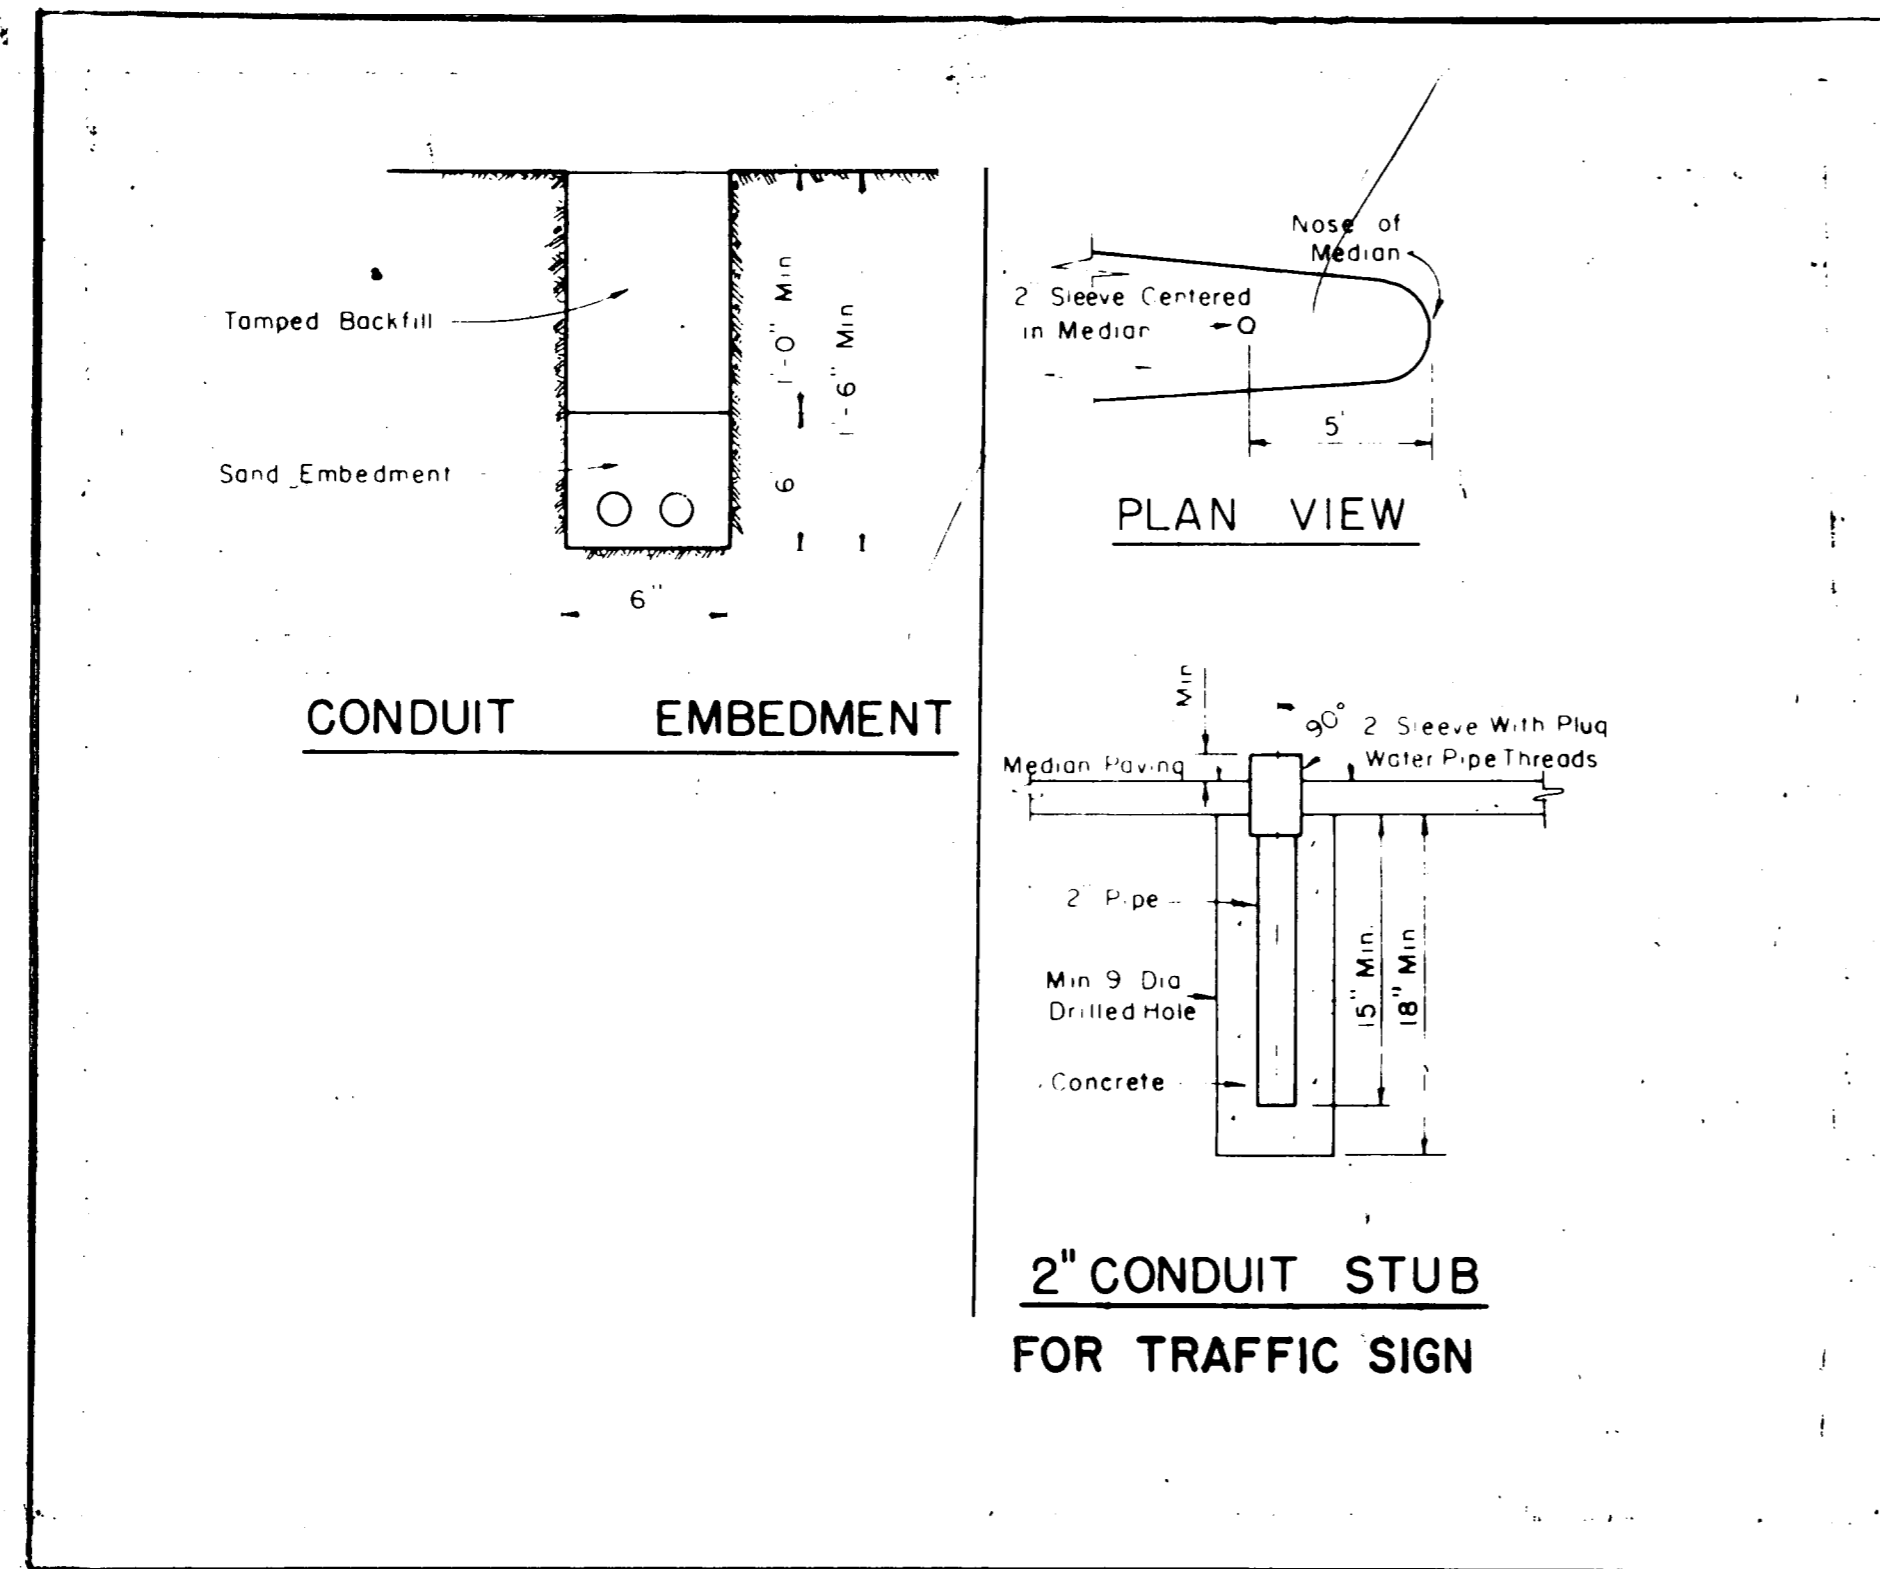


CITY OF ADDISON DALLAS COUNTY, TEXAS			
TYPICAL PULL BOX DETAILS			
GINN, INC. Consulting Engineers - Dallas, Texas			
DESIGNED - H.K.	DRAWN - S.M.M.	DATE - March, 1981	
APPROVED - H.W.G.	CHECKED - H.B.J.	SCALE - NONE	SHEET 36 OF

TABLE OF REINFORCING STEEL FOR 4 WING WALLS


CULVERT SIZE	SLAB DEPTH	MAX WING FULL	WING HEIGHT	WING LENGTH	TOTAL QUANT. 4 WING WALLS		TABLE OF DIMENSIONS		WING SIZE		BARS R		BARS S1		#4 BARS T1 @ 18"		#4 BARS T2 @ 12"		BARS U			#4 BARS P @ 18"		#4 BARS W @ 12"		TOTAL WEIGHT						
					CONC CY	REINF LB	R	W	V	D	Y	Z	L	NO	SIZE	SPAC	LENGTH	WEIGHT	NO	LENGTH	WEIGHT	NO	LENGTH	WEIGHT	NO		LENGTH	WEIGHT	NO	LENGTH	WEIGHT	
3x2	6"	14'	3'-6"	5'-3"	4.10	558	6 1/2"	2'-6"	8"	10'	1'-0"	3'-6"	5'-3"	24 #4	12"	5'-1"	81	24 #4	12"	3'-11"	63	16 #5	18"	6'-0"	100	20 #3	9"	50	28 #8	9"	164	538
3x3	6"	14'	4'-6"	6'-9"	6.11	818	7"	2'-10"	8"	1'-2"	1'-0"	4'-6"	6'-9"	32 #4	11"	6'-1"	130	32 #4	11"	4'-3"	91	24 #5	18"	6'-0"	150	24 #4	9"	76	28 #11	3"	210	796
4x2	6"	12'	3'-6"	5'-3"	4.21	564	6 1/2"	2'-6"	8"	10'	1'-0"	5'-6"	8'-3"	60 #4	7"	7'-3"	291	60 #4	7"	4'-10"	194	32 #5	18"	6'-0"	200	32 #6	9"	144	36 #15	9"	379	1833
4x3	6"	12'	4'-6"	6'-9"	6.23	824	7"	2'-10"	8"	1'-2"	1'-0"	6'-6"	9'-9"	56 #5	8 1/2"	8'-5"	492	60 #5	8"	5'-5"	339	32 #5	18"	6'-0"	200	32 #6	9"	144	36 #17	3"	415	2560
4x4	6"	12'	5'-6"	8'-3"	8.75	1322	7"	3'-5"	8"	1'-7"	1'-2"	7'-6"	11'-3"	80 #5	7"	9'-10"	820	80 #5	7"	6'-1"	507	40 #5	18"	6'-0"	300	36 #7	9"	186	36 #18	3"	505	3581
5x2	6"	8'	3'-6"	5'-3"	4.33	569	7"	2'-6"	8"	10'	1'-0"	8'-6 1/2"	12'-10"	112 #5	5 1/2"	11'-4"	1324	104 #5	6"	6'-7"	714	48 #5	18"	6'-0"	300	40 #8	9"	234	40 #18	3"	5137	
5x3	6"	8'	4'-6"	6'-9"	6.34	829	7"	2'-10"	8"	1'-2"	1'-0"	9'-6 1/2"	14'-4"	108 #6	6 1/2"	12'-9"	2068	116 #6	6"	7'-4"	1277	48 #5	18"	6'-0"	300	44 #9	9"	287	44 #20	6"	603	5137
5x4	6"	8'	5'-6"	8'-3"	8.87	1328	7"	3'-5"	8"	1'-7"	1'-2"	10'-7"	15'-10"	140 #6	5 1/2"	14'-4"	3013	140 #6	5 1/2"	7'-1"	1665	56 #5	18"	6'-0"	350	48 #10	10"	347	44 #22	0"	647	6772
5x5	6"	8'	6'-6"	9'-9"	11.86	1876	7"	4'-0"	8"	2'-0"	1'-4"	11'-7"	17'-4"	168 #6	5"	15'-9"	3974	168 #6	5"	8'-7"	2165	64 #5	18"	6'-0"	401	52 #11	10"	411	48 #23	6"	754	8618

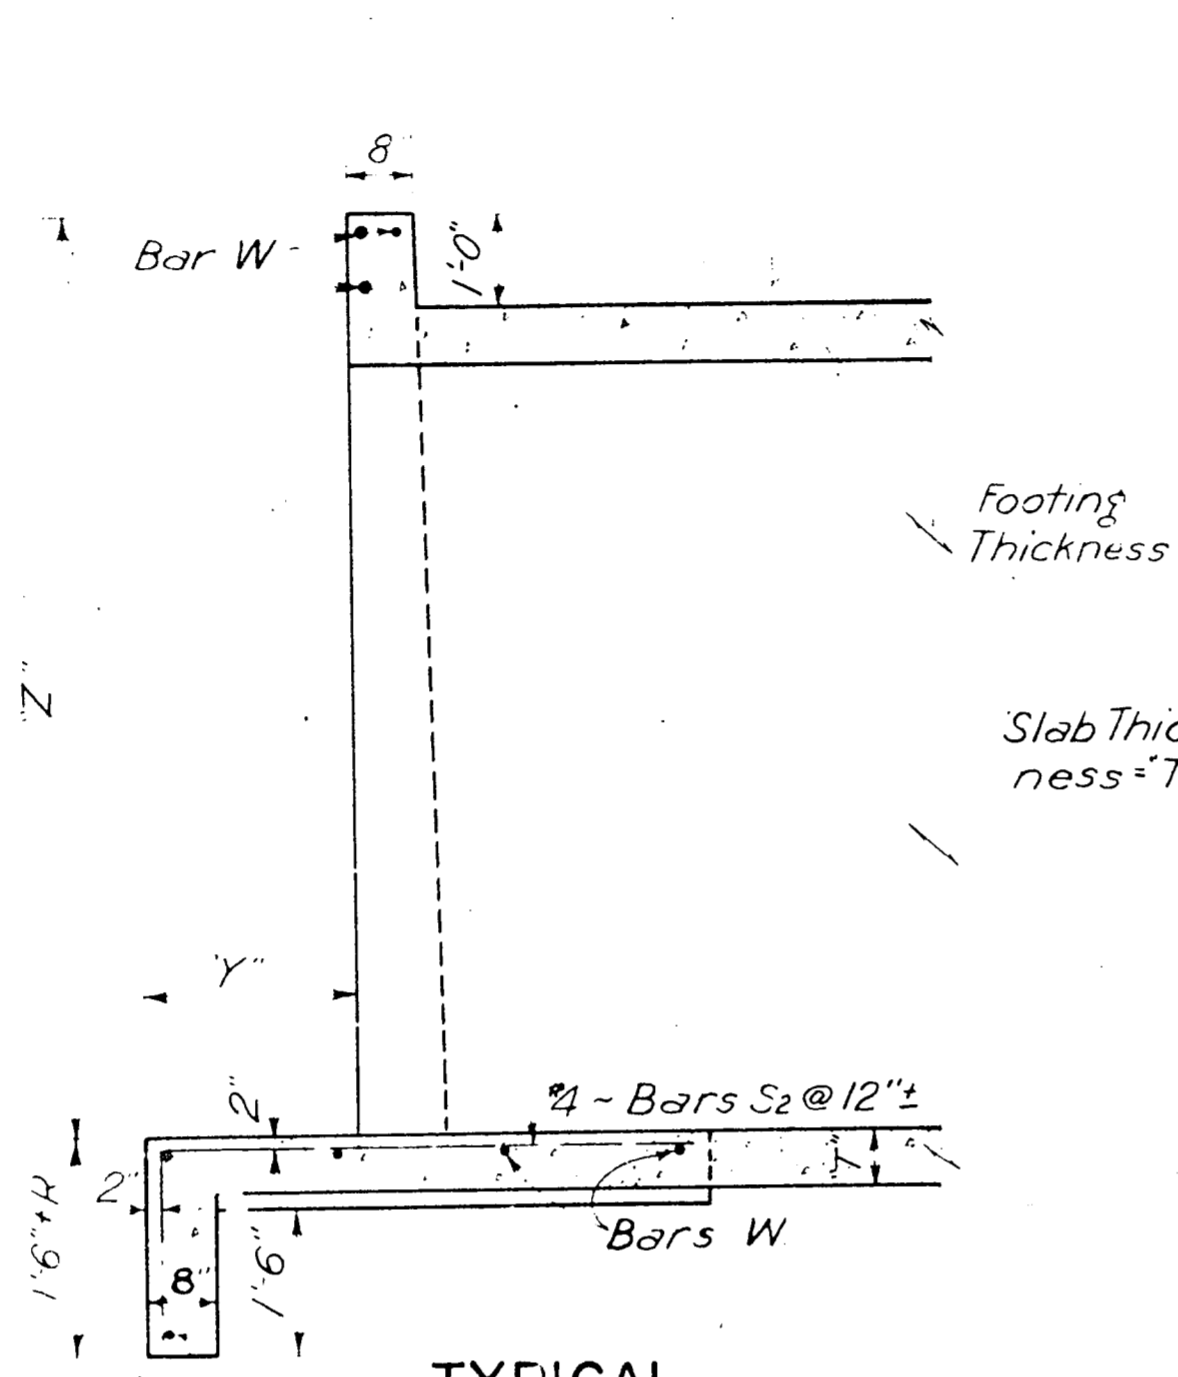


TYPICAL LONGITUDINAL SECTION THRU BOX SHOWING DETAIL OF APRON

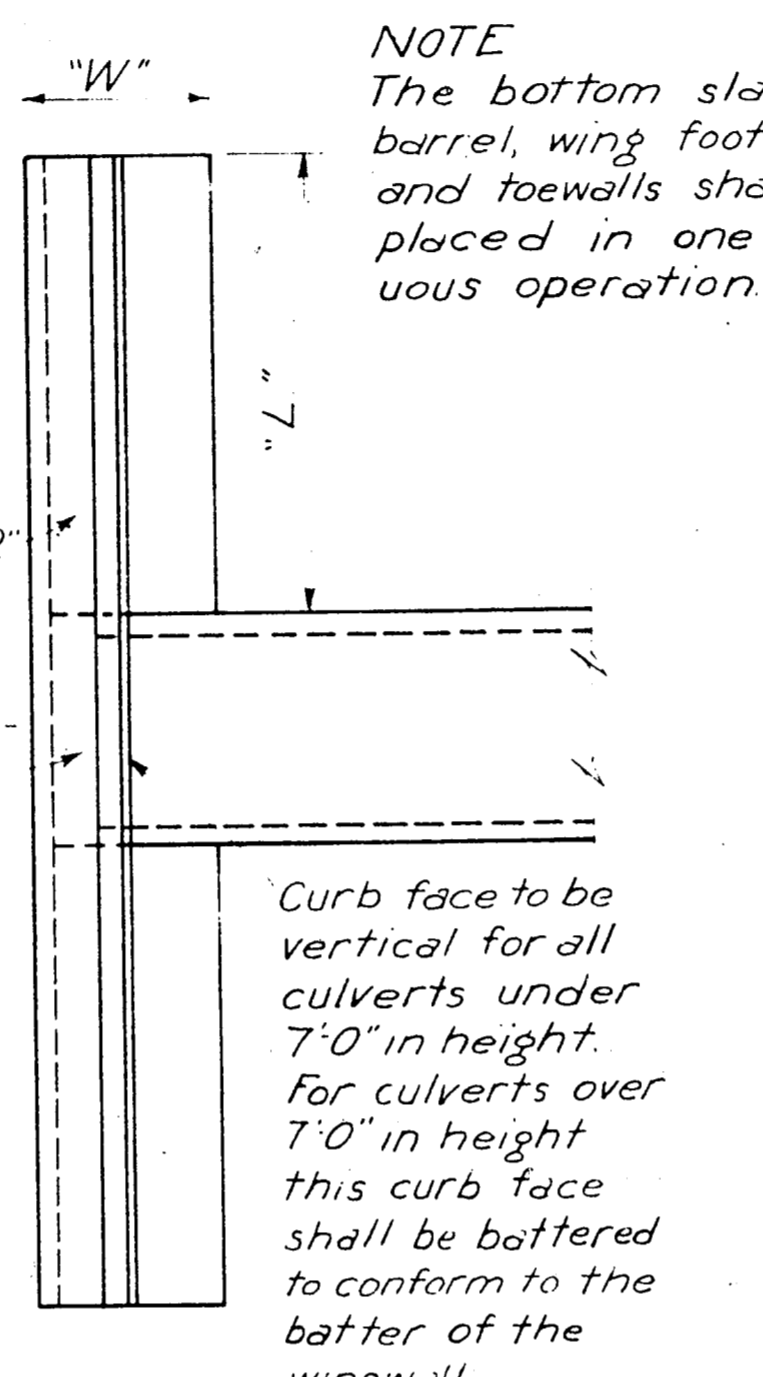

PLAN VIEW OF WING WALL

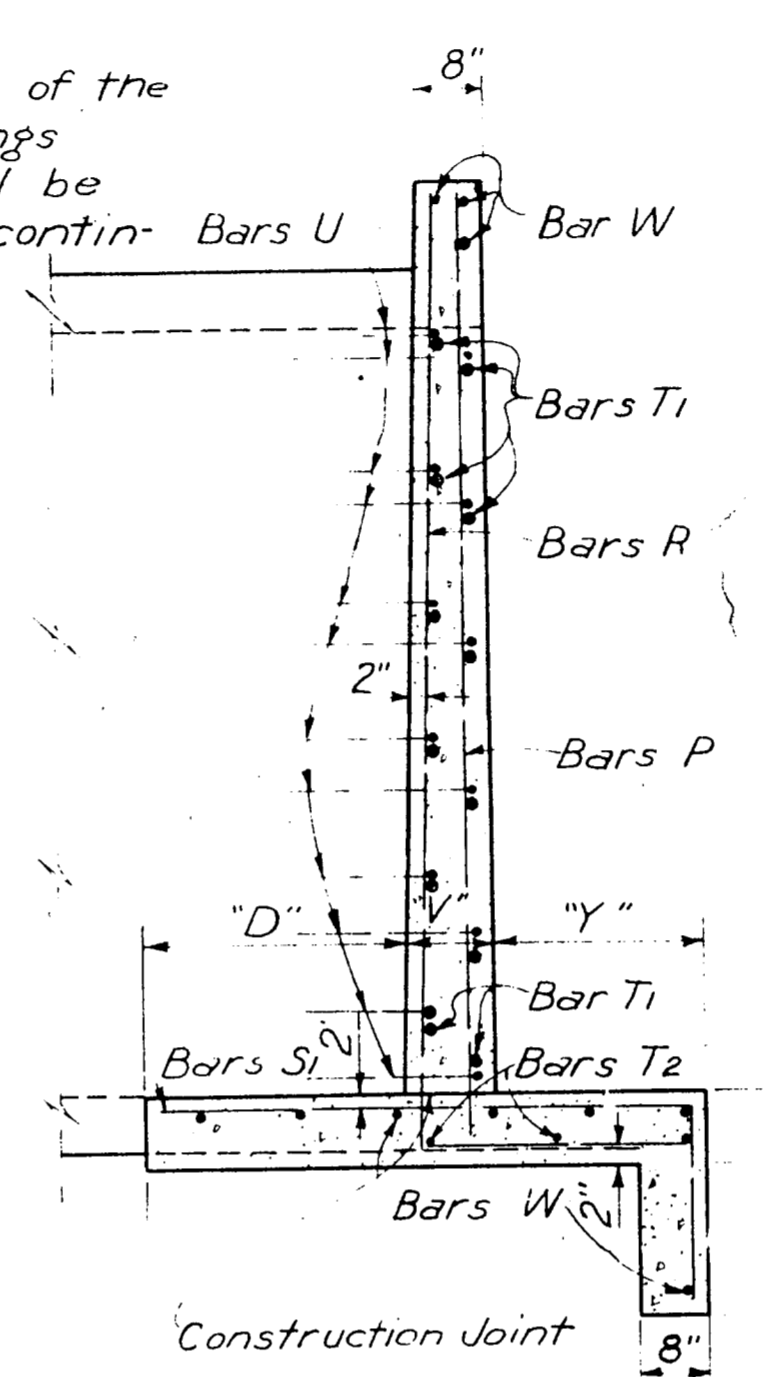

SECTION

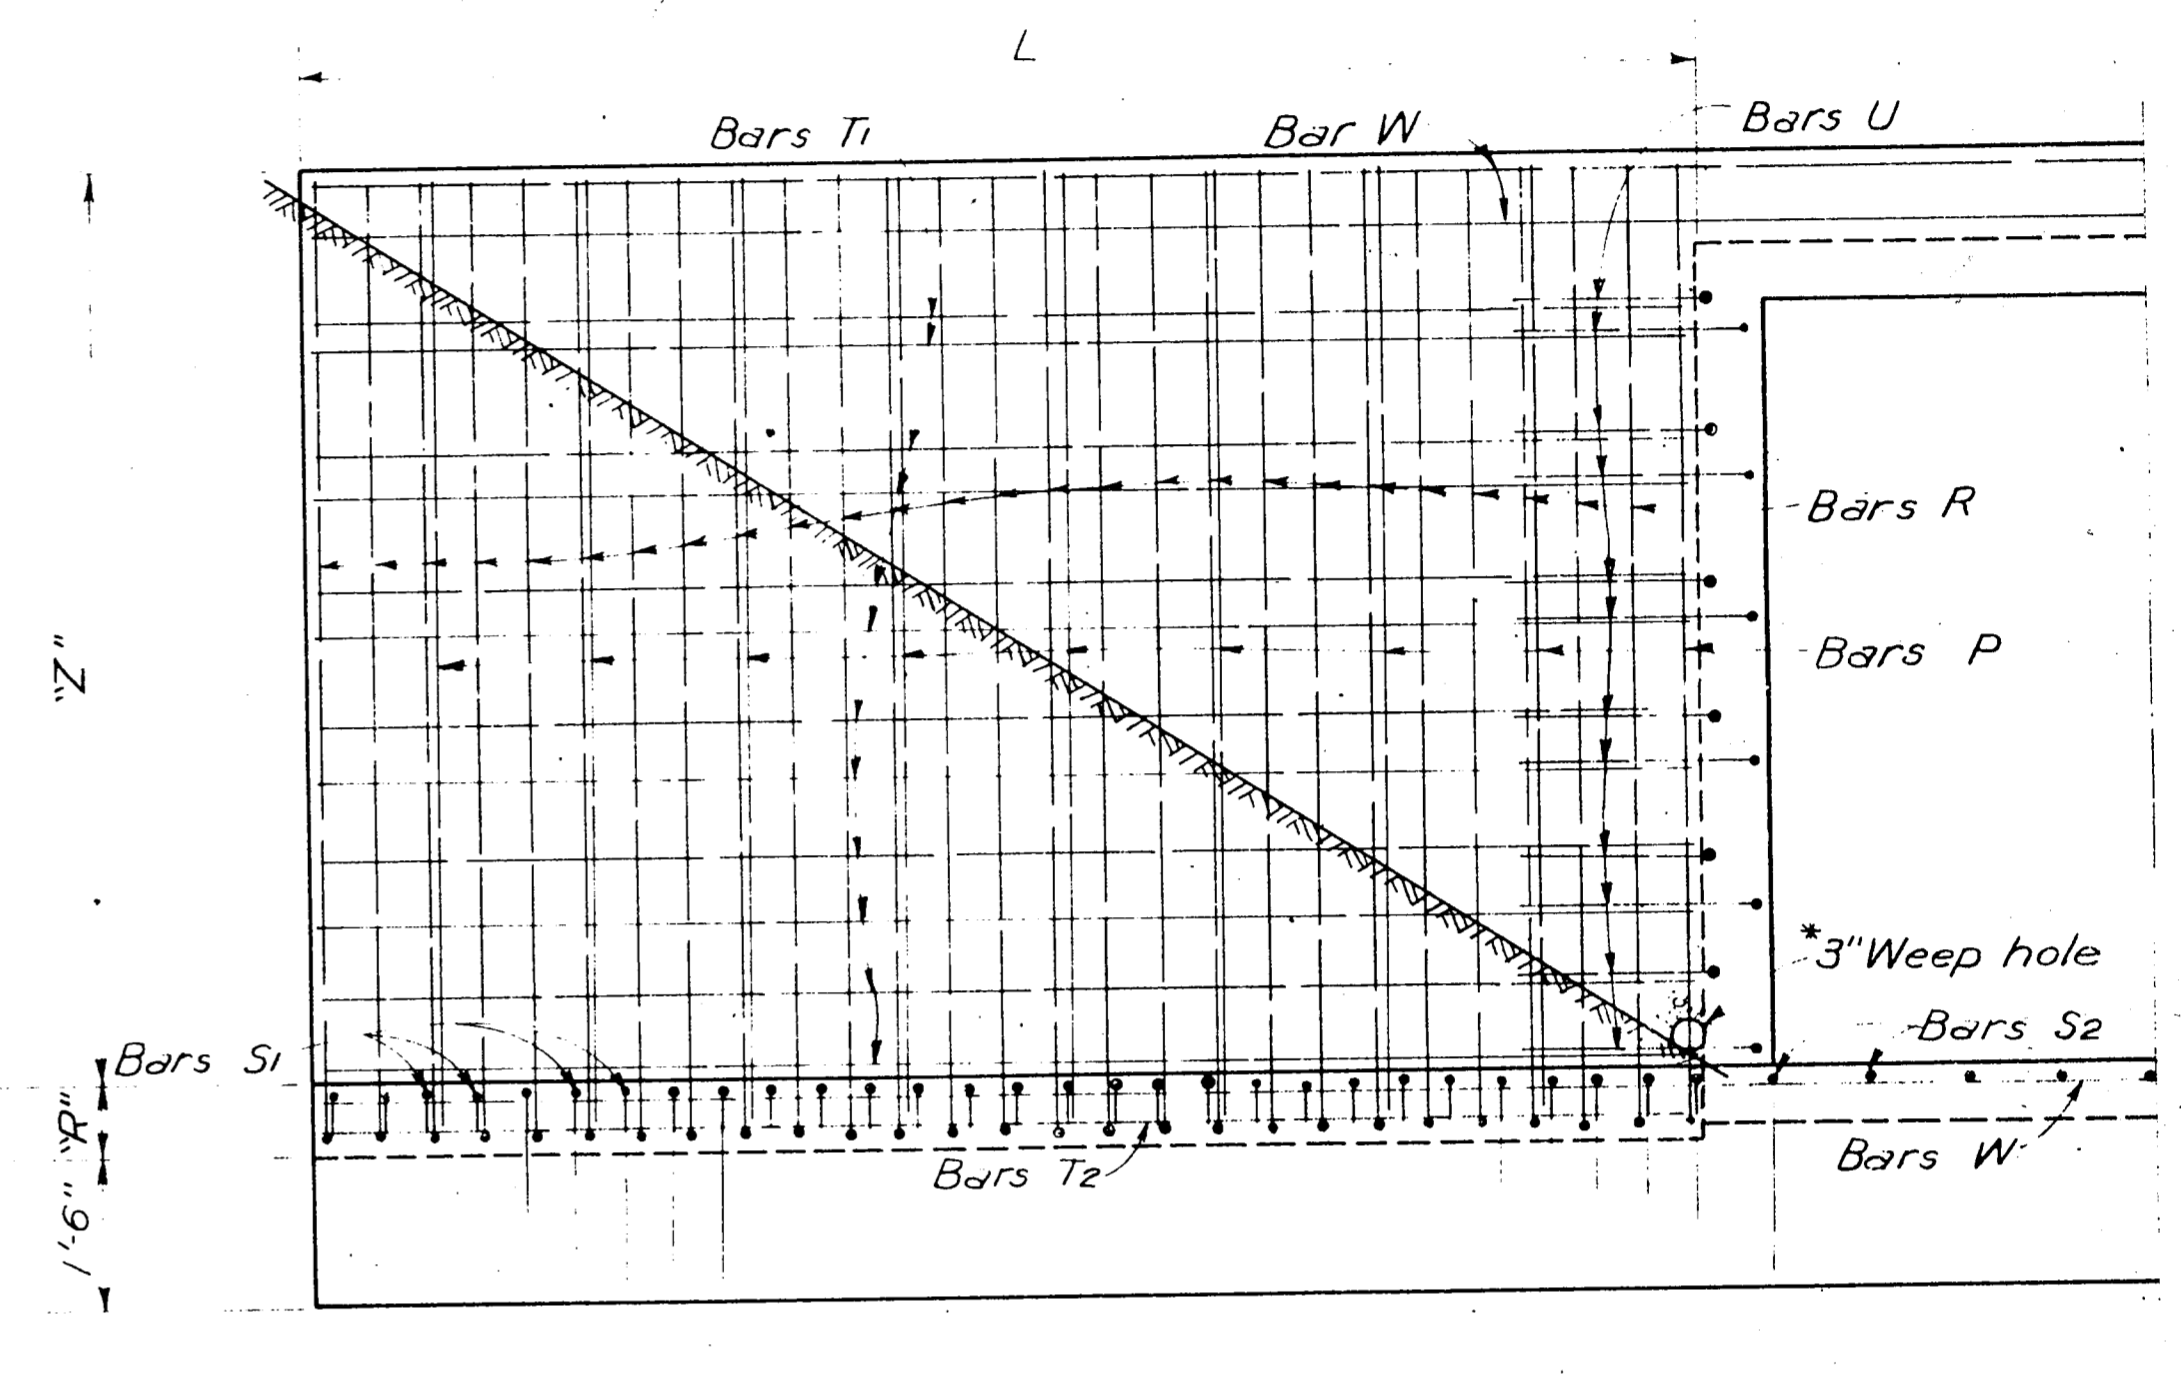


DETAIL OF WING WALL HALF ELEVATION

GENERAL NOTES:
 All concrete shall be Class C. Chamfer all exposed corners 3" unless specified otherwise.
 All dimensions relating to reinforcing steel are to centers of bars.

*Place one weep hole per wing at approximate earth line as shown. Fill around inlet of drains with broken stone or coarse gravel to permit free passage of water. Weep holes required for Z=6'-6" and greater.

Z	BARS R	BARS S1	BARS T1	BARS S2 (Culvert Apron)
3'-9" (Z=3'-6")	1'-4" (Z=3'-6")	2'-4"	2'-2" (Z=3'-6")	2'-2" (Z=3'-6")
4'-9" (Z=4'-6")	1'-4" (Z=4'-6")	2'-4"	2'-6" (Z=4'-6")	2'-6" (Z=4'-6")
5'-9" (Z=5'-6")	1'-6" (Z=5'-6")	2'-4"	3'-1" (Z=5'-6")	3'-1" (Z=5'-6")
6'-9" (Z=6'-6")	1'-8" (Z=6'-6")	2'-4"	3'-8" (Z=6'-6")	3'-8" (Z=6'-6")
7'-9" (Z=7'-6")	2'-1" (Z=7'-6")	2'-4"	4'-4" (Z=7'-6")	4'-4" (Z=7'-6")
9'-0"	2'-3'-6" to 7'-6"	2'-4"	4'-10" (Z=8'-6 1/2")	4'-10" (Z=8'-6 1/2")
10'-0"		2'-4"	5'-5" (Z=9'-6 1/2")	5'-5" (Z=9'-6 1/2")
11'-2"		2'-4"	6'-0" (Z=10'-7")	6'-0" (Z=10'-7")
12'-3"		2'-4"	6'-8" (Z=11'-7")	6'-8" (Z=11'-7")

5'-0"	1'-6" (Z=5'-6")	2'-4"	3'-1" (Z=5'-6")	3'-1" (Z=5'-6")
6'-0"	1'-8" (Z=6'-6")	2'-4"	3'-8" (Z=6'-6")	3'-8" (Z=6'-6")
7'-0"	2'-1" (Z=7'-6")	2'-4"	4'-4" (Z=7'-6")	4'-4" (Z=7'-6")
8'-0"		2'-4"	4'-10" (Z=8'-6 1/2")	4'-10" (Z=8'-6 1/2")
9'-0"		2'-4"	5'-5" (Z=9'-6 1/2")	5'-5" (Z=9'-6 1/2")
10'-0"		2'-4"	6'-0" (Z=10'-7")	6'-0" (Z=10'-7")
11'-0"		2'-4"	6'-8" (Z=11'-7")	6'-8" (Z=11'-7")

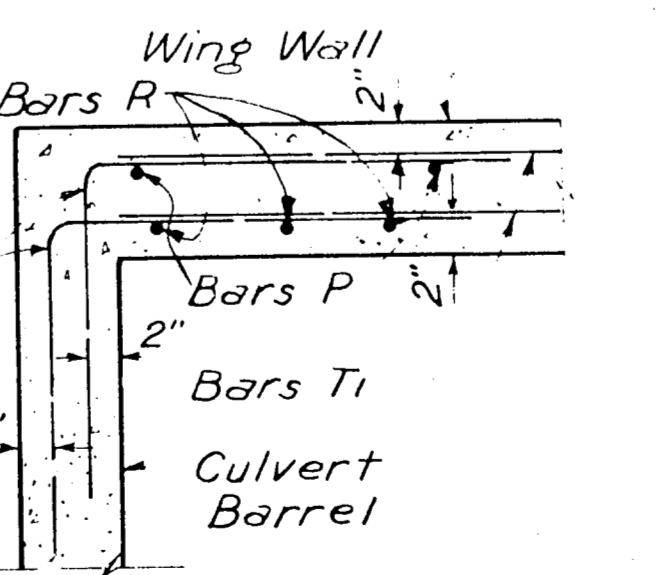

ARRANGEMENT OF WING WALL REINF. AT CULVERT WALL

TEXAS HIGHWAY DEPARTMENT
PARALLEL WINGS-NORMAL
 FOR SINGLE BOX CULVERTS
 3 X 2 TO 10 X 10

PWN




DESIGNED BY	DATE	REVISED BY	DATE	STATE	FEDERAL AID PROJECT NO.	SHEET NO.
W. H. WILSON	June 1948	W. H. WILSON	June 1948	TEXAS		
DR. A. B. L.	Rev Oct 1958	DR. A. B. L.	Rev Oct 1958			
DR. W. H. WILSON	Rev Jan 1959	DR. W. H. WILSON	Rev Jan 1959			
DR. A. B. L.	Rev Nov 1964	DR. A. B. L.	Rev Nov 1964			

PLAN
 NOTE BOOK NO.

PROFILE
 NOTE BOOK NO.

BILLS OF REINFORCING STEEL FOR 44'-0" CLEAR WIDTH

Main table with columns for Culvert Size, Section, Dimensions, Total Quantities, and various Bar types (A, B, C, D, E, F, H, K, M, N) with their respective lengths and weights.

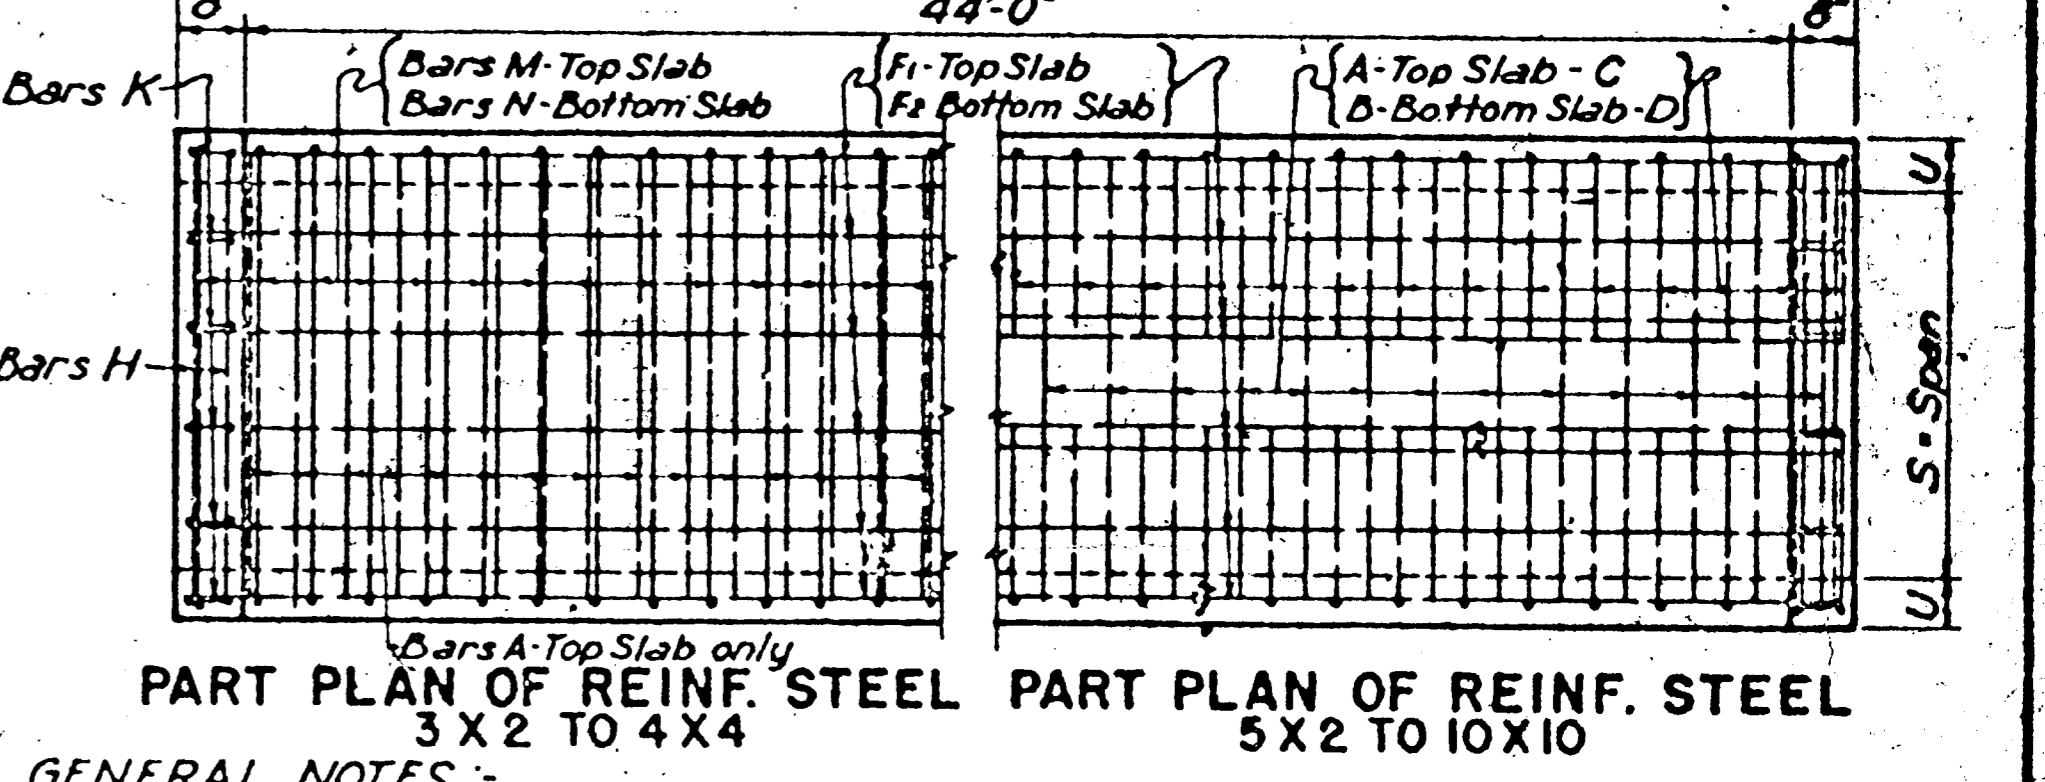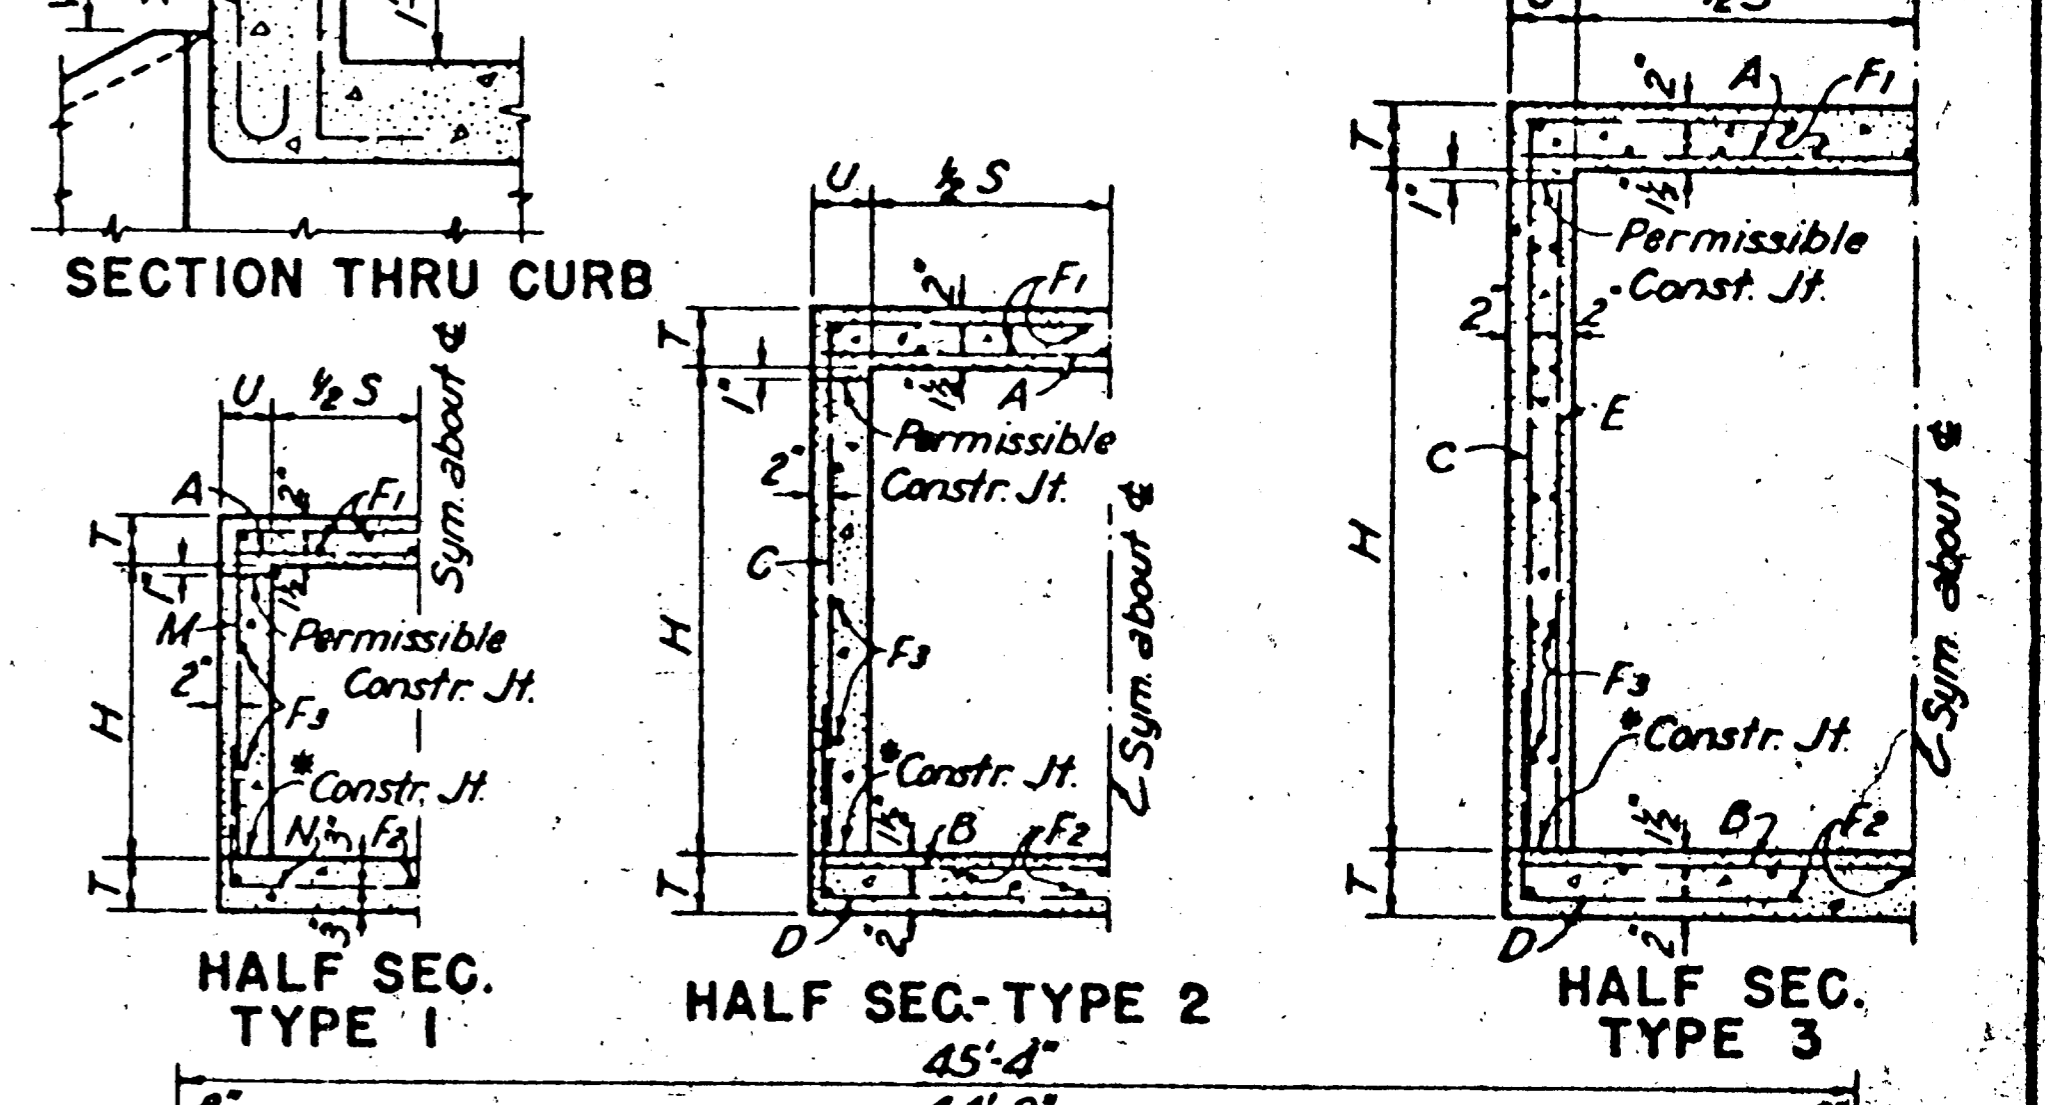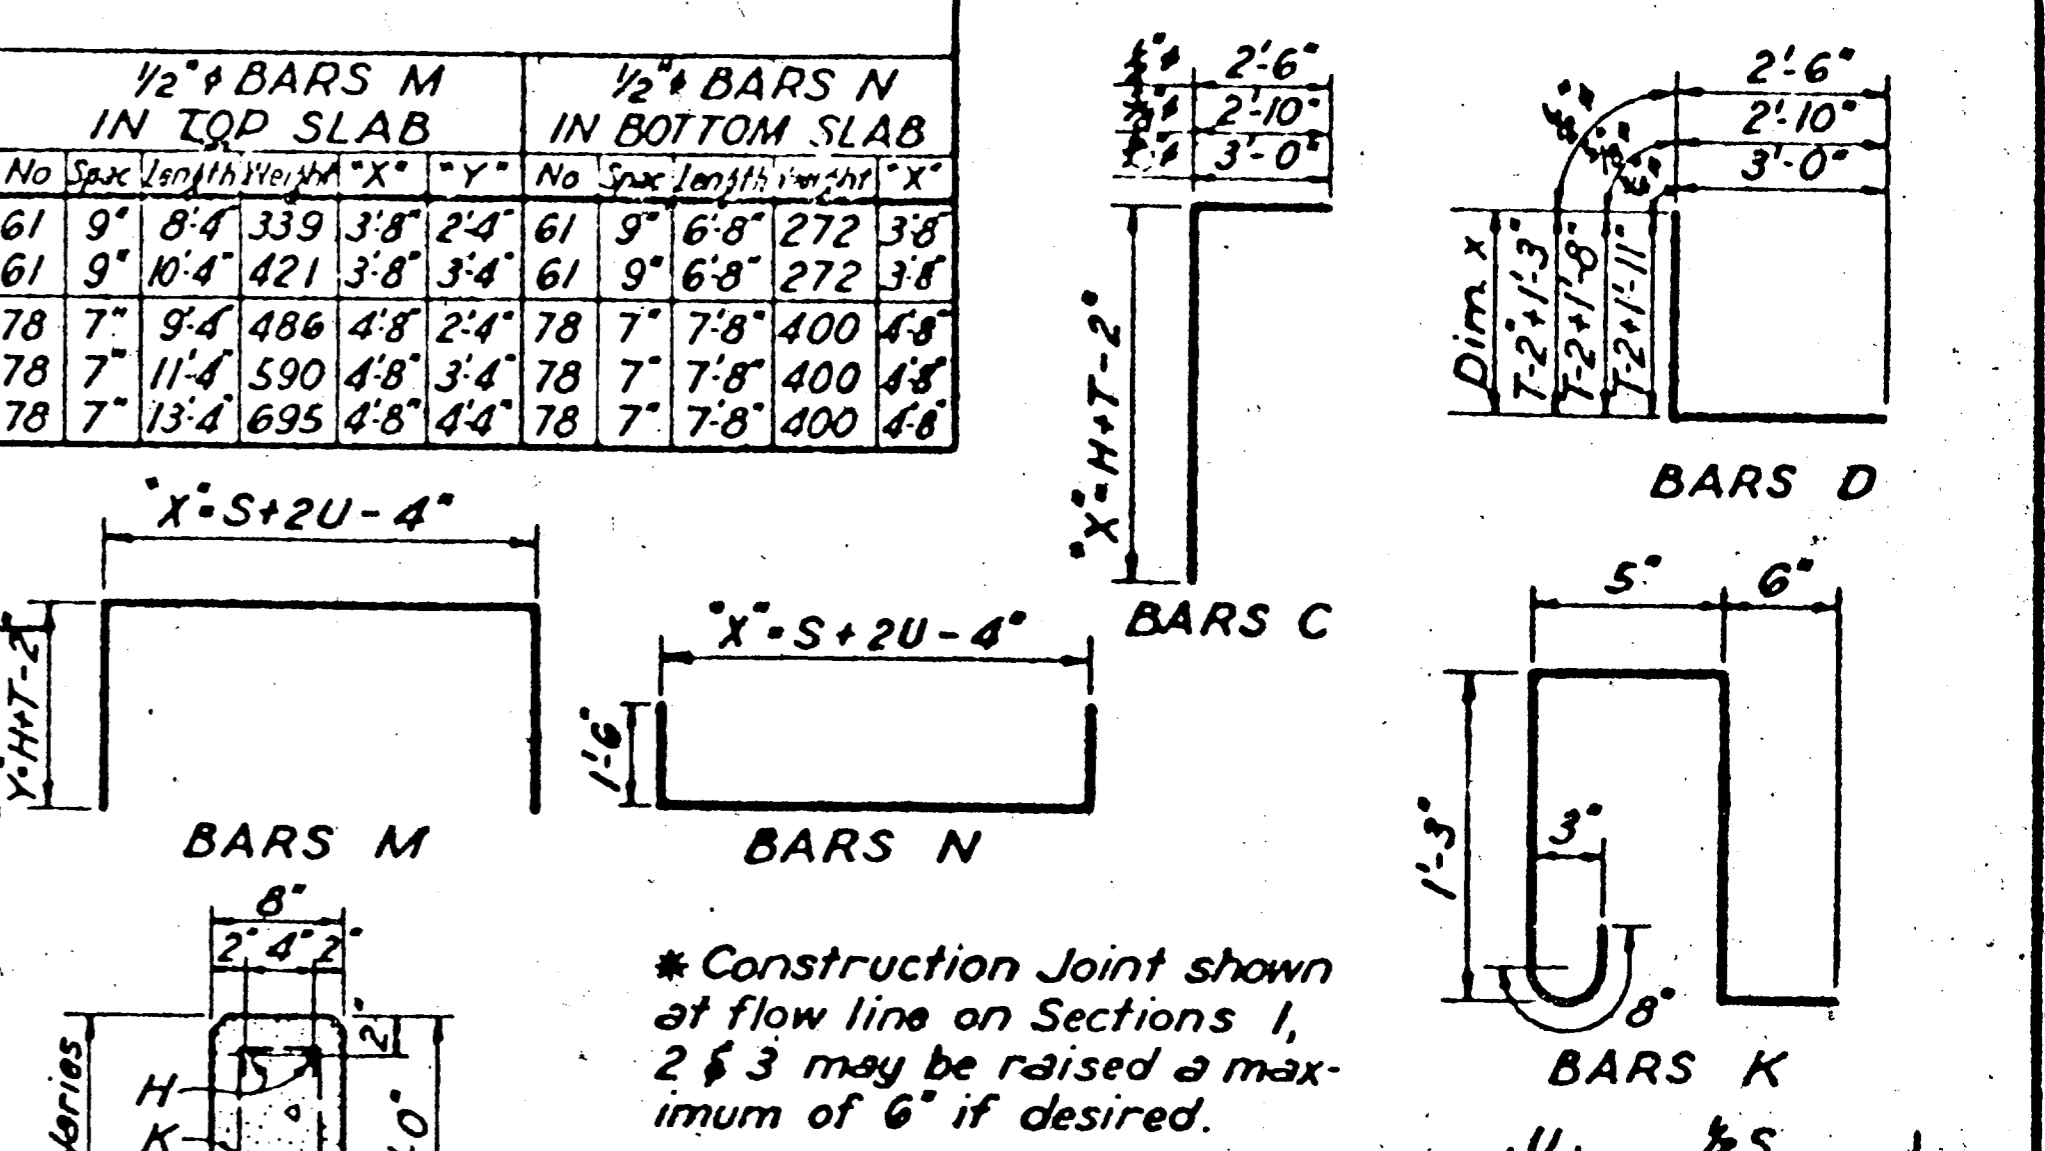


GENERAL NOTES: Design: H20 or H20-S16 Loading in accordance with A.A.S.H.O. 1944 Standard Specifications and revisions thereto.

Texas Highway Department SINGLE CULVERTS-NORMAL 3' X 2' TO 10' X 10' DIRECT TRAFFIC TO 8'-0" FILL



BILL OF STEEL- END SECTION


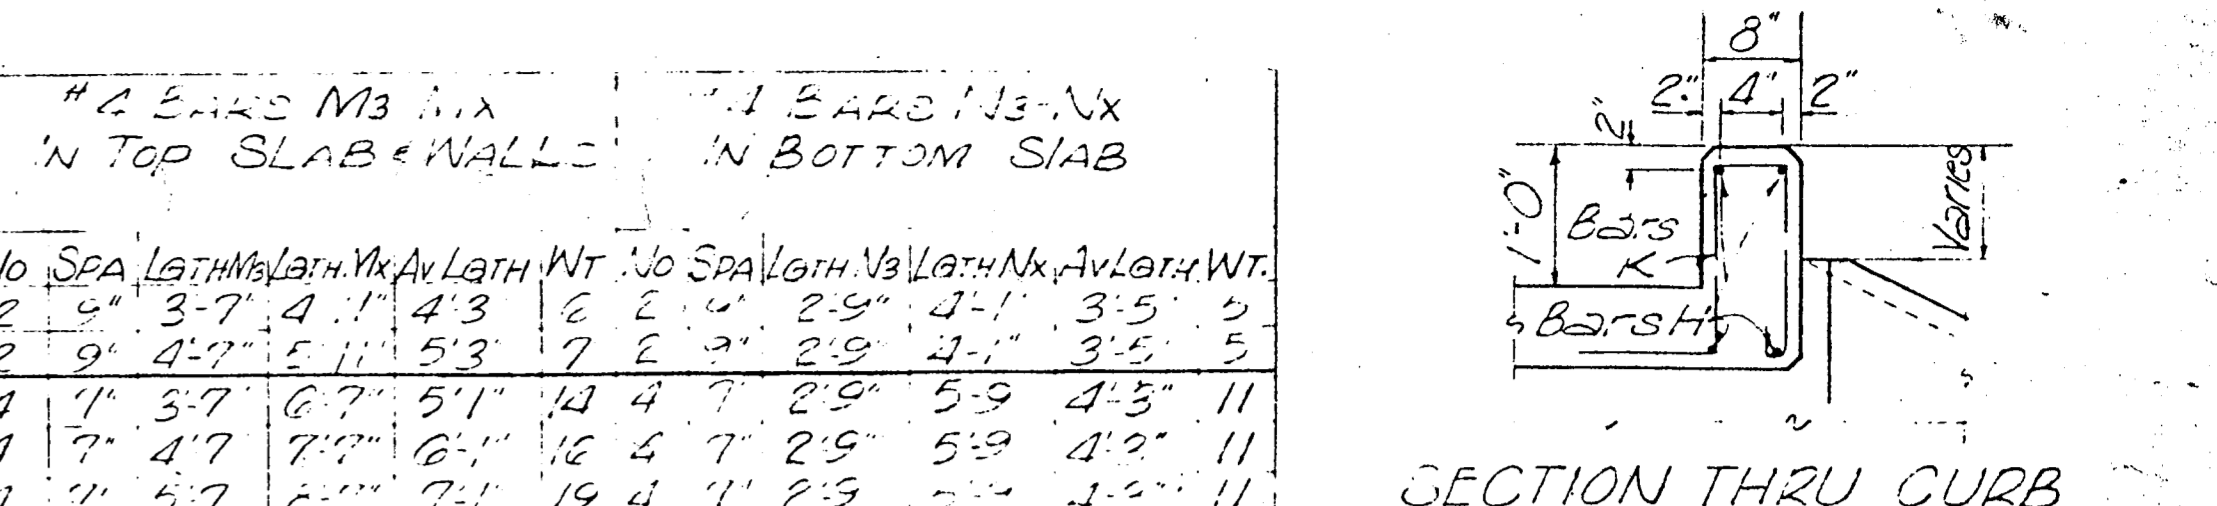


NOTE: It is desirable to have at least one foot of straight extension before beginning Angle Section. Bars F may be eliminated from this one foot section.

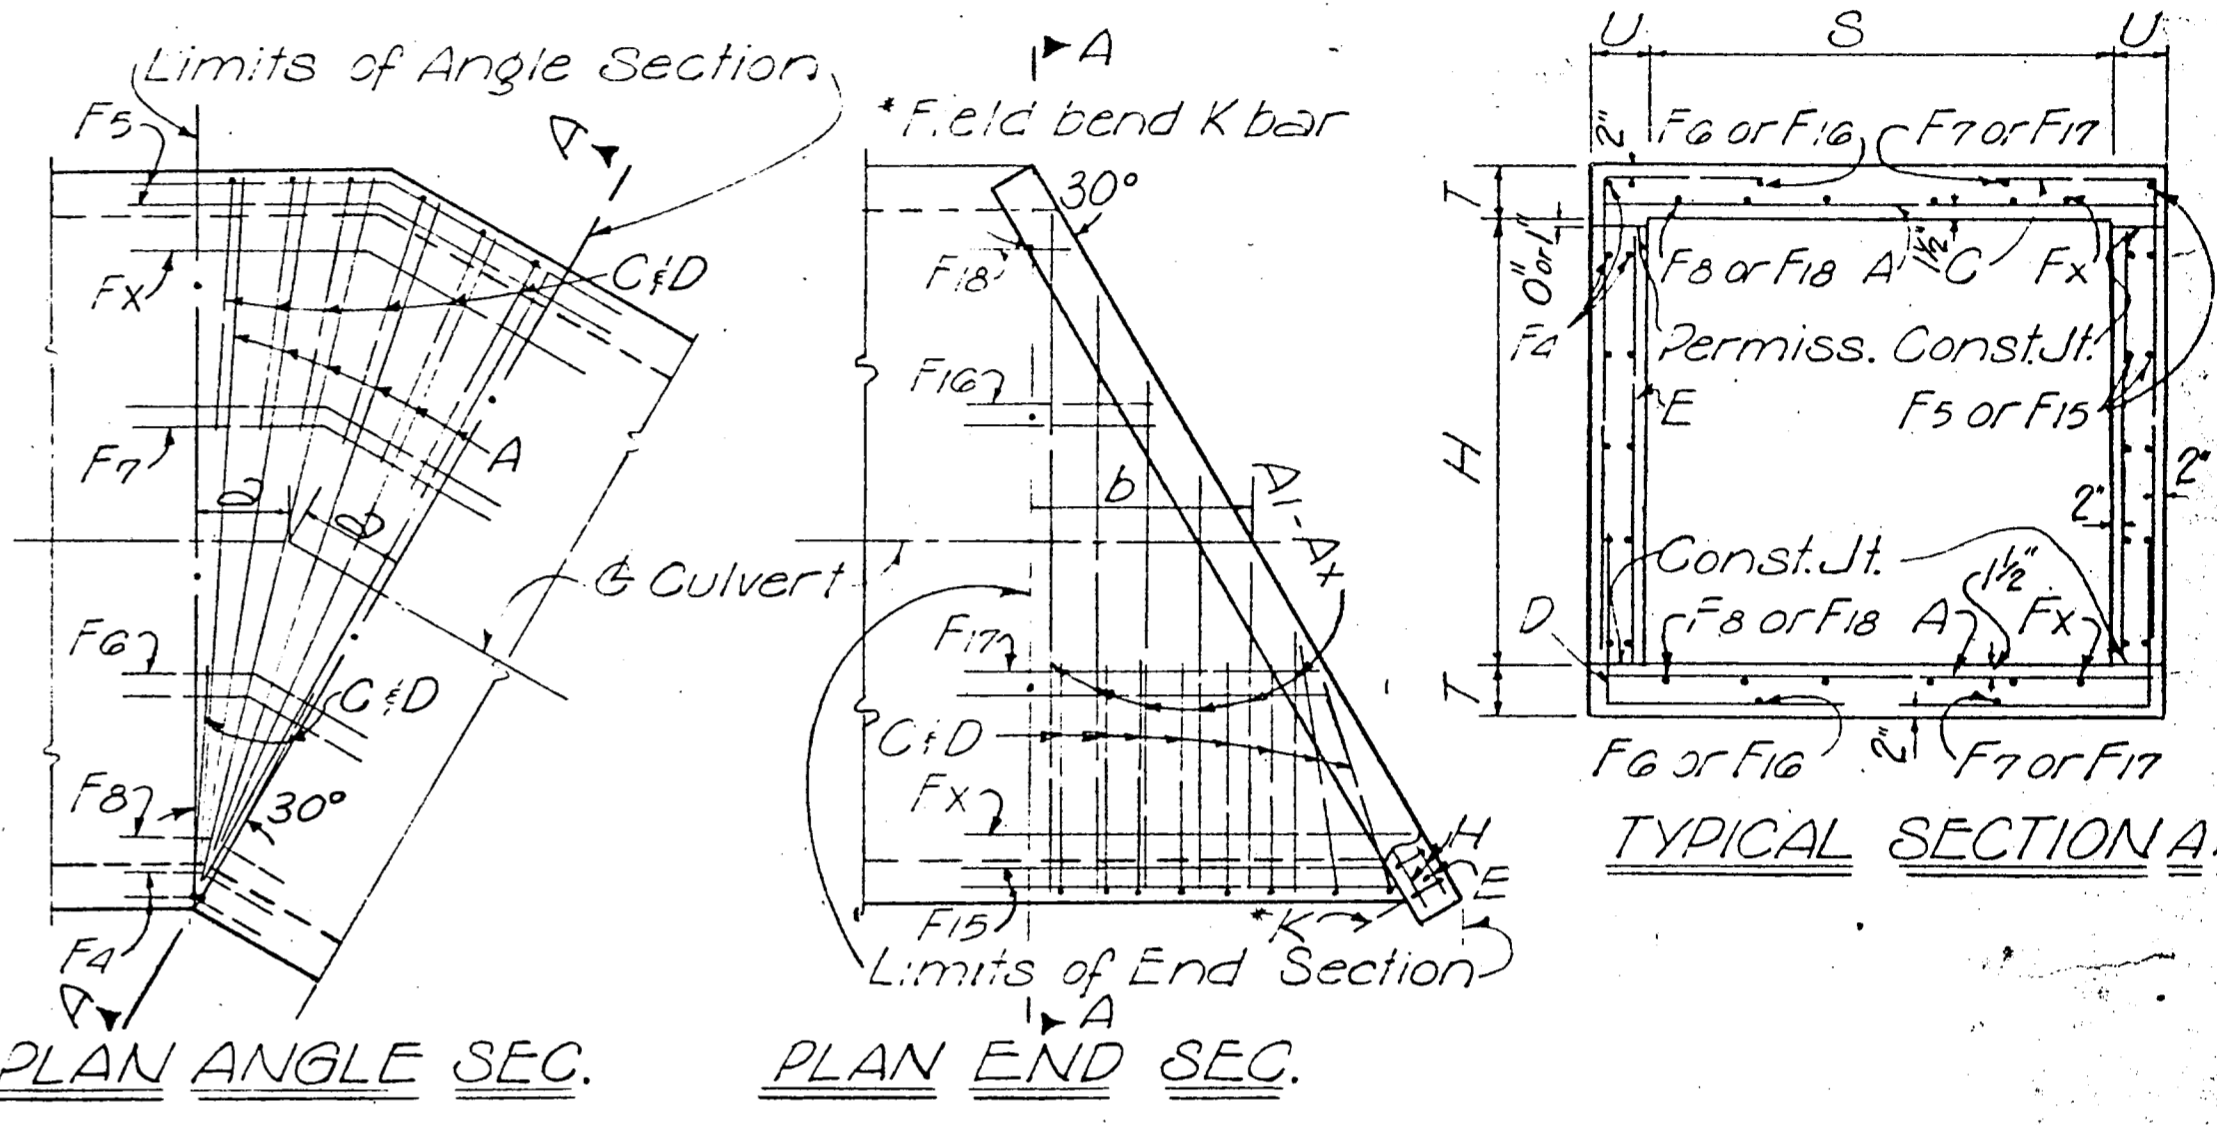

BILL OF STEEL- ANGLE SECTION

Table for ANGLE SECTION detailing bar quantities and specifications for various culvert sizes and dimensions.

Bars M & N replace Bars C & D when shown. Bars Fa, Fb, Fc & Fd are not used in bottom slab when Bars M & N are used. When only 1-Bar E is shown it shall be placed in wall at end of barrel.

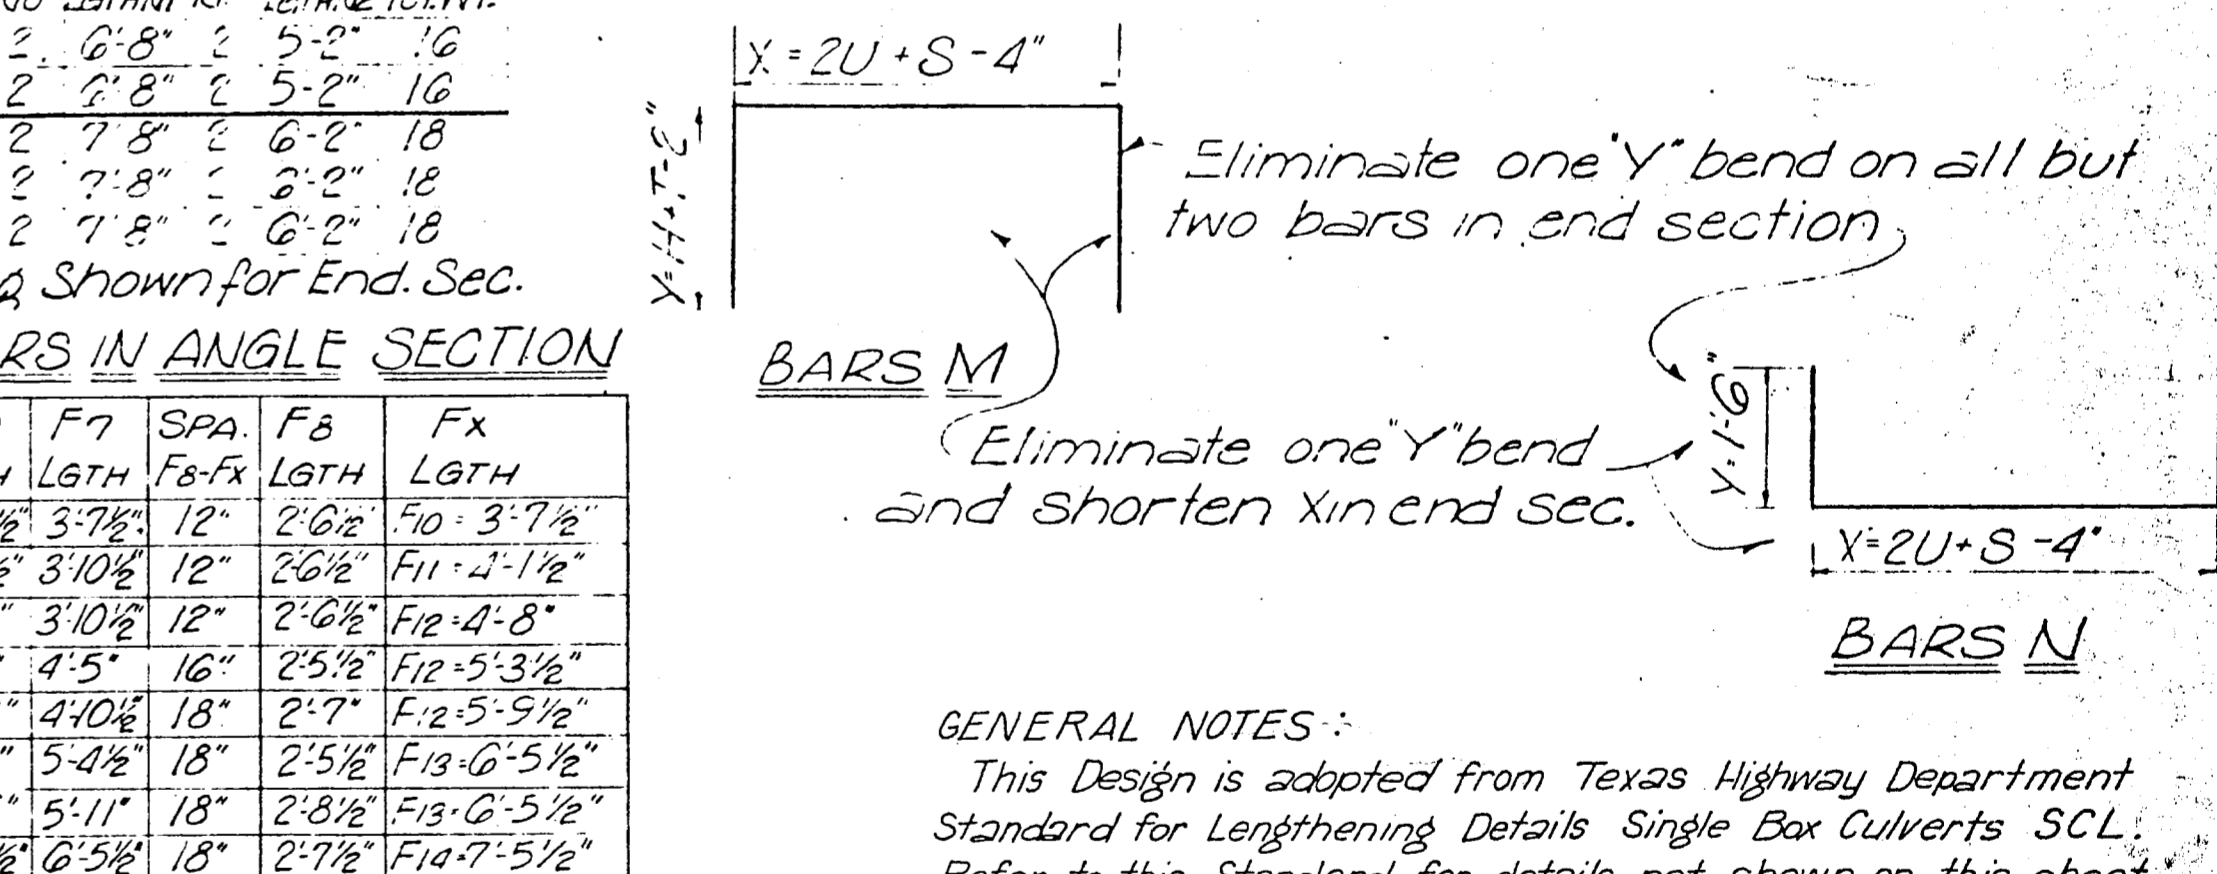

GENERAL NOTES: This Design is adopted from Texas Highway Department Standard for Lengthening Details Single Box Culverts SCL. Refer to this Standard for details not shown on this sheet. Chamfer exposed corners. Refer to Standard SCL for straight sections of culvert. All dimensions relating to reinforcing steel are to centers of bars.

TEXAS HIGHWAY DEPARTMENT BRIDGE DIVISION LENGTHENING DETAILS SINGLE BOX CULVERTS 30° SKEW SCL 30°. Includes a table of reinforcement bar specifications for different culvert sizes and dimensions.