


B.M. #4 On Conc. Walk At S.E. Corner Of Bldg At 15301 Midway Rd. Elev. 621.43

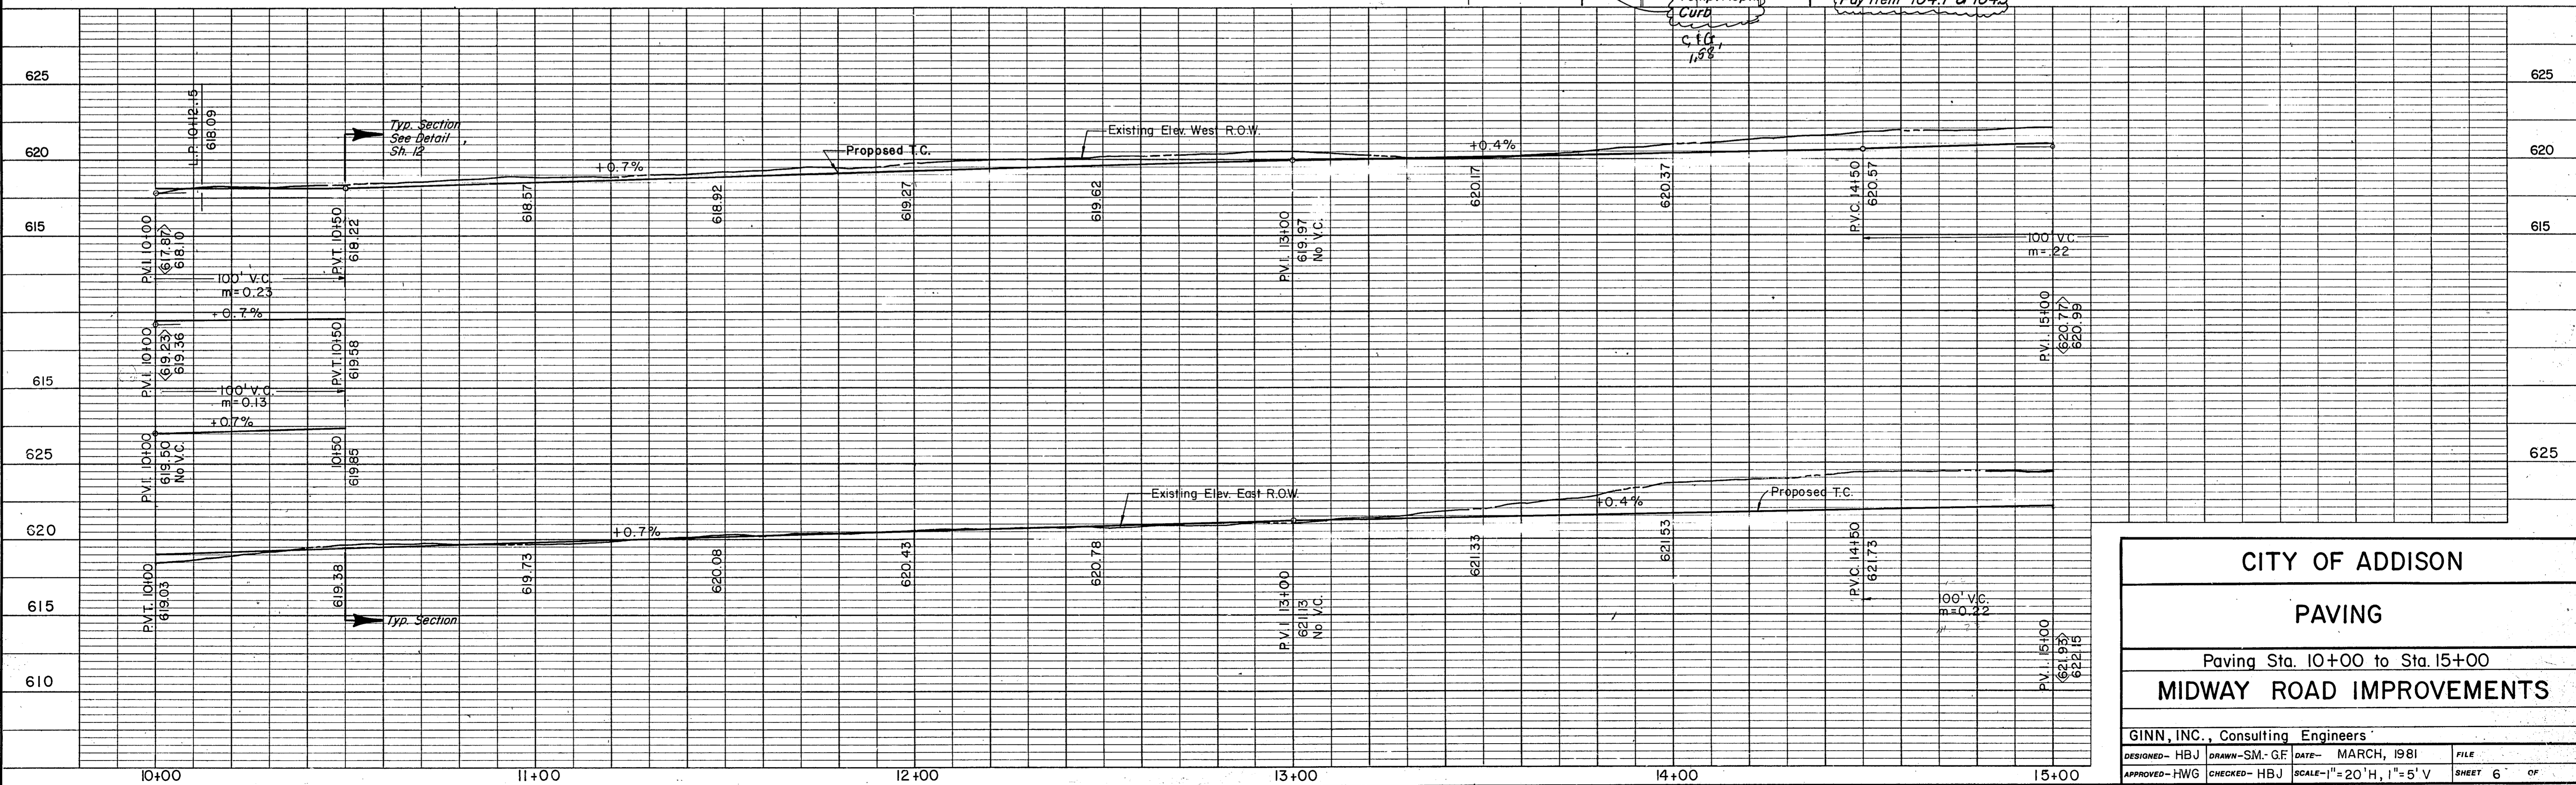

CITY OF ADDISON

PAVING

Paving Sta. 10+00 to Sta. 15+00
MIDWAY ROAD IMPROVEMENTS

GINN, INC., Consulting Engineers

DESIGNED - HBJ DRAWN - SM - GF DATE - MARCH, 1981 FILE
APPROVED - HWG CHECKED - HBJ SCALE - 1" = 20' H, 1" = 5' V SHEET 6 OF