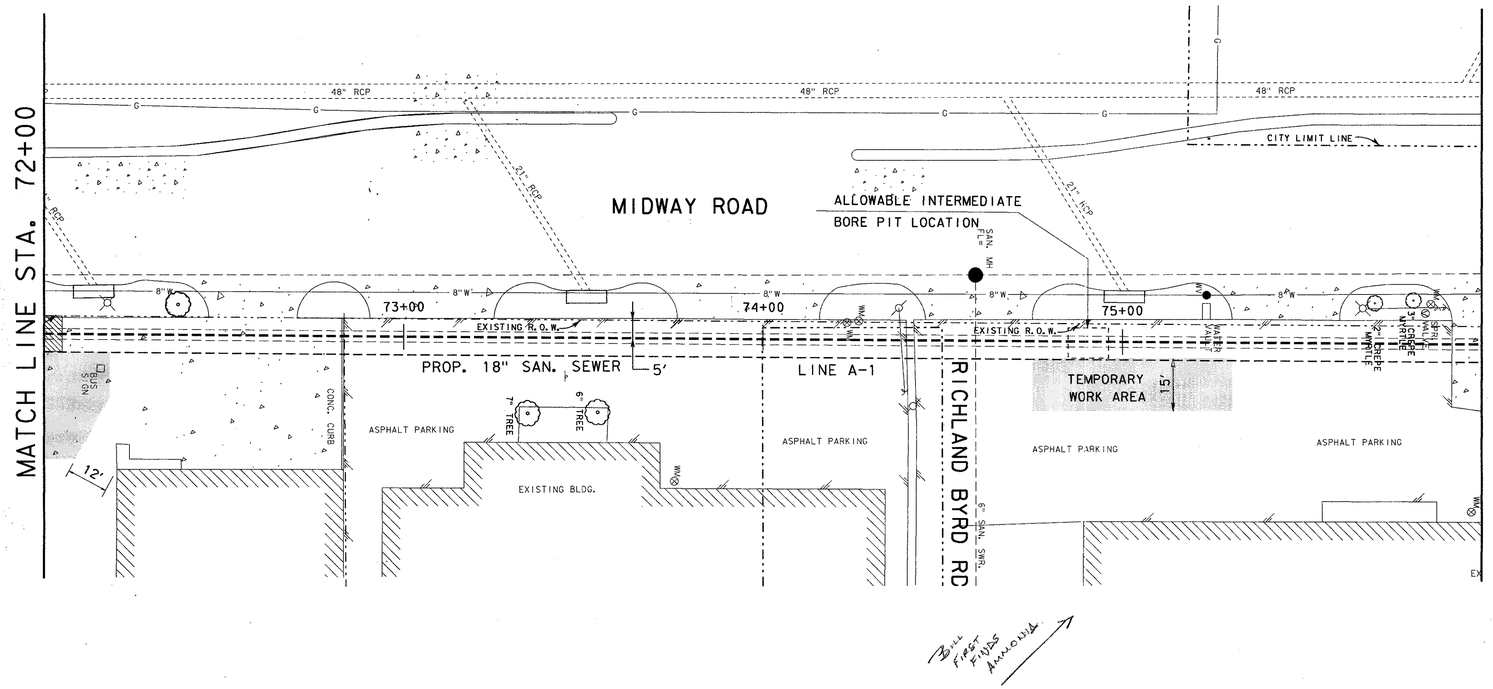

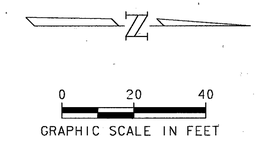

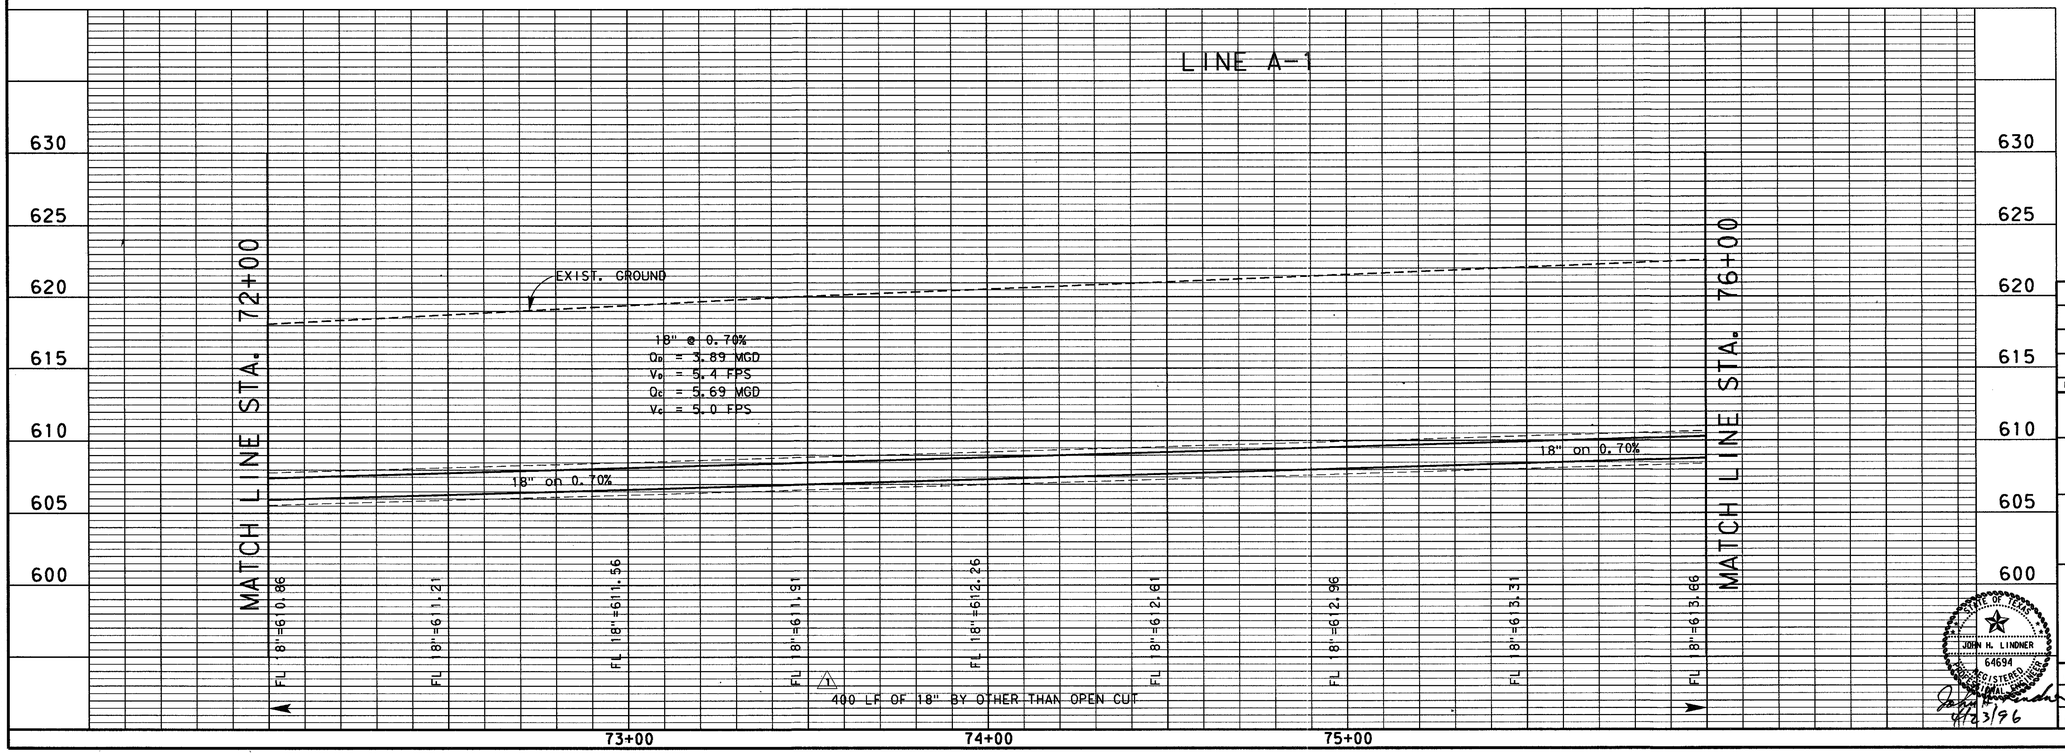

NO.	DATE	REVISION	APPROV.
4			
3			
2			
1	4-23-96	ADDENDUM NO. 1	J.H.L.

TOWN OF ADDISON, TEXAS

MIDWAY/BELTLINE SANITARY SEWER
PHASE II

LINE A-1

FROM STATION 72+00 TO STATION 76+00

Carter::Burgess
Consultants in Engineering, Architecture, Planning and the Environment
CARTER & BURGESS, INC.
7950 ELMBROOK DRIVE, SUITE 250
DALLAS, TX 75247-4961

STATE OF TEXAS
JOHN H. LINDNER
64694
REGISTERED PROFESSIONAL ENGINEER
4/23/96

Unit		Scale	Horiz. 1"=20' Vert. 1"=5'	Date	04-05-96
Designed	J. Lindner	Checked	J. Lindner	Job No.	93327601D
Drawn	R. Howman	Approved	J. Lindner	Sheet	21 of 63

3276SS18.DGN

01-2607