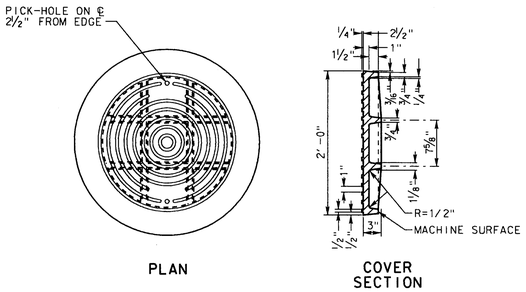

NOTE:
DALLAS FOUNDRY 700-8, OR EQUAL, 400 FRAME AND COVER. FOR OTHER THAN STREET LOCATIONS, 300 FRAME AND COVER (DALLAS FOUNDRY 700-12, OR EQUAL) MAY BE SUBSTITUTED.

MANHOLE COVER AND FRAME STANDARD

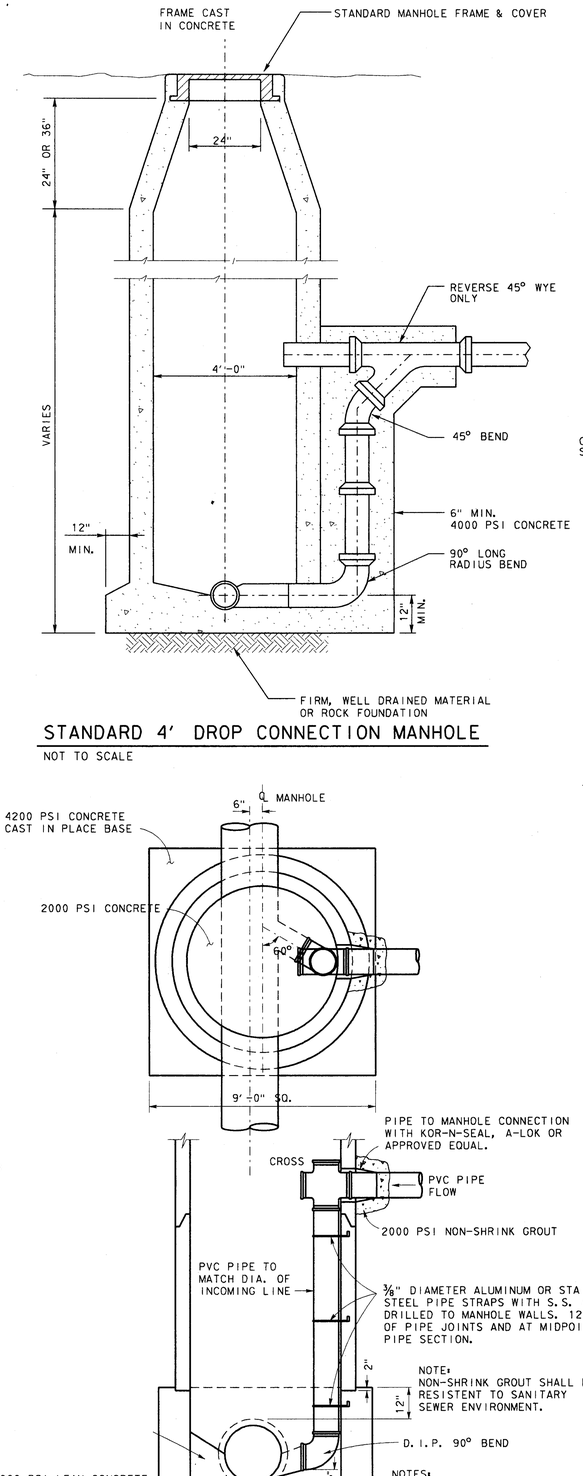

STANDARD 4' DROP CONNECTION MANHOLE

NOT TO SCALE

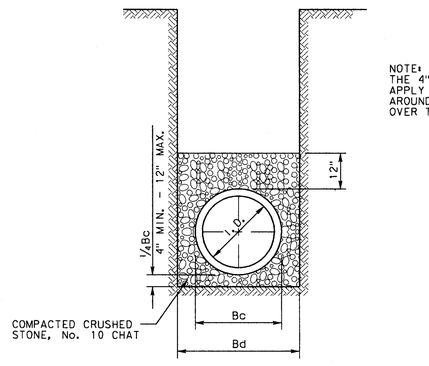

BEDDING DETAIL CLASS "B"

* ALL SANITARY SEWER EMBEDMENT SHALL BE CLASS "B" UNLESS OTHERWISE SHOWN ON PLANS.

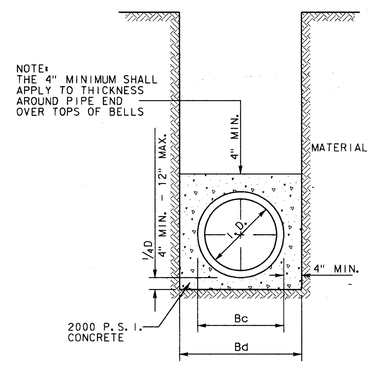

BEDDING DETAIL CLASS "G"

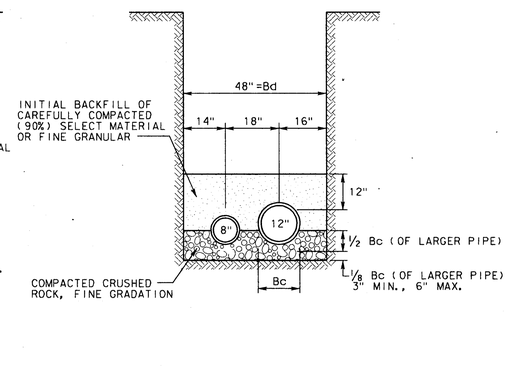

PVC FORCEMAIN EMBEDMENT DETAIL

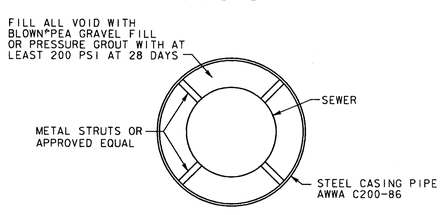

CARRIER PIPE (DIA.)	CASING PIPE (DIA.)	MIN. STEEL PIPE WALL THICKNESS
8"	16"	¼"
12"	18"	¼"
15"	24"	⅜"
18"	28"	⅜"
21"	30"	⅜"
24"	34"	⅜"
21"*	36"	½"

* UNDER RAILROAD

CASING DETAIL FOR BORING

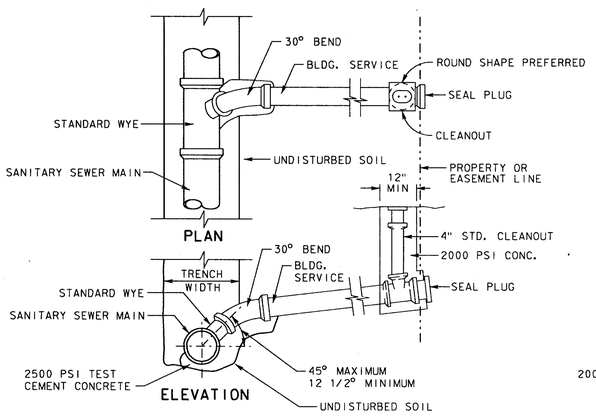

SERVICE CONNECTION STANDARD

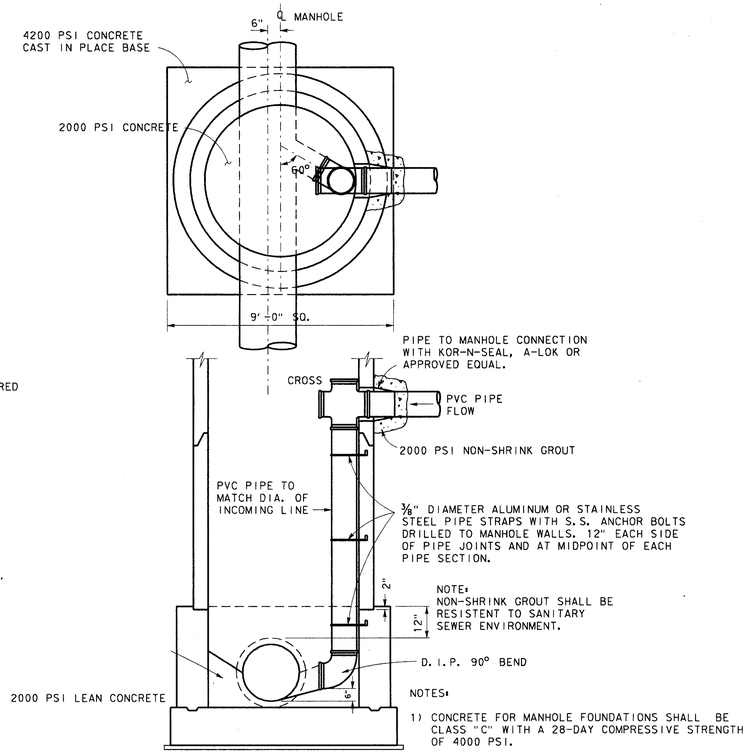

6' DIA. DROP MANHOLE CONNECTION

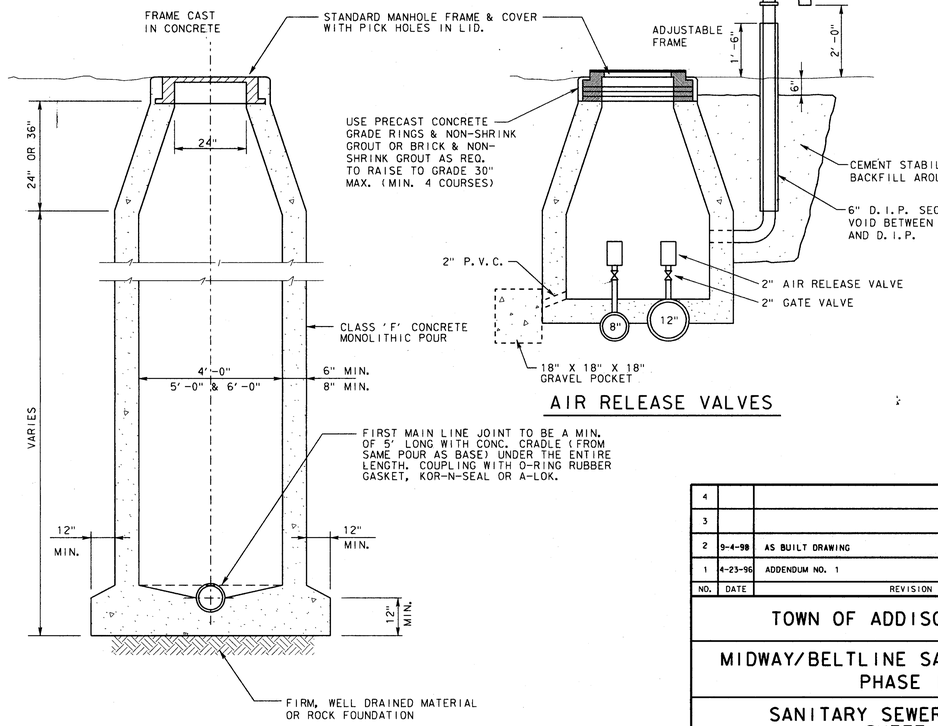

STANDARD CAST-IN-PLACE CONCRETE MANHOLE

NOT TO SCALE

⚠1 THE BOTTOMS OF ALL MANHOLES ARE TO BE CAST-IN-PLACE.

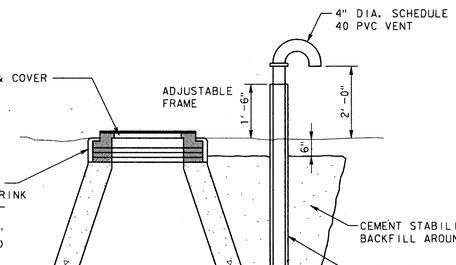

AIR RELEASE VALVES

NO.	DATE	REVISION	APPROV.
4			
3			
2	9-4-98	AS BUILT DRAWING	J. H. L.
1	4-25-96	ADDENDUM NO. 1	J. H. L.

TOWN OF ADDISON, TEXAS

MIDWAY/BELTLINE SANITARY SEWER PHASE II

SANITARY SEWER DETAILS SHEET 1

Carter :: Burgess
Consultants in Engineering, Architecture, Planning and the Environment
CARTER & BURGESS, INC.
7950 ELMBROOK DRIVE, SUITE 250
DALLAS, TX 75247-4961

STATE OF TEXAS — JOHN H. LINDNER — 64694 — REGISTERED PROFESSIONAL ENGINEER — 4/23/96

Unit		Scale	Date 04-05-96
Designed	J. Lindner	Checked J. Lindner	Job No. 93327601D
Drawn	R. Howman	Approved J. Lindner	Sheet 36 of 63

3276cd01.dgn

01-2607