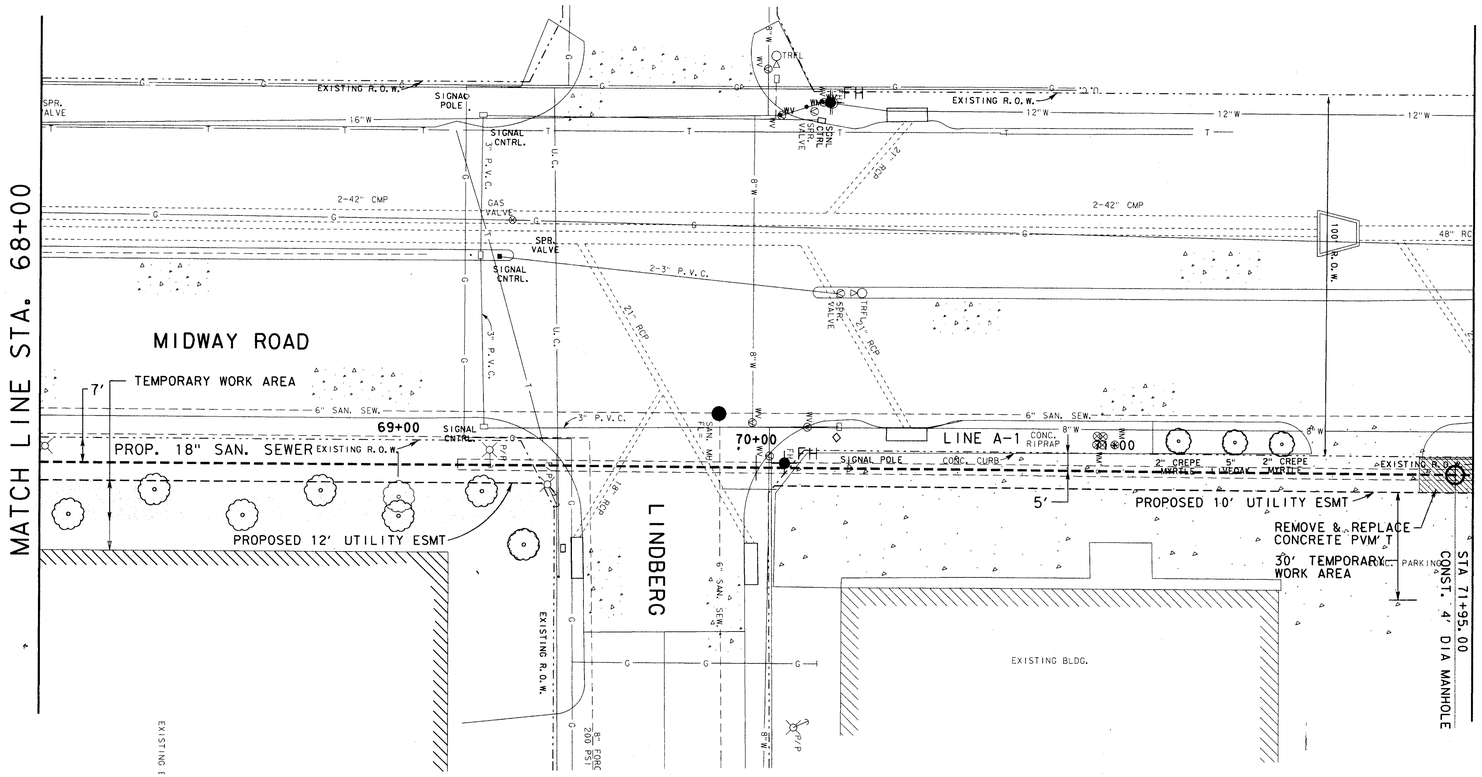

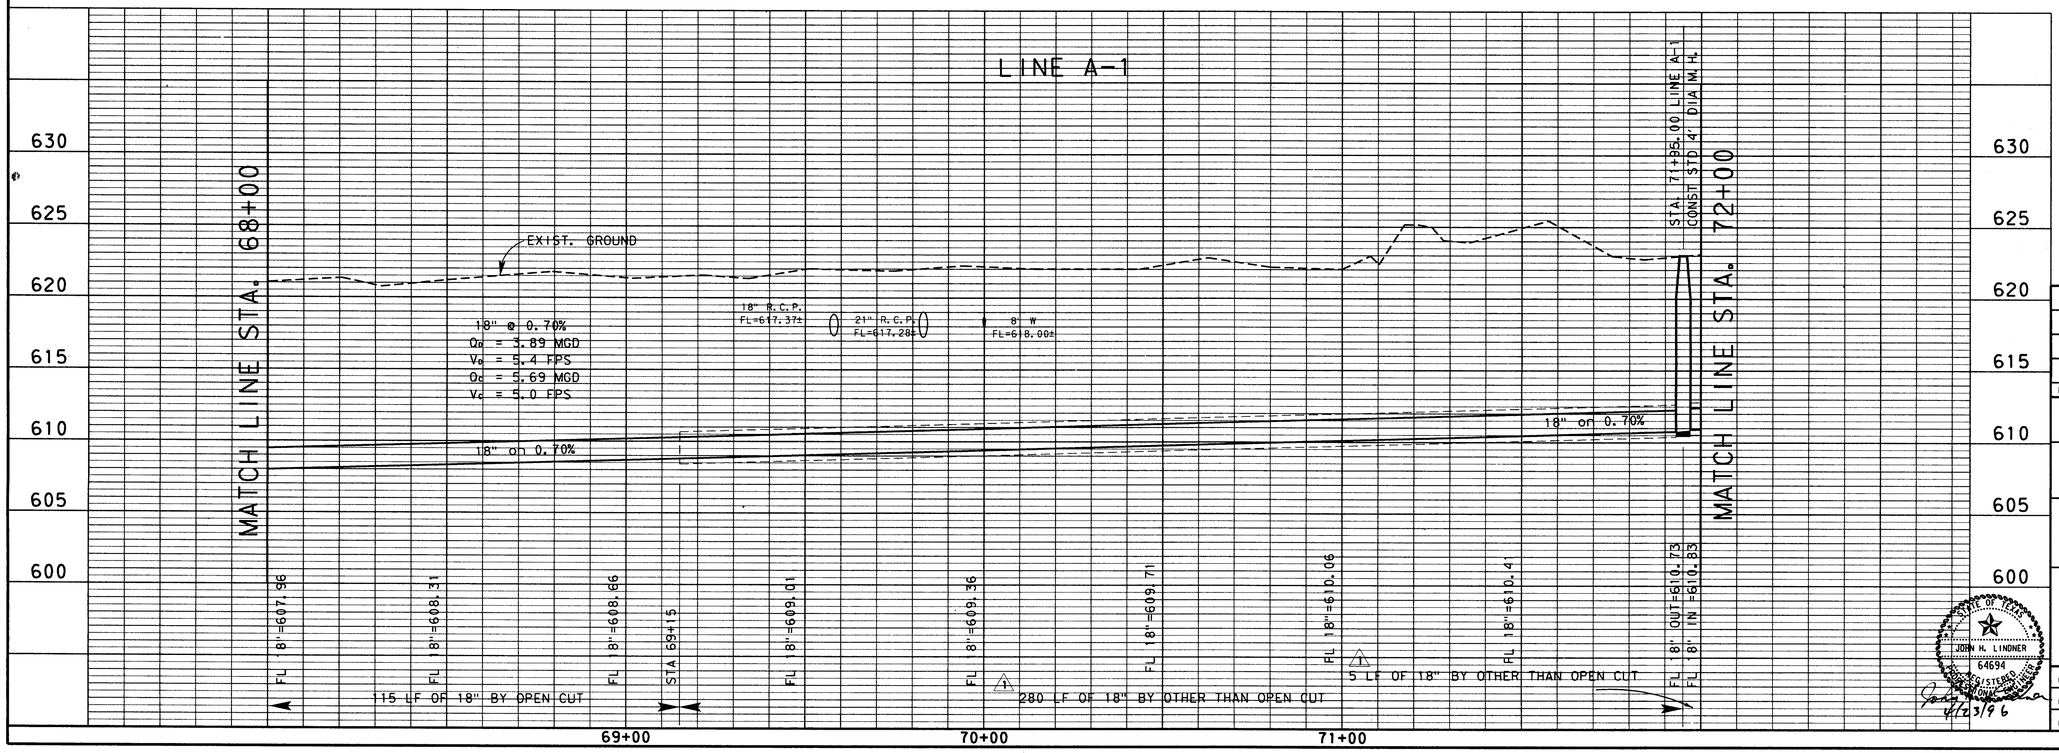

NO.	DATE	REVISION	APPROV.
4			
3			
2	9-4-98	AS BUILT DRAWING	J.H.L.
1	4-23-96	ADDENDUM NO. 1	J.H.L.

TOWN OF ADDISON, TEXAS

MIDWAY/BELTLINE SANITARY SEWER PHASE II

LINE A-1

FROM STATION 68+00 TO STATION 72+00

Carter::Burgess
Consultants in Engineering, Architecture, Planning and the Environment
CARTER & BURGESS, INC.
7950 ELMBROOK DRIVE, SUITE 250
DALLAS, TX 75247-4961

STATE OF TEXAS
JOHN H. LINDNER
64694
REGISTERED PROFESSIONAL ENGINEER
4/23/96

Unit		Scale Horiz. 1"=20' Vert. 1"=5'	Date 04-05-96
Designed	J. Lindner	Checked J. Lindner	Job No. 93327601D
Drawn	R. Howman	Approved J. Lindner	Sheet 20 of 63

3276SS17.DGN

0 20 40
GRAPHIC SCALE IN FEET

01-2607