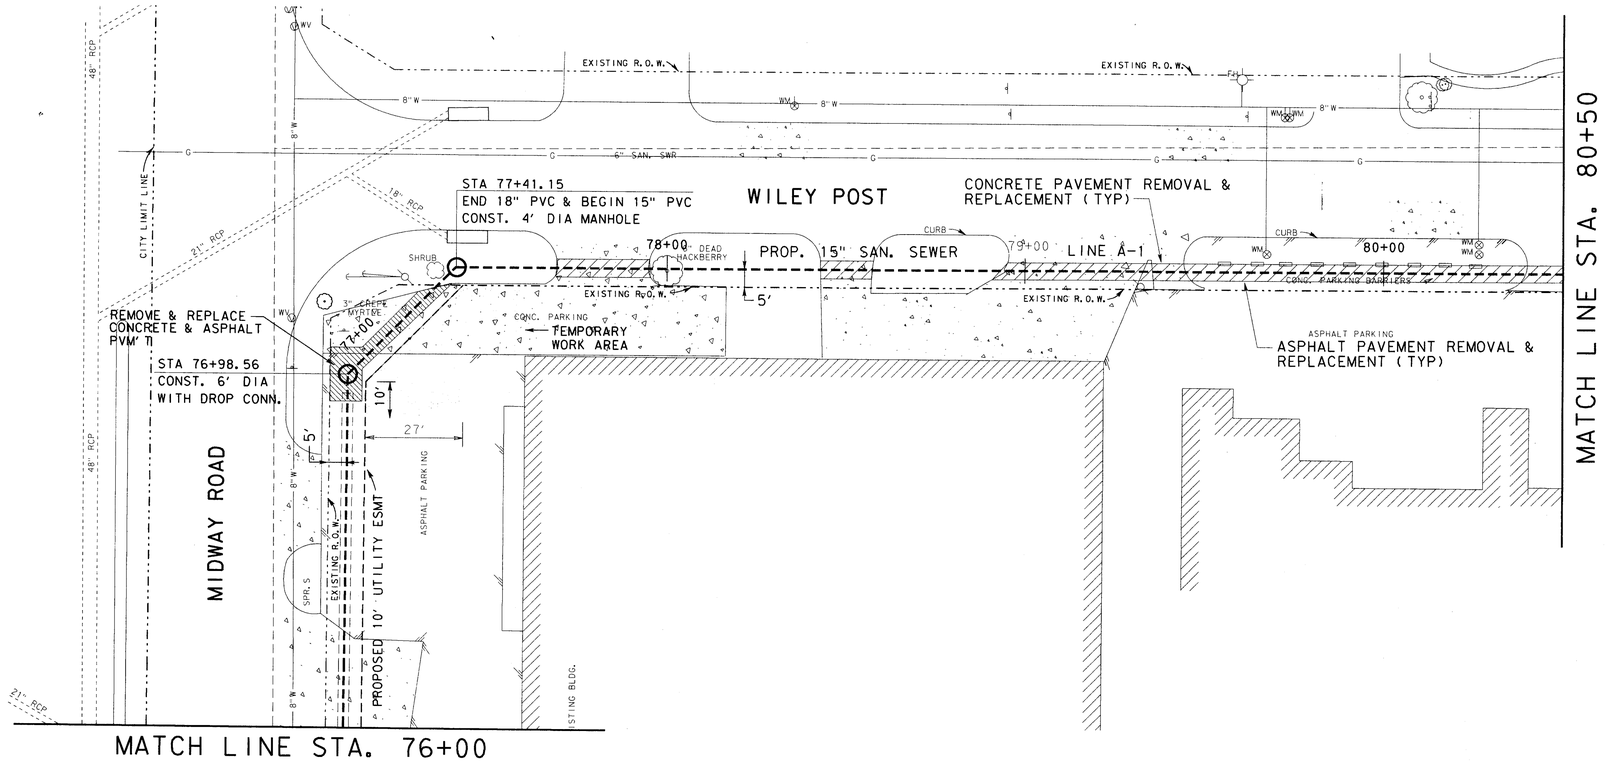

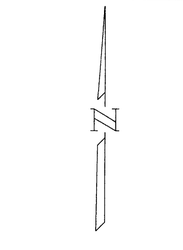

NOTE:

1. CONTRACTOR SHALL NOT CLOSE MORE THAN ONE DRIVEWAY TO A GIVEN BUSINESS AT A TIME. IMMEDIATELY UPON PIPE INSTALLATION, CONTRACTOR SHALL BACKFILL AND PLACE TEMPORARY ASPHALT OR STEEL PLATES. NOT A SEPARATE PAY ITEM.

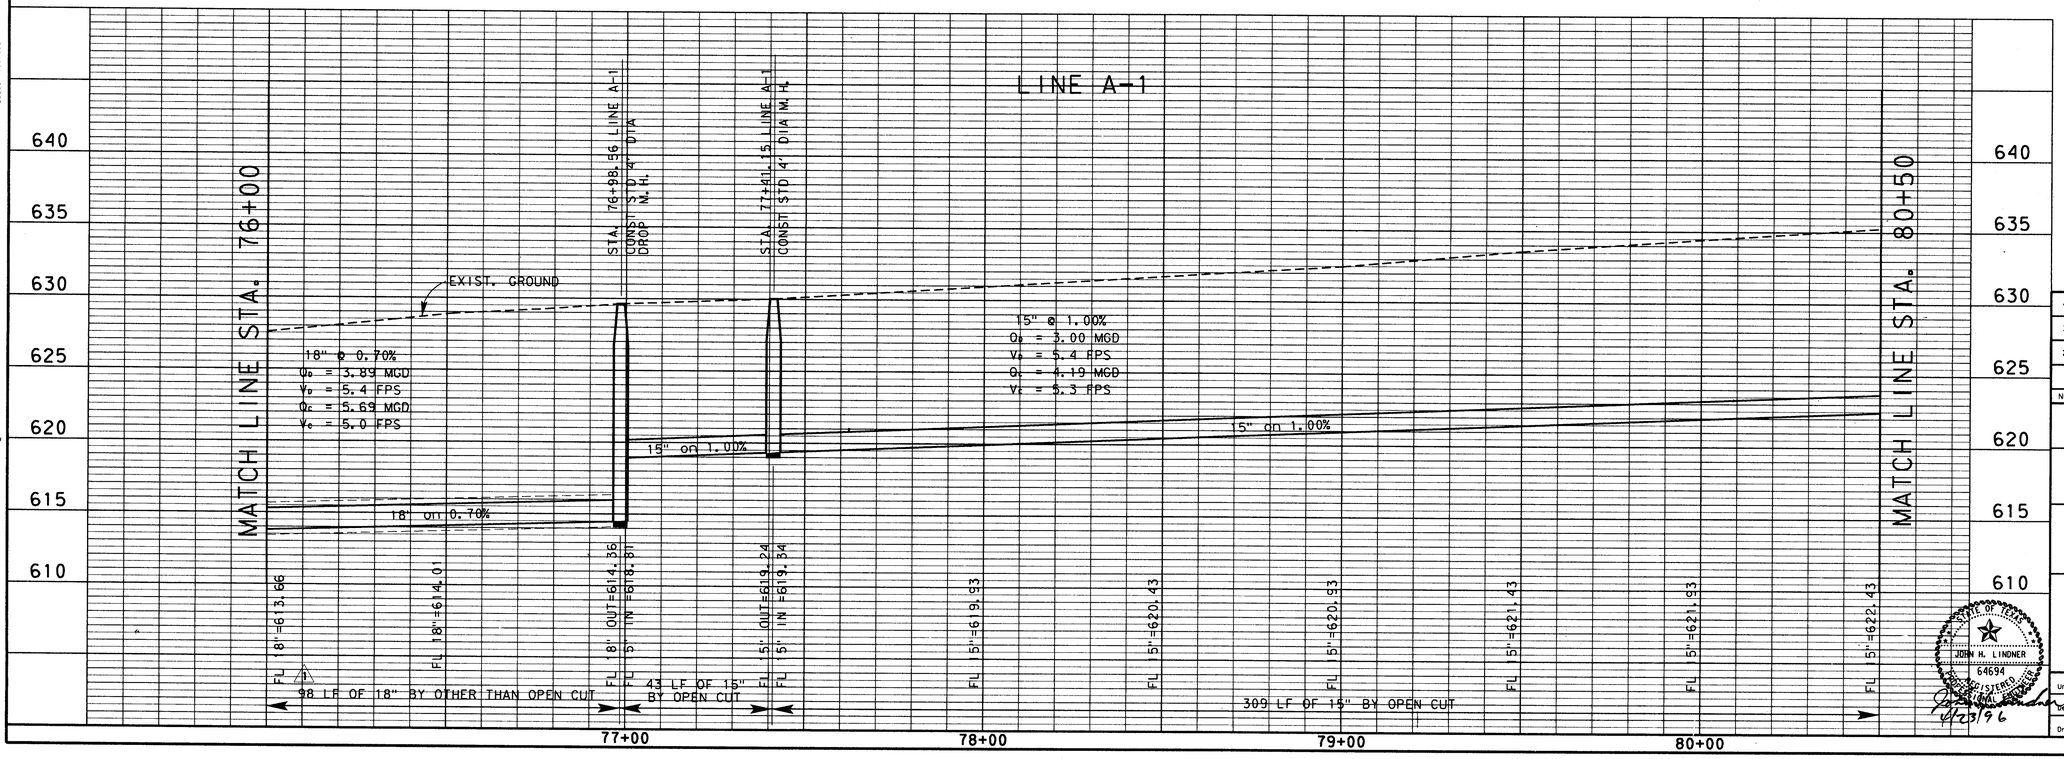

NO.	DATE	REVISION	APPROV.
4			
3			
2	9-4-96	AS BUILT DRAWING	J. H. L.
1	4-23-96	ADDENDUM NO. 1	J. H. L.

TOWN OF ADDISON, TEXAS

MIDWAY/BELTLINE SANITARY SEWER PHASE II

LINE A-1

FROM STATION 76+00 TO STATION 80+50

Carter :: Burgess
Consultants in Engineering, Architecture, Planning and the Environment
CARTER & BURGESS, INC.
7950 ELMBROOK DRIVE, SUITE 250
DALLAS, TX 75247-4961

STATE OF TEXAS
JOHN H. LINDNER
64694
REGISTERED PROFESSIONAL ENGINEER
4/23/96

Unit		Scales Horiz. 1"=20' Vert. 1"=5'	Date 04-05-96
Designed	J. Lindner	Checked J. Lindner	Job No. 93327601D
Drawn	R. Howman	Approved J. Lindner	Sheet 22 of 63

3276SS19.DGN

01-2607