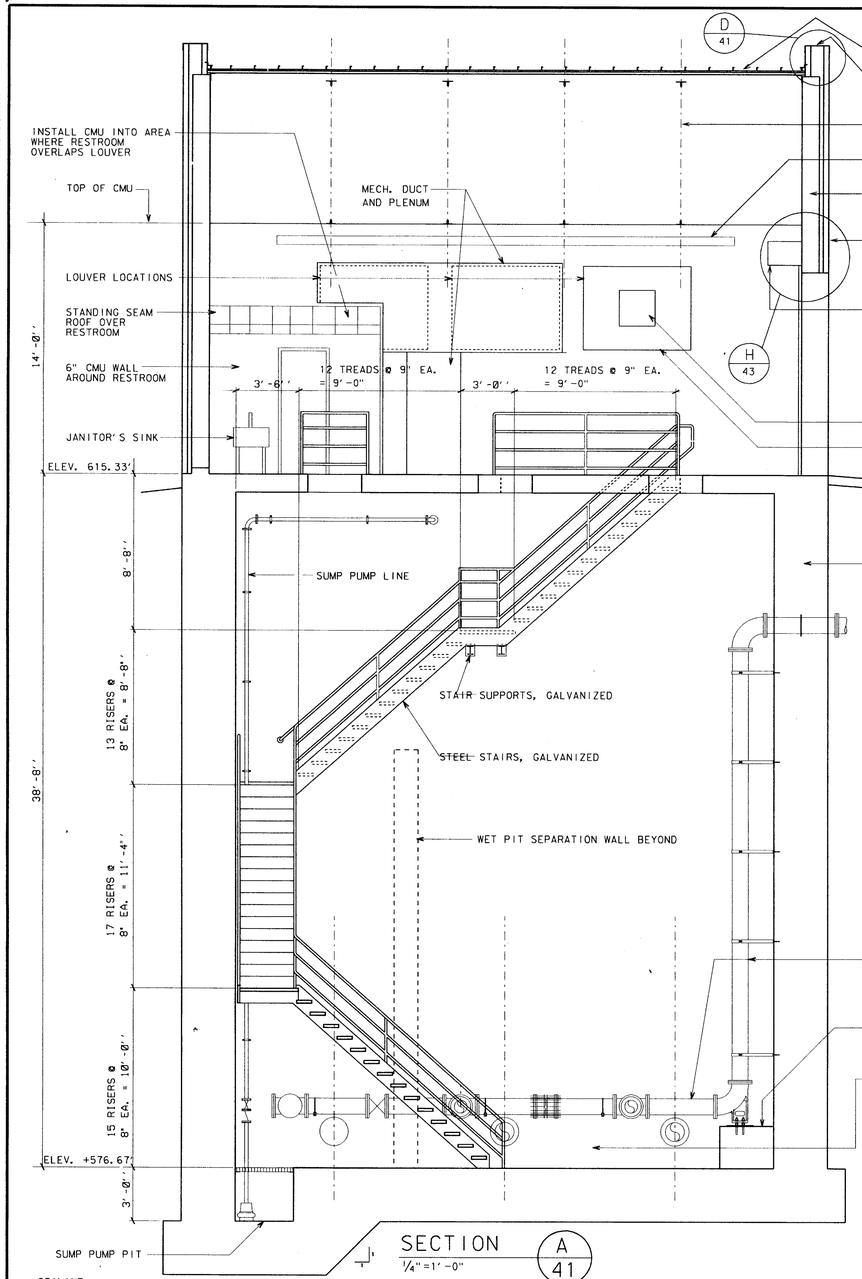

SECTION A 41
1/4" = 1'-0"

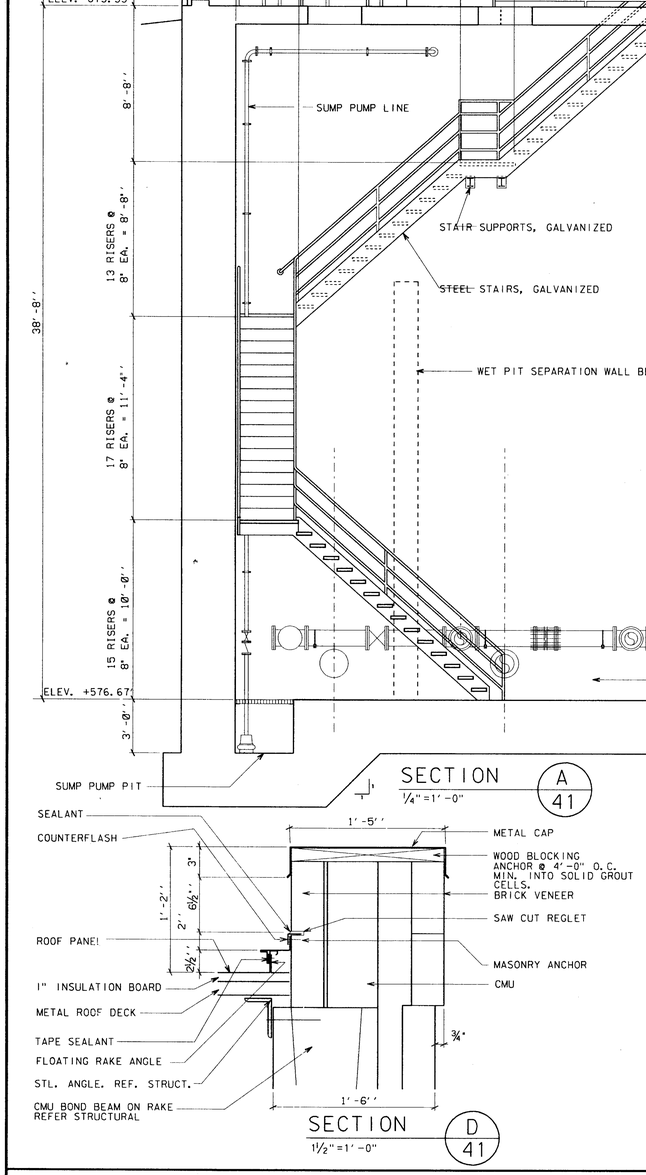

SECTION D 41
1½" = 1'-0"

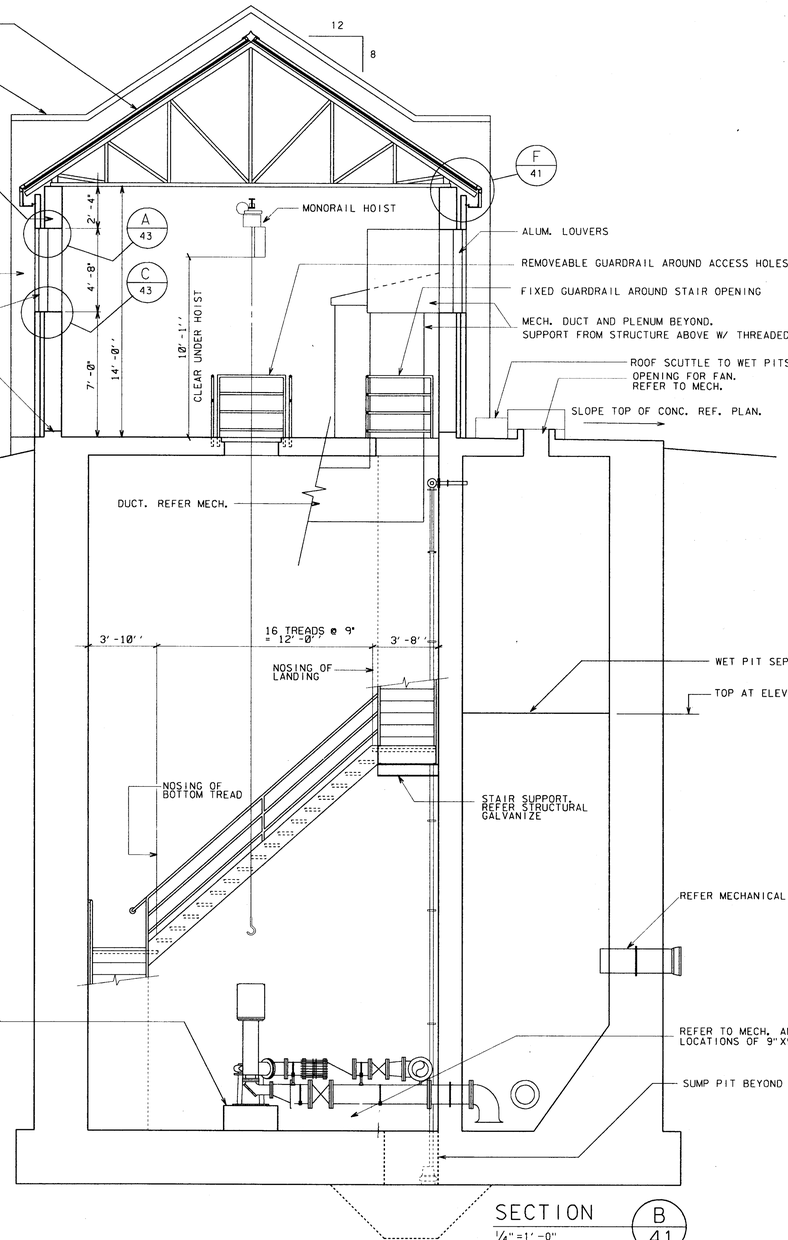

SECTION B 41
1/4" = 1'-0"

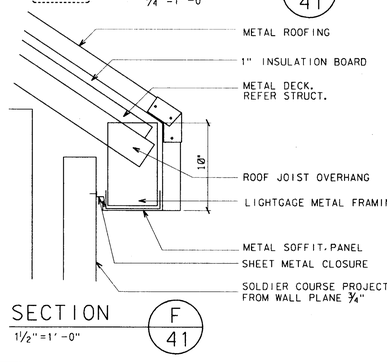

SECTION F 41
1½" = 1'-0"

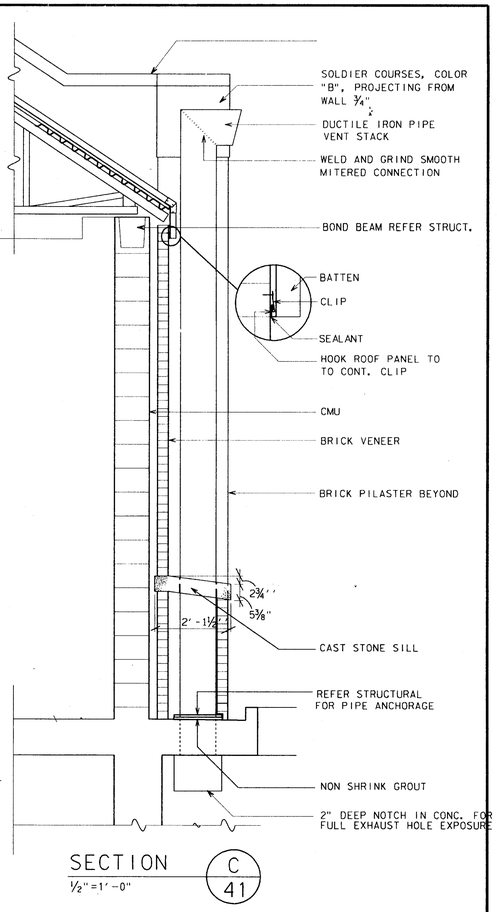

SECTION C 41
1/2" = 1'-0"

NO.	DATE	REVISION	APPROV.
4			
3			
2			
1	9-4-98	AS BUILT DRAWING	J.H.L.

TOWN OF ADDISON, TEXAS

MIDWAY/BELTLINE SANITARY SEWER PHASE II

LIFT STATION - ARCHITECTURAL BUILDING SECTIONS

Carter :: Burgess
Consultants in Engineering, Architecture, Planning and the Environment
CARTER & BURGESS, INC.
7950 ELMBROOK DRIVE, SUITE 250
DALLAS, TX 75247-4961

REGISTERED ARCHITECT MICHAEL DORRITIE 8829 STATE OF TEXAS
4/5/96 7/23/97

Unit		Scale AS SHOWN	Date 04-05-96
Designed R. WRIGHT		Checked R. WRIGHT	Job No. 93327601D
Drawn R. WRIGHT		Approved J. Lindner	Sheet 41 of 63

01-2607