



ESTIMATED QUANTITIES				
ITEM	DESCRIPTION	UNIT	QUANTITY	
100	Prepare Roadway R.O.W	Sta.	5	
104.1	Remove Old Concrete, Pavement & Median	SY		
104.2	Sawed Break-Out Groove	LF	99	
110	Unclassified Road Excavation (Dens Cont.)	CY	3602	
160	Placing 4" Topsoil	CY		
248	6" Flex Base (Dens Cont) (Ty A, Gr 2, C13)	CY		
260.1	Lime (Ty A) Slurry Method	Ton	57.08	
260.2	6" Lime Treated Subgrade (Dens Cont)	SY	4566.73	
340.1	3" Hot Mix Asph (Ty D) Resurf Shoulder	Ton	73.34	
340.2	6" Hot Mix Asphalt (Ty B)	Ton		
360.1	8" Conc Pavement (3000 PSI)	SY	4341.49	
360.2	6" Conc Monolithic Curb (3000 PSI)	LF	1550	
360.3	4" Non-Reinf Conc In Median (2000 PSI)	SY	131.48	
522	Conc Curb & Gutter Class A	LF		
524	Conc Driveways, Aprs & Reinf Conc (3000 PSI)	SY	244.94	
630.1	Foundation (Ty A) Traffic Sig In Place	EA		
630.2	Foundation (Ty B) Traffic Sig In Place	EA		
630.3	Foundation (Ty C) Traffic Sig In Place	EA		
630.4	Foundation (Ty D) Illumination	EA	2	
640.1	1/2" PVC Conduit, Furnish & Install	LF	500	
640.2	2" PVC Conduit, Furnish & Install	LF	500	
640.3	3" PVC Conduit, Furnish & Install	LF		
640.4	Pull Box, Complete In Place	EA	3	
752.1	Traffic Buttons-Single Refl Ty P15 White	EA	48	
752.2	Traffic Buttons-Single Refl Ty P18-1 White	EA	20	
754.1	Traffic Buttons-Nonrefl, Ty P7 White	EA	240	

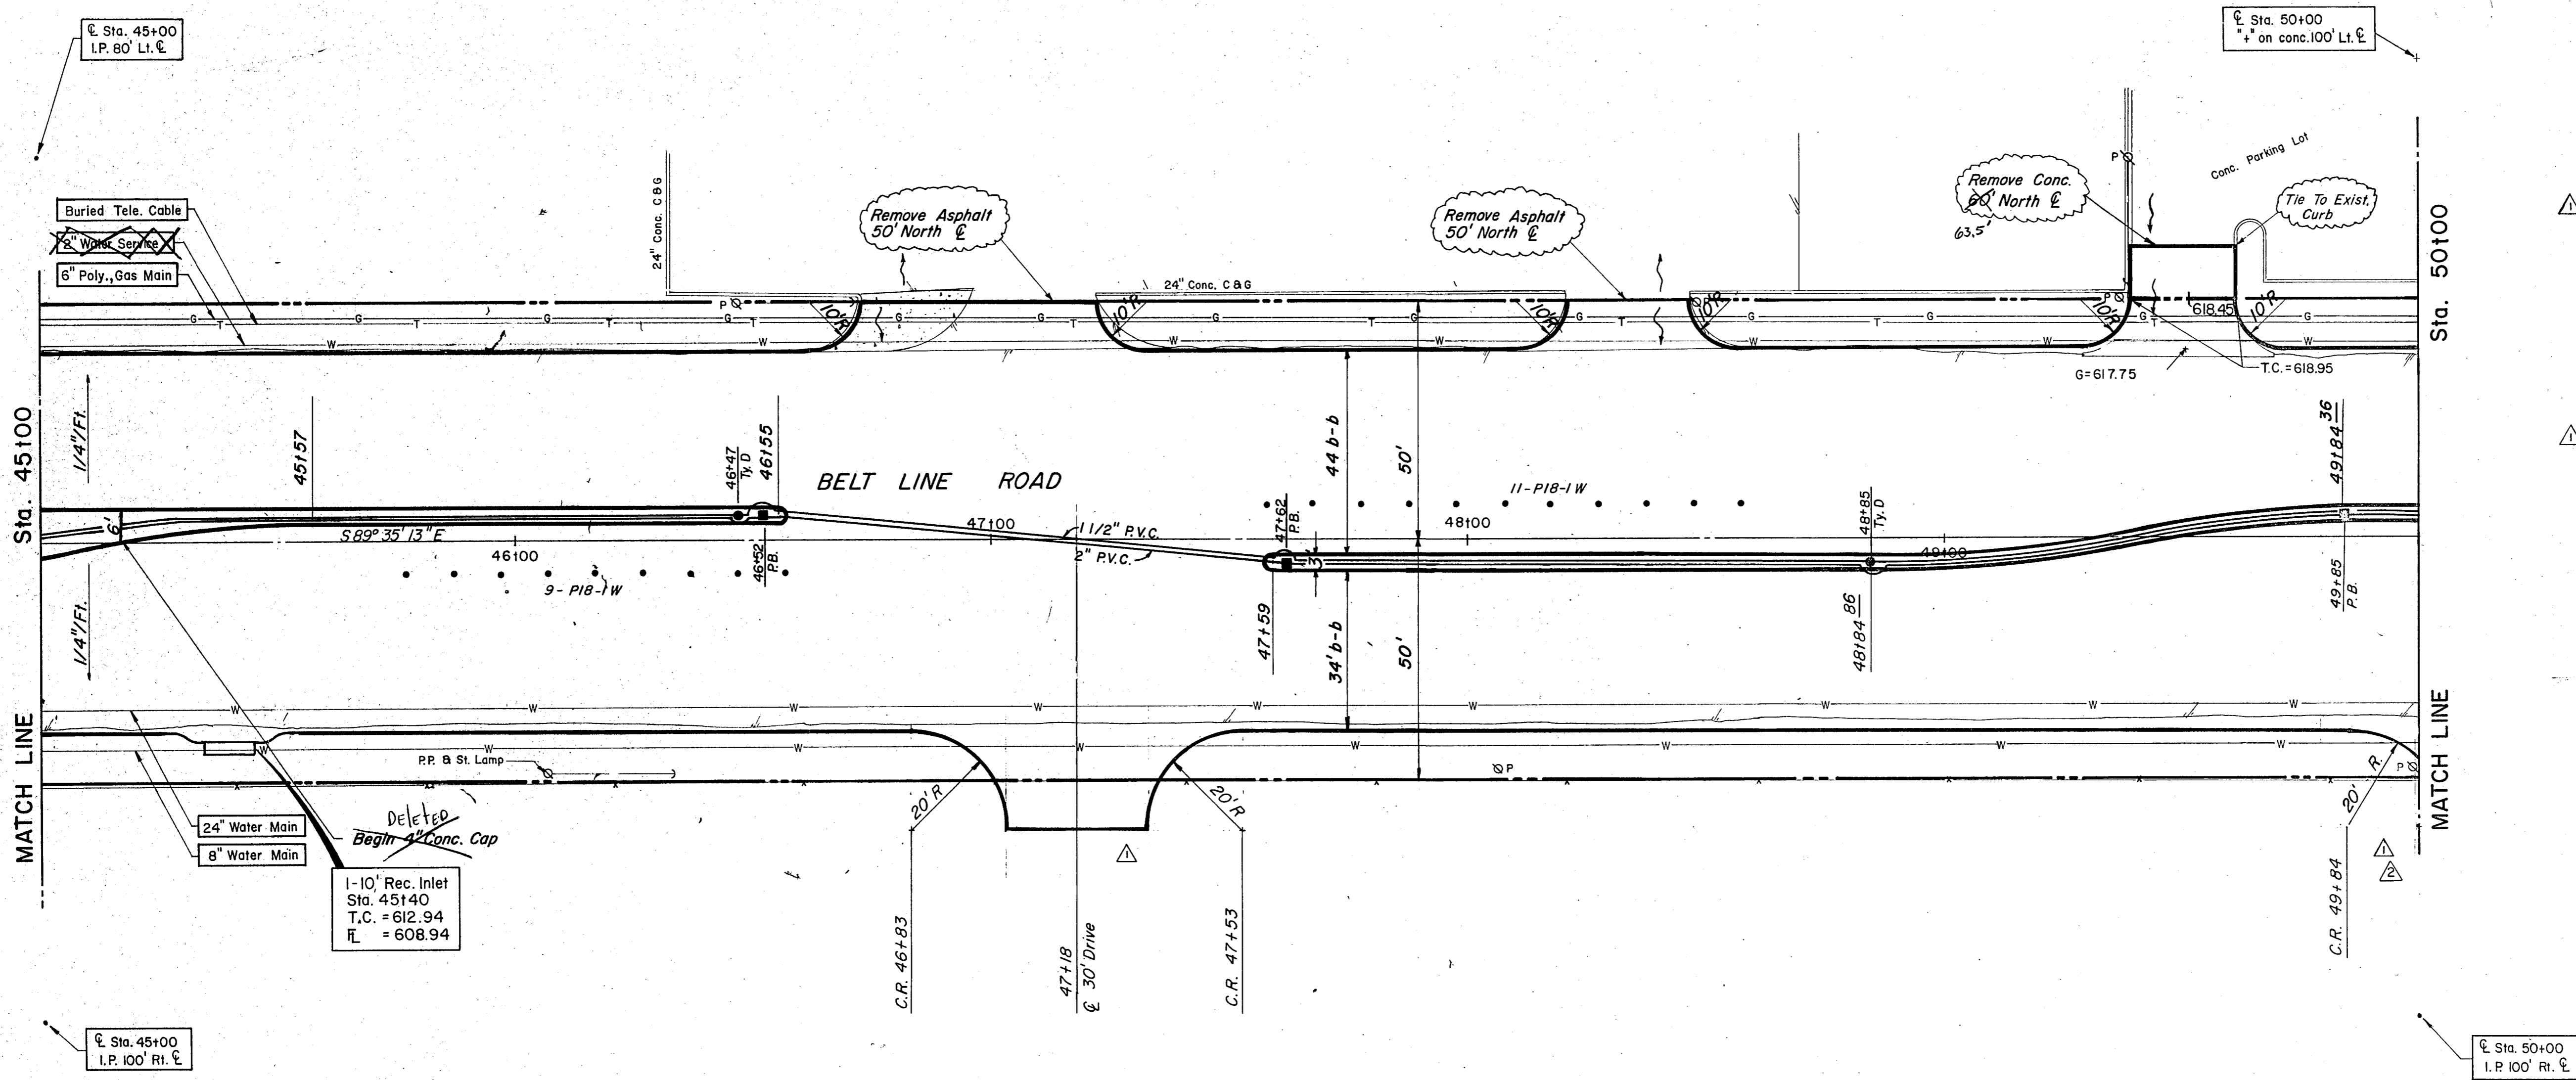

LEGEND	
○	Beach Mark
●	Iron Pin
○	Monument
○	Gas Meter
○	Gas Valve
○	Gas Line
○	Power Pole (Typical Pole Symbol)
○	Power Line
○	Guy Wire Anchor
○	Telephone Line
○	Water Meter
○	Water Valve
○	Water Line
○	Fire Hydrant
○	Manhole
○	Sanitary Sewer Line
○	Fence Line
○	Flow Direction Indicator
○	Property or Right-of-Way Line (R.O.W)
○	Easement Line
○	Traffic Pull Box
○	Most Arm Pole Foundation (Type A or B)
○	Pedestal Pole Foundation (Type C)
○	Signal Illumination Pole Foundation (Type D)
○	Top of Curb
○	Flow Line

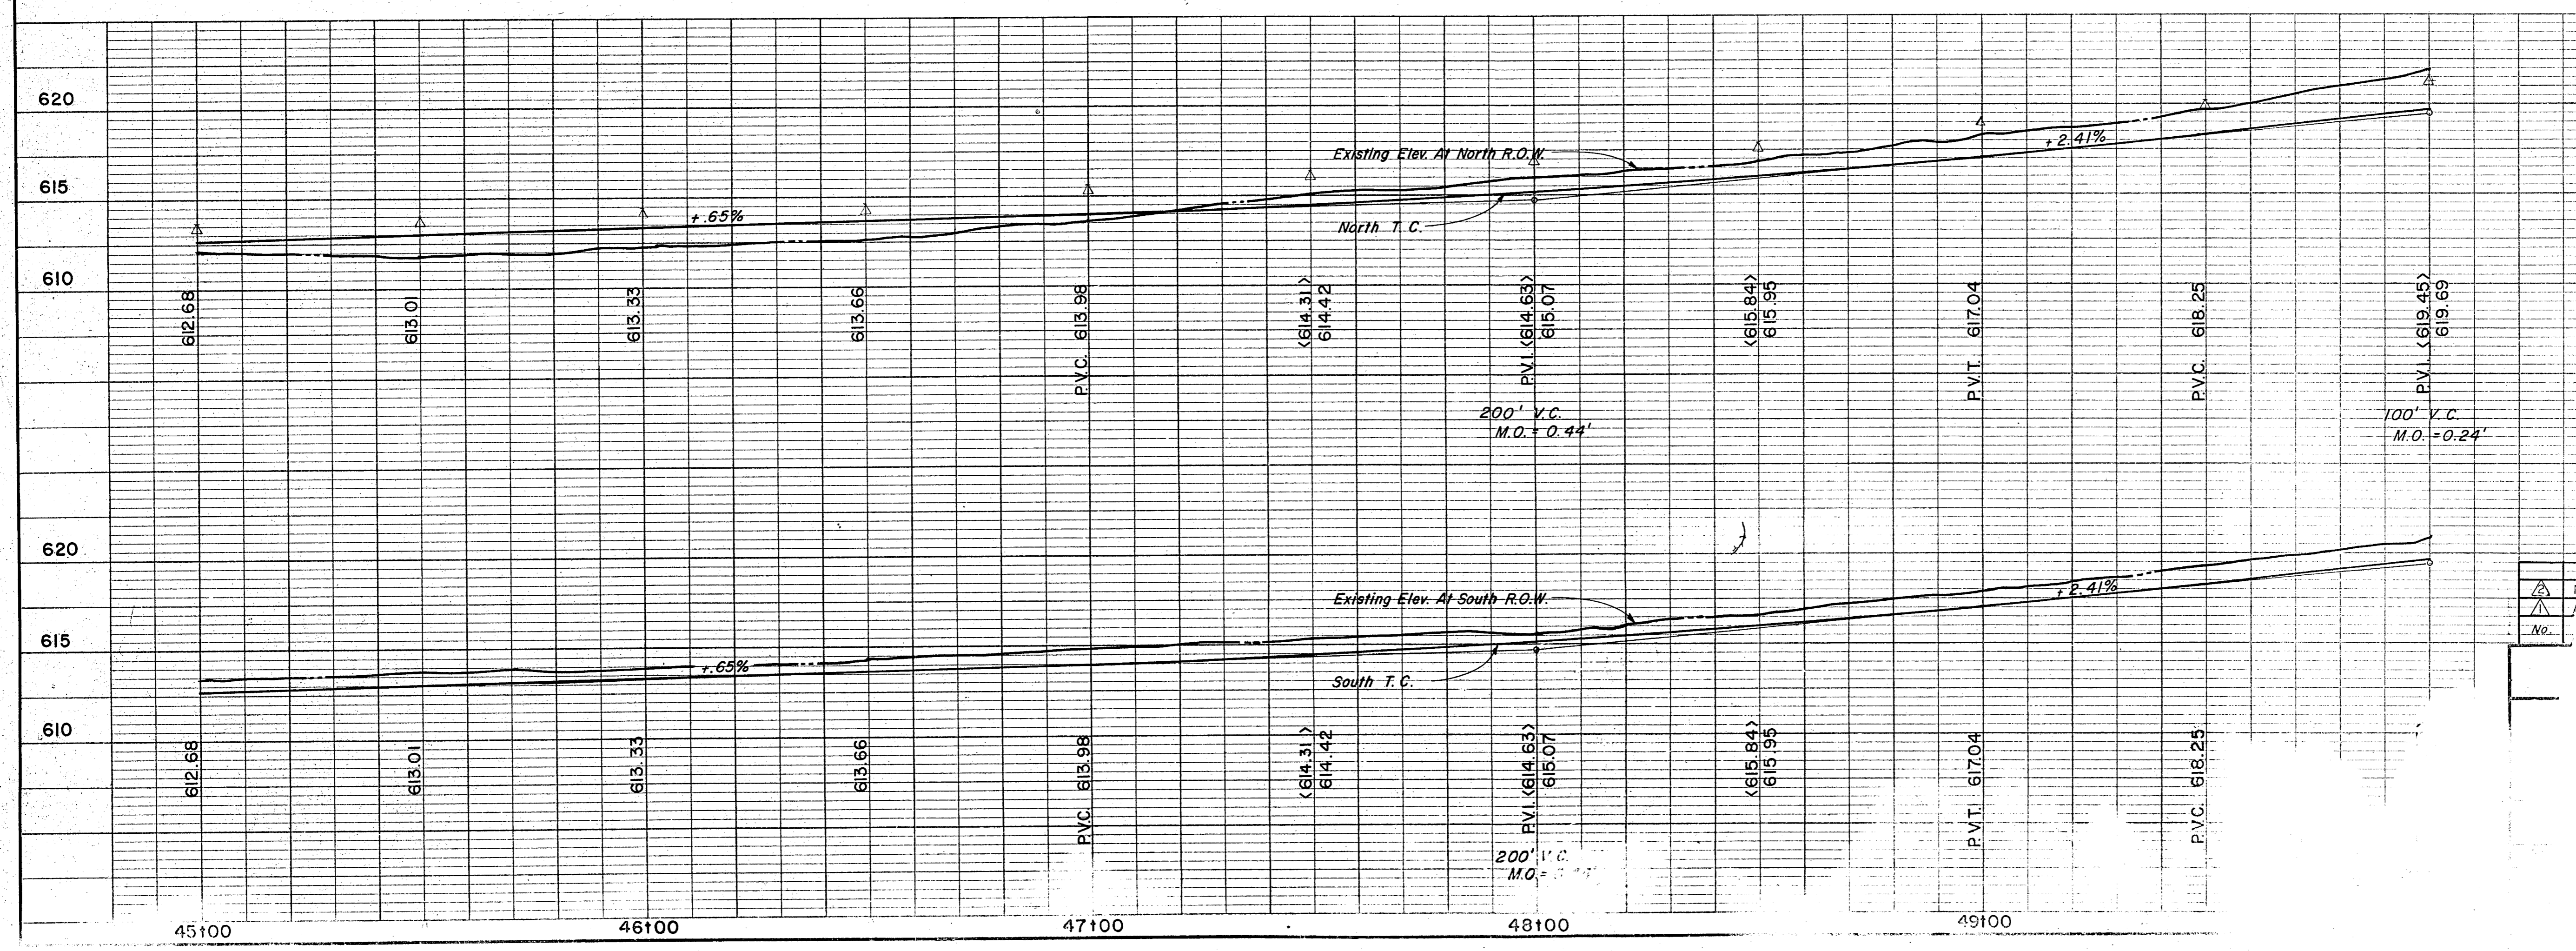

No. 5 East  
 18-50114 B Ch. 012  
 Revision  
**CITY OF ADDISON**  
**VT / OF WILL**  
 DEPARTMENT OF PUBLIC  
 PLANNING SERVICES  
 BELT LINE  
 CONSULTING