


Blk-1

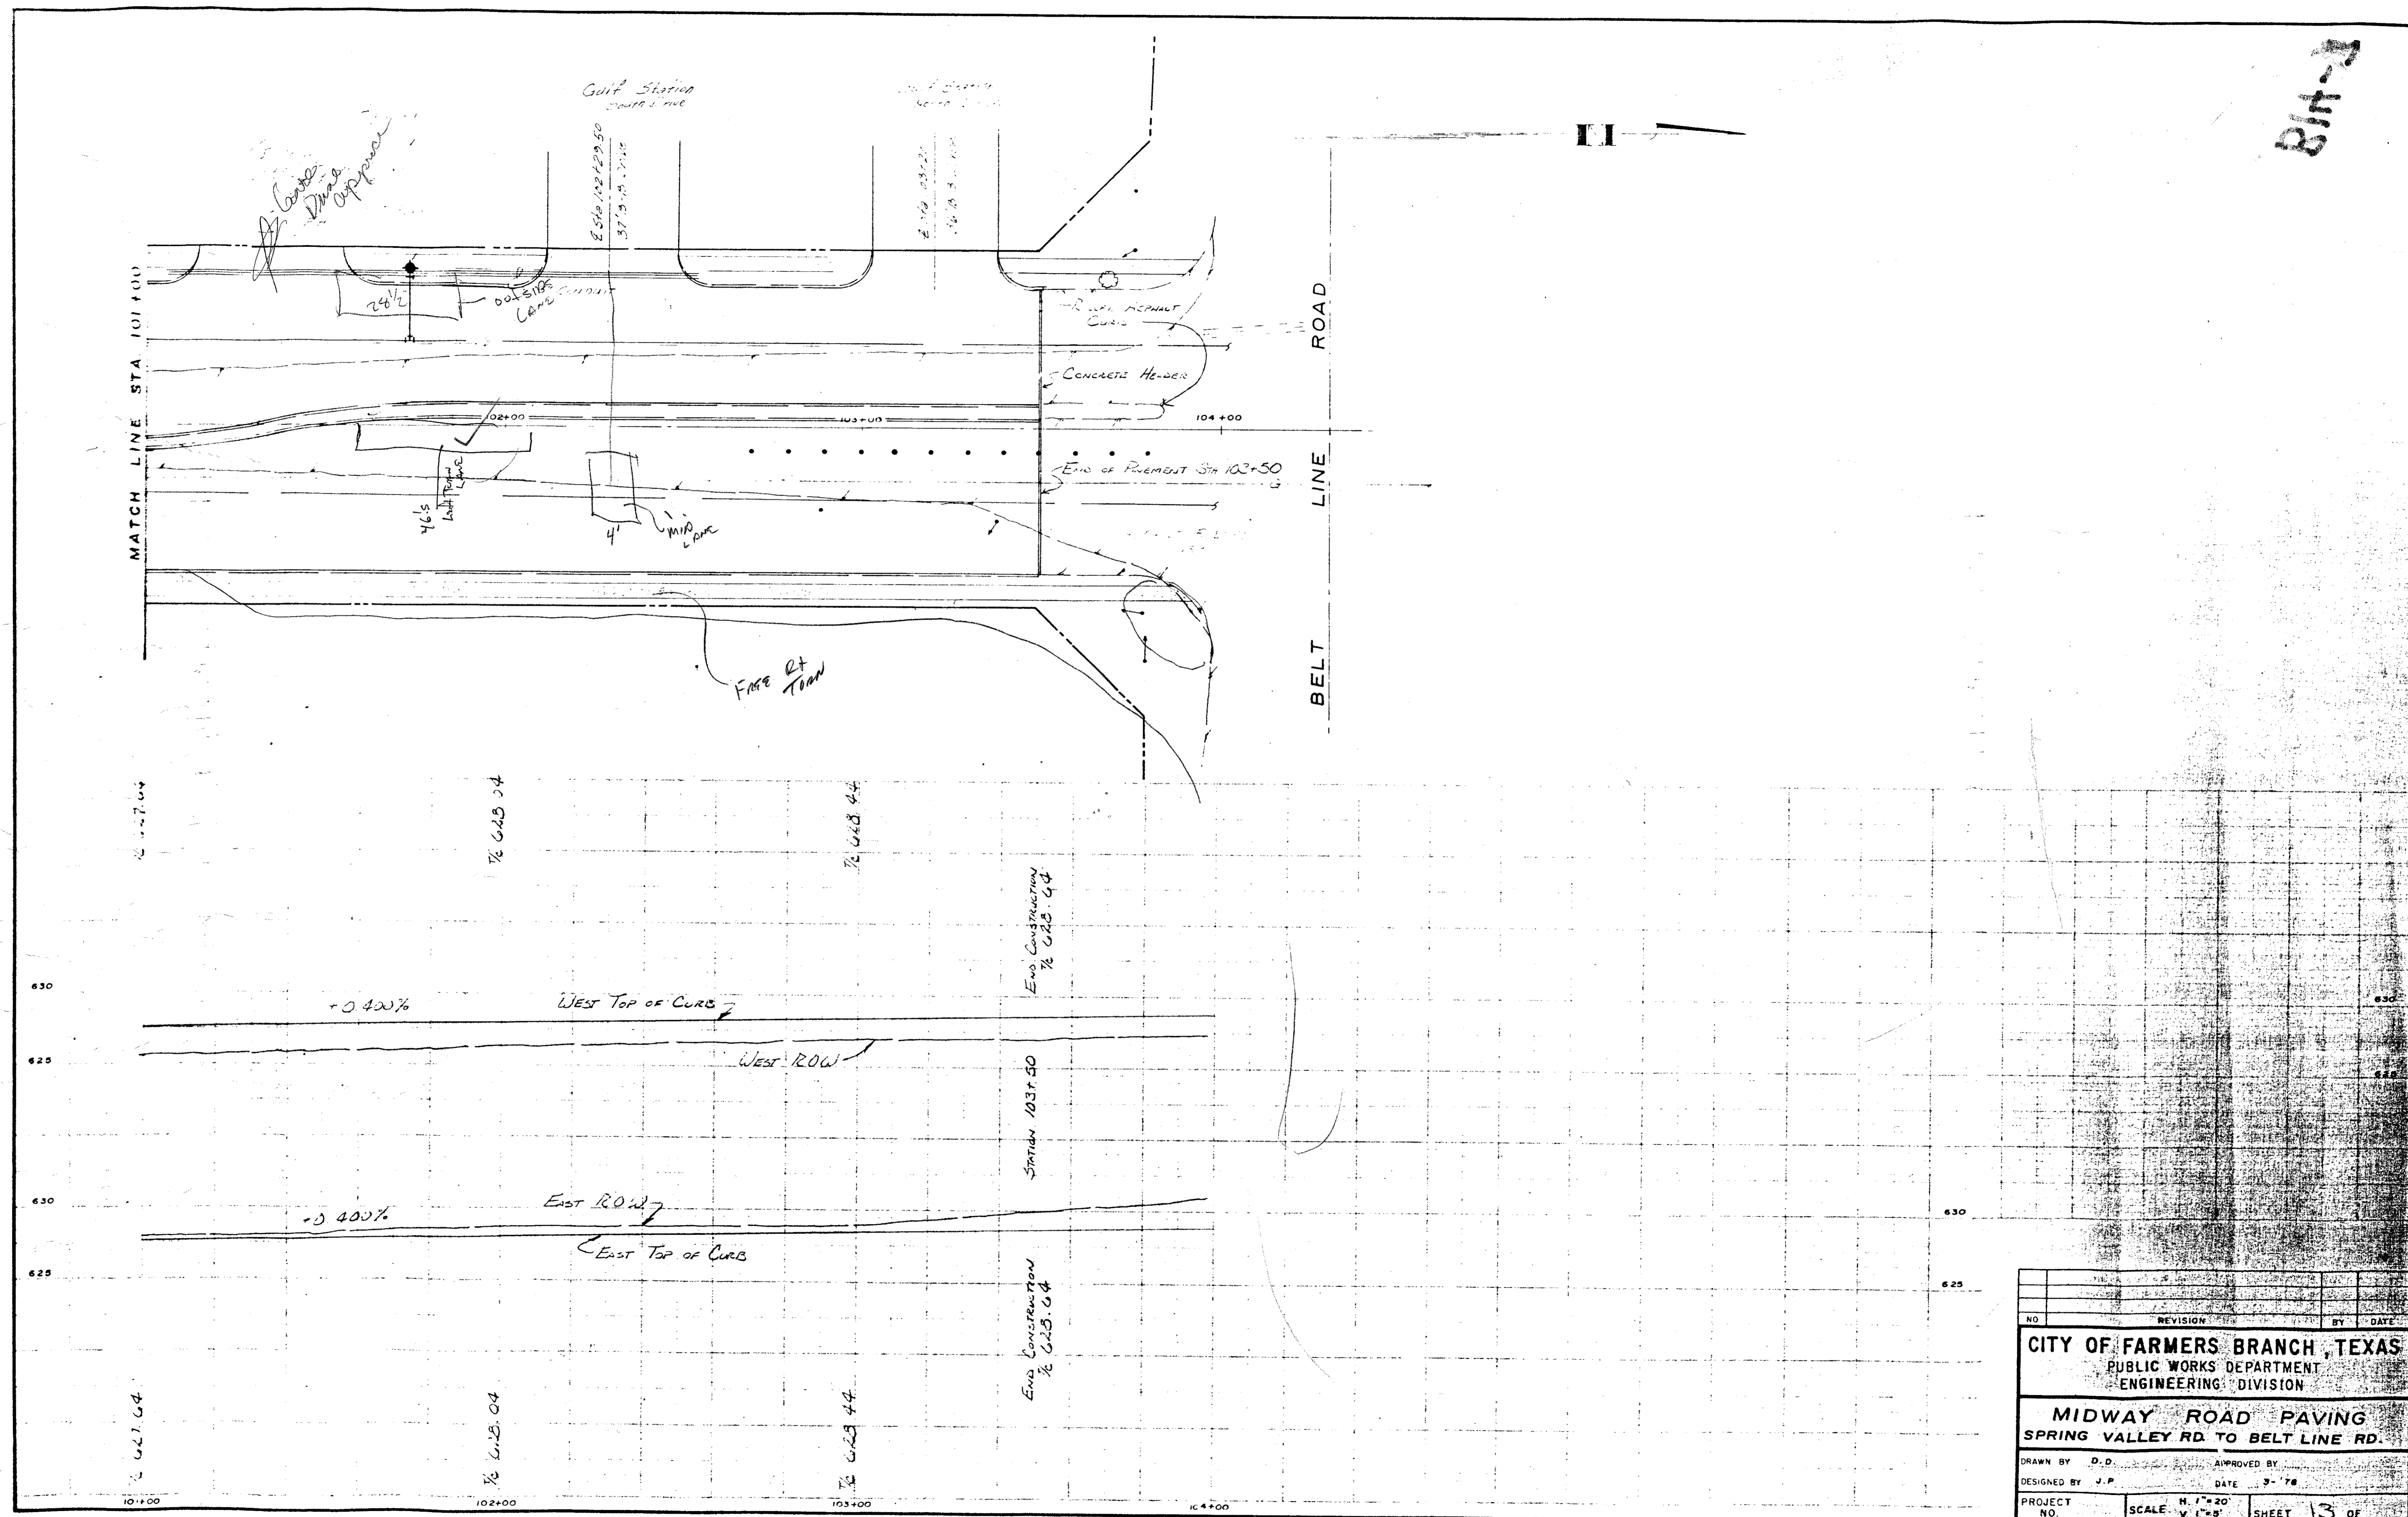

NO.	REVISION	BY	DATE
<b>CITY OF FARMERS BRANCH, TEXAS</b> PUBLIC WORKS DEPARTMENT ENGINEERING DIVISION			
<b>MIDWAY ROAD PAVING</b> SPRING VALLEY RD TO BELT LINE RD.			
DRAWN BY	D.D.	APPROVED BY	
DESIGNED BY	J.P.	DATE	3-78
PROJECT NO.	SCALE	H. 1" = 20' V. 1" = 5'	SHEET 13 OF

284