P 5153 11-72 53473-

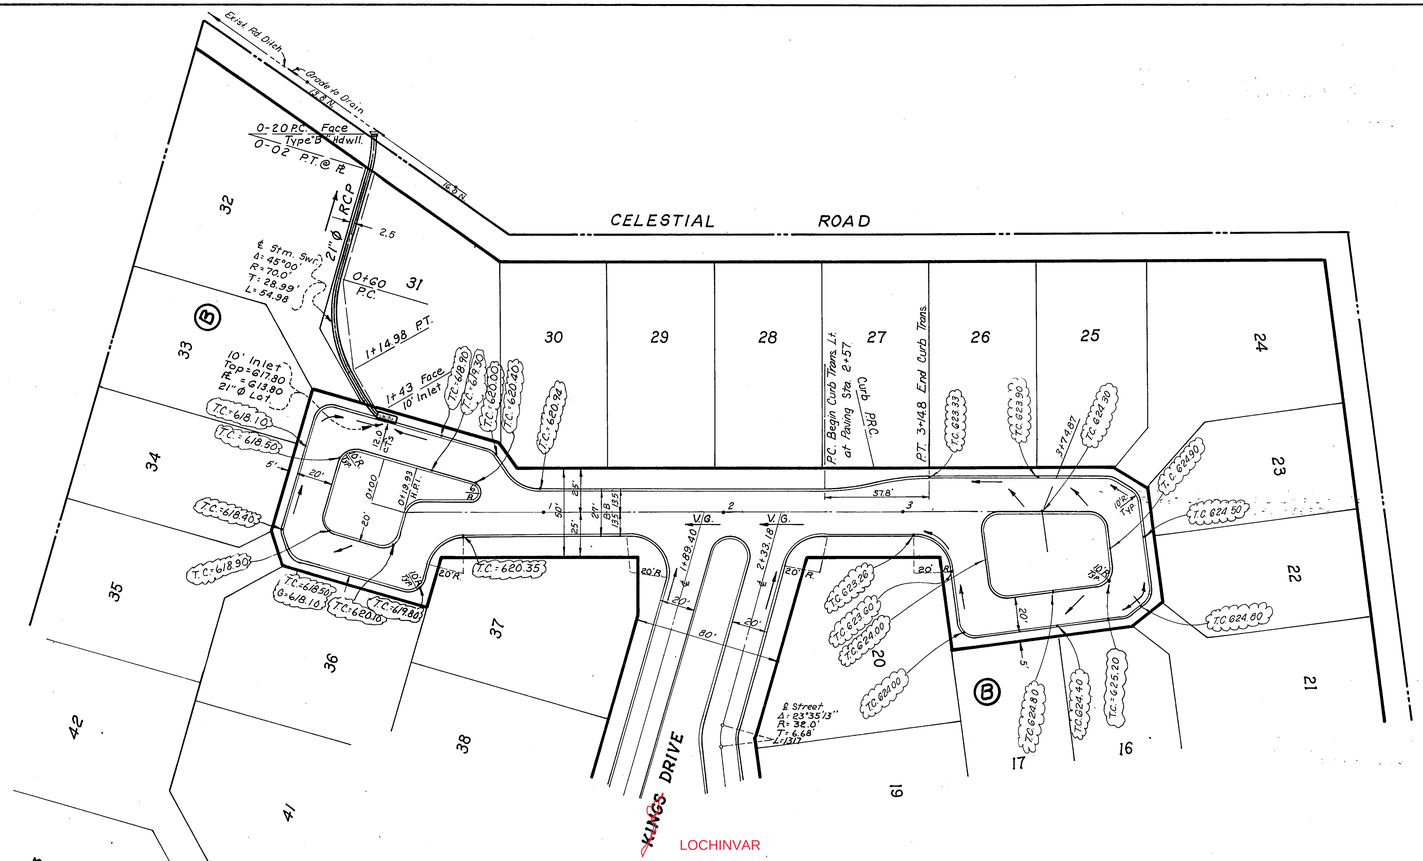

LOCHINVAR

MAIDEN ~~QUEENS~~ COURT

BEDIVERE ~~WINDSOR~~ COURT

NOTE: On All Streets W/Islands Contractor to Verify Island Configuration With Owner Prior to Start of Construction.

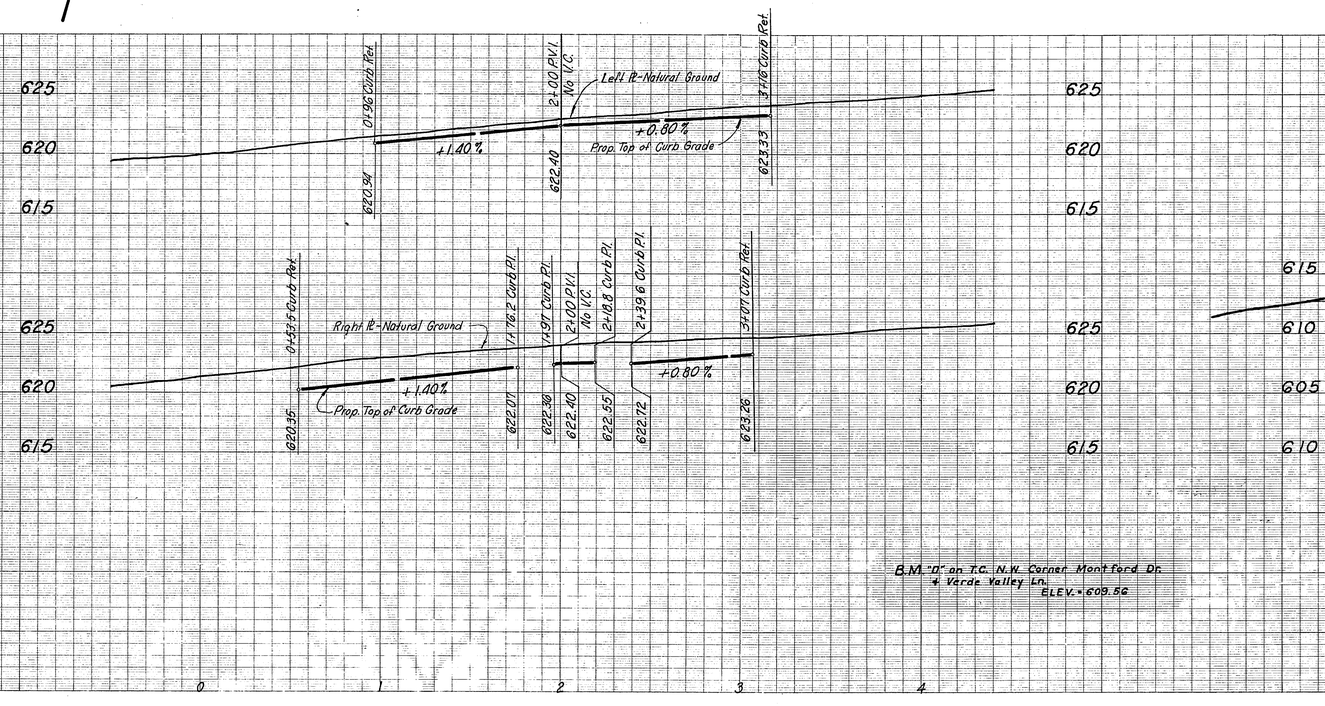

B.M. "A" on T.C. N.W. Corner Montford Dr. & Verde Valley Ln. ELEV. = 609.56

PAVING PLANS

OAKS NORTH ADDITION

ADDISON, TEXAS

John C. Gibson Co. Inc. ~ Consulting Engineers

9510 Military Parkway ~ Dallas, Texas 75227

DESIGN	DRAWN	DATE	SCALE	NOTES	FILE	NO.
A.D.M.	G.E. G.D.	Aug. 23, 1978	H:1"=40' V:1"=6'	D.B.	Oaks North Addition	10 / 16

QUEENS COURT & WINDSOR COURT + STM. SWR. #10386