


Contractor should not use boom type equipment in DP&L easement in connection with construction unless special arrangements have been made with DP&L one week prior to construction.

CAUTION - Maintain adequate clearance from DP&L electrical lines to avoid injury or damage to person or property.

REVISIONS


- △ GENERAL REVISIONS AS PER CITY OF ADDISON - 11/13/81
- △ STREET NAME CHANGES - 11/20/81
- △ ADDITION OF 10' INLET - 12/8/81

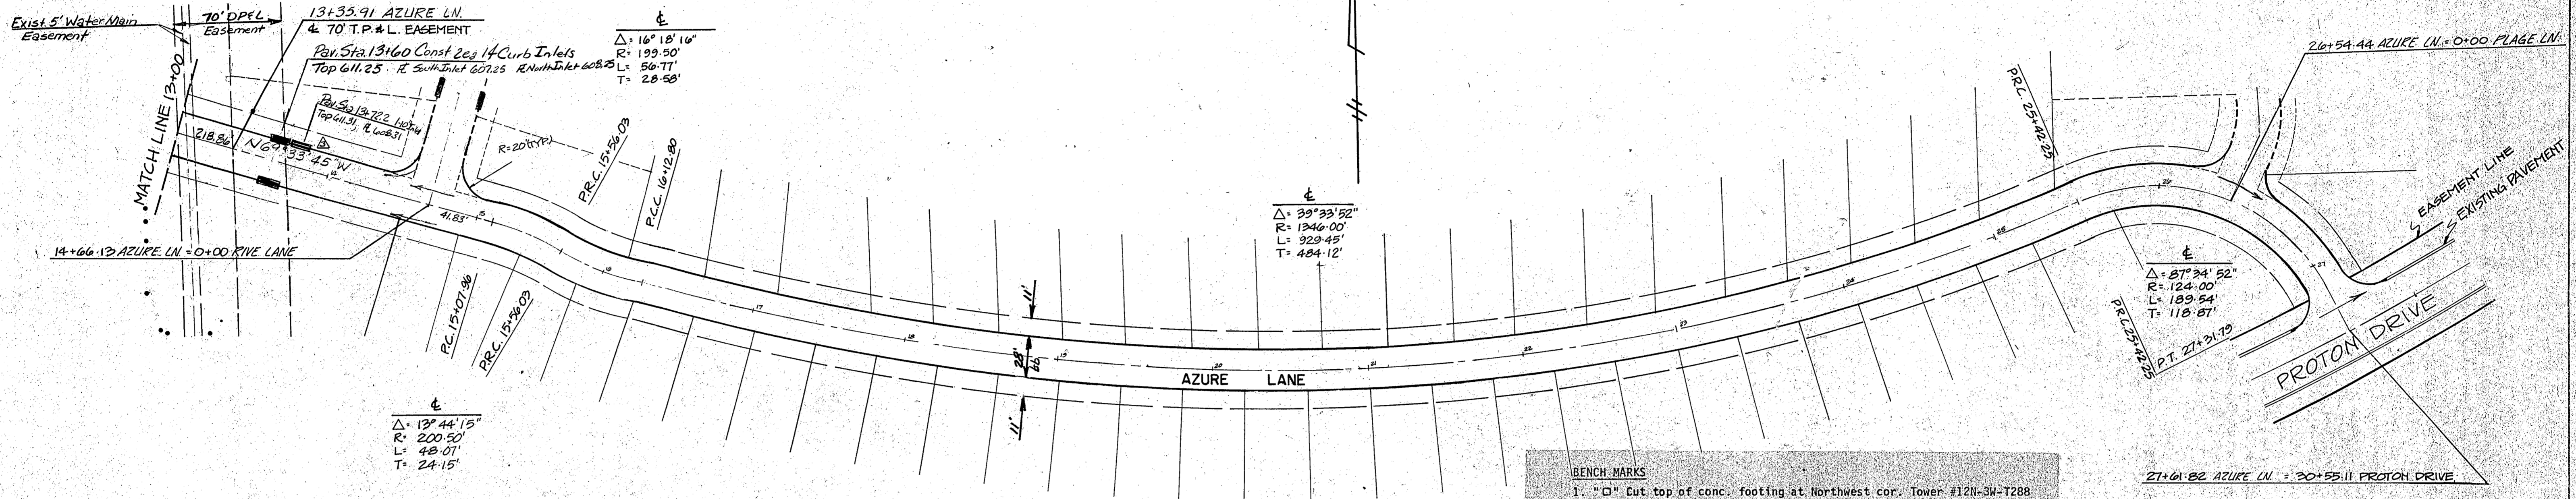


**BENCH MARKS**

1. "□" Cut top of conc. footing at Northwest cor. Tower #12N-3W-T288 ELEV. 605.20
2. "□" Cut top of conc. footing at Northwest cor. Tower #12N-3W-T290 located at the angle point of the line ELEV. 613.16
3. "□" Cut top of conc. footing at Southwest cor. Tower #12N-3W-T291 ELEV. 619.46

NOTE: ALL DIMENSIONS ARE TO BACK-OF CURB UNLESS OTHERWISE NOTED.

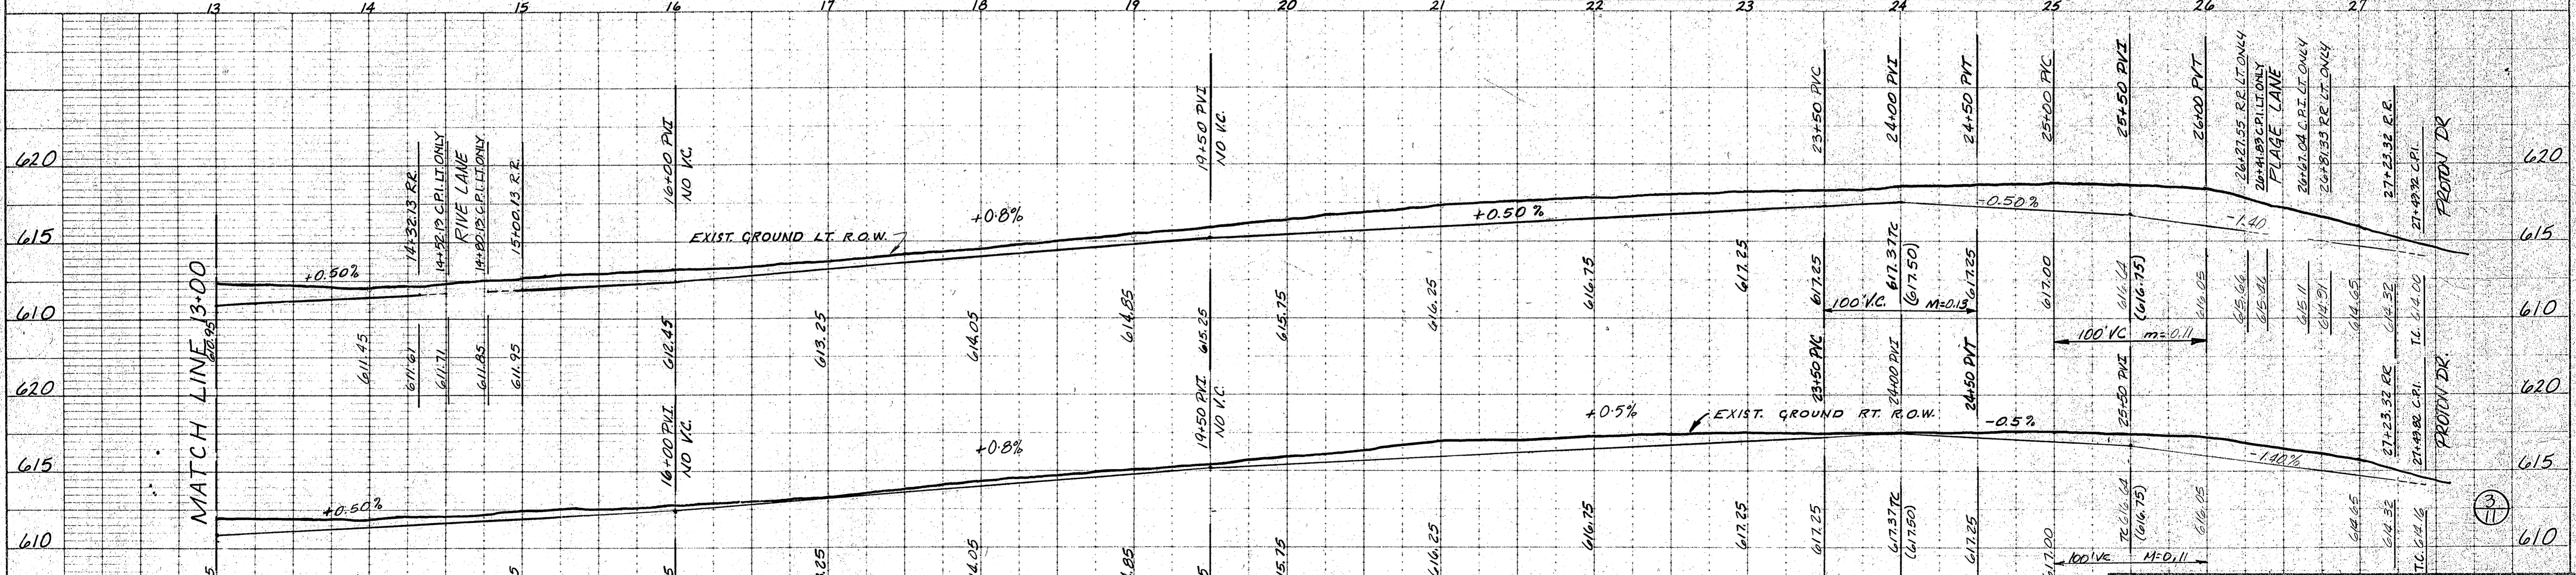

PAVING PLAN					
LES LACS GARDEN HOMES					
AZURE LANE 13+00 TO END					
CITY OF ADDISON, TEXAS					
HILL & CO. ENGINEERING SCIENCES INC.					
DESIGN	DRAWN	DATE	SCALE	NOTES	FILE NO
HILL & CO		AUG 81	HOR: 1"=50' VERT: 1"=5'	RLG	

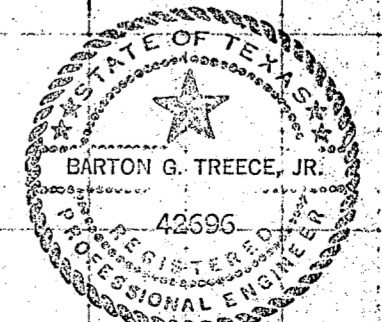

DATE	
BY	
APPROVED	
PLAN	
NOTE BOOK	
ALIGNMENT CHECKED	
BY	
BY	
NO.	

DATE	
BY	
APPROVED	
PROFILE	
NOTE BOOK	
GRADES CHECKED	
BY	
BY	
NO.	