

HUIE ADDISON ADDITION  
VOL. 84194, PG. 2175  
D.R.D. Co., Tx.


BERKLEE DR. PRIVATE  
JULIARD DRIVE PRIVATE  
JULIARD LN. PRIVATE

CURVE CHART

CHORD BEARING	CHORD	TANGENT	RADIUS	DELTA


LEGEND

EXISTING CONTOUR  
PROPOSED STORM SEWER  
EXISTING SPOT ELEV.

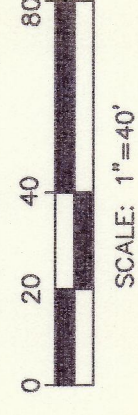

- NOTES:
1. SODDING, REPAIR AND REPLACE IN ALL CONSTRUCTION AREAS.
  2. CONTRACTOR SHALL NOT REMOVE OR DAMAGE ANY EXISTING TREES WITHOUT PERMISSION FROM THE OWNER OR ENGINEER.
  3. STORM SEWER EMBEDMENT SHALL CONFORM TO THE TOWN OF ADDISON SPECIFICATIONS.
  4. ALL CONSTRUCTION SHALL CONFORM TO THE TOWN OF ADDISON SPECIFICATIONS.

BENCHMARK:  
TOP OF OPERATING NUT ON FIRE HYDRANT,  
433' WEST AND 15' SOUTH OF S.E. CORNER  
OF PROPERTY.  
ELEVATION 606.35

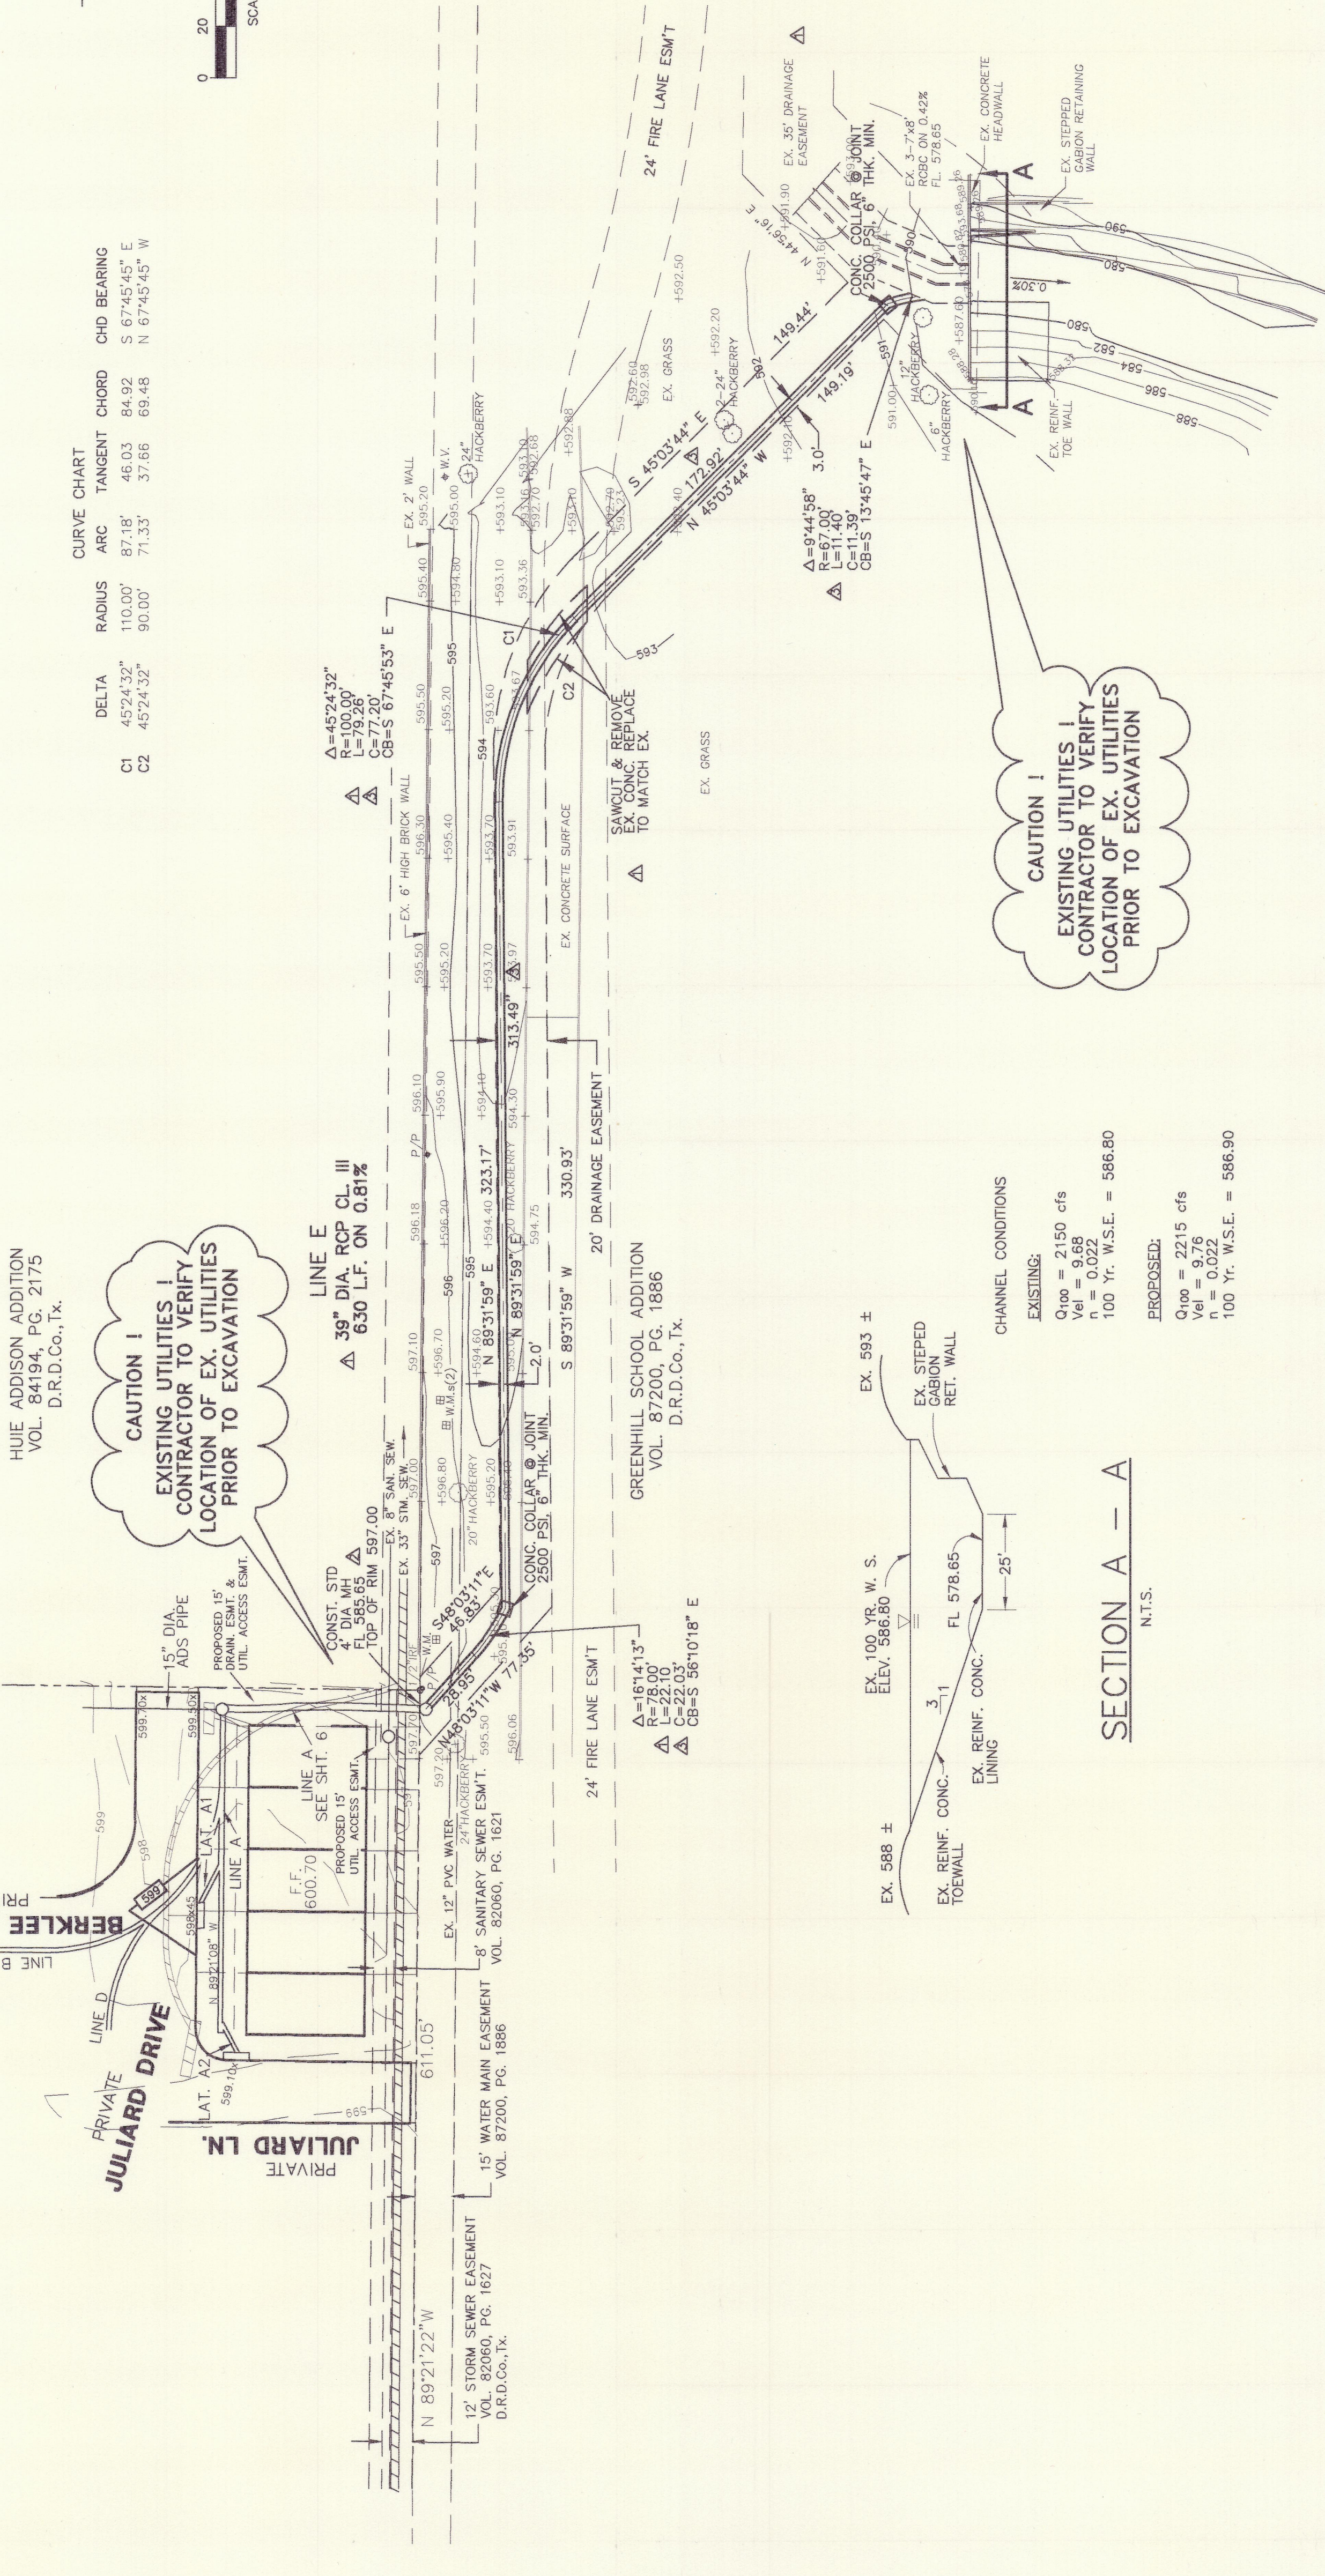

CHANNEL CONDITIONS

EXISTING:	PROPOSED:
Q <sub>100</sub> = 2150 cfs	Q <sub>100</sub> = 2215 cfs
V <sub>100</sub> = 9.68	V <sub>100</sub> = 9.76
n = 0.022	n = 0.022
100 Yr. W.S.E. = 586.80	100 Yr. W.S.E. = 586.90

SECTION A - A  
N.T.S.



SCALE: HORI. 1"=20'  
VERT. 1"=5'

OFF-SITE STORM SEWER  
TOWN HOMES OF ADDISON

DEPARTMENT OF PUBLIC WORKS  
TOWN OF ADDISON, TEXAS

DESIGN	DATE	SCALE	NOTES	FILE	NO.
LD	SC	12/12/95	1"=40'	CCI	

REV. NO.	PROJ. NO.	DATE	DESCRIPTION
1	81215-35	7/30/96	REVISED ALIGNMENT
2		7/17/96	REVISED MH FLOWLINE
3		7/17/96	REVISED COMMENTS

THE DRAWING, SPECIFICATIONS, AND OTHER DOCUMENTS PREPARED BY COOK CONSULTANTS, INC. FOR THIS PROJECT ARE INSTRUMENTS OF SERVICE. COOK CONSULTANTS, INC. AS A PROFESSIONAL ENGINEERING FIRM, DOES NOT GUARANTEE THE ACCURACY OF THE INFORMATION AND OTHER DOCUMENTS. THESE DOCUMENTS MAY NOT BE REPRODUCED OR USED BY ANYONE FOR ANY PURPOSE WITHOUT THE EXPRESS WRITTEN CONSENT OF COOK CONSULTANTS, INC. THESE DRAWINGS ARE PROVIDED FOR "AS-BUILT" DRAWINGS BY OTHERS FOR THE CITY OF ADDISON.