


RUN OFF CALCULATIONS *

Drainage Area No.	Area (Acres)	Q ₂₅ (c.f.s.)
1	0.26	1.5
2	0.38	2.2

* Based on Mannings Equation (Q=C.I.R)
 C= Runoff Coefficient = 0.90
 I= In./Hr. for 25 yr. Storm & 10 min. Time of Concentration = 6.50

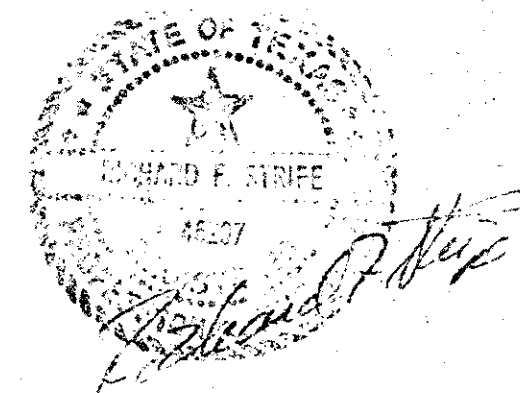

2 21 84 FIELD ORDER #1

DRAINAGE AREA MAP

QUORUM 14881

ADDISON PUBLIC WORKS DEPARTMENT
 CITY OF ADDISON, TEXAS

DESIGN	DRAWN	DATE	SCALE	NOTES	FILE	NO.
I.E. Inc.	JPL	Oct. '83	1"=20'	I.E. Inc.		C4

