


DEVELOPMENT PLANS FOR MARRIOTT RESIDENCE

ADDISON, TEXAS

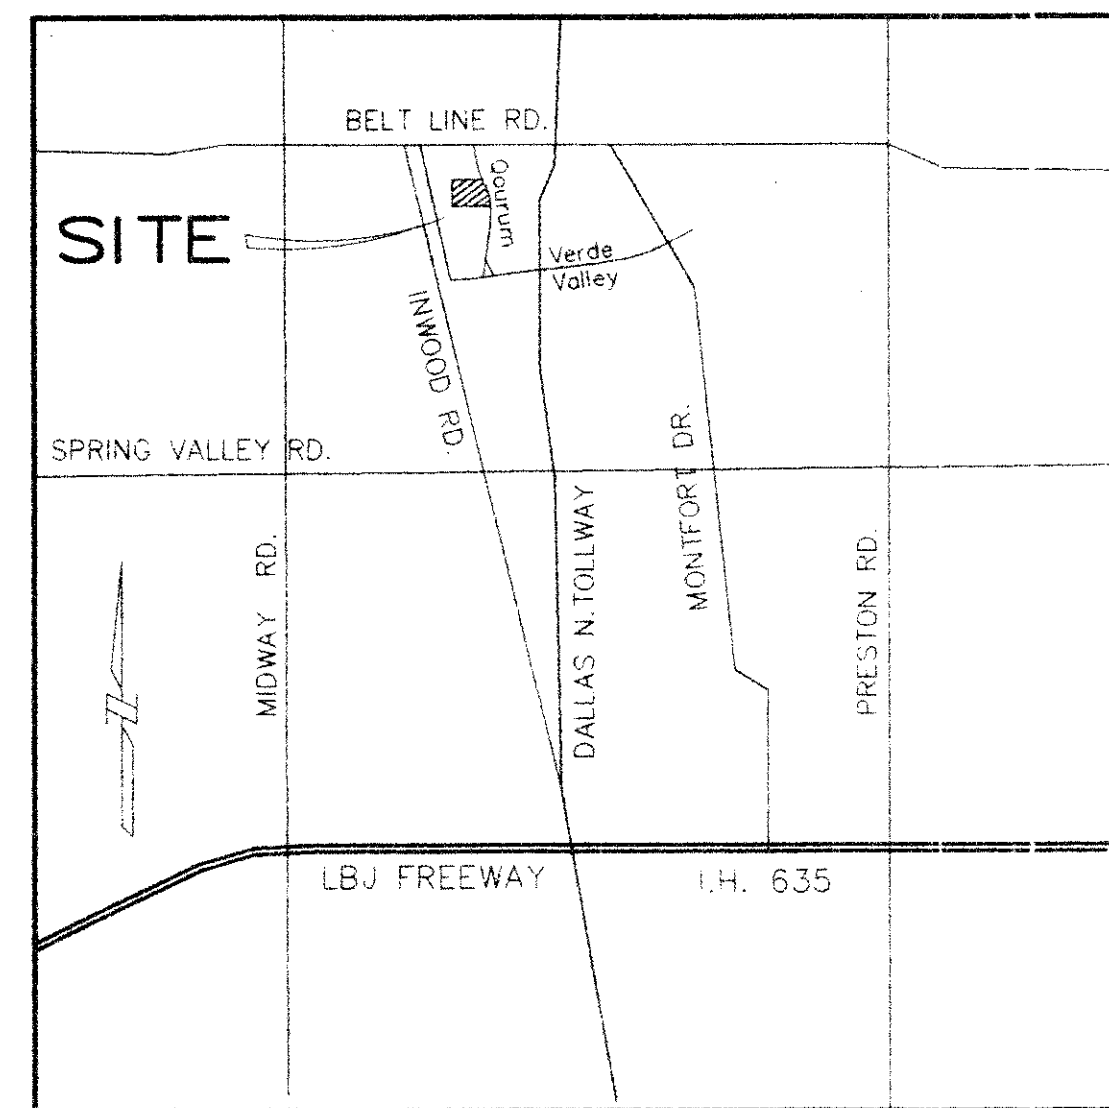

VICINITY MAP
N.T.S.

PREPARED FOR:
ADHOTEL ASSOCIATES, LTD.
12850 SPURLING ROAD, SUITE 114
DALLAS, TEXAS 75230

INDEX SHEET NO. DESCRIPTION

1. COVER SHEET
2. FINAL PLAT
3. DIMENSION CONTROL
4. GRADING & STORM SEWER PLAN
5. DRAINAGE AREA MAP
6. WATER & SANITARY SEWER PLAN
7. STORM SEWER PROFILES
8. EROSION CONTROL & RESTORATION PLAN

1. Prior to C.O. a utility easement shall be prepared and dedicated to the town of Addison for the fire loop ^{and} water meter assemblies.
2. Prior to C.O. certification from the design professional shall be provided that a 25dB noise level reduction was achieved.

COOK CONSULTANTS, INC.
CIVIL AND STRUCTURAL ENGINEERING
LAND SURVEYING AND LAND PLANNING
12250 Inwood road - suite 10 Dallas, Texas 75244
[214] 387-1890 fax [214] 387-5210

JUNE 1995

DATE: _____
ISSUED BY
TOWN OF ADDISON
PUBLIC WORKS DEPARTMENT
CONSTRUCTION SET

CONSTRUCTION SET
ISSUED BY
TOWN OF ADDISON
PUBLIC WORKS DEPARTMENT
NAME: JEB DATE: 6-9-95