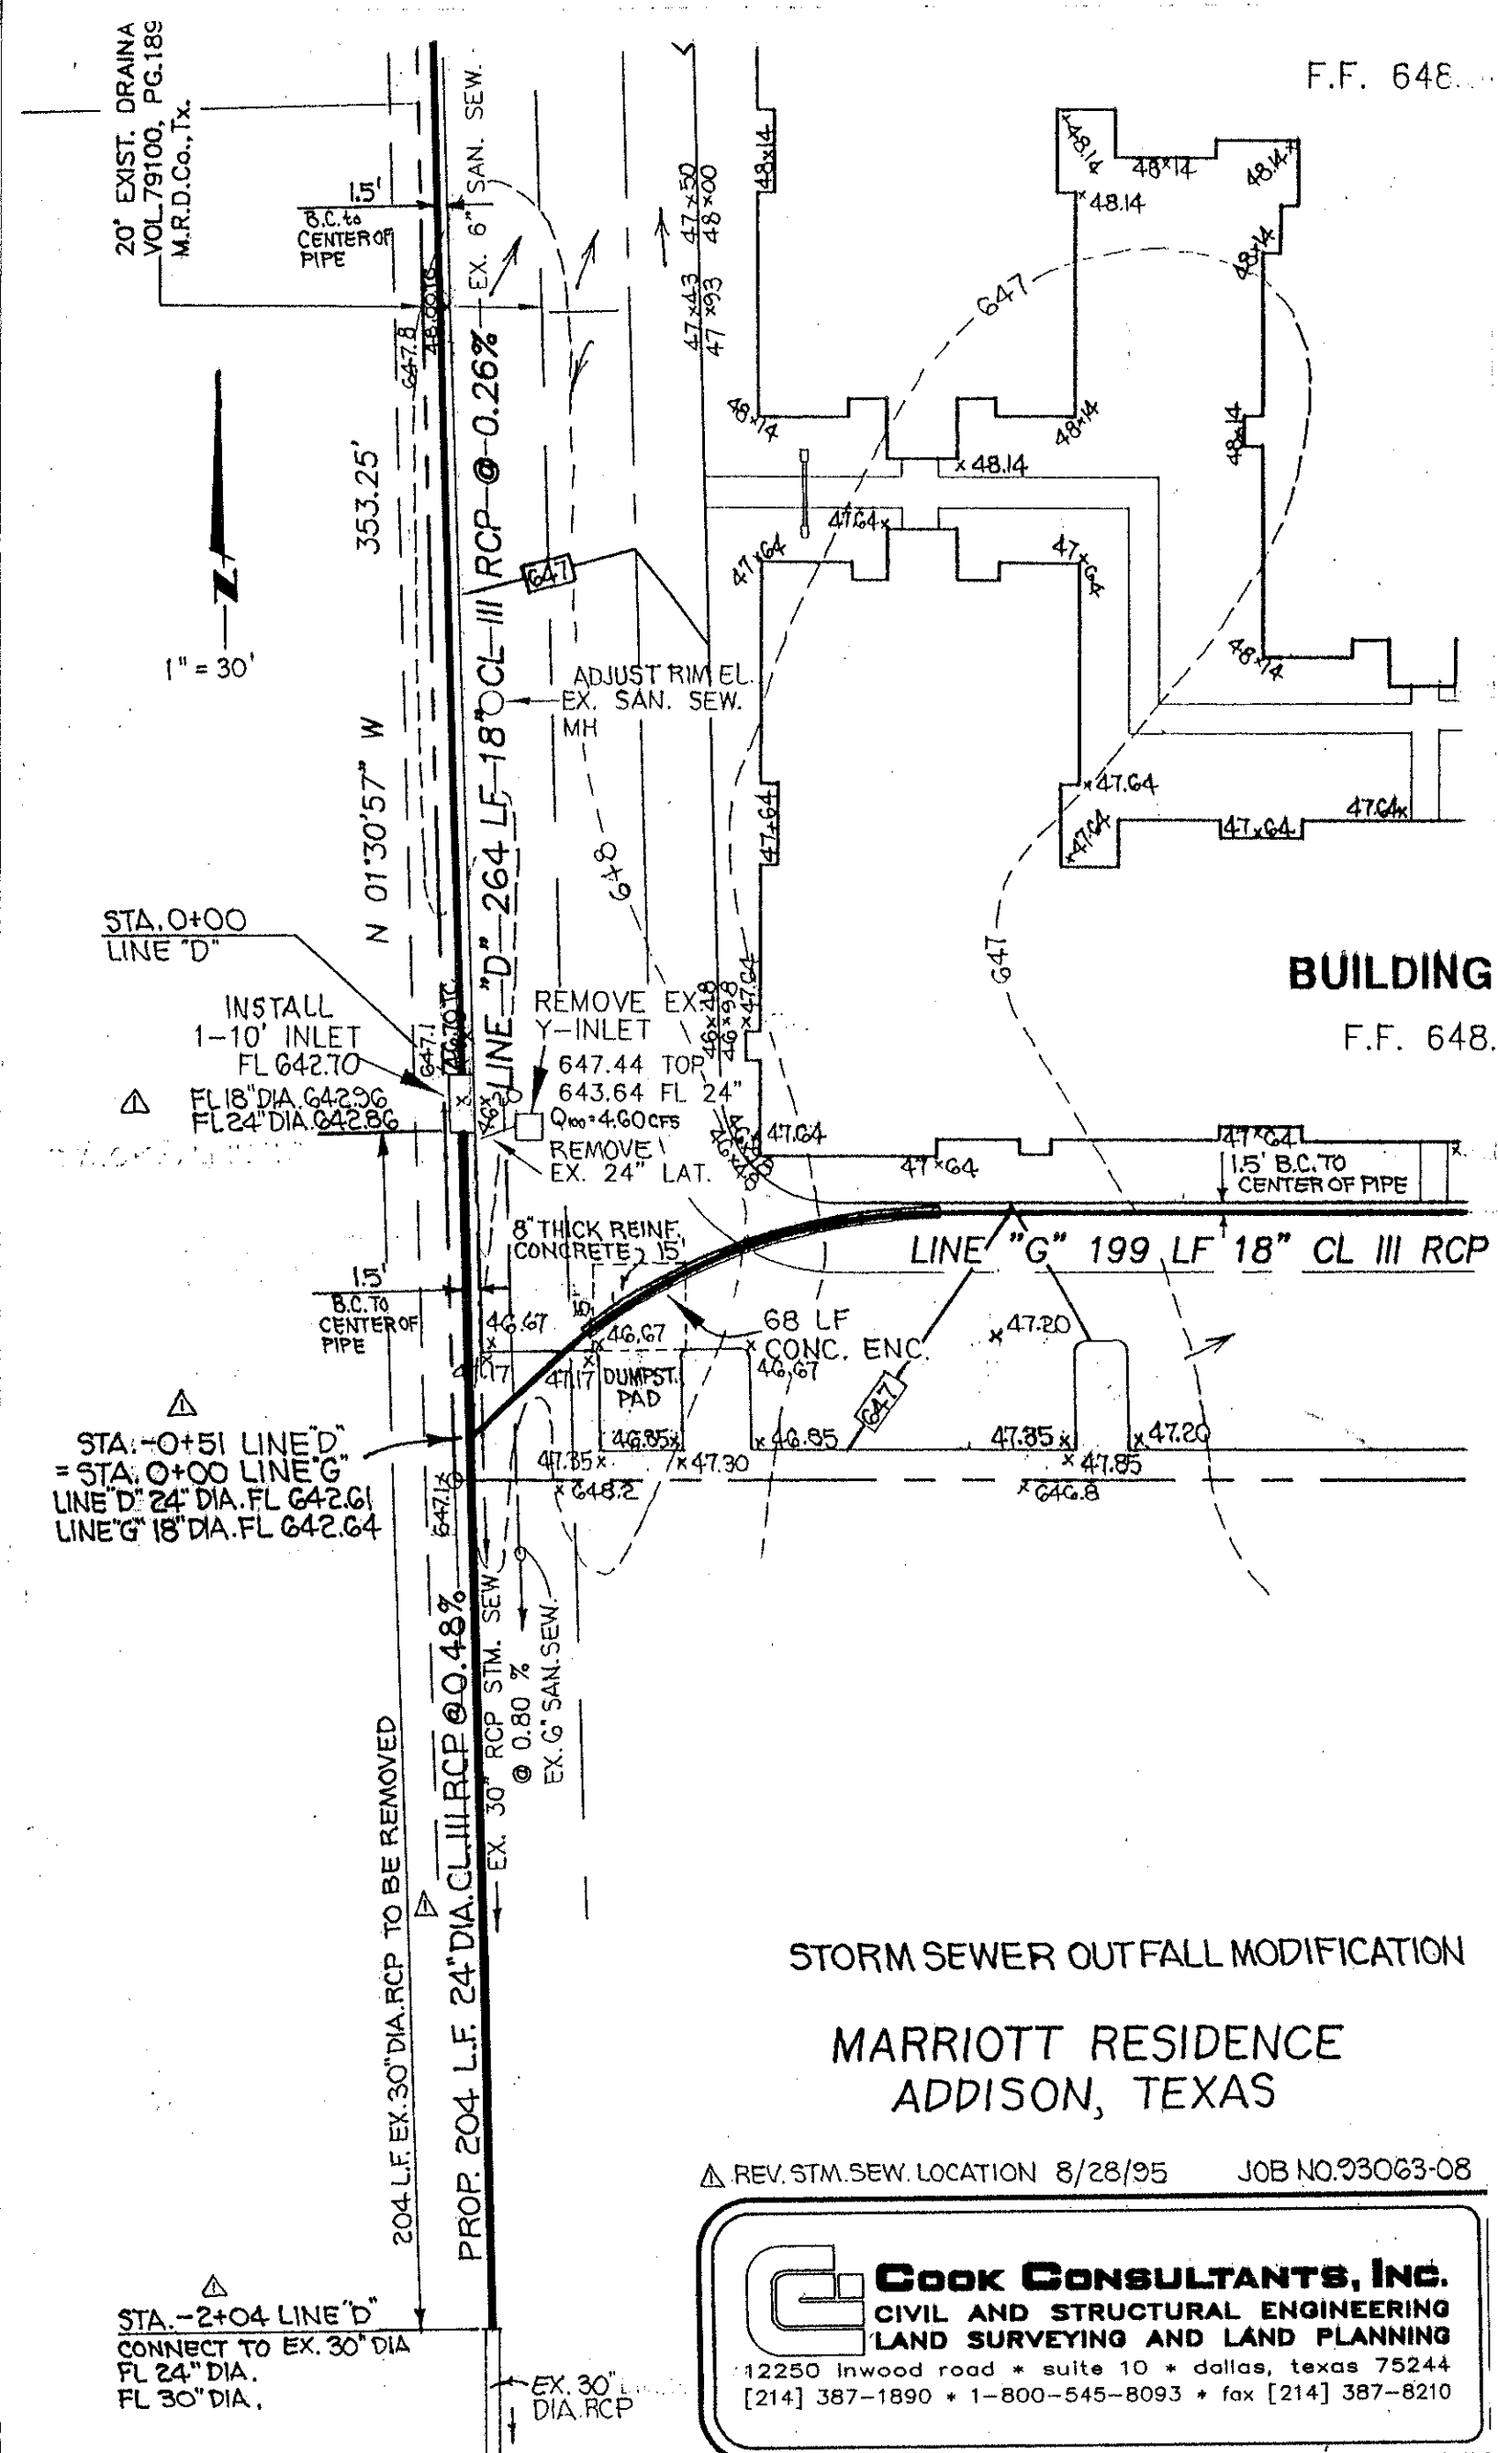

STORM SEWER OUTFALL MODIFICATION

MARRIOTT RESIDENCE
ADDISON, TEXAS

⚠ REV. STM. SEW. LOCATION 8/28/95

JOB NO. 93063-08

COOK CONSULTANTS, INC.
CIVIL AND STRUCTURAL ENGINEERING
LAND SURVEYING AND LAND PLANNING
12250 Inwood road * suite 10 * dallas, texas 75244
[214] 387-1890 * 1-800-545-8093 * fax [214] 387-8210