


LEGEND

- INSTALL 8" NCTCOG P1 4000psi (NCTCOG P2 4500psi IF HAND FINISHED) REINFORCED CONCRETE PAVEMENT WITH #3 BARS @ 18" O.C.E.W.
- INSTALL 7" 3600psi REINFORCED CONCRETE PAVEMENT WITH #3 BARS @ 18" O.C.E.W.
- INSTALL 5" 3600psi REINFORCED CONCRETE PAVEMENT WITH #3 BARS @ 18" O.C.E.W.
- INSTALL 4" 3000psi REINFORCED CONCRETE PAVEMENT WITH #3 BARS @ 24" O.C.E.W.
- (REF LANDSCAPE PLANS FOR SIDEWALK PAVERS AND FINISHES DETAILS)
- PROPOSED INTEGRAL CURB
- LIMITS OF PAVEMENT SAWCUT
- PROPOSED FIRELANE
- 1. INSTALL BARRIER FREE RAMP WITH CAST IN PLACE DETECTABLE/TACTILE SURFACE WARNING TILE BY ARMOR-TILE TACTILE SYSTEMS PER T.O.A.
- 2. INSTALL WHEEL STOP (SEE SHEET C8.00 FOR DETAILS)
- 3. INSTALL HC PARKING SIGN (SEE SHEET C8.00 FOR DETAILS)
- FL. LANDSCAPE AREA DRAIN (REF LANDSCAPE PLANS)
- FL. FIRE LANE

BENCHMARKS:
 BM#1
 BRASS DISC AT THE SOUTHWEST CORNER OF A 10' CURB INLET, ON THE WEST SIDE OF QUORUM DRIVE, 186 FEET ± SOUTH OF EDWIN LEWIS ROAD AS SHOWN.
 ELEVATION = 630.11

RLG RAYMOND L. GOODSON JR., INC.
 CONSULTING ENGINEERS
 12001 N. CENTRAL EXPRESSWAY, SUITE 300
 DALLAS, TEXAS 75243 214/739-8100
 E-MAIL: rlg@rlginc.com FIRM REG. F-493

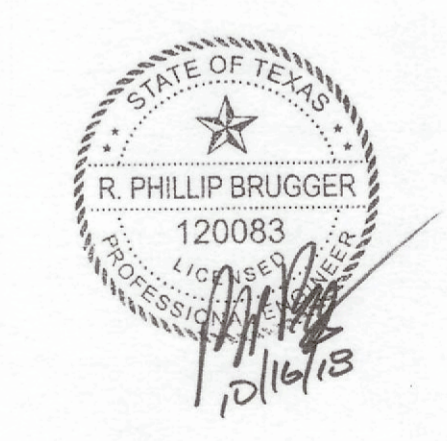

ADDISON
 APPROVED FOR CONSTRUCTION
 INFRASTRUCTURE & DEVELOPMENT SERVICES
 BY:
 DATE: 10/16/18

IN APPROVING THESE PLANS, THE TOWN OF ADDISON ASSUMES NO RESPONSIBILITY FOR THEIR ADEQUACY, WHICH REMAINS WITH THE ENGINEER OF RECORD.
 16801 WESTGROVE DRIVE, ADDISON, TX 75001 - (972) 450-2871

PAVING & DIMENSIONAL CONTROL PLAN						
WESTERN INTERNATIONAL OFFICE BUILDING						
WESTERN INTERNATIONAL						
MAYSE & ASSOCIATES INC.						
TOWN OF ADDISON, TEXAS						
DESIGN	DRAWN	DATE	SCALE	XREF	FILE	NO.
RLG	RLG	10/16/18	1"=20'	1813.013	1813	013
JOB NO. 1813.013		SUBMITTAL:				

P:\DWG\2018\1015101\01 Western International Office Building - Redesign\DWG\1\2200 PAVING & DIMENSIONAL CONTROL PLAN.dwg 10/15/2018 10:45:54
 M. Cheneau, Ego