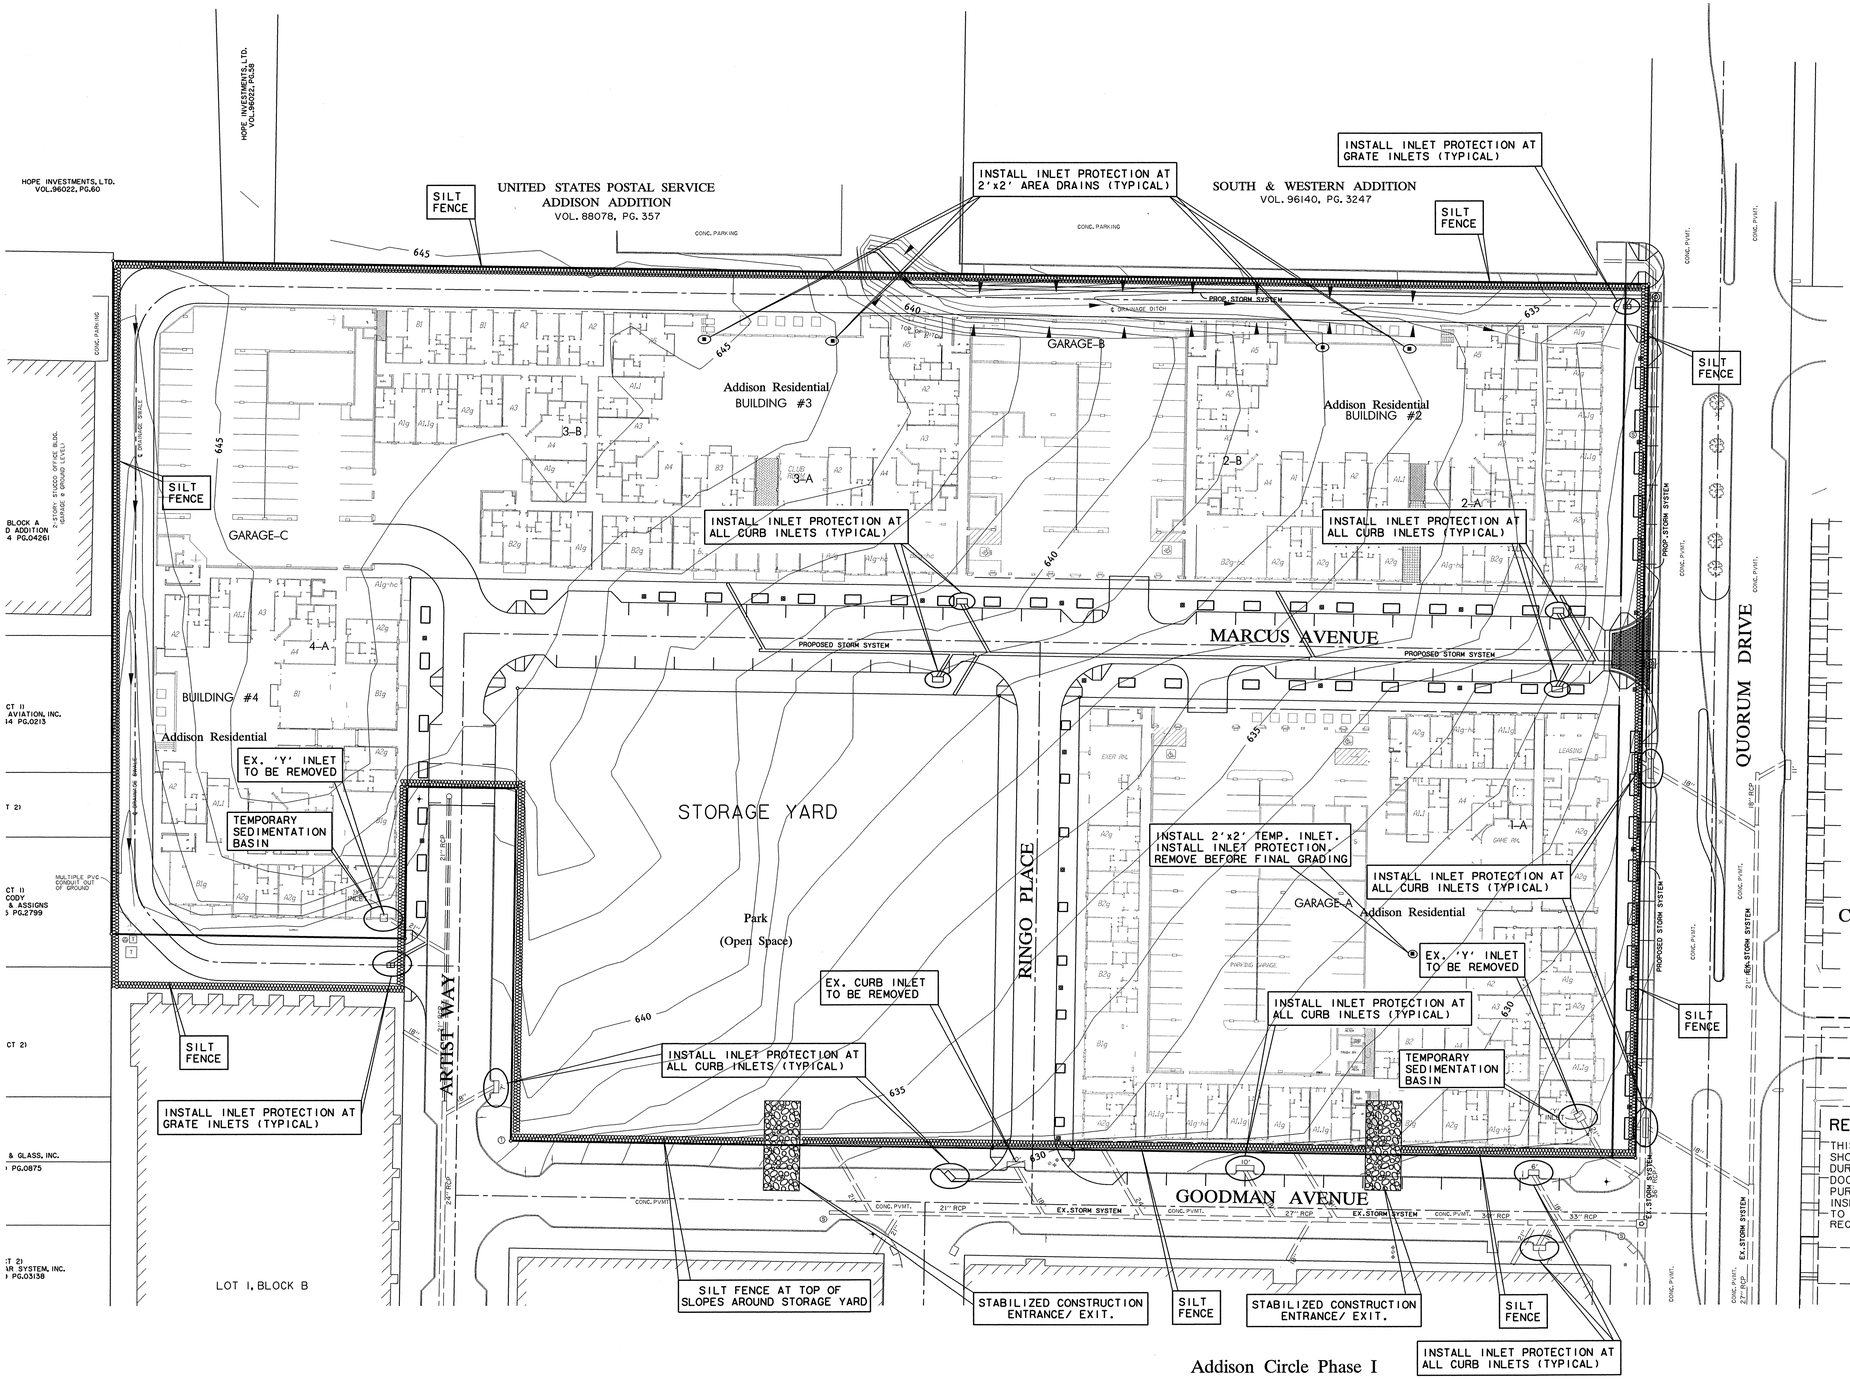

Addison Circle Phase I

N

0 20 40 60 80
SCALE IN FEET

SCALE: 1" = 40'

NOTES:

1. SEE DRAINAGE AREA MAP FOR DRAINAGE AREAS AND CALCULATIONS.
2. SEE EROSION CONTROL DETAILS FOR TYPES OF INLET PROTECTION.
3. STOCKPILED SOIL WILL BE STORED IN THE CONSTRUCTION STAGING AREA.

AREA OF DISTURBANCE = 9.24 ACRES

BENCHMARKS:

BM*5
"□" CUT ON 8' INLET ON NORTH CURB LINE OF GOODMAN AVE. ±75' EAST OF PASCHAL PLACE.
ELEV. 629.98

BM*6
"□" CUT AT ℄ OF 8' INLET AT THE SOUTHWEST CORNER OF MORRIS AVE. AND WITT PLACE.
ELEV. 627.29

BM*7
"□" CUT AT WEST CORNER OF ADDISON THEATRE CENTRE PARKING LOT, SECOND ENTRANCE NORTH OF ADDISON RD.
ELEV. 637.66

RECORD DRAWING

THIS DRAWING HAS BEEN MODIFIED FROM THE ORIGINAL TO SHOW ONLY THE FIELD CHANGES AND ADJUSTMENTS MADE DURING CONSTRUCTION BY THE CONTRACTOR WHICH WERE DOCUMENTED AND FURNISHED TO THE ENGINEER FOR THE PURPOSE OF PREPARING THESE RECORD DRAWINGS. FIELD INSPECTION OF CONSTRUCTION WAS PERFORMED BY OTHERS. TO THE BEST OF OUR KNOWLEDGE AND UNDERSTANDING THESE RECORD DRAWINGS REPRESENT THE "AS-BUILT" CONDITIONS.

STATE OF TEXAS
KEVIN N. CARLSON
89232
REGISTERED
PROFESSIONAL ENGINEER
1-9-09

POLLUTION CONTROL PLAN

ADDISON RESIDENTIAL

TOWN OF ADDISON, TEXAS

Huitt - Zollars, Inc.
3131 Mckinney Ave., Suite 600, Dallas, TX 75204
Phone (214) 871-3311/Fax (214) 871-0757

DESIGN	CHECKED	APPR.	SCALE	DATE	PROJECT NO.	NO.
HZI	HZI	DEM	1"=40'	11/20/08		C37

h:\proj\0134080l\dgn\3629ECO1.DGN

PRF ROTATION=90.000000
Fx\TBL\HIDSCREEN.TBL
jpoce
h:\proj\0134080l\dgn\3629ECO1.DGN
PSBASE2, h:\proj\0134080l\dgn\3408PSBASE2.DGN, I-45
RF1, h:\proj\0134080l\dgn\3408RF1.DGN, I-2.47,-0.78-63
RF2, h:\proj\0134080l\dgn\3408RF2BASE.DGN, I-2.47,-0.78-63
SIDEWLDG1-4, h:\proj\0134080l\dgn\3629SLD01-4.DGN, I-61
SWPPSITDP1A, h:\proj\0134080l\dgn\3408PSITDP1A.DGN, I-42.6,0.-26.8
PSITBL, h:\proj\0134080l\dgn\3408PSITBL.DGN, I-7.19-63
EXSITPA, h:\proj\0134080l\dgn\3408PSITPA.DGN, I-41.42.44
CONTOURS, h:\proj\0134080l\dgn\CONTOURS.DGN, I-3-63
EXSITBL, h:\proj\0134080l\dgn\3408PSITBL.DGN, I-42.44
SWPPSITDP1, h:\proj\0134080l\dgn\3408PSITDP1.DGN, I-42.44