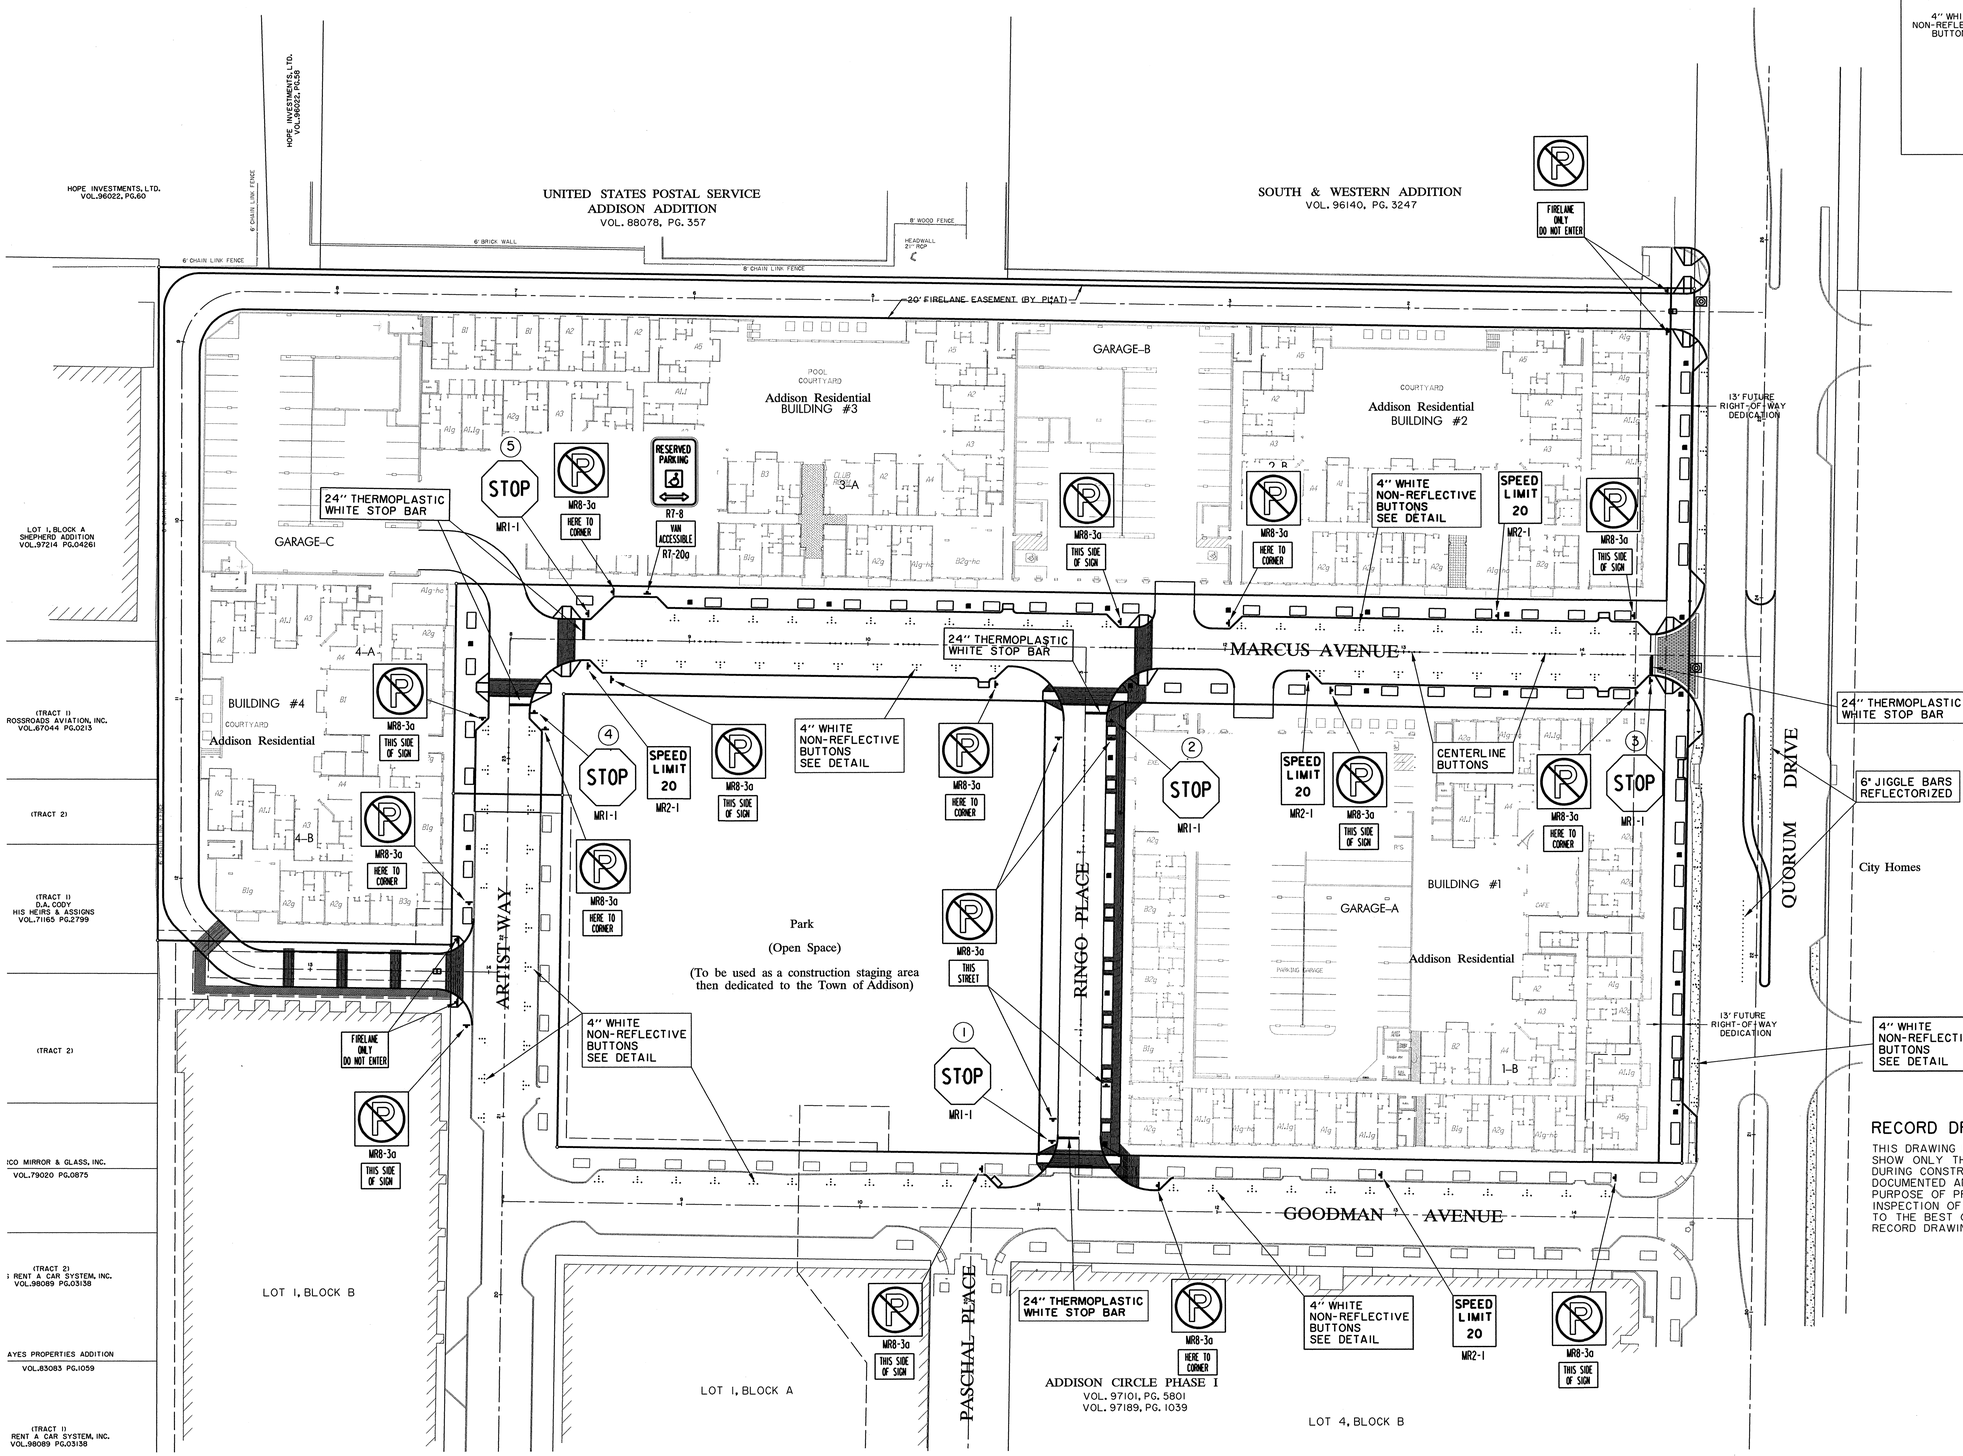

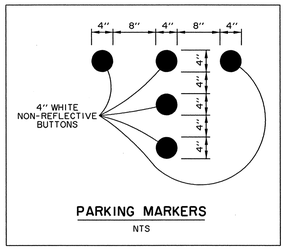

PARKING MARKERS

NTS

N

0 20 40 60 80

SCALE IN FEET

SCALE: 1" = 40'

STREET NAME SIGNS		
SIGN NO./ LOCATION	STREET NAME	MOUNTING
1	GOODMAN AVENUE	NEW SIGN POLE
	RINGO PLACE	
2	MARCUS AVENUE	NEW SIGN POLE
	RINGO PLACE	
3	MARCUS AVENUE	NEW SIGN POLE
	QUORUM DRIVE	
4	ARTIST WAY	NEW SIGN POLE
	MARCUS AVENUE	

NOTE:

EXACT SIGNAGE PLACEMENT TO BE DETERMINED IN THE FIELD BASED ON VISIBILITY CONCERNS.

BENCHMARKS:

BM#5
"□" CUT ON 8' INLET ON NORTH CURB LINE OF GOODMAN AVE. ±75' EAST OF PASCHAL PLACE.
ELEV. 629.98

BM#6
"□" CUT AT ℄ OF 8' INLET AT THE SOUTHWEST CORNER OF MORRIS AVE. AND WITT PLACE.
ELEV. 627.29

BM#7
"□" CUT AT WEST CORNER OF ADDISON THEATRE CENTRE PARKING LOT, SECOND ENTRANCE NORTH OF ADDISON RD.
ELEV. 637.66

RECORD DRAWING

THIS DRAWING HAS BEEN MODIFIED FROM THE ORIGINAL TO SHOW ONLY THE FIELD CHANGES AND ADJUSTMENTS MADE DURING CONSTRUCTION BY THE CONTRACTOR WHICH WERE DOCUMENTED AND FURNISHED TO THE ENGINEER FOR THE PURPOSE OF PREPARING THESE RECORD DRAWINGS. FIELD INSPECTION OF CONSTRUCTION WAS PERFORMED BY OTHERS. TO THE BEST OF OUR KNOWLEDGE AND UNDERSTANDING THESE RECORD DRAWINGS REPRESENT THE "AS-BUILT" CONDITIONS.

STATE OF TEXAS
KEVIN N. CARLSON
89232
REGISTERED PROFESSIONAL ENGINEER
1-9-09

SIGNAGE AND STRIPING PLAN

ADDISON RESIDENTIAL

TOWN OF ADDISON, TEXAS

Huitt - Zollars, Inc.
3131 Mckinney Ave., Suite 600, Dallas, TX 75204
Phone (214) 871-3311/Fax (214) 871-0757

DESIGN	CHECKED	APPR.	SCALE	DATE	PROJECT NO.	NO.
HZI	HZI	DEM	1"=40'	11/20/08		C7

h:\proj\01340801\dgn\3629SIGN1.DGN