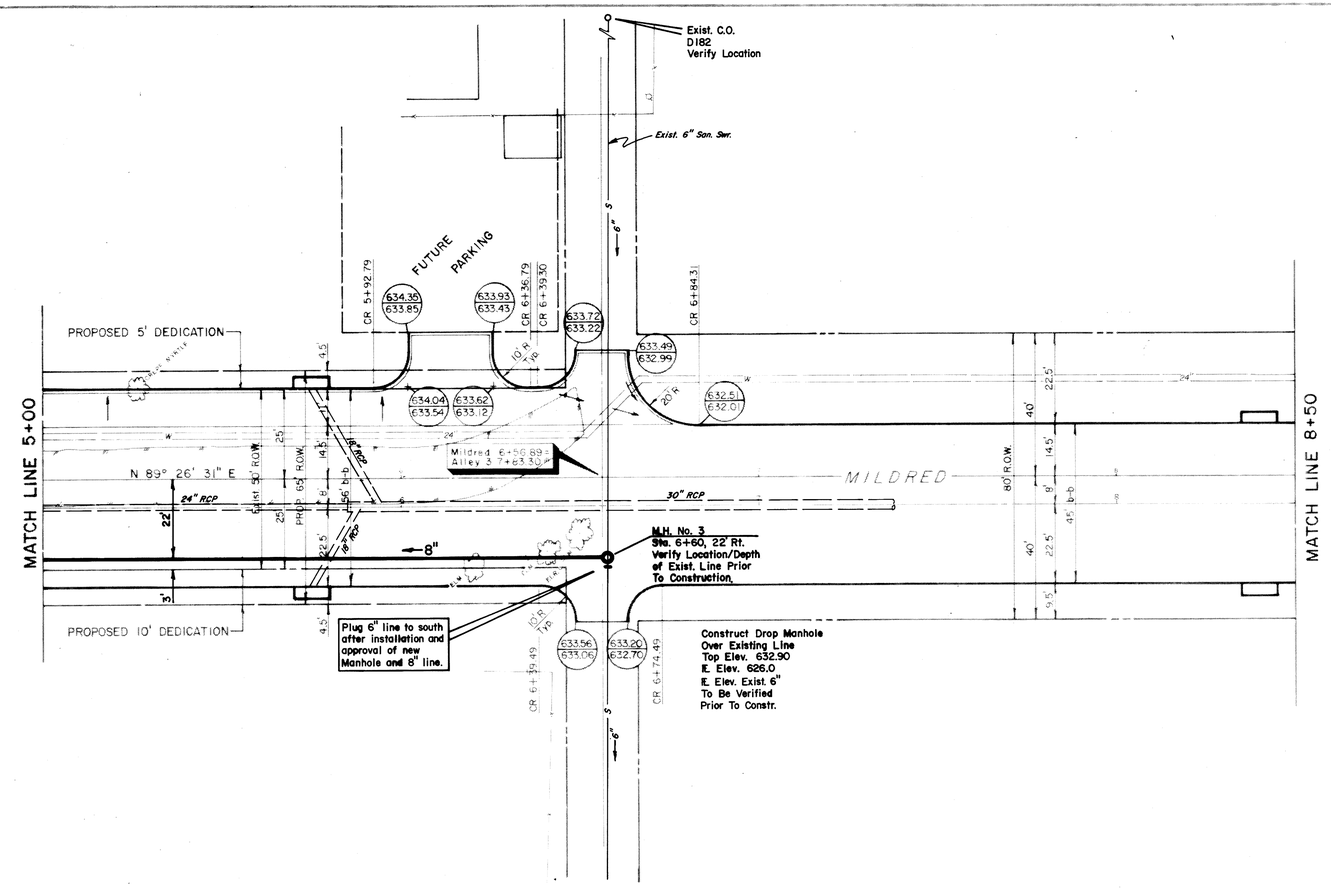

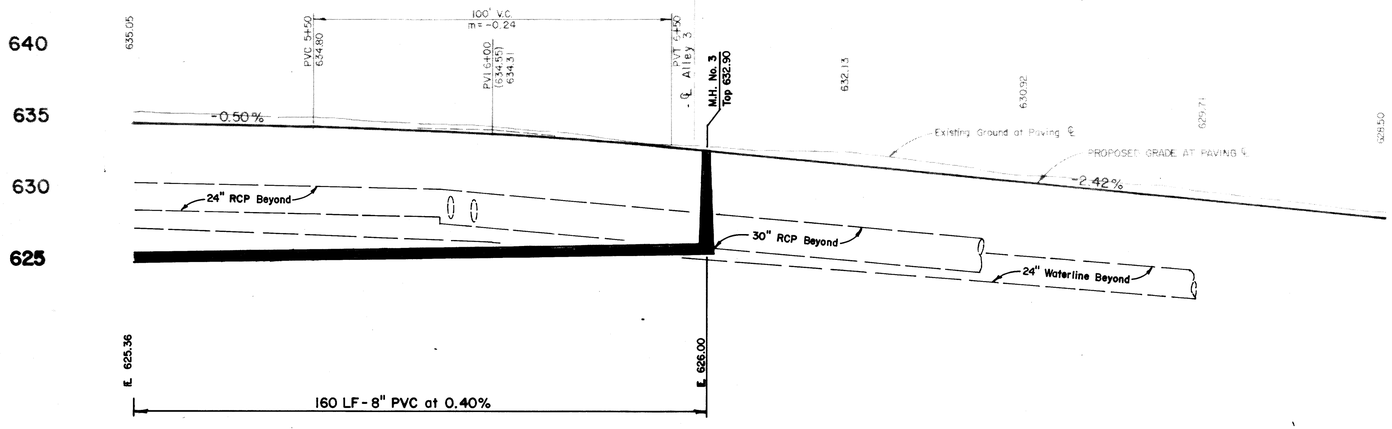

No.	Revision	By	Date

TOWN OF ADDISON
DALLAS COUNTY, TEXAS As Builts

SANITARY SEWER IMPROVEMENTS

MILDRED STREET
STA. 5+00 TO STA. 8+50

GINN, INC.
Consulting Engineers Dallas, Texas

Designed - GF	Drawn - TEC	Date - May, 1990	Job No. - 90443
Approved - HWG	Checked - GF	Scale - 1"=20'H/1"=5'V	Sheet S4 of 10

STATE OF TEXAS
WAYNE GINN
31142
REGISTERED PROFESSIONAL ENGINEER
7/24/90