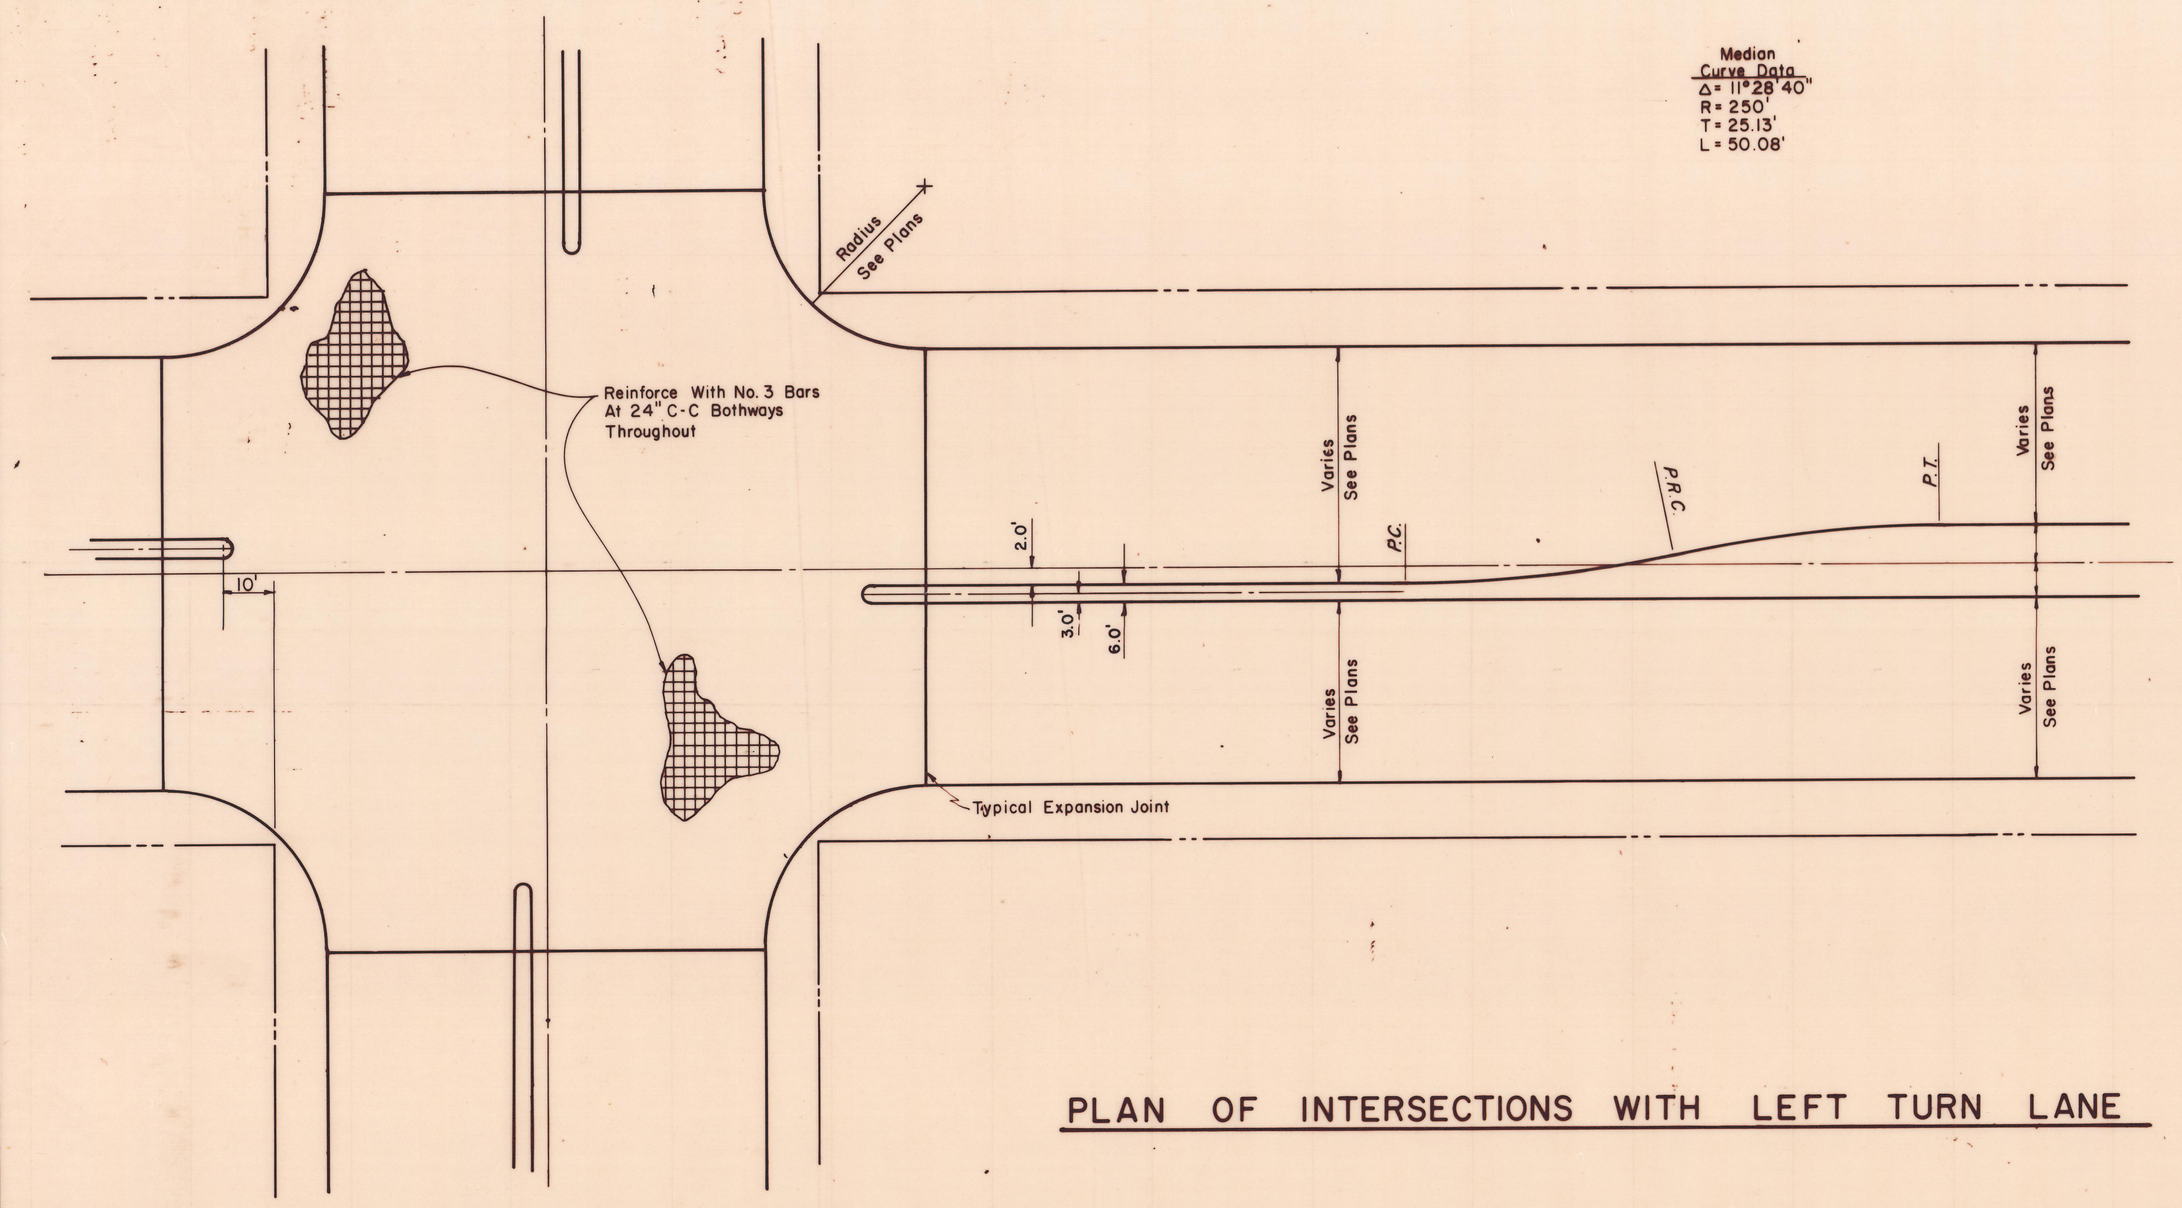

PLAN OF INTERSECTIONS WITH LEFT TURN LANE

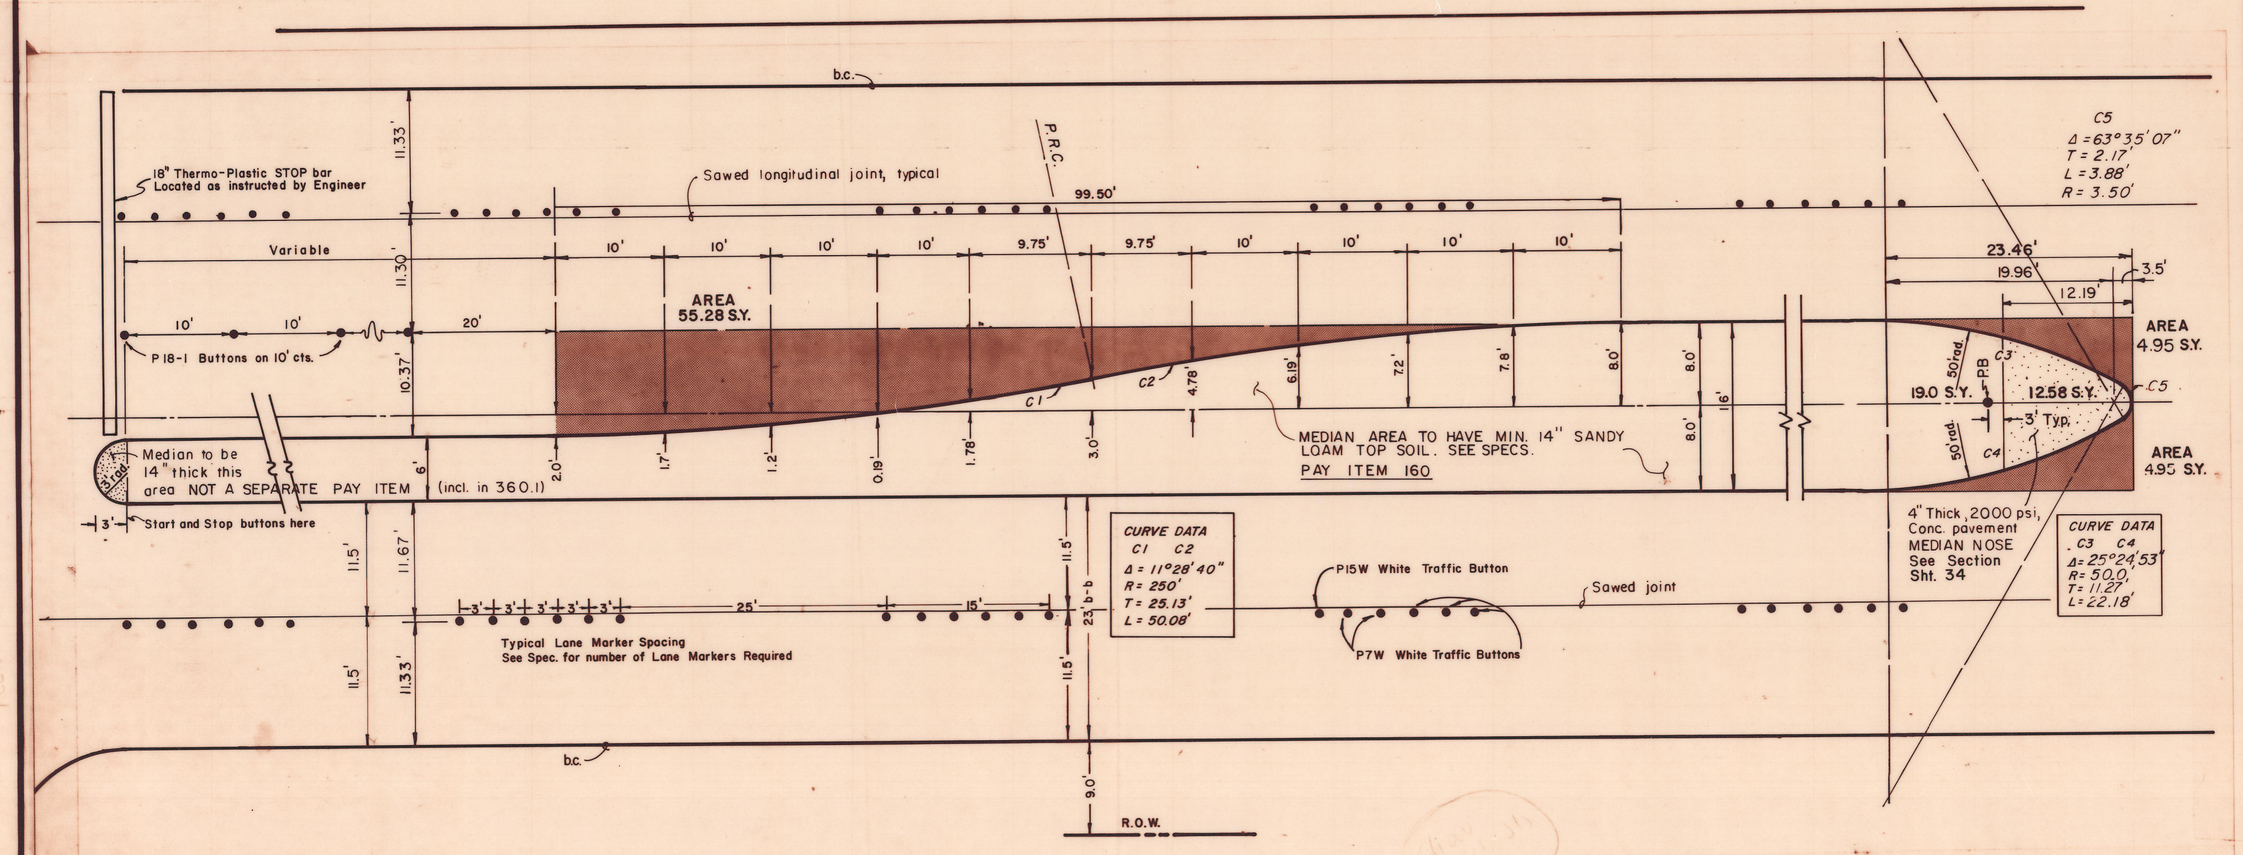

LEFT TURN LANE & LANE MARKER DETAIL

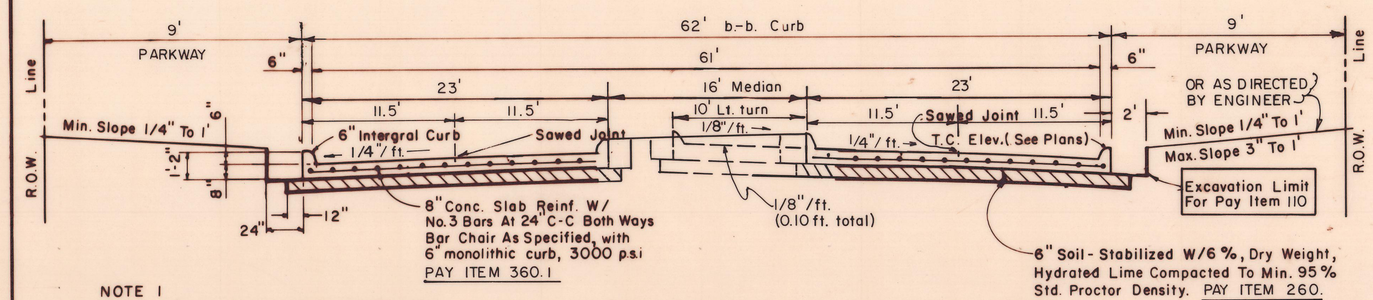

NOTE 1
Backfill material NOT A SEPARATE PAY ITEM
Material acquired from excavation may be used if approved by Engineer

(A) DIVIDED WEST T.C. ELEV. SAME AS EAST T.C. ELEV.

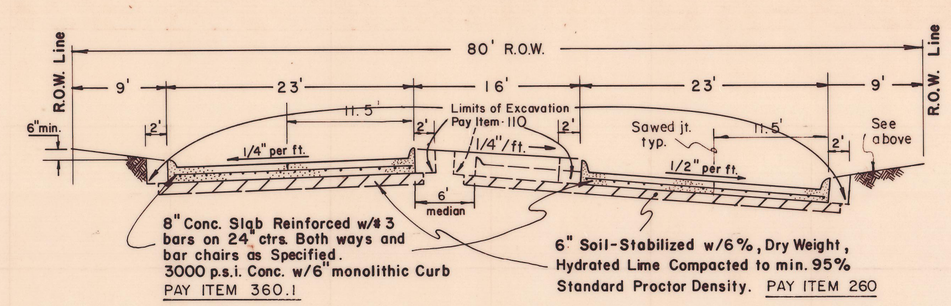

Note:
Backfill material NOT a SEPARATE PAY ITEM - Material acquired from excavation may be used if approved by Engineer.

MEDIAN SHALL HAVE MINIMUM 14" SANDY LOAM TOP SOIL

(B) DIVIDED WEST T.C. ELEV. HIGHER THAN EAST T.C. ELEV., SEE PLANS

TYPICAL PAVING SECTION DETAILS

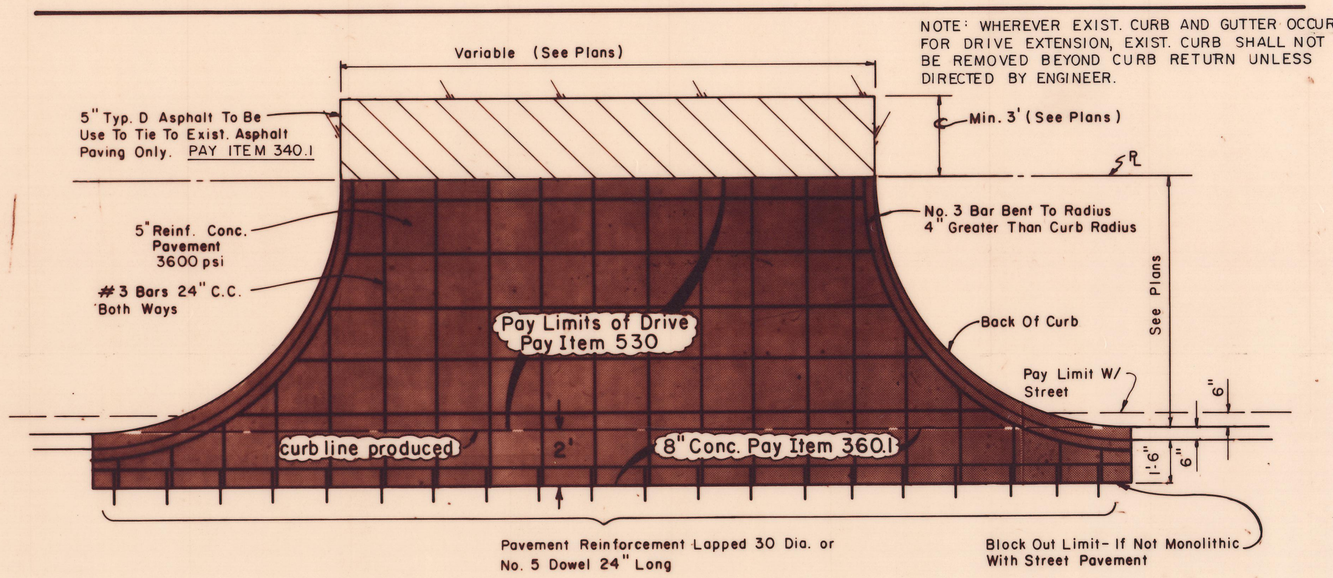

DRIVEWAY PAVING DETAIL

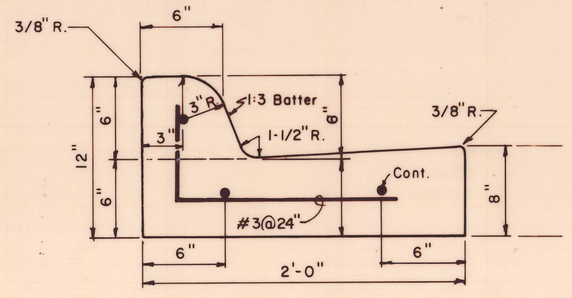

PAY ITEM 530.1
SEPARATE CURB & GUTTER
REINFORCEMENT SHALL BE No. 5 BARS

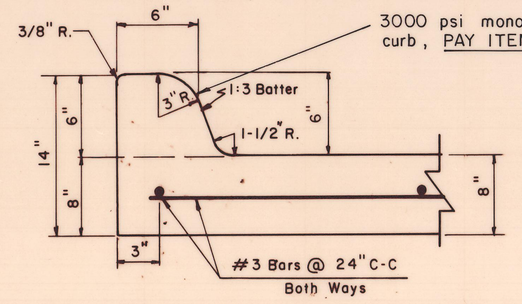

6" INTEGRAL CURB & GUTTER DETAIL

"AS BUILT"

CITY OF ADDISON
DALLAS COUNTY, TEXAS
QUORUM DRIVE

PAVING DETAILS A

GINN, INC.
Consulting Engineers Dallas, Texas

DESIGNED - H.K.	DRAWN - S.M.M.	DATE - MAY, 1984	JOB No. J-203
APPROVED - H.G.	CHECKED - G.F.	SCALE - NONE	SHEET 33 OF 38