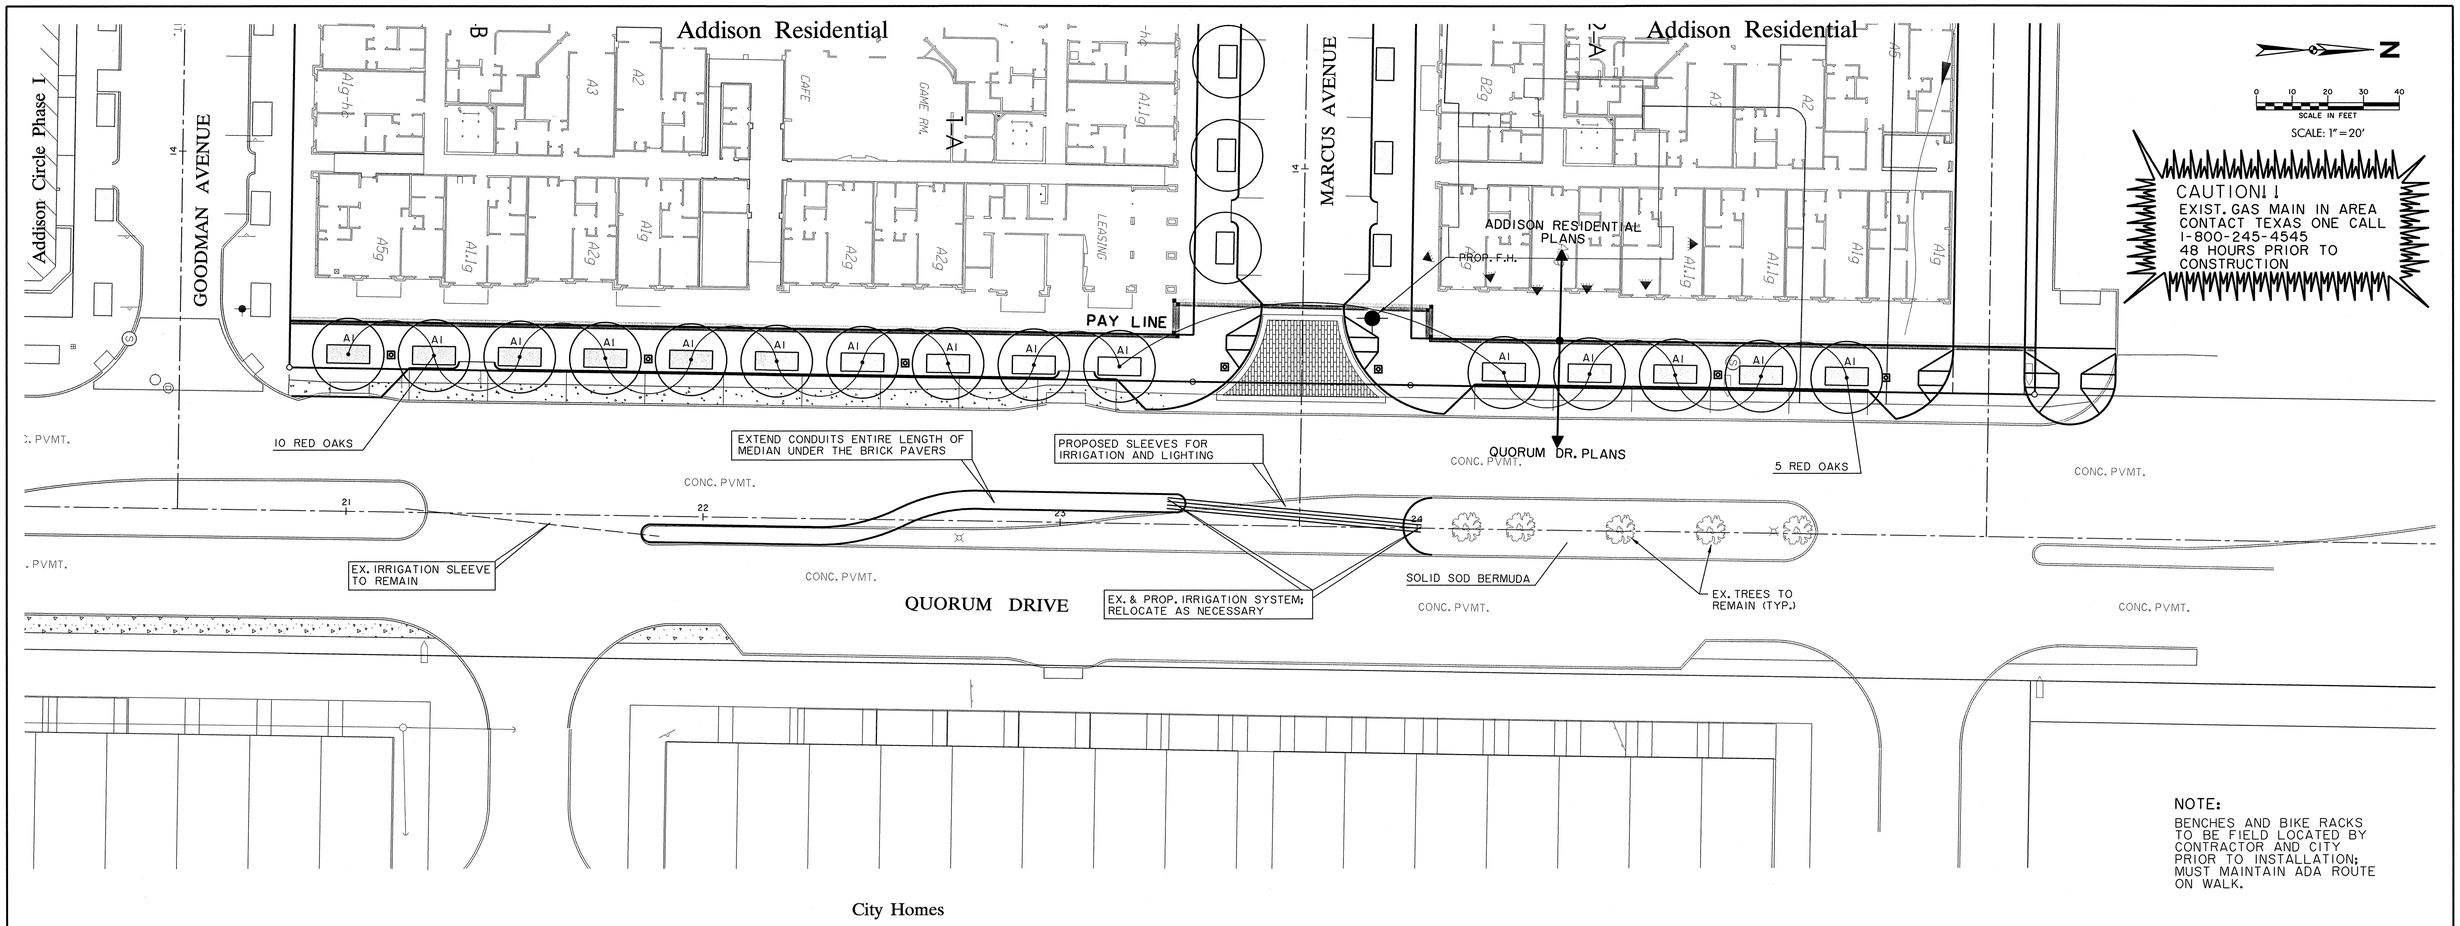

NOTE:
BENCHES AND BIKE RACKS TO BE FIELD LOCATED BY CONTRACTOR AND CITY PRIOR TO INSTALLATION; MUST MAINTAIN ADA ROUTE ON WALK.

City Homes

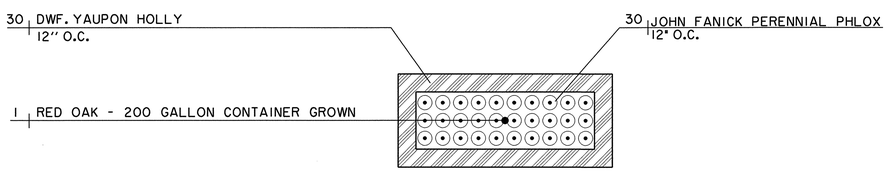

A1 5'X12' TREE WELL PLANTING

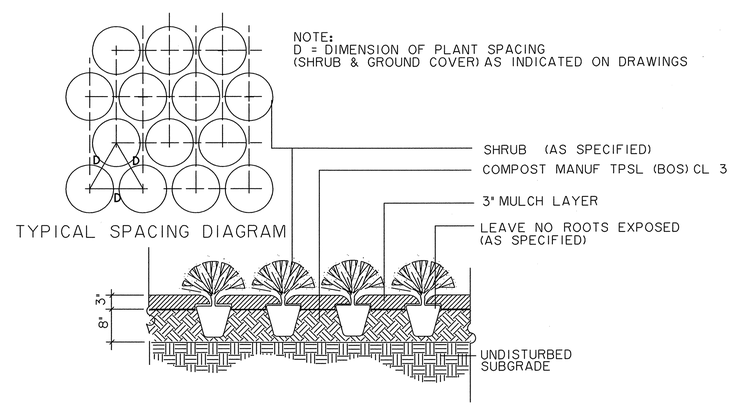

SHRUB PLANTING DETAIL

N.T.S.

NOTE:
SEE SHEET C9 FOR SUBSURFACE DRAIN SYSTEM DETAIL

STATE OF TEXAS
KEVIN N. CARLSON
89232
REGISTERED
PROFESSIONAL ENGINEER
1-15-09

RECORD DRAWING

THIS DRAWING HAS BEEN MODIFIED FROM THE ORIGINAL TO SHOW ONLY THE FIELD CHANGES AND ADJUSTMENTS MADE DURING CONSTRUCTION BY THE CONTRACTOR WHICH WERE DOCUMENTED AND FURNISHED TO THE ENGINEER FOR THE PURPOSE OF PREPARING THESE RECORD DRAWINGS. FIELD INSPECTION OF CONSTRUCTION WAS PERFORMED BY OTHERS. TO THE BEST OF OUR KNOWLEDGE AND UNDERSTANDING THESE RECORD DRAWINGS REPRESENT THE "AS-BUILT" CONDITIONS.

PLANTING & FURNITURE PLAN
WITH PLANTING DETAILS

QUORUM DRIVE

TOWN OF ADDISON, TEXAS

Huitt - Zollars, Inc.
3131 Mckinney Ave., Suite 600, Dallas, TX 75204
Phone (214) 871-3311/Fax (214) 871-0757

DESIGN	CHECKED	APPR.	SCALE	DATE	PROJECT NO.	NO.
HZI	HZI		1"=20'	01/15/09		C21

h:\proj\01340801\dgn\3408LS04.DGN