


SCALE: 1" = 200'

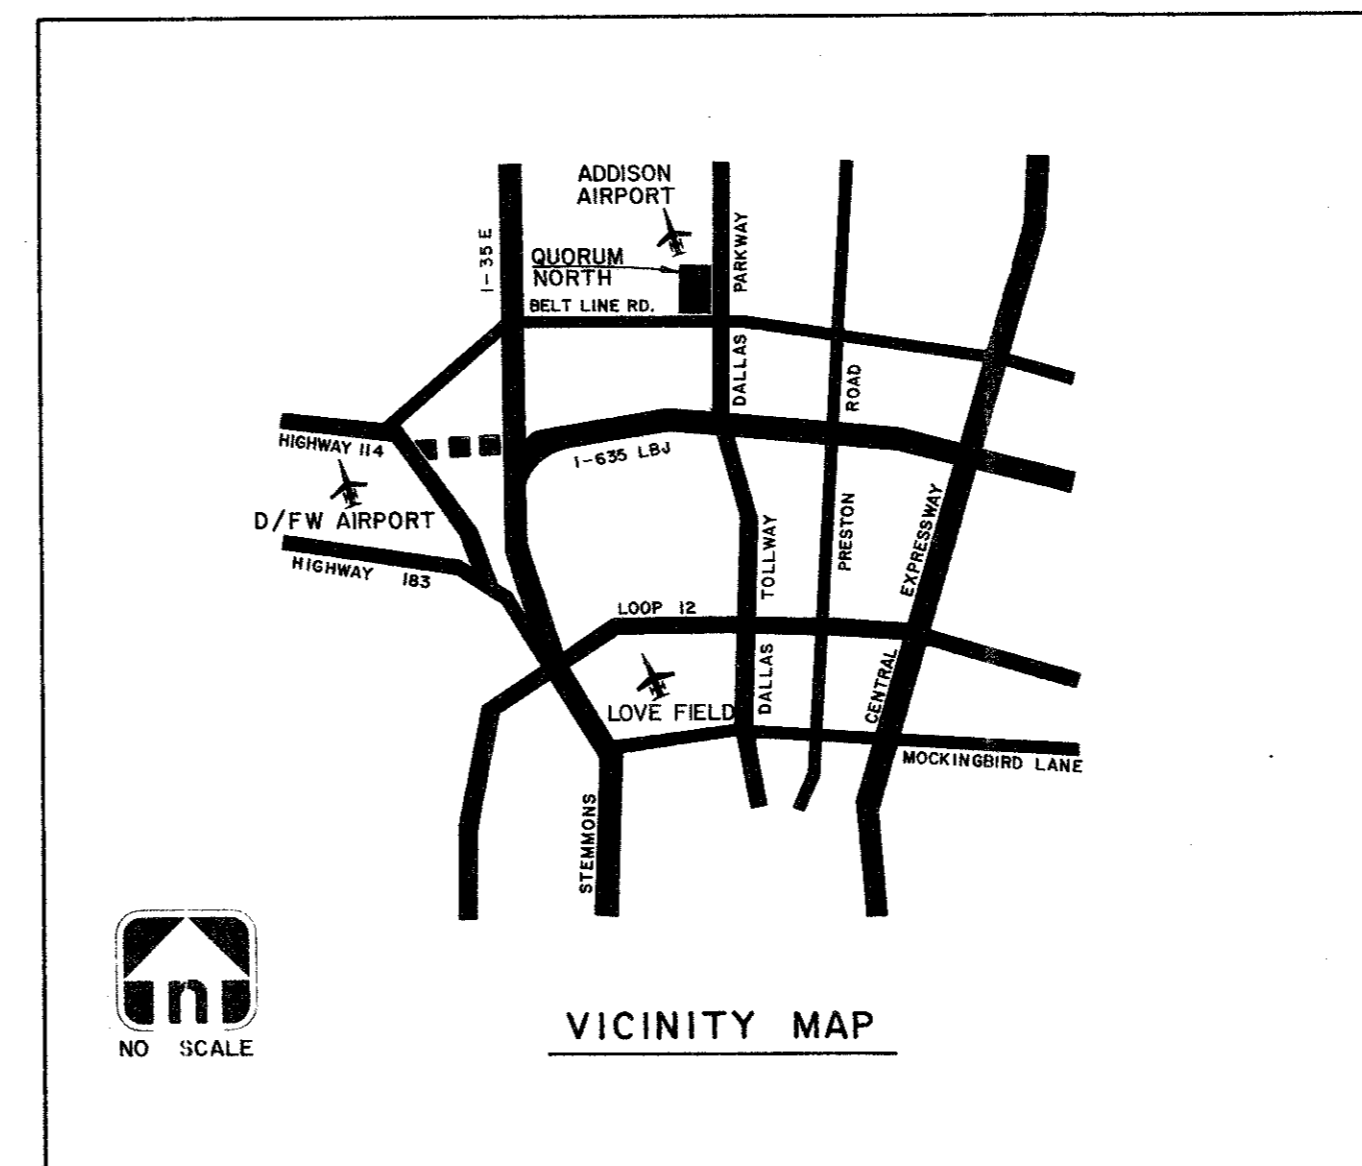

NO SCALE

INDEX	
SHEET NO.	TITLE
1	COVER SHEET & LAYOUT
2	UTILITY SITE PLAN
3	PAVING PLAN
4	DRAINAGE AREA MAP
5	GRADING PLAN
6	PAVING-QUORUM LOOP NORTH
7	PAVING-LOOP NORTH & FACTORY ST.
8	STORM SEWER LINE 'A'
9	STORM SEWER LINES 'A' & 'B'
10	10" SAN. SEW. APPROACH MAIN
11	SAN. SEW. LINE 'A'
12	SAN. SEW. LINE 'A'
13	PAVING DETAILS
14	WATER MAIN APPURTENANCES
15	SAN. SEW. DETAILS
16	STORM DRAIN INLET DETAILS
17	DETAIL - TYPE 'Y' INLET
18	DETAIL - CONCRETE CRADLE
19	DETAIL - TYPE I & II INLET

QUORUM NORTH

ADDISON, TEXAS

DAON CORPORATION: DEVELOPER

Hellmuth, Obata & Kassabaum, Inc.
 Architects, Engineers, Planners
 Graham Associates, Inc.
 Consulting Engineers & Planners

REVISED TO CONFORM TO
 CONSTRUCTION RECORDS:
 BY _____
 DATE _____