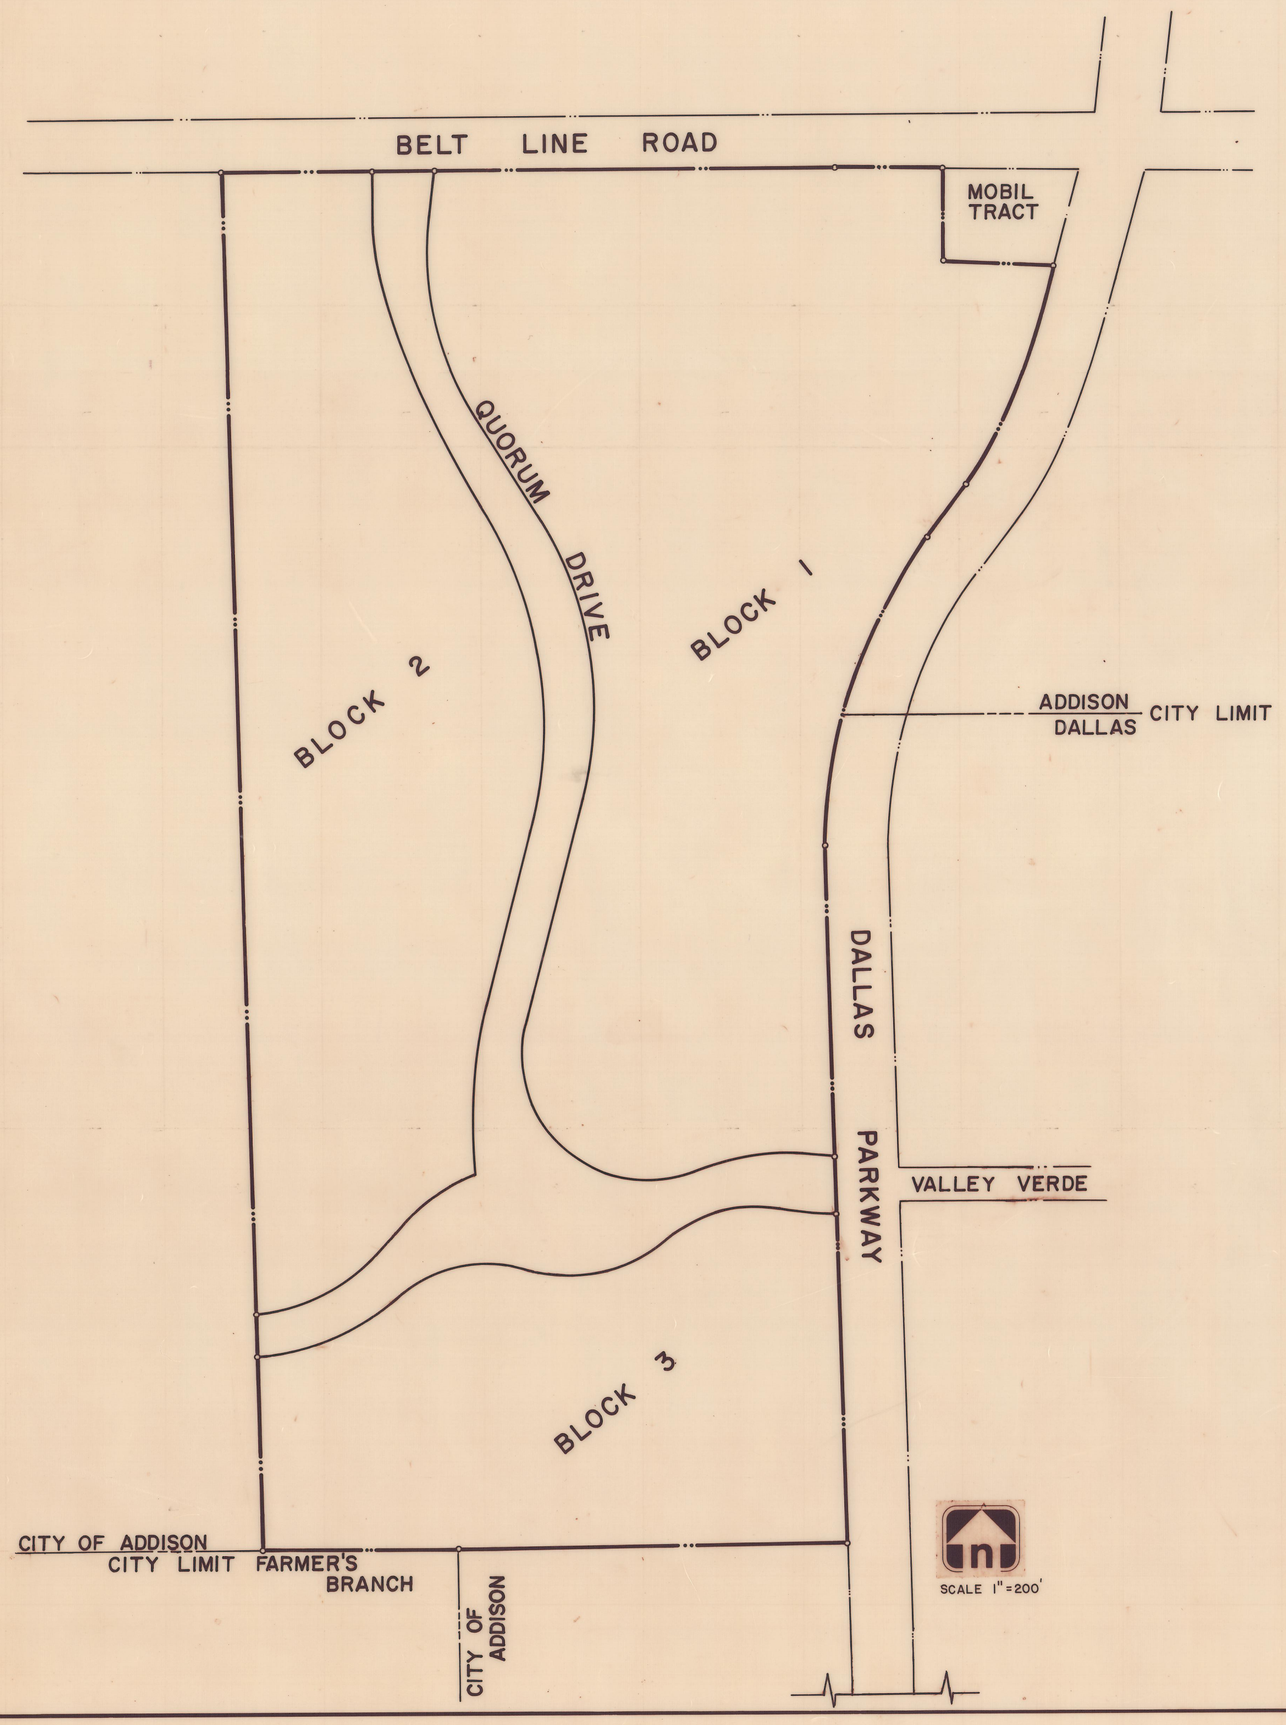

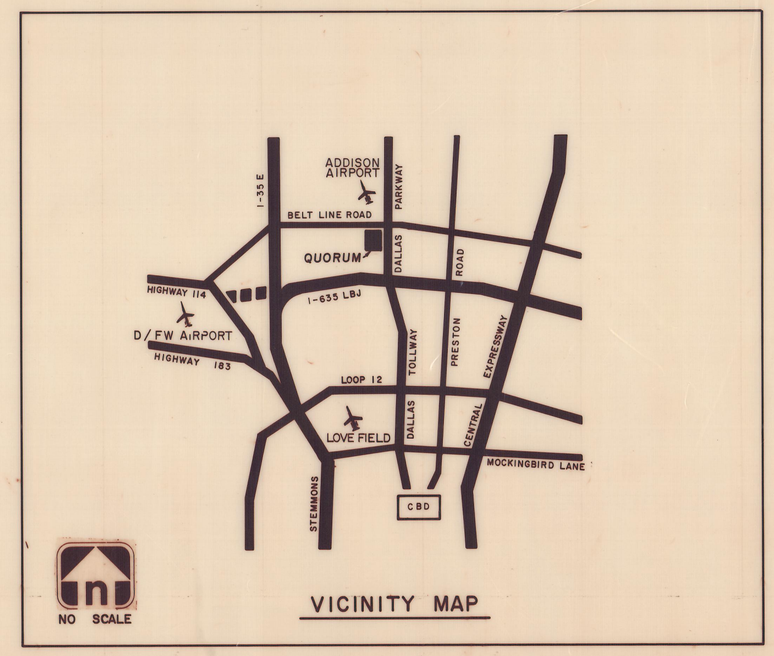

INDEX

SHEET NO.	TITLE
1	COVER SHEET & LAYOUT
2	UTILITY SITE PLAN
3	PAVING PLAN
4	DRAINAGE AREA MAP
5	GRADING PLAN
6	PAVING - EAST LANE
7	PAVING - WEST LANE
8	PAVING -
9	STORM SEWER LINES A & B
10	STORM SEWER LINE C
11	STORM SEWER LINE D
12	SANITARY SEWER LINE A
13	SANITARY SEWEP LINE B
14	12" OFFSITE WATER LINE
15	PAVING DETAILS
16	SIGNALIZATION PLAN
17	WATER MAIN APPURTENANCES
18	SANITARY SEWER DETAILS
19	STORM SEWER INLET DETAILS
20	DETAIL - TYPE "Y" INLET
21	DETAIL - CONCRETE CRADLE
22	DETAIL - TYPE I & II INLET

QUORUM
ADDISON, TEXAS

DAON CORPORATION: DEVELOPER

Hellmuth, Obata & Kassabaum, Inc.
Architects, Engineers, Planners
Graham Associates, Inc.
Consulting Engineers & Planners

REVISED TO CONFORM TO CONSTRUCTION RECORDS
BY RH
DATE 8/6/80

FF-2 pdf