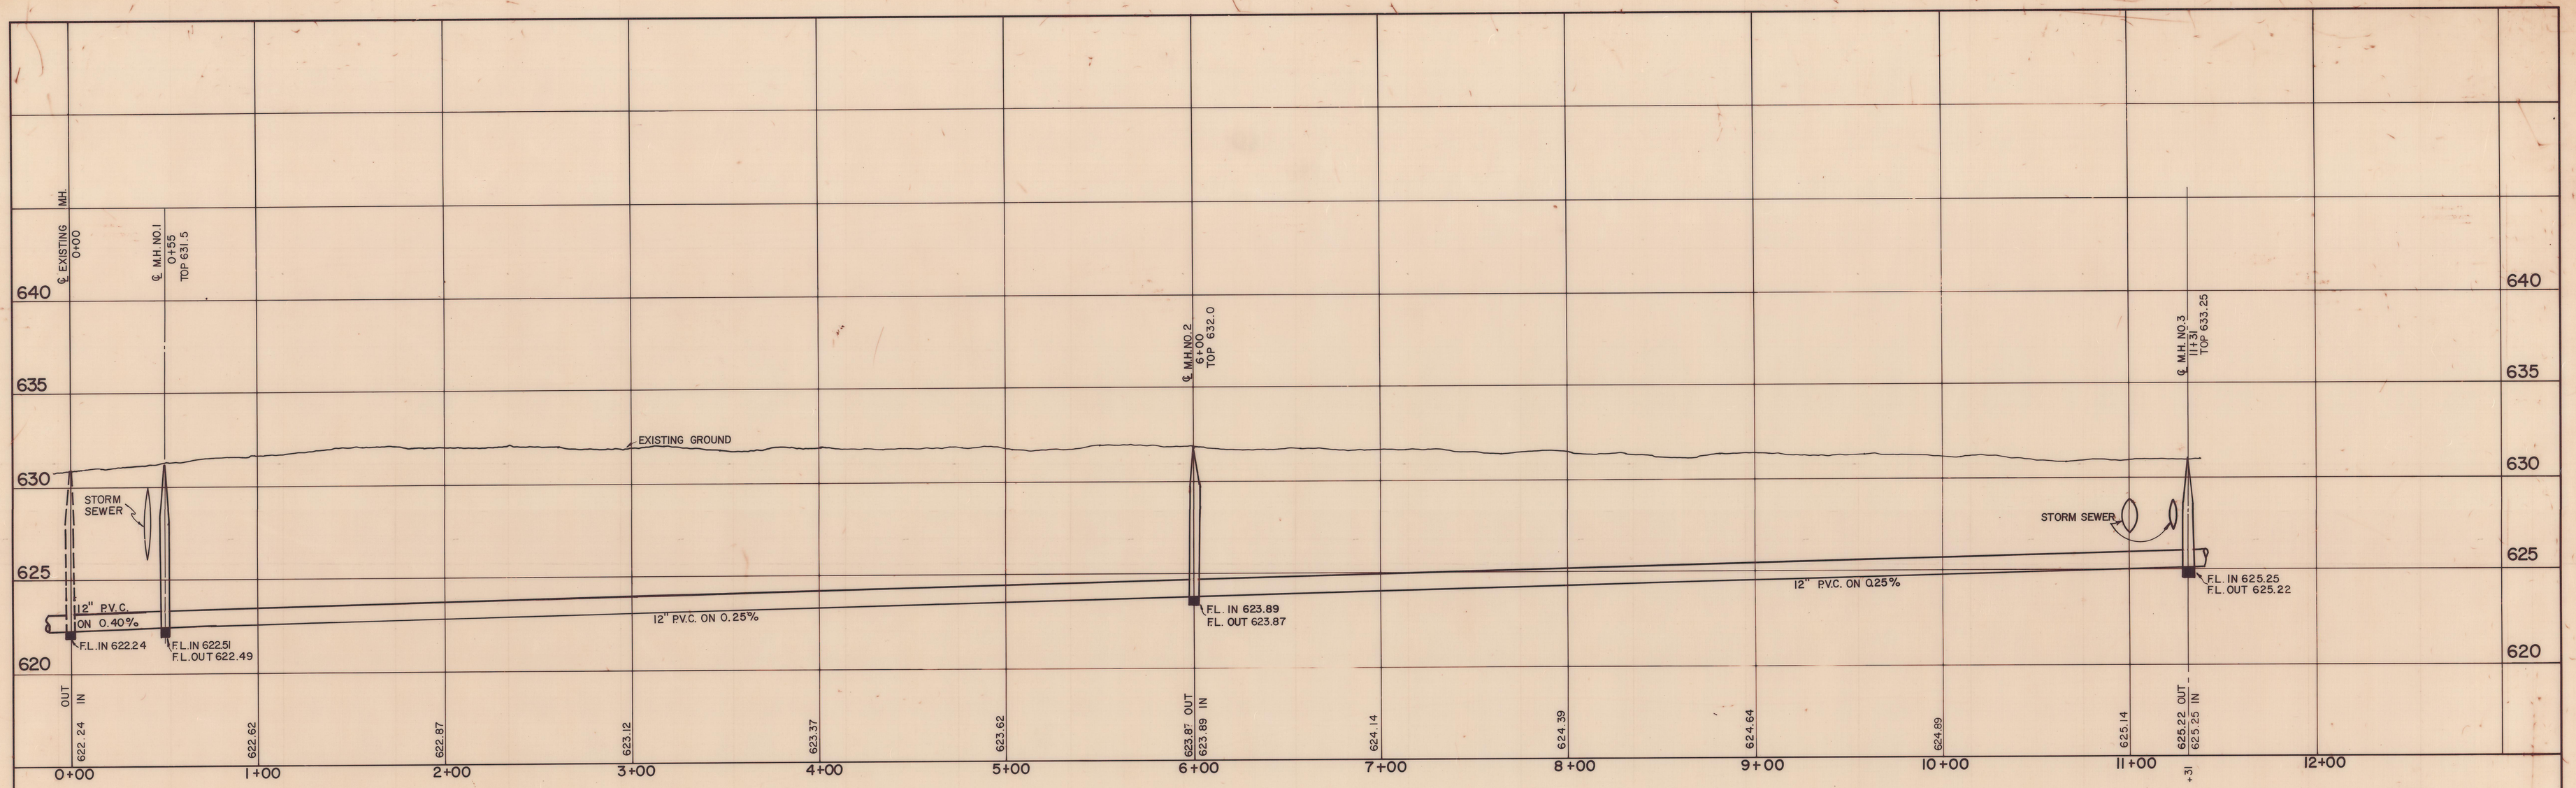

LINE "A" · PROFILE

SCALE:
HORIZ. - 1"= 40'
VERT. - 1"= 4'

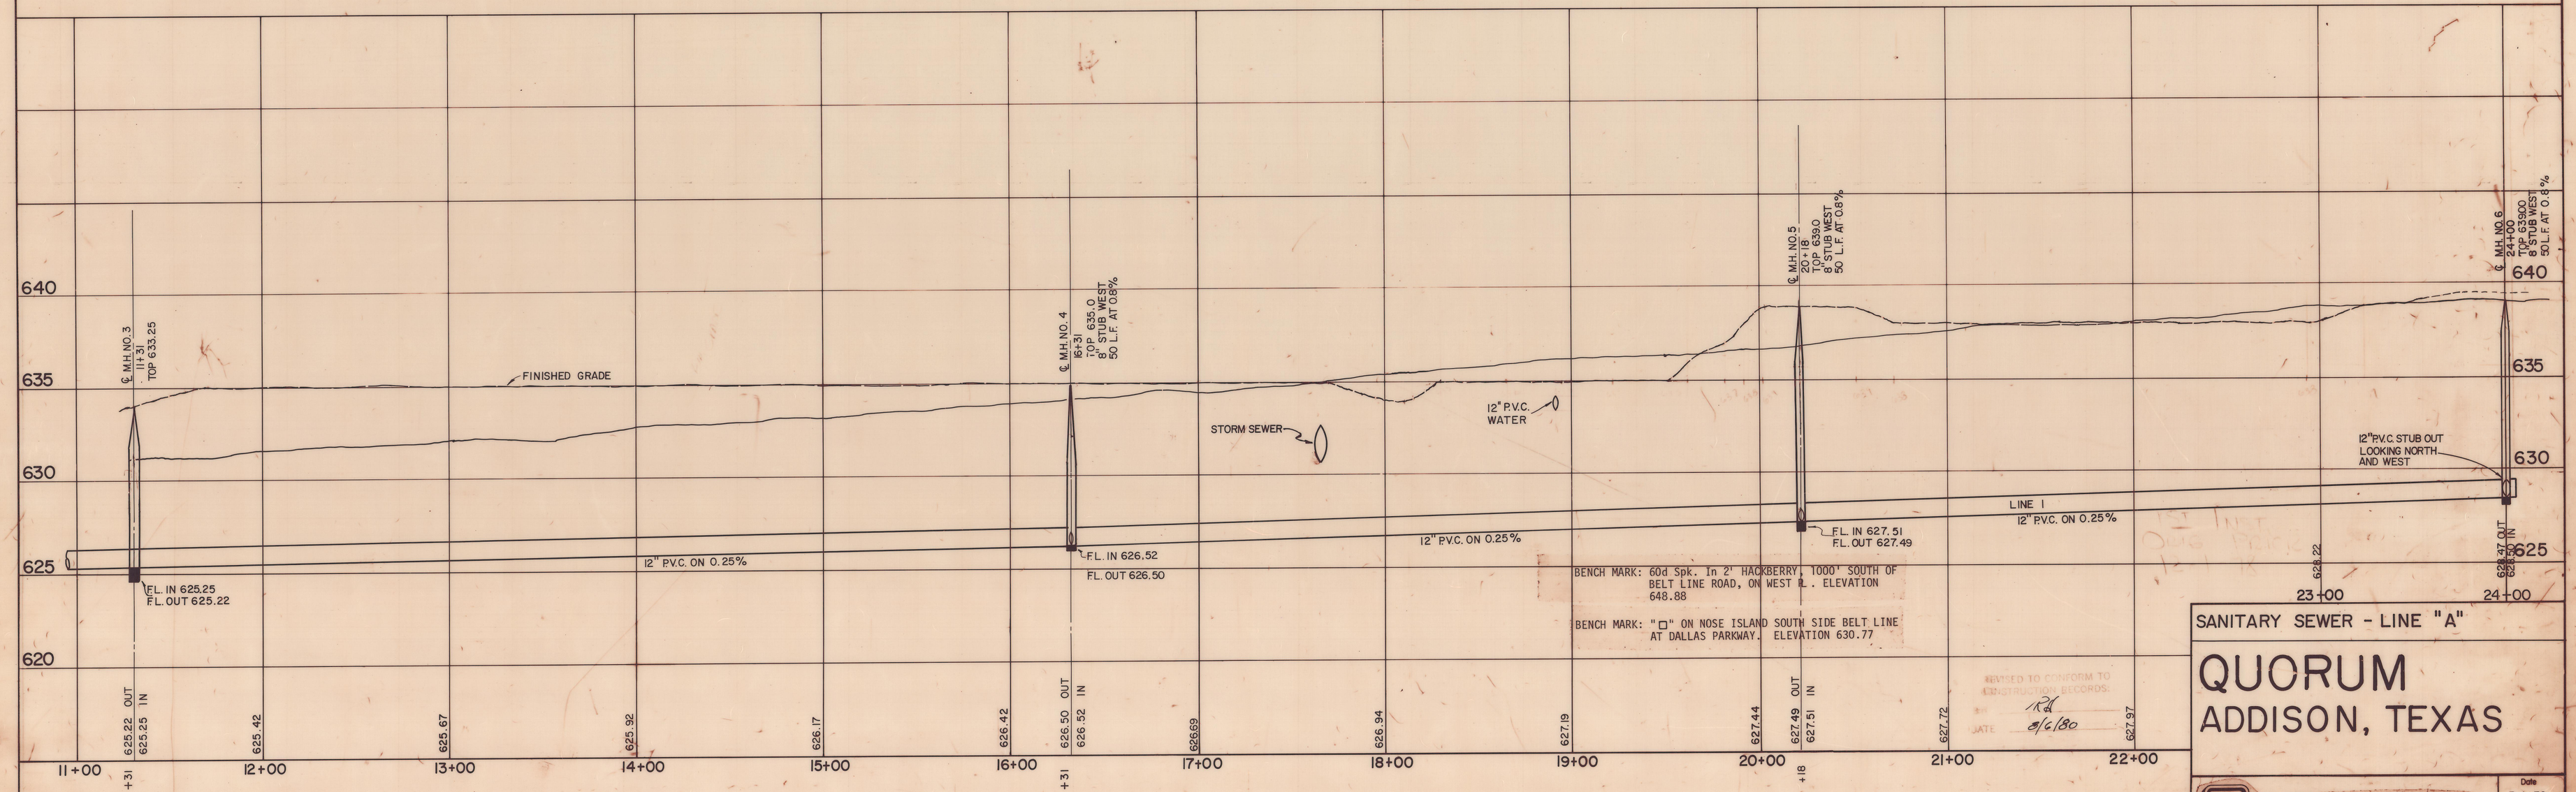

BENCH MARK: 60d Spk. In 2' HACKBERRY, 1000' SOUTH OF BELT LINE ROAD, ON WEST R.L. ELEVATION 648.88

BENCH MARK: "□" ON NOSE ISLAND SOUTH SIDE BELT LINE AT DALLAS PARKWAY. ELEVATION 630.77

REVISED TO CONFORM TO CONSTRUCTION RECORDS
RH
DATE 8/6/80

LINE "A" · PROFILE

SANITARY SEWER - LINE "A"

QUORUM
ADDISON, TEXAS

Graham Associates, Inc.
CONSULTING ENGINEERS & PLANNERS

Date 3 1 · 79
File 314 1437

Drawn By: G.A.I.
Sheet 12 Of 22