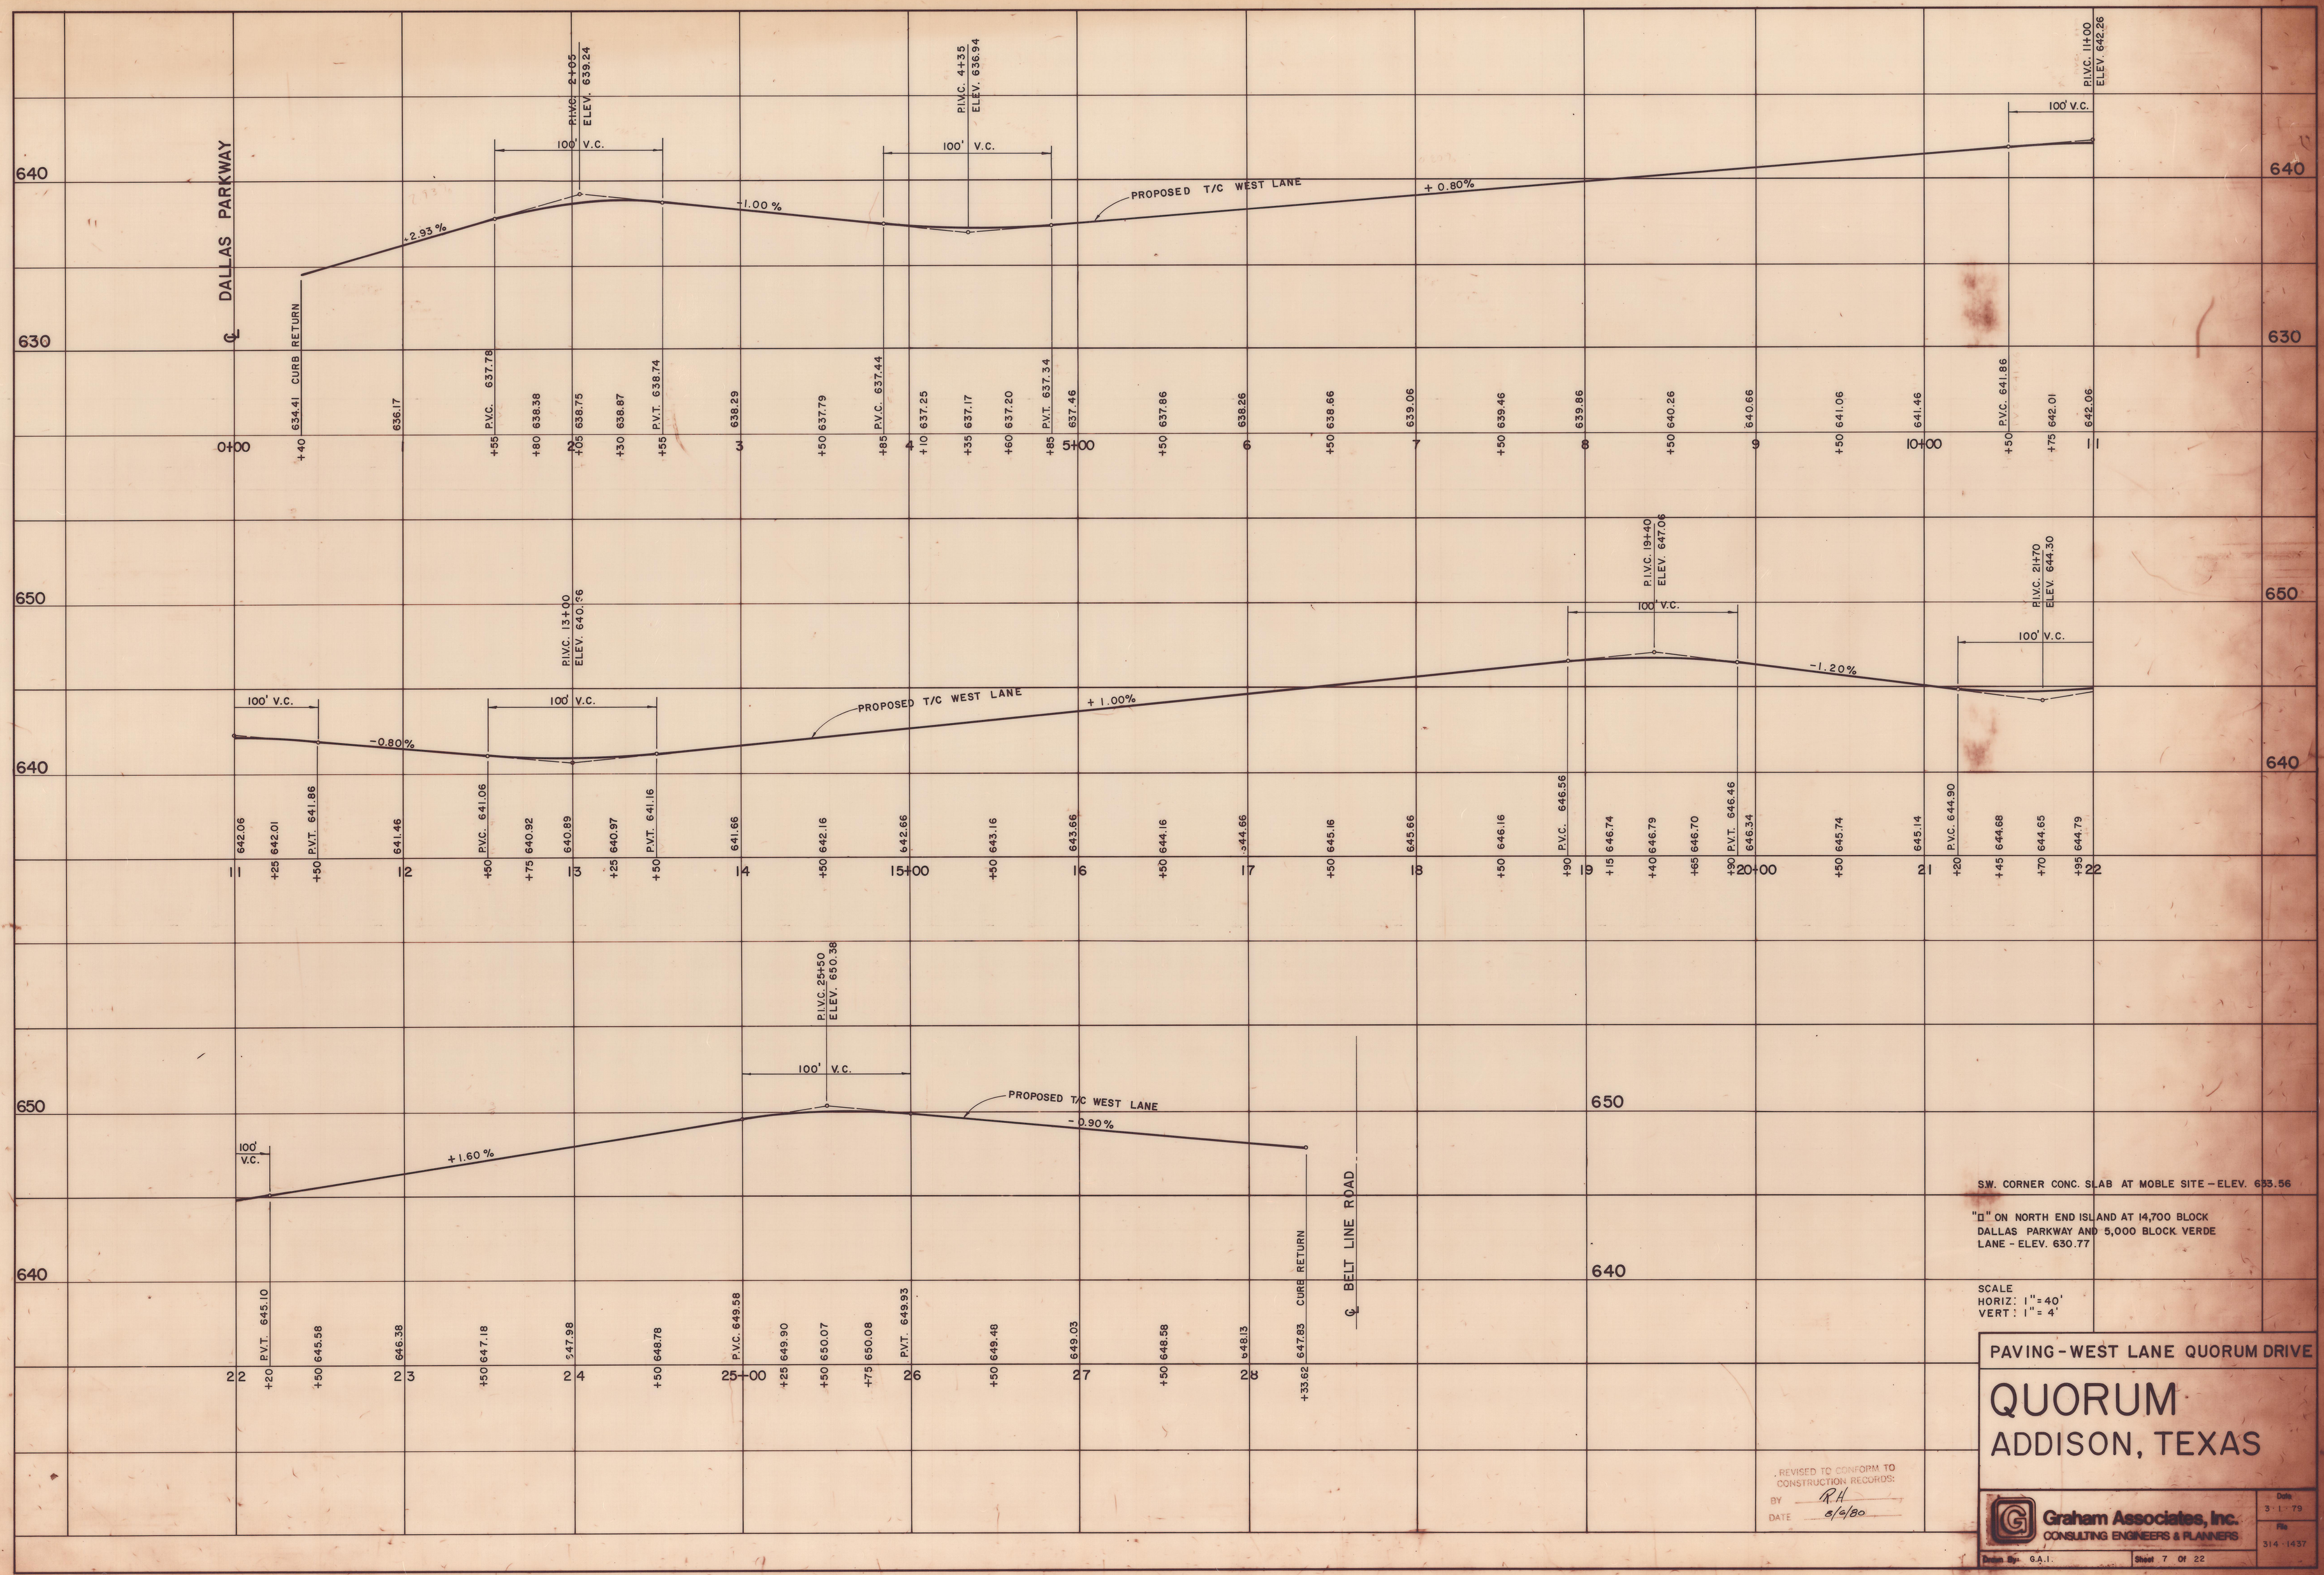

S.W. CORNER CONC. SLAB AT MOBLE SITE – ELEV. 633.56

"□" ON NORTH END ISLAND AT 14,700 BLOCK DALLAS PARKWAY AND 5,000 BLOCK VERDE LANE – ELEV. 630.77

SCALE
HORIZ: 1" = 40'
VERT: 1" = 4'

PAVING – WEST LANE QUORUM DRIVE

QUORUM
ADDISON, TEXAS

REVISED TO CONFORM TO CONSTRUCTION RECORDS:
BY R.H.
DATE 8/6/80

Graham Associates, Inc.
CONSULTING ENGINEERS & PLANNERS

Date 3-1-79
File 314-1437
Drawn By: G.A.I.
Sheet 7 Of 22