


CITY OF FARMERS BRANCH
CITY OF ADDISON

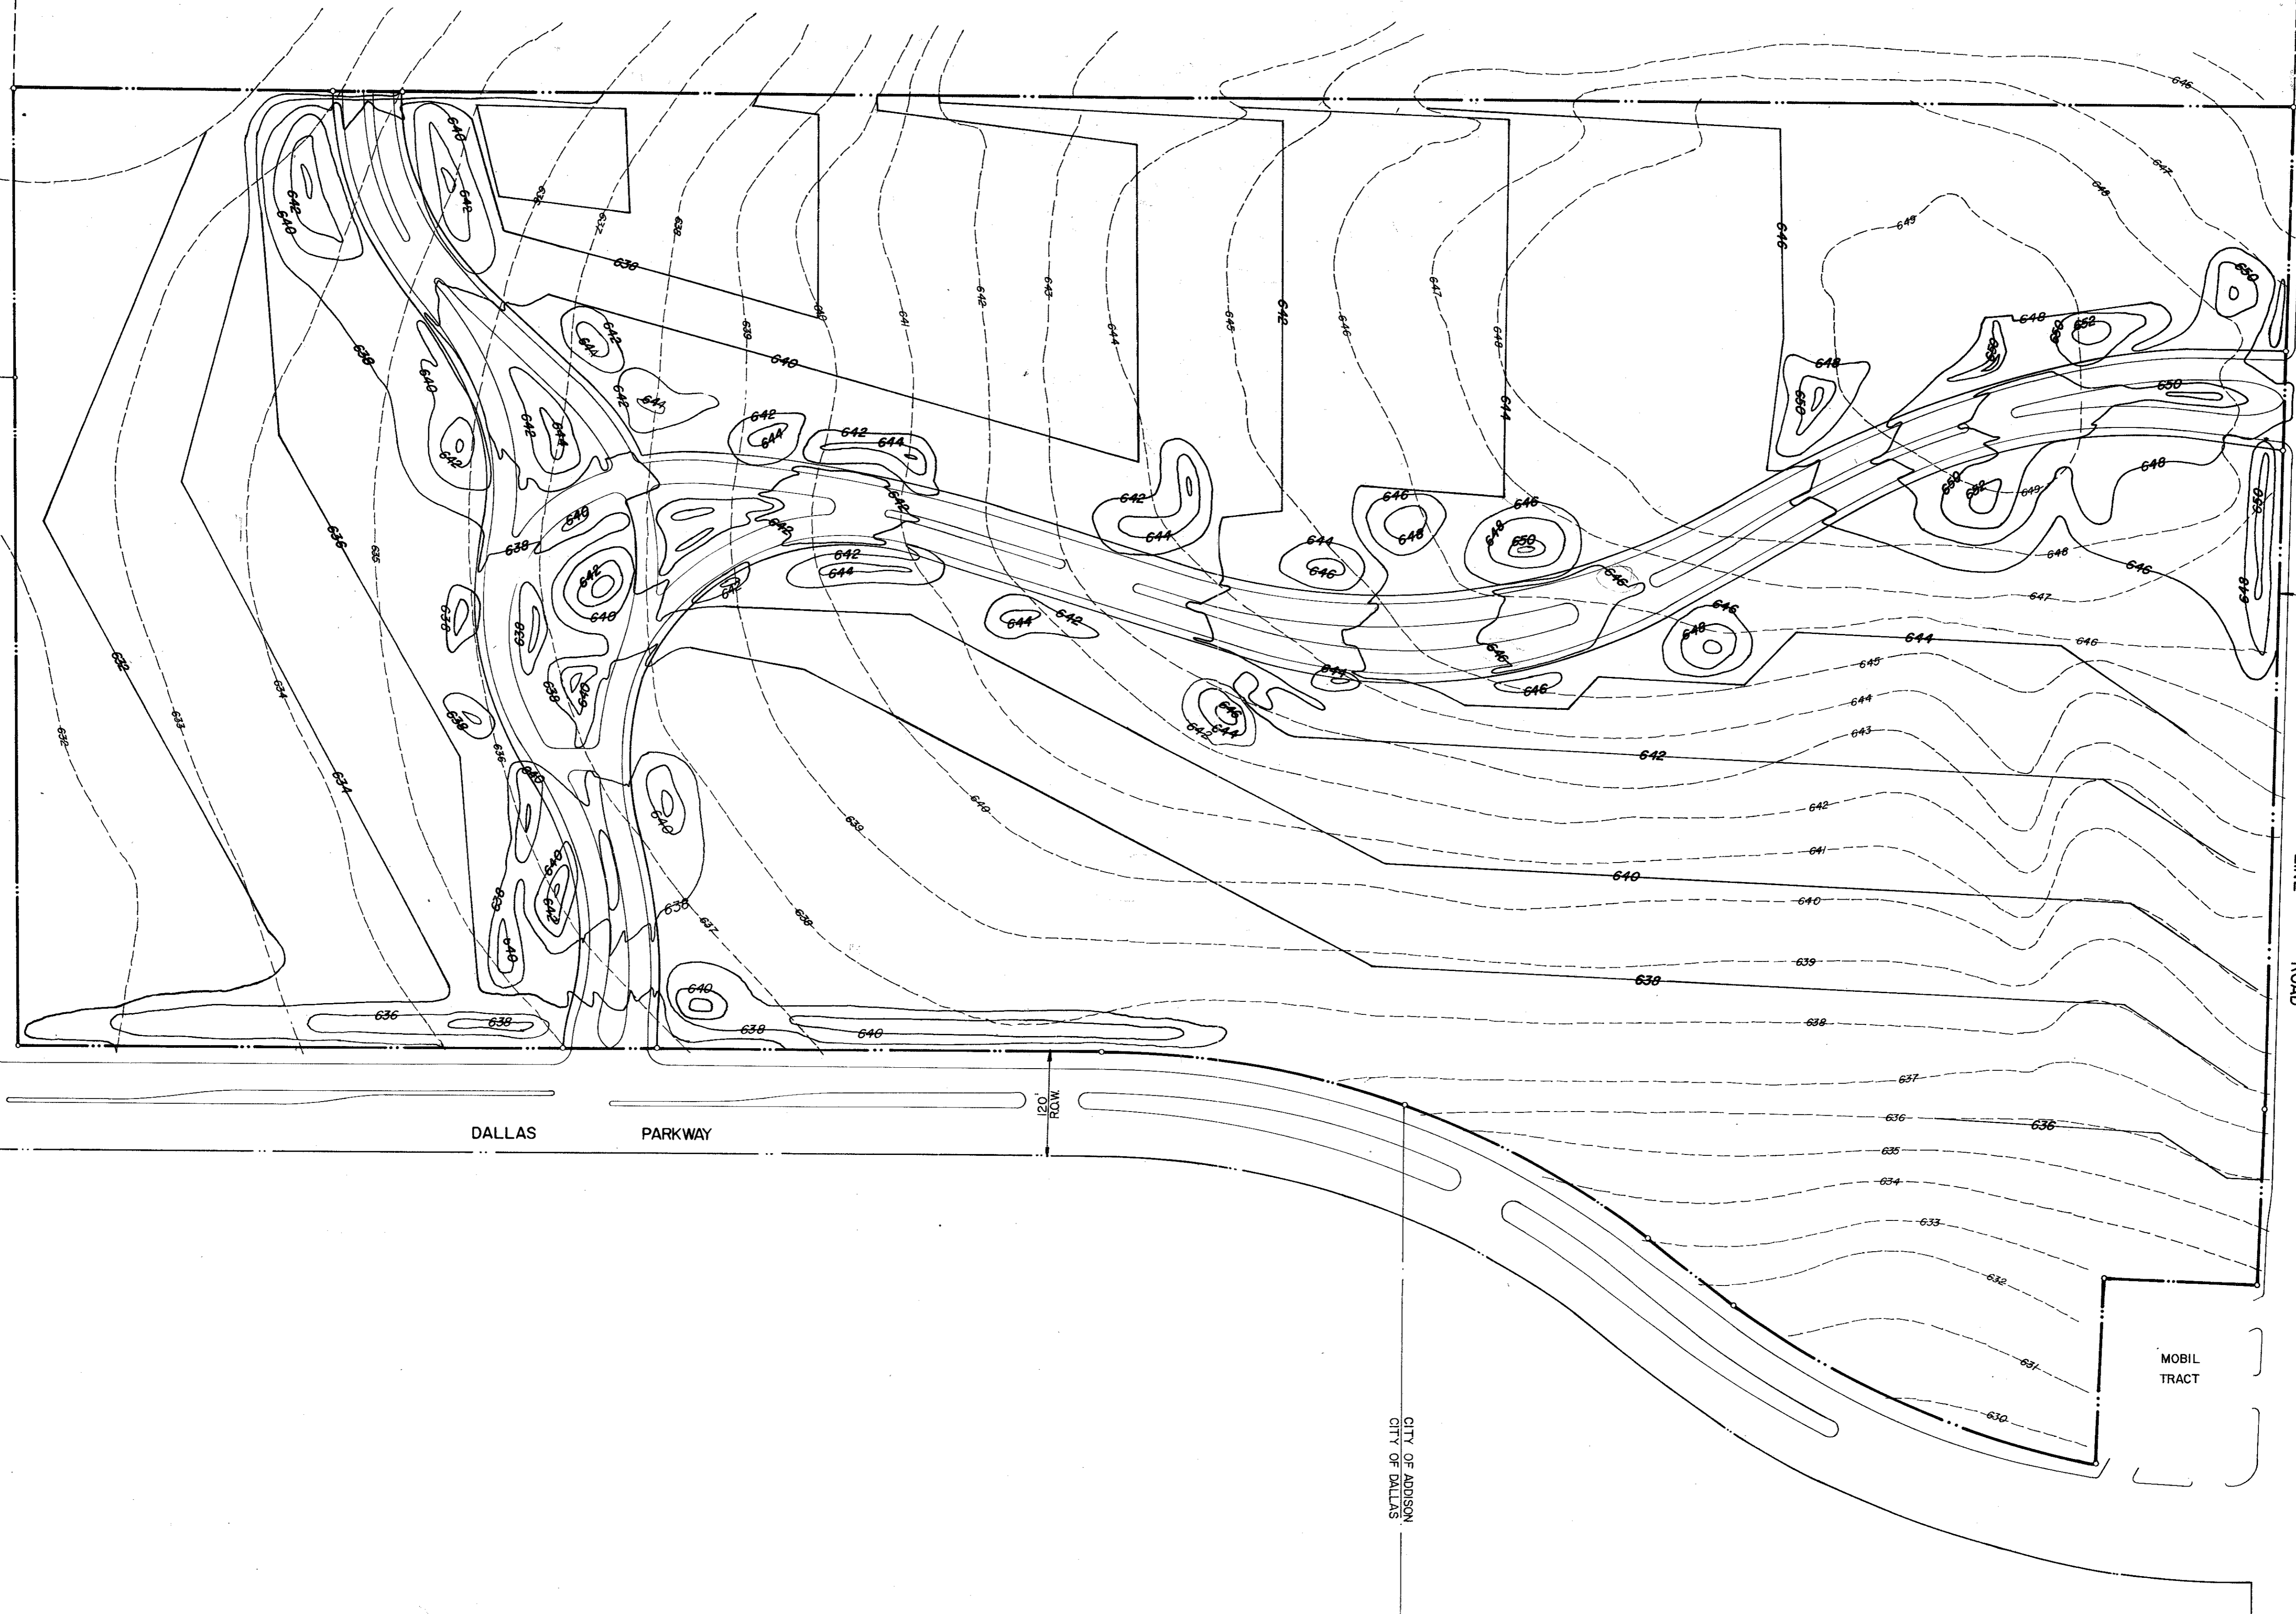

DALLAS PARKWAY

120' ROW

100' ROW

BELT LINE ROAD

MOBIL TRACT

CITY OF ADDISON
CITY OF DALLAS



SCALE: 1" = 100'

| LEGEND | |
|-----------------|-----------|
| PROPOSED GRADES | ——— |
| EXISTING GRADES | - - - - - |

RA
8/6/80

GRADING PLAN
QUORUM
ADDISON, TEXAS

| | | |
|------------------|---------------------------------|------------|
| | Graham Associates, Inc. | Date |
| | CONSULTING ENGINEERS & PLANNERS | 3 · 1 · 79 |
| Drawn By: G.A.I. | Sheet 5 of 27 | File |
| | | 314 · 1437 |