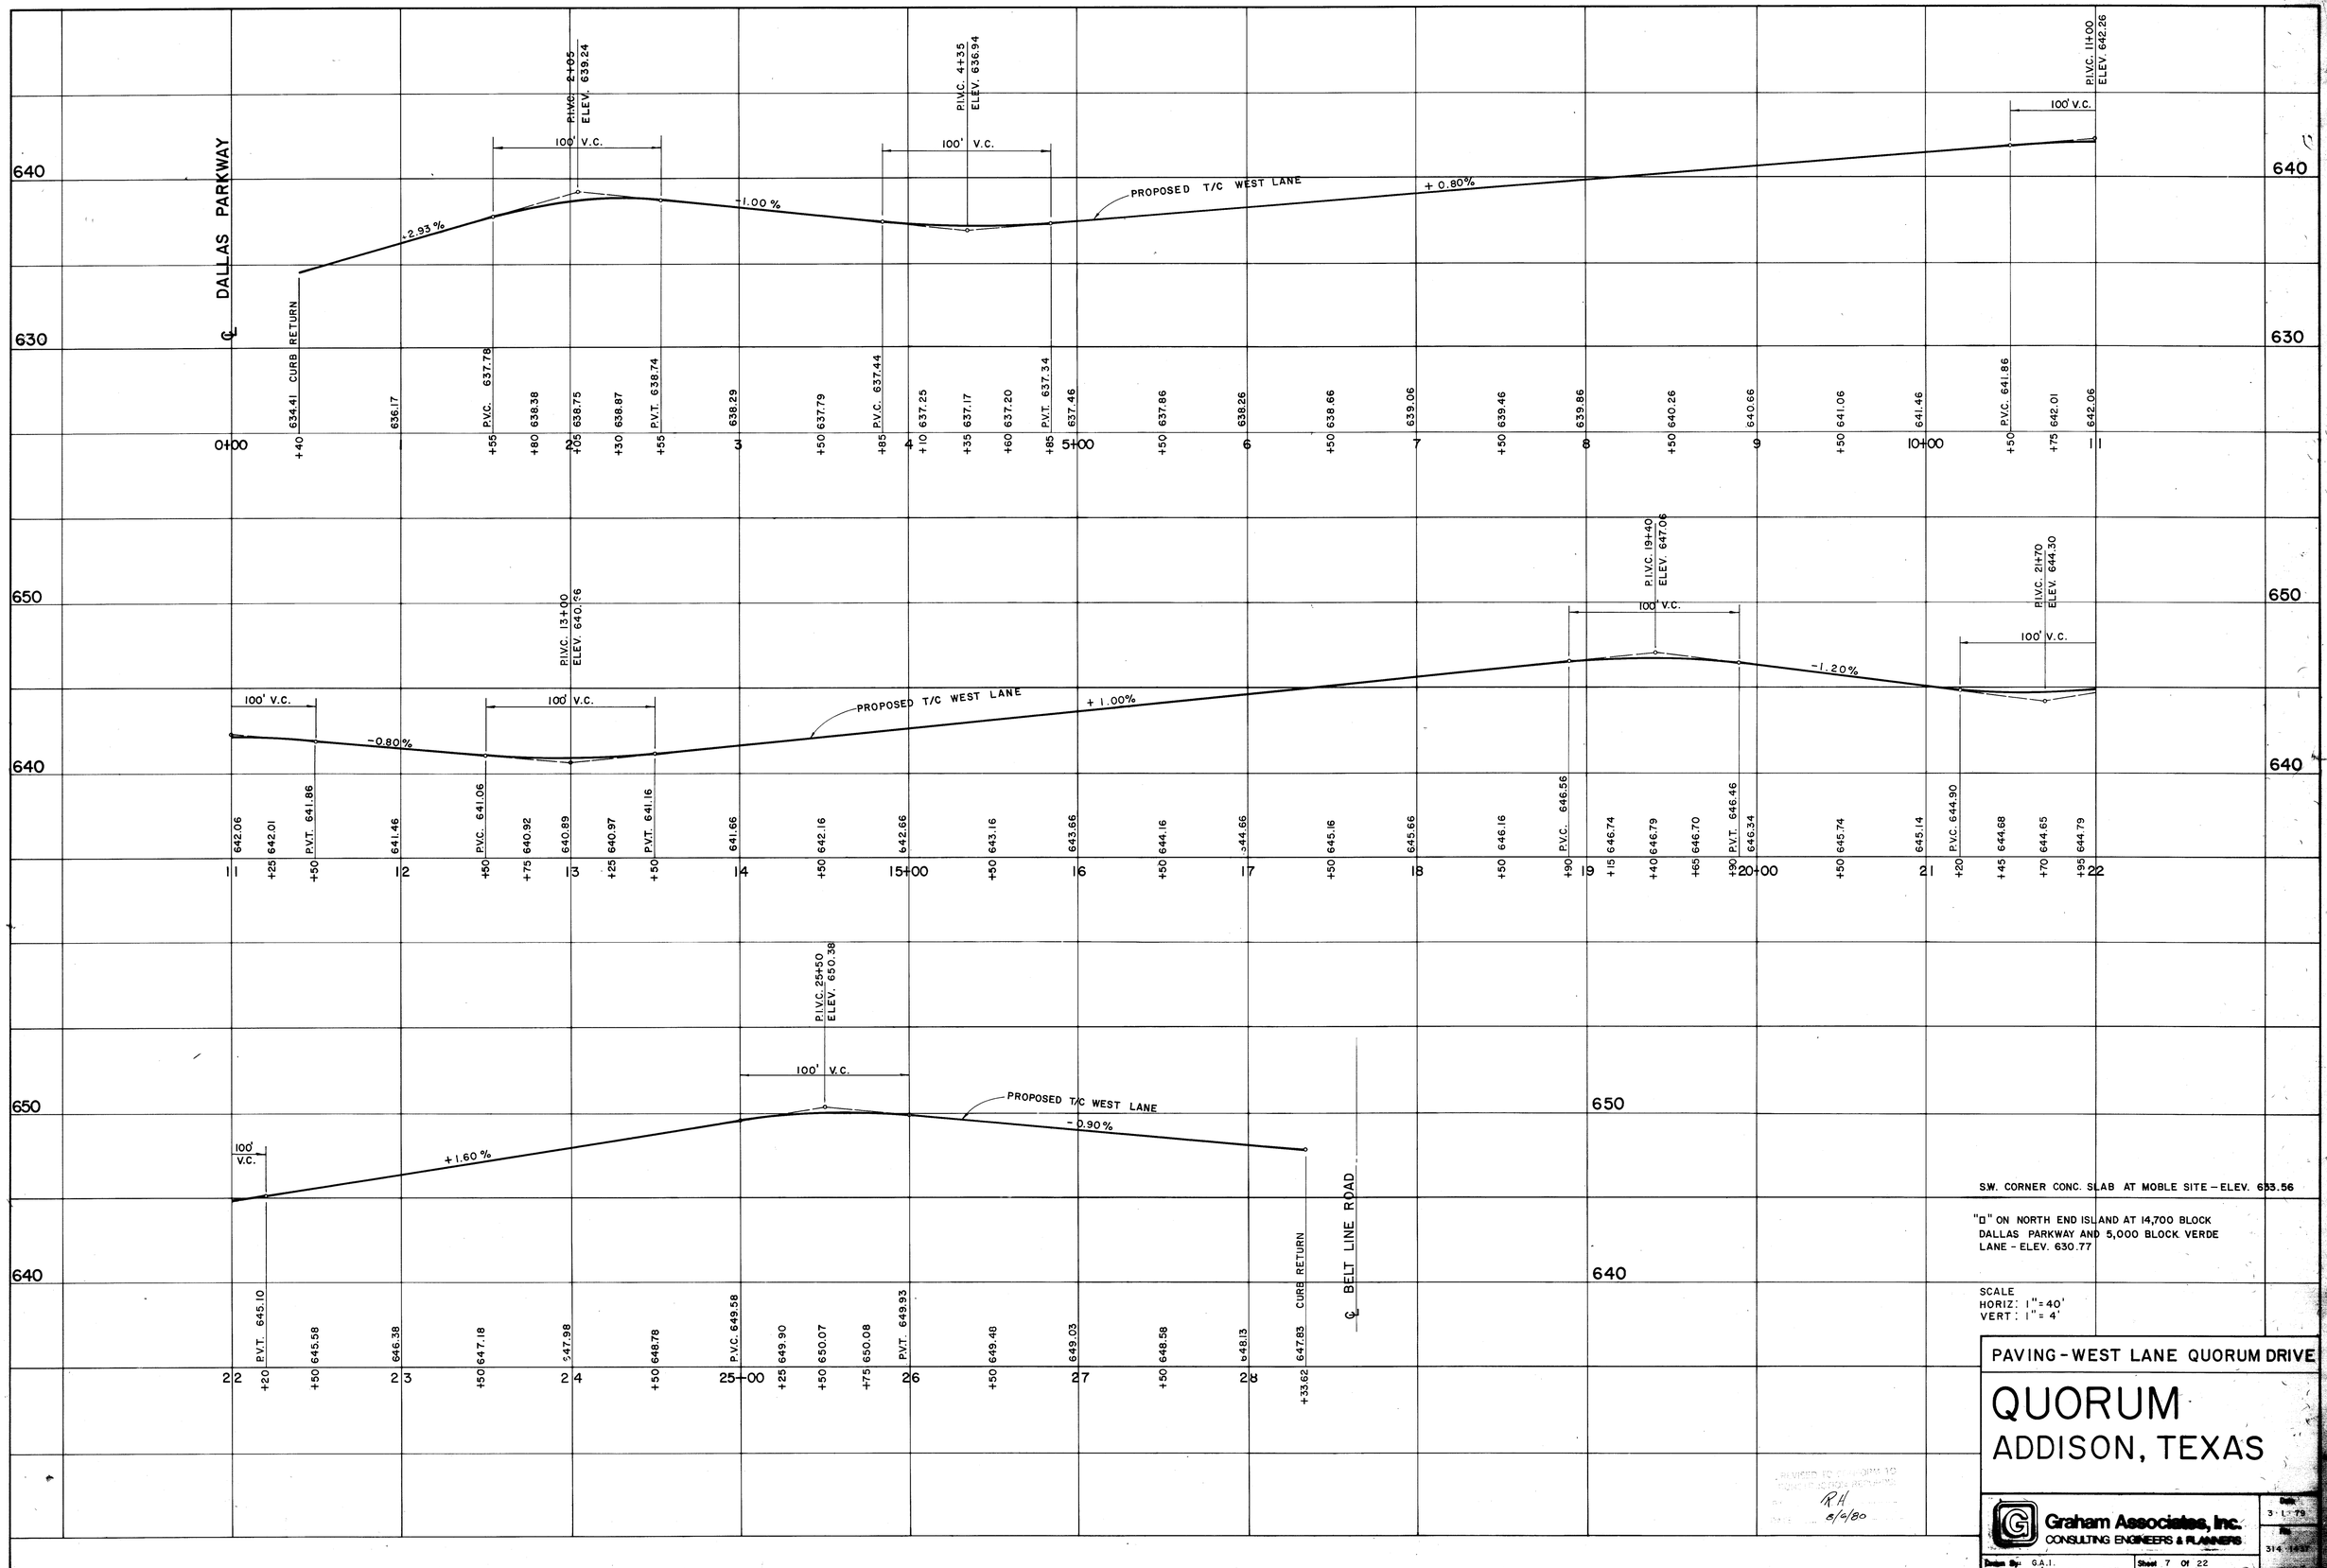

S.W. CORNER CONC. SLAB AT MOBLE SITE – ELEV. 653.56

"a" ON NORTH END ISLAND AT 14,700 BLOCK DALLAS PARKWAY AND 5,000 BLOCK VERDE LANE – ELEV. 630.77

SCALE
HORIZ: 1"=40'
VERT: 1"=4'

PAVING – WEST LANE QUORUM DRIVE

QUORUM
ADDISON, TEXAS

RH
5/4/80

Graham Associates, Inc.
CONSULTING ENGINEERS & PLANNERS

Date: 3-1-79
File: 314-1432
Design By: G.A.I.
Sheet 7 Of 22