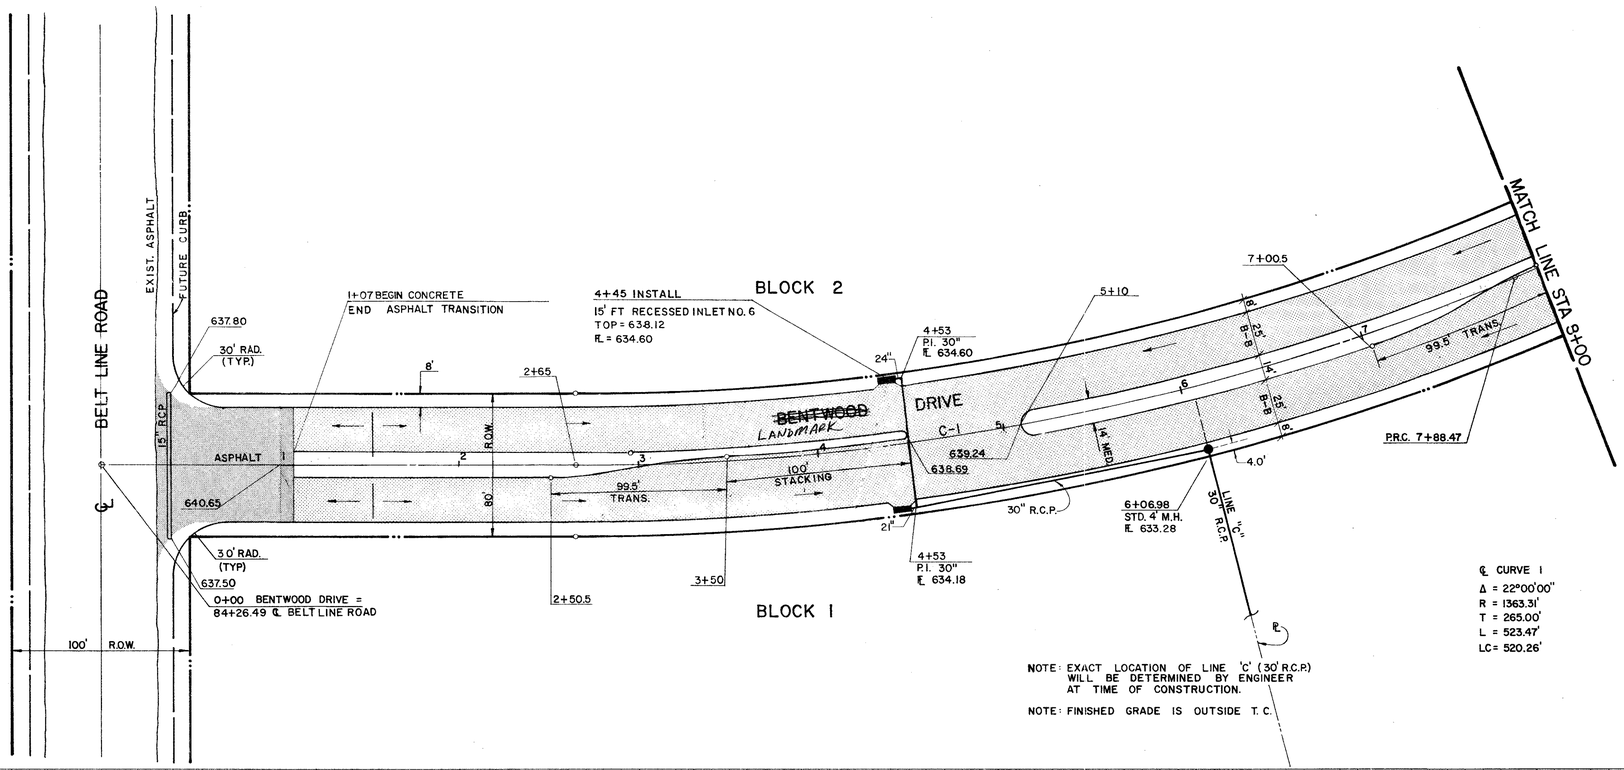

SCALE : 1"=40' HORIZ.
1"=4' VERT.

BENCHMARK NO. 1

U.S.C.G. disk in wall of school dated 1946, #921. Elev. 650.61

BENCHMARK NO. 2

R.R. spike in power pole in the south R.O.W. Belt Line Road, 1,171.3' west of centerline Dallas Parkway. Elev. 650.69

NOTE: Median cut locations are subject to change

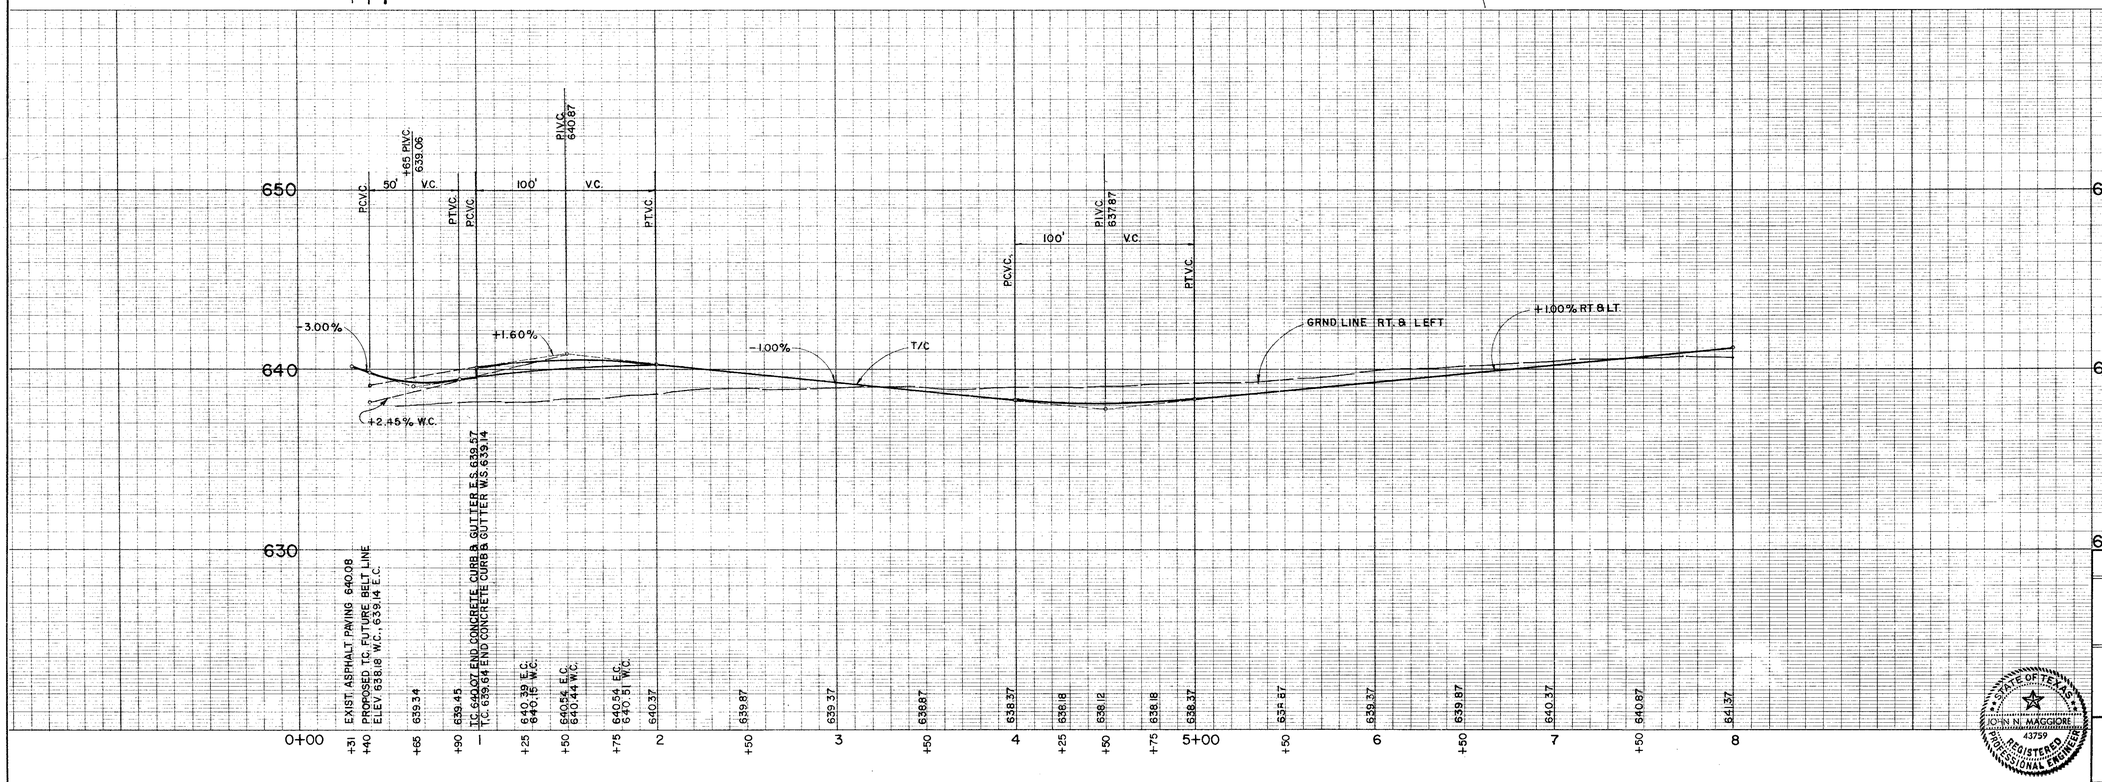

Revised 9/19/80

PAVING & DRAINAGE

BENTWOOD DRIVE

STA 0+00 TO STA. 8+00

QUORUM WEST
ADDISON, TEXAS

STATE OF TEXAS
JOHN N. MAGHORE
43759
REGISTERED PROFESSIONAL ENGINEER

Graham Associates, Inc.
CONSULTING ENGINEERS & PLANNERS

Date 2/26/80
File 425-2248

Drawn By: K.A.B.

Sheet 3 Of 15