
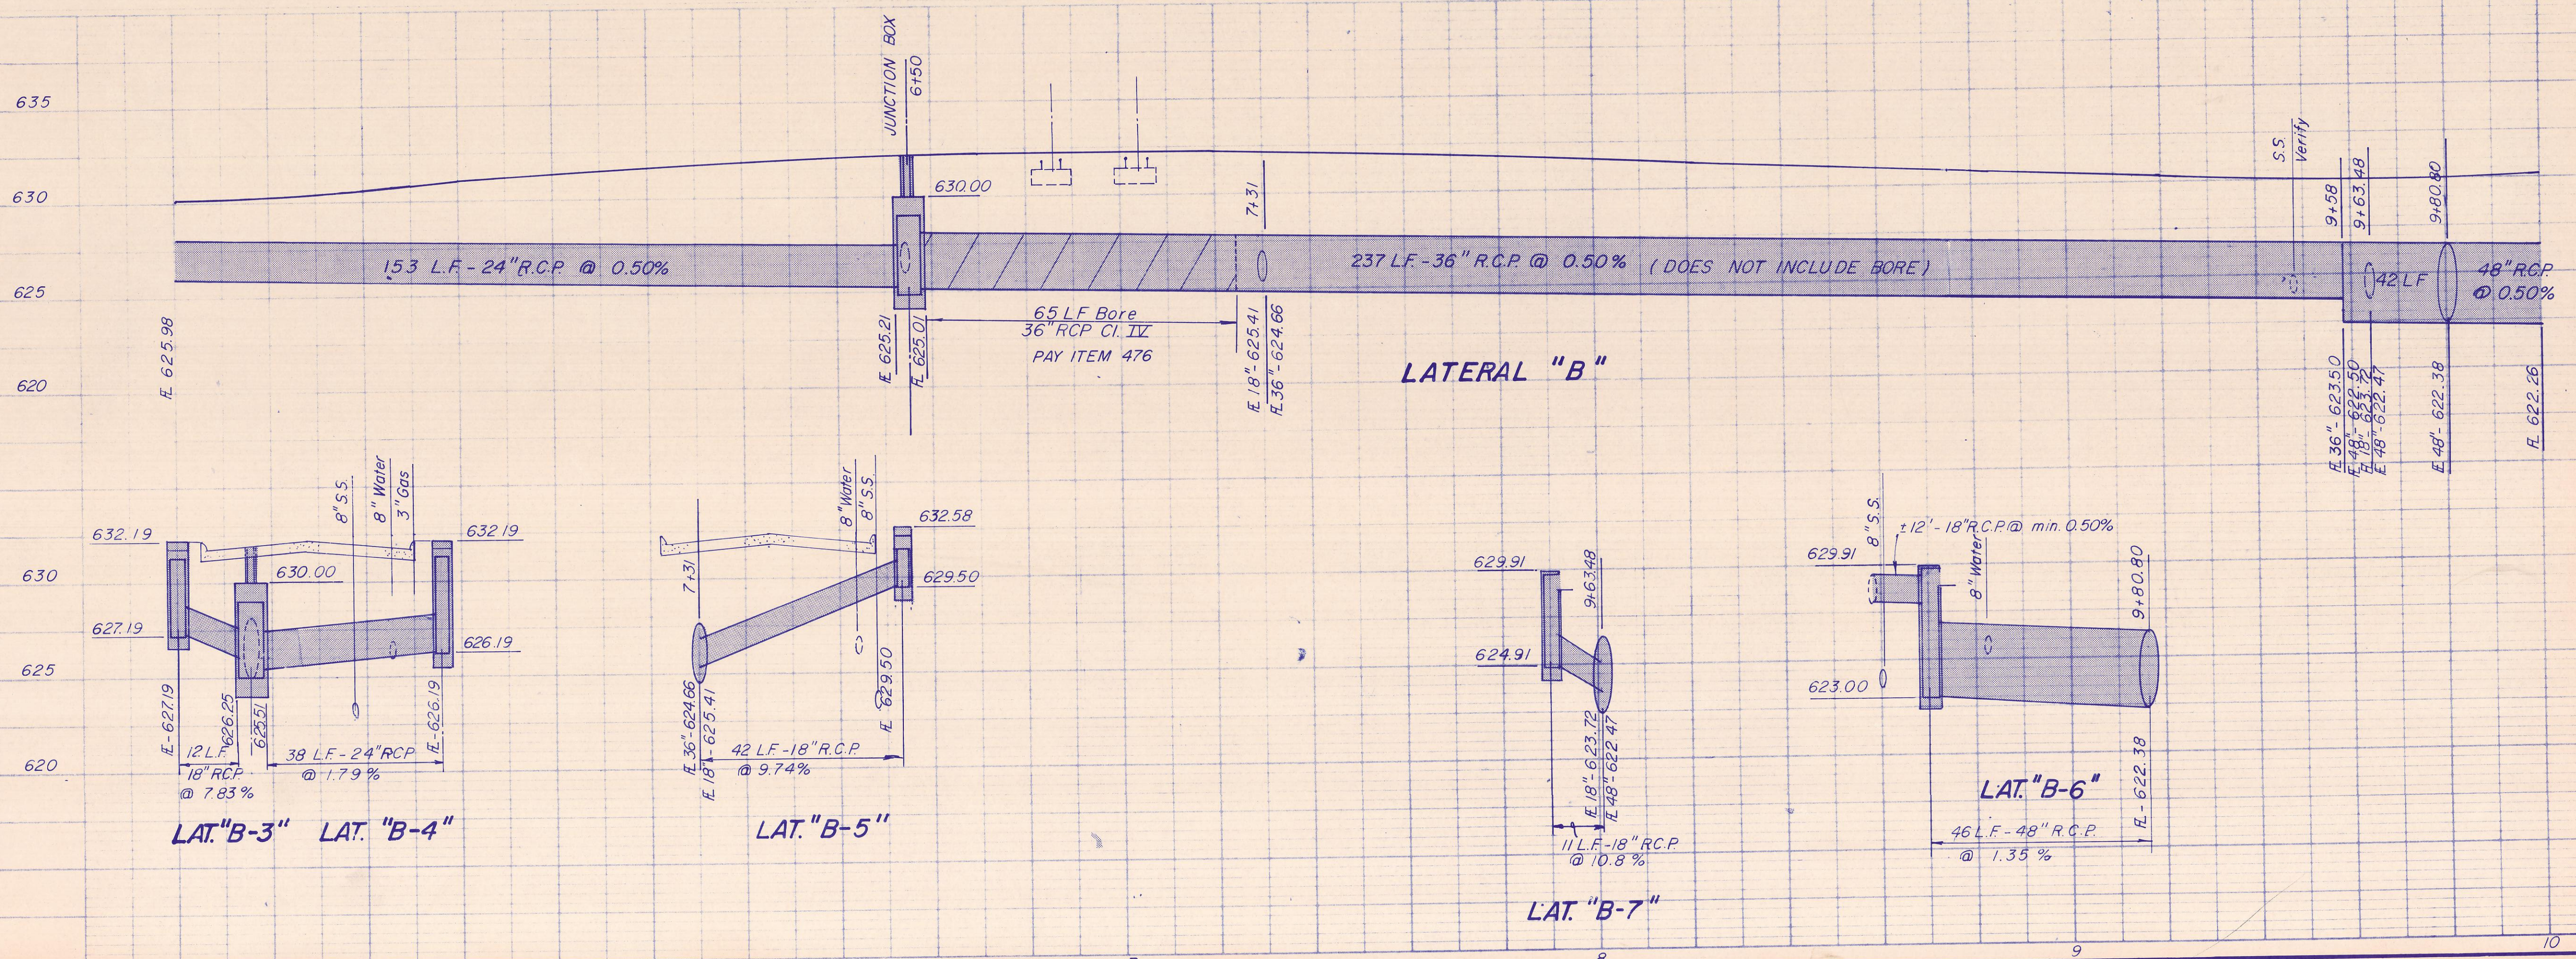


MATCH LINE - STA. 5+00

MATCH LINE - STA. 10+00

Reverse Curve Data
Δ = 16° 46' 00"
R = 329.31'
T = 48.53'
L = 96.37'

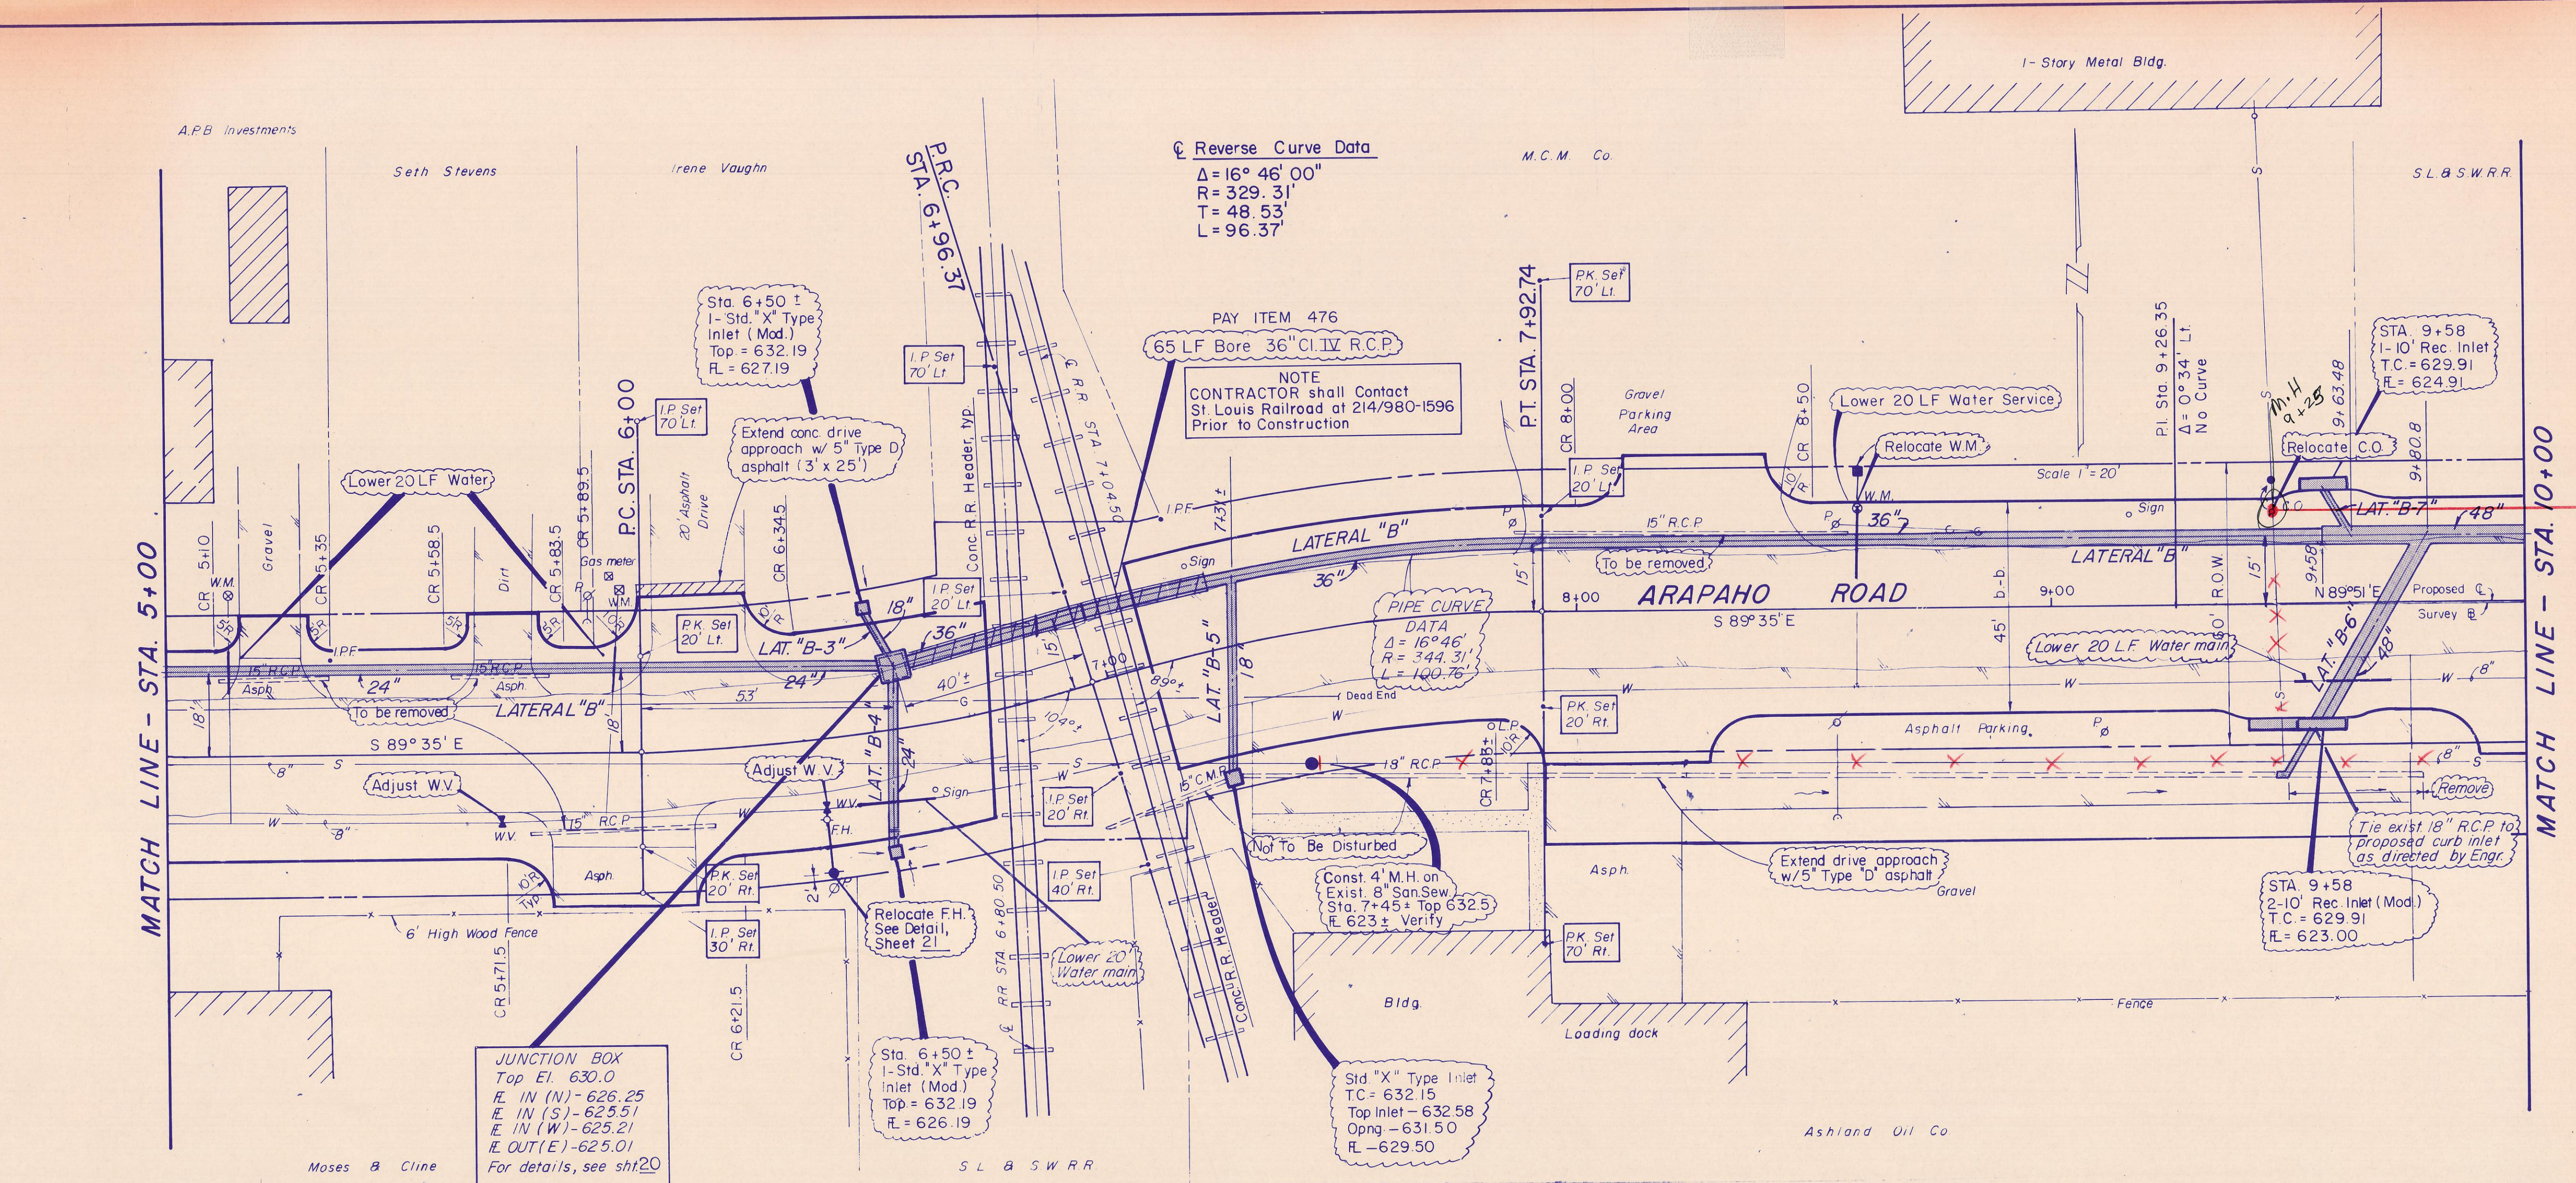

No.	Revision	By	Date
CITY OF ADDISON DALLAS COUNTY, TEXAS			
ARAPAH0 RD. / QUORUM DR. IMPROVEMENTS			
ARAPAH0 ROAD - DRAINAGE			
Sta. 5+00 to Sta. 10+00			
GINN, INC.			
Consulting Engineers Dallas, Texas			
Designed - GF	Drawn - GF	Date - DECEMBER, 1983	Job No. - J-177
Approved - HWG	Checked - HBJ	Scale - 1" = 20'	Sheet 14 of 22