

CONSTRUCTION PLANS FOR

# RATLIFF LANE IMPROVEMENTS

**MAYOR :**

Honorable JERRY REDDING


**COUNCIL MEMBERS :**

- RICHARD RODER, Mayor pro tem
- LYNN SPRULL
- BOBBY HATFIELD
- JOHN NOLAN
- JIM DUFFY

**CITY MANAGER :**

RON WHITEHEAD

Approved By : \_\_\_\_\_ Date : \_\_\_\_\_  
*Jerry Redding, Mayor of Addison*

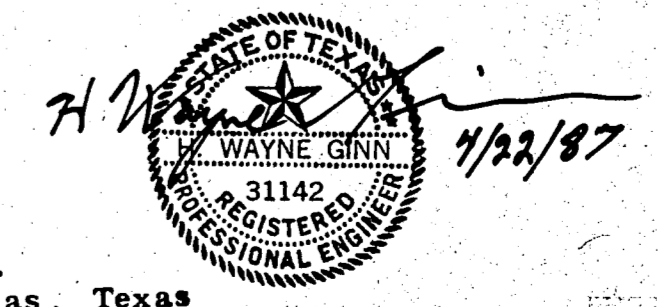

**GINN, INC.**  
 Consulting Engineers Dallas, Texas  
 MARCH 1987

**RECORD DRWG.**