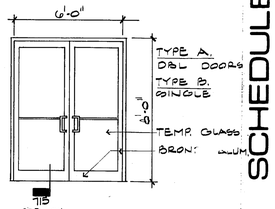

DOOR TYPES

DOOR SCHEDULE

No.	Hdw.	Type	Door Size	Thk.	Material	Frame	Head	Jamb	Sill	Remarks
1		A	6'-0" x 7'-10 3/4"	1 3/4	ALUM & TEMP GLASS	ALUM.	600SIM.		715	REFER TO SPECS FOR
2		C	3'-0" x 6'-8"	"	H.C. WD W/ PLAS. LAM.	KNOCK-DOWN				HARDWARE SCHEDULE
3		C	" "	"	" "					
4		D	2'-8" x 6'-8"	"	S.C. WD W/ PLAS. LAM.					
5		D	" "	"	" "					
6		C	3'-0" x 6'-8"	"	H.C. WD W/ PLAS. LAM.					
7		C	" "	"	" "					
8		C	" "	"	" "					
9		C	" "	"	" "					
10		C	" "	"	" "					
11		C	" "	"	" "					
12		C	" "	"	" "					
13		C	" "	"	" "					
14		E	" "	"	S.C. WD PAINT GRADE					DOOR SWEEP
15		D	" "	"	S.C. WD W/ PLAS. LAM.					1 HR RATED, DOOR SWEEP
16		C	" "	"	H.C. WD W/ PLAS. LAM.					
17		D	" "	"	S.C. WD W/ PLAS. LAM.					
18		D	" "	"	" "					

No.	Hdw.	Type	Door Size	Thk.	Material	Frame	Head	Jamb	Sill	Remarks
19		D	3'-0" x 6'-8"	1 3/4	S.C. WD W/ PLAS. LAM.	KNOCK DOWN	⚠			
20		B	3'-0" x 7'-10 3/4"	"	ALUM. & TEMP. GLASS	ALUM			715	
21		F	3'-0" x 7'-0"	"	H.C. MTL	HOL.MTL.	714	714SIM.	716	
22		G	10'-0" x 10'-0"	—	24 GAGE MTL	—	602	705	602	
23		G	10'-0" x 12'-0"	—	" "	—				
24		G	10'-0" x 10'-0" ⚠	—	" "	—				
25		G	" "	—	" "	—				
26		E	3'-0" x 6'-8"	1 3/4	S.C. WD. PAINT GRADE	KNOCK DOWN	⚠			
27		F	3'-0" x 7'-0"	"	H.C. MTL	HOL.MTL.	714	714SIM.	716	
28		F	" "	"	" "					
29		F	" "	"	" "					
30		G	10'-0" x 10'-0"	—	24 GAGE MTL	—	602	705	602	
31		G	" "	—	" "	—				
32		G	" "	—	" "	—				
33		D	3'-0" x 6'-8"	1 3/4	SC. WD W/ PLAS. LAM.	KNOCK DOWN				
34		C	" "	"	H.C. WD W/ PLAS LAM					
35		C	" "	"	" "					
36		C	" "	"	" "					
37		D	" "	"	SC. WD W/ PLAS LAM					
38		C	" "	"	H.C. WD W/ PLAS LAM					
39		H	5'-0" x 6'-8"	1 3/8	H.C. BIFOLD					READ IN RMS 103 & 130
40		C	3'-0" x 6'-8"	1 3/4	H.C. WD W/ PLAS. LAM.					
41		D	" "	"	S.C. WD W/ PLAS. LAM					

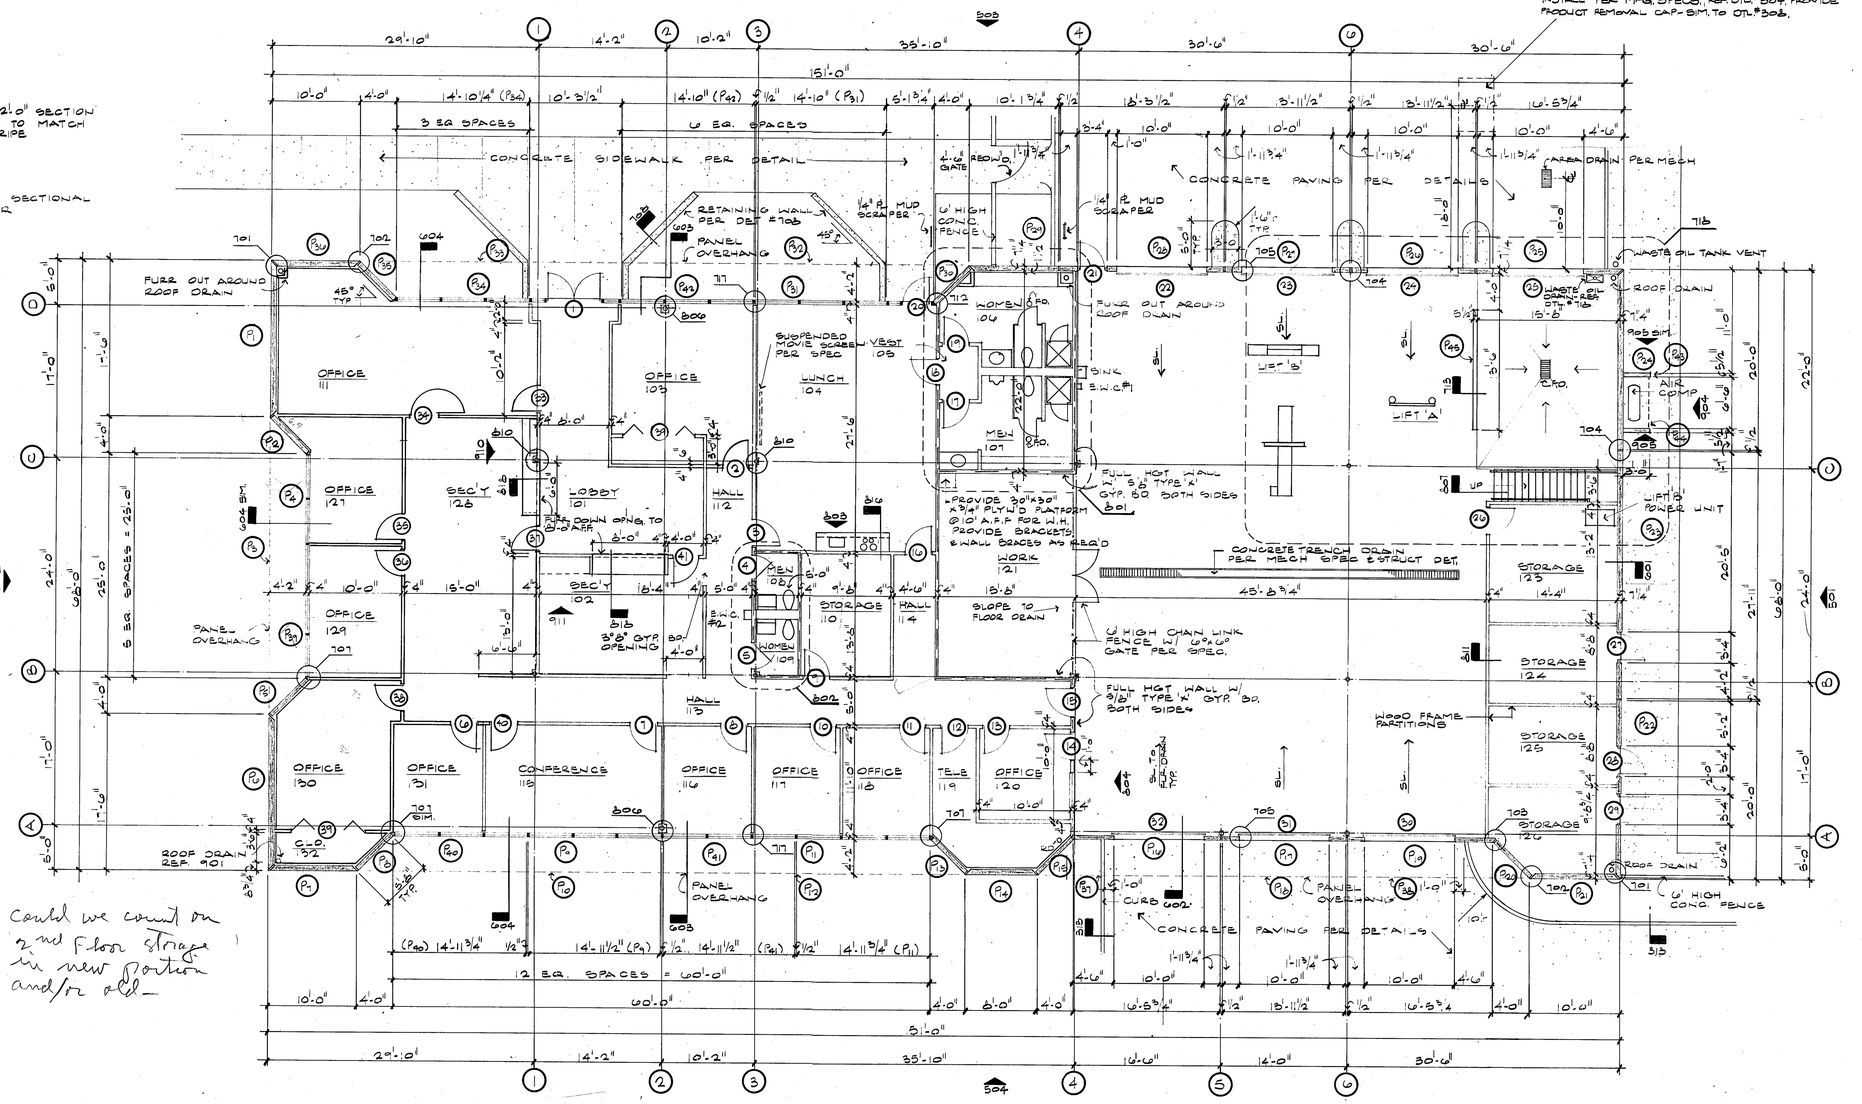

01 FLOOR PLAN

SCALE: 1/8" = 1'-0"

EDI CAPE HOPKINS CLEMENT INC.
PLANNING ARCHITECTURE INTERIOR DESIGN
TWO NORTHPARK EAST. 120 · DALLAS 214/750-1945
AMERICAN INSTITUTE OF ARCHITECTS AMER SOC CONSULTING ENGINEERS

City of Addison
PUBLIC WORKS SERVICE CENTER
Dooley Road
Addison Texas

ISSUE DATE 6/12/80
REVISIONS
⚠ 8/15/80 ADDENDUM #1

SHEET NUMBER 4

#8000.00