

EDI ARCHITECTS, INC.

EDI

TOWN OF ADDISON

ADDITION TO PUBLIC WORKS SERVICE CENTER



**DATE
11 JUNE 86
24 JULY 1986 - BID**

SHEET NO

A2.4

OF SHEETS

JOB NO: 851-137

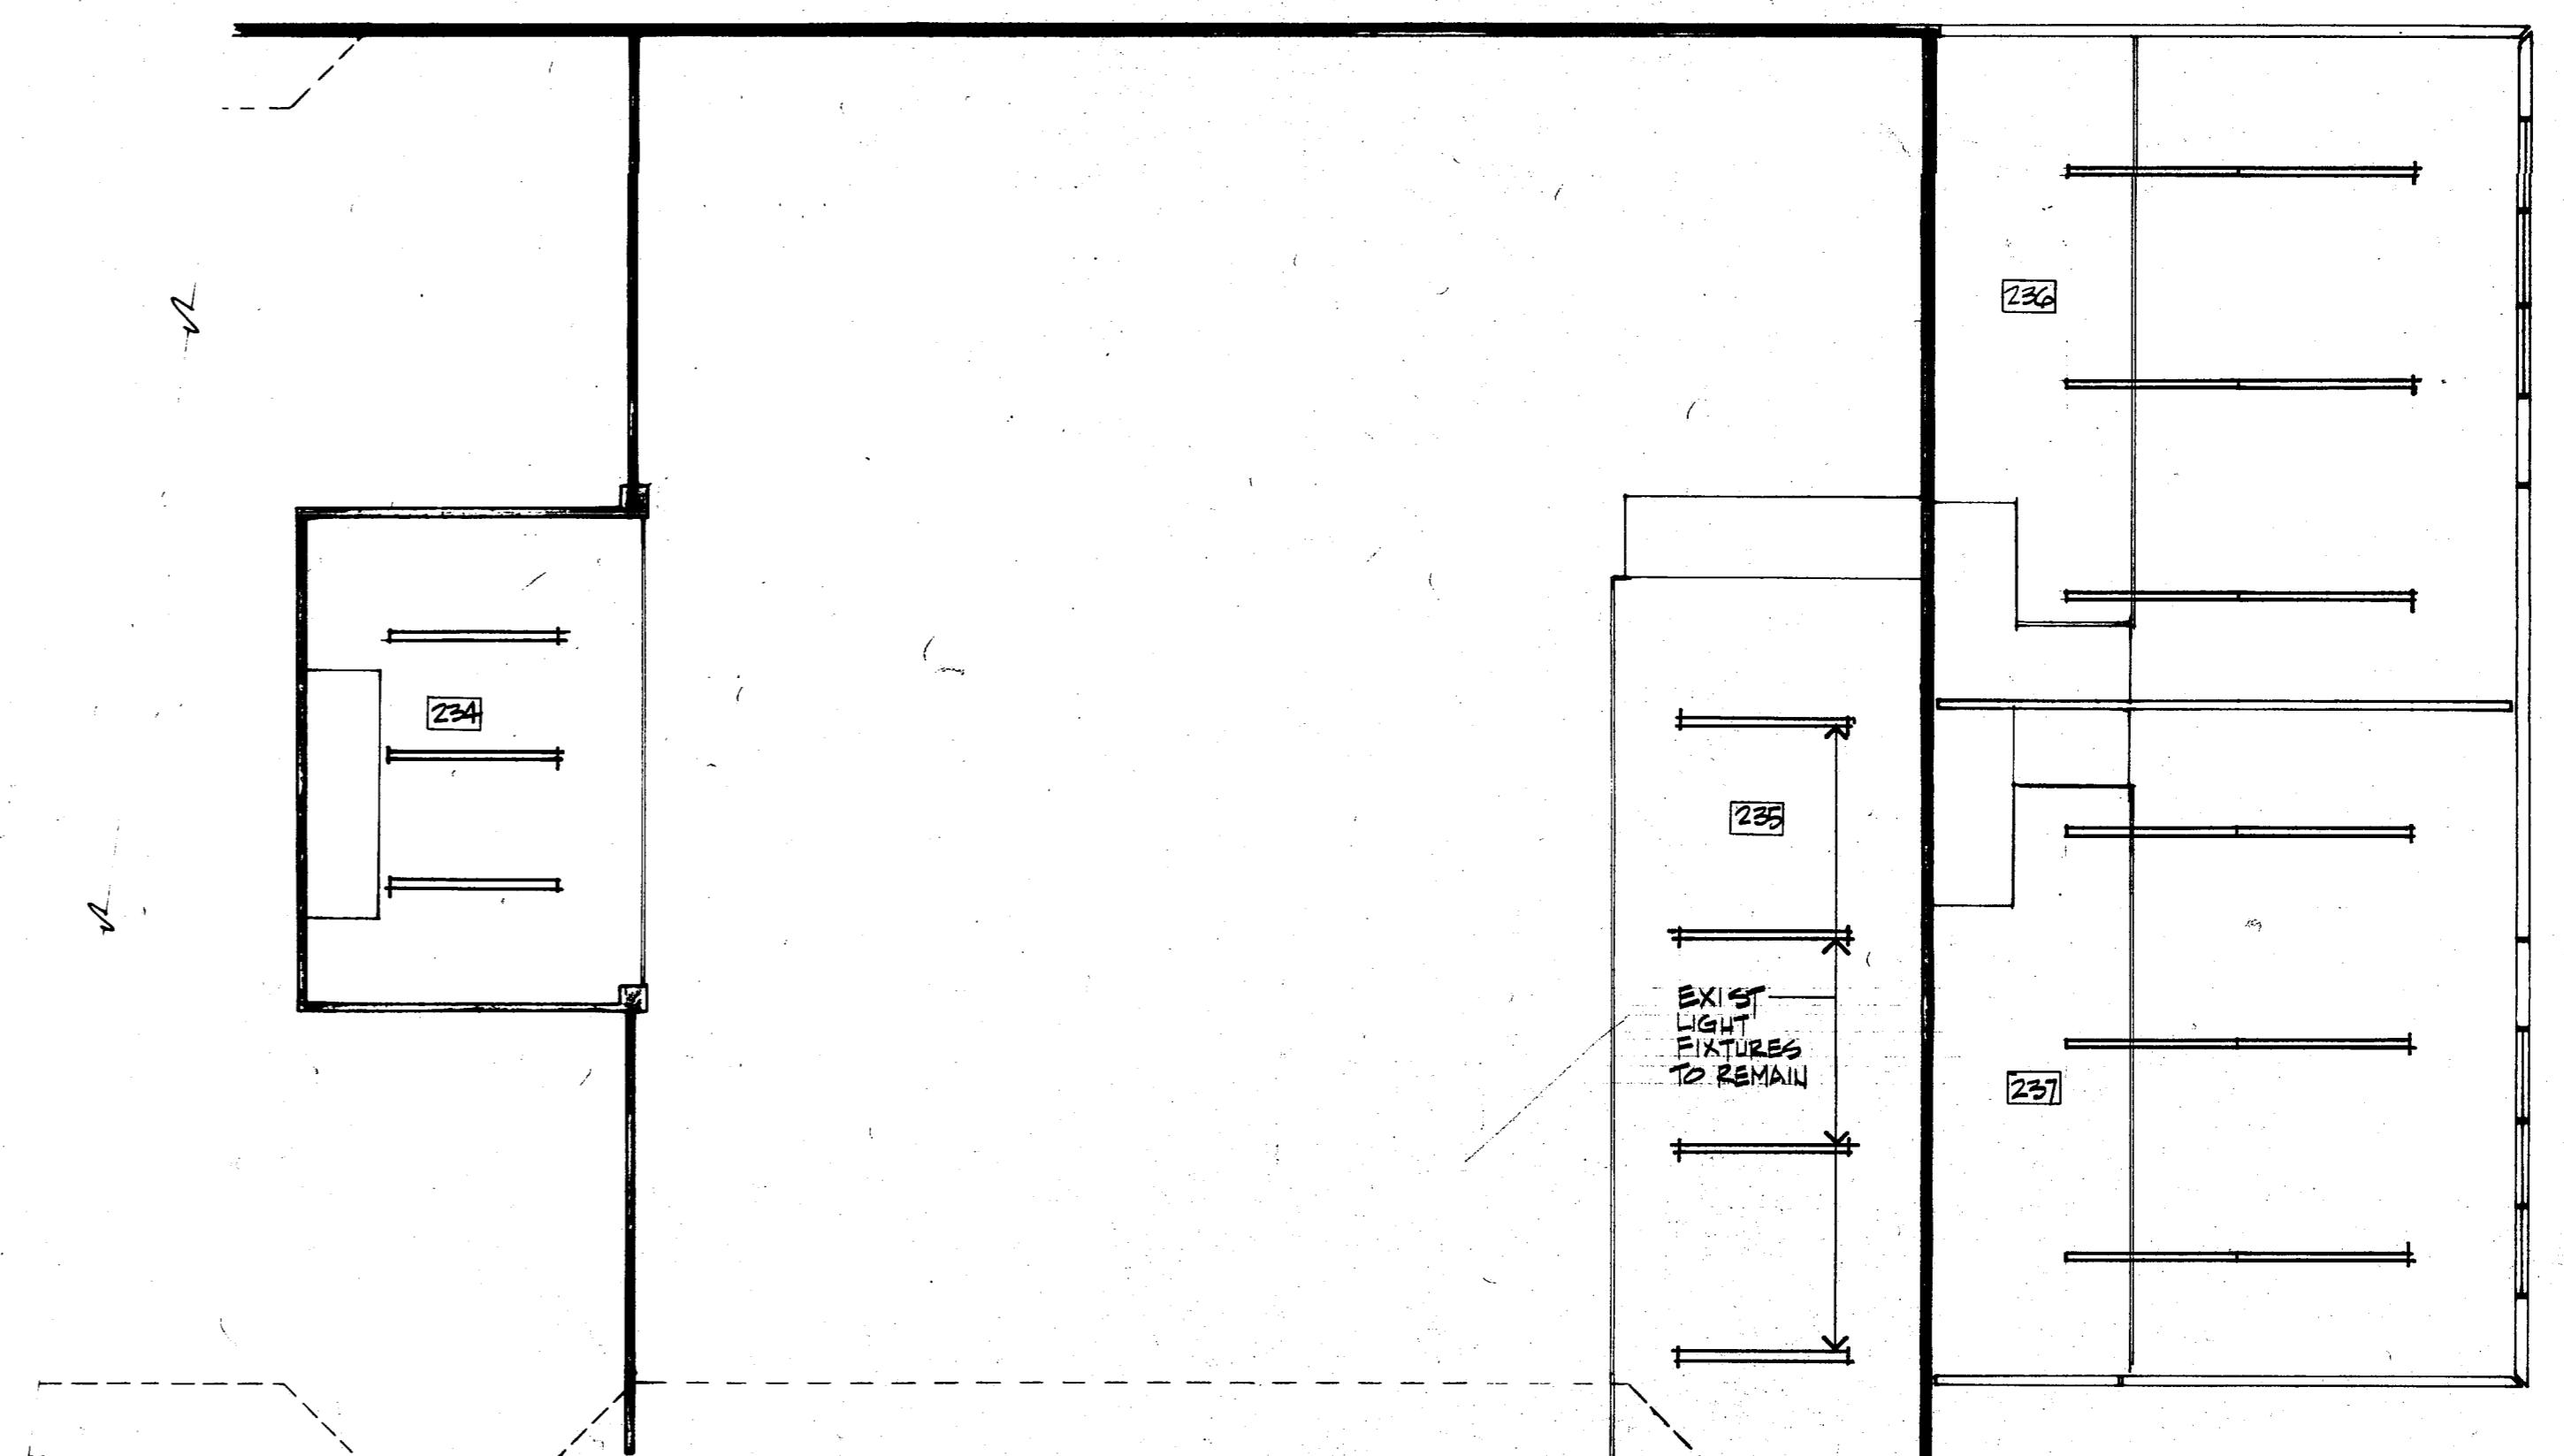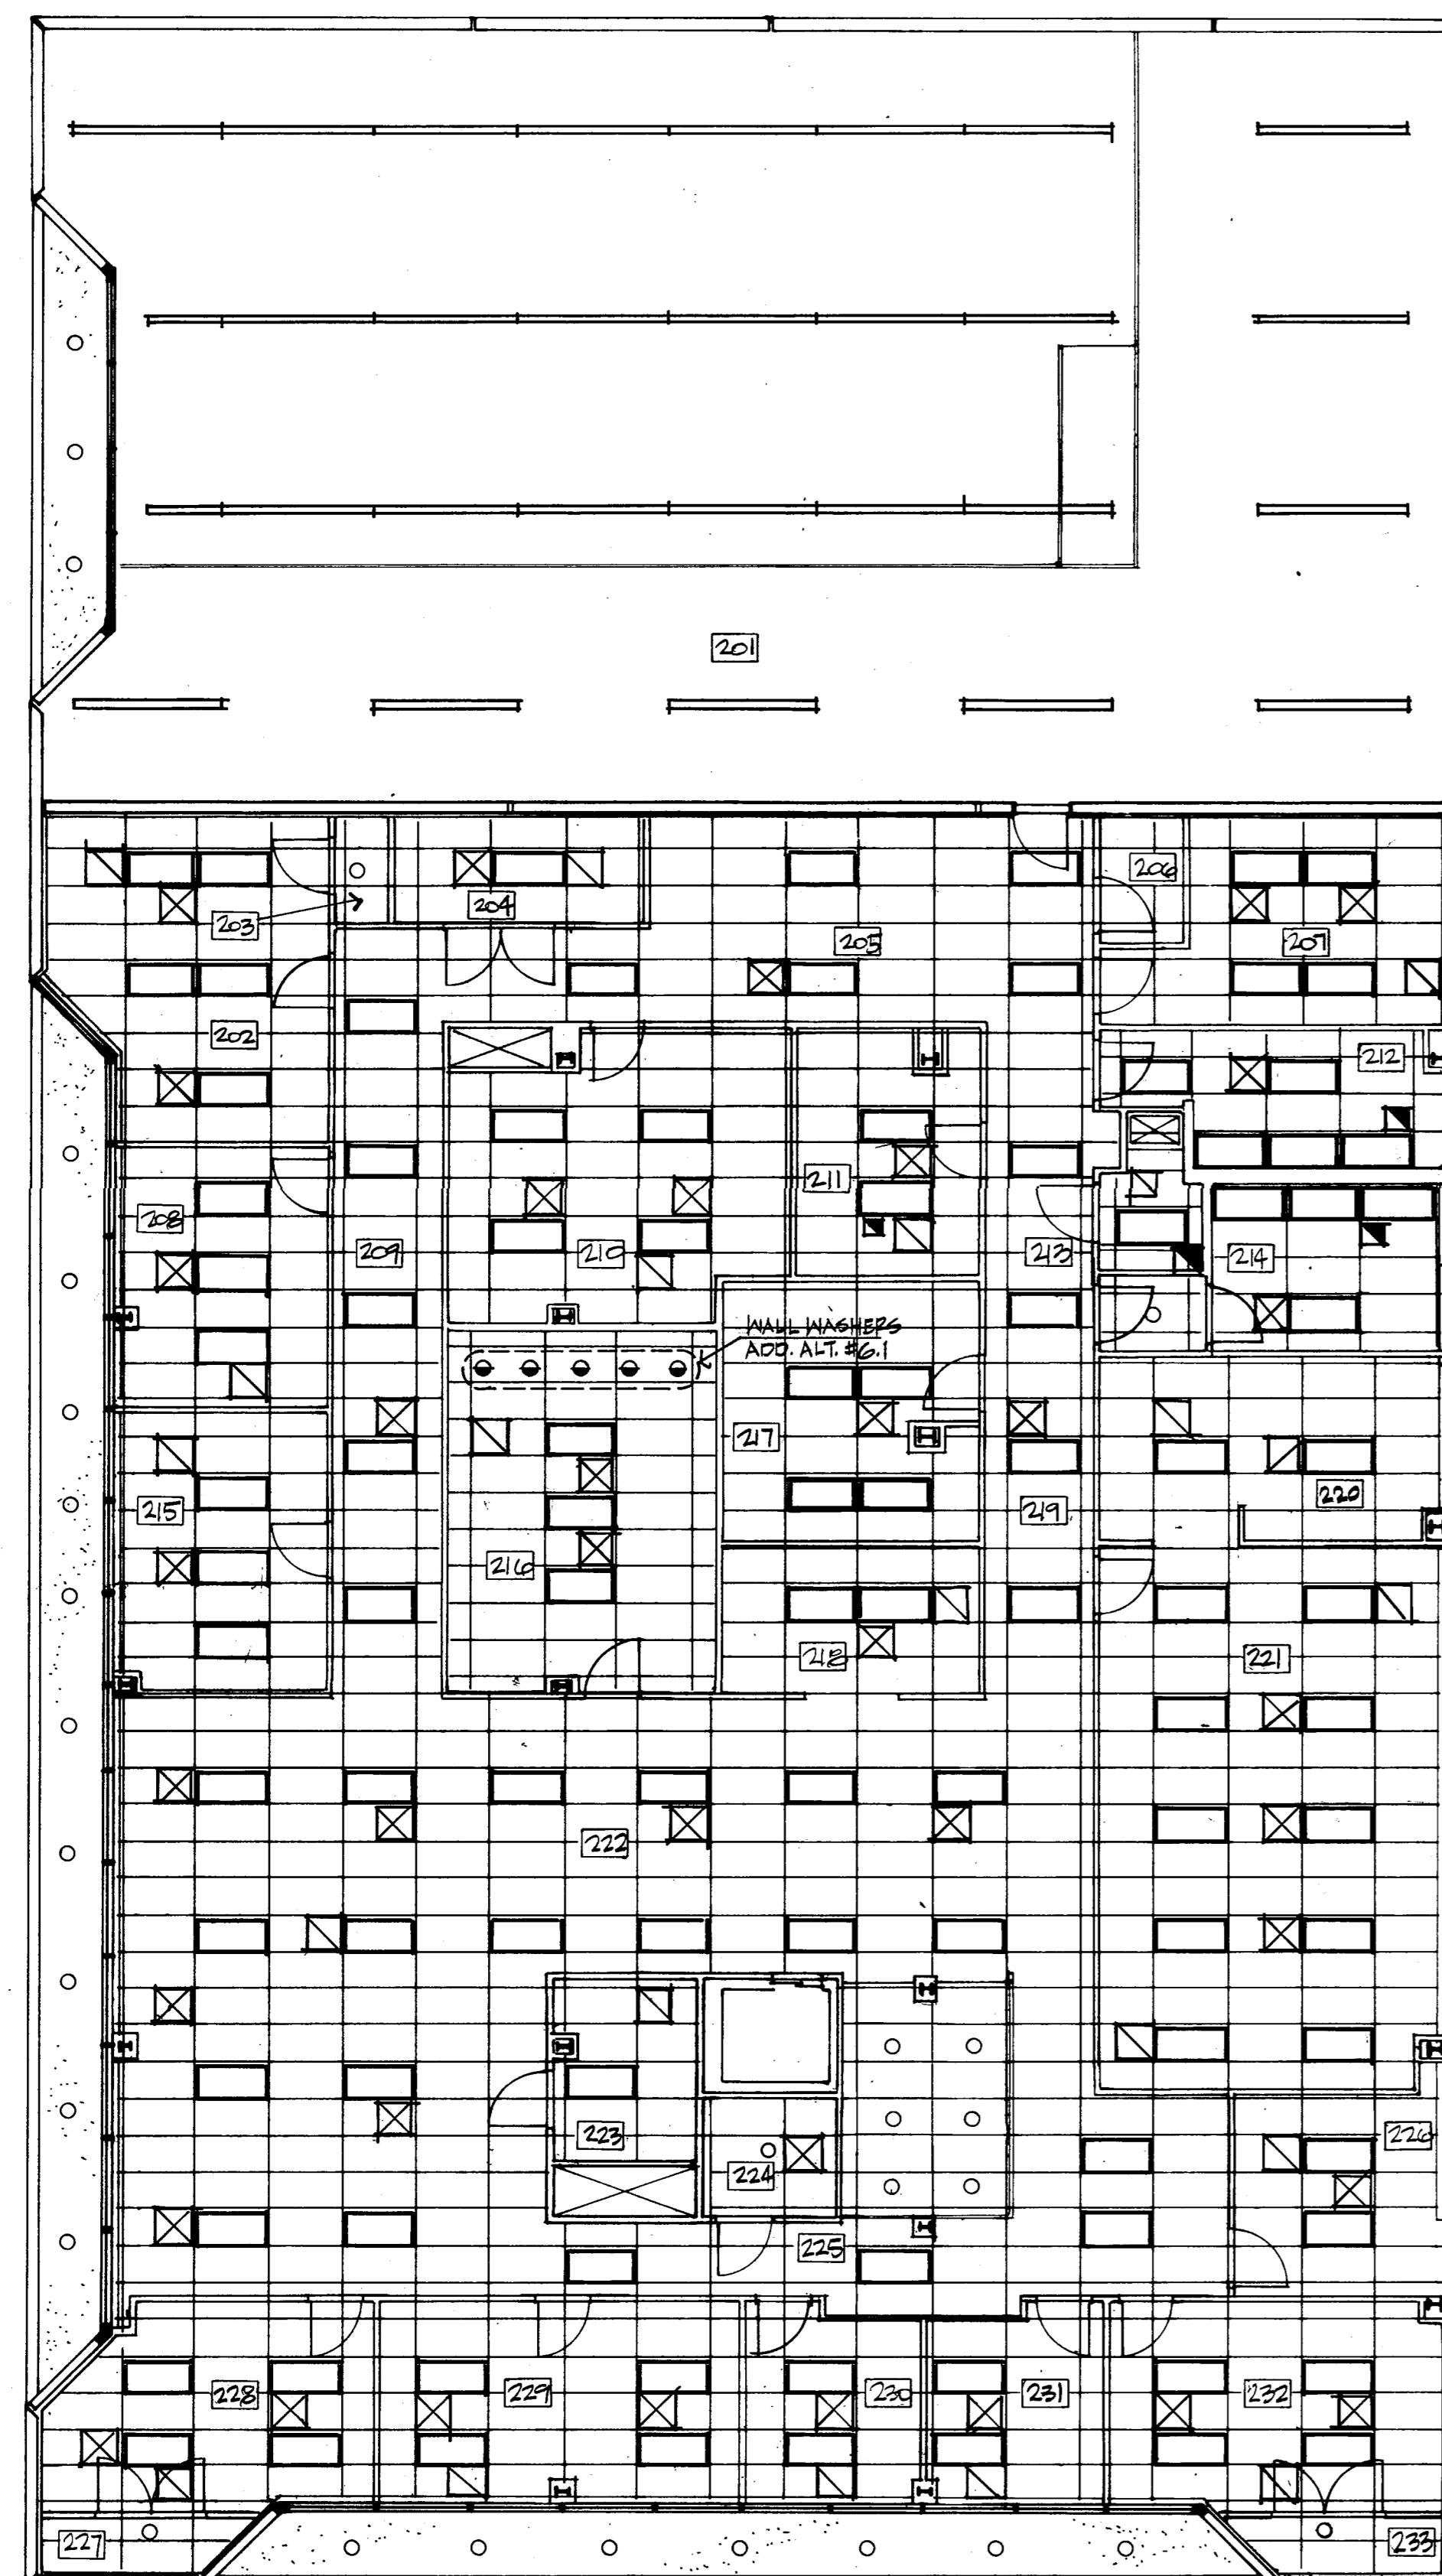

TOWN OF ADDISON
BUILDER'S COPY OF PLANS
This set of plans contains various corrections and comments made by the City Staff. All trades will be required to comply with these corrections and comments. Failure to comply with these corrections and comments will not be accepted as a reason to approve construction which is in violation of local ordinances.
This set of plans is to be kept on the job site at all times and is to be made available for use by city inspectors at their request. Failure to have these plans available may delay approval of a requested inspection.

EDI ARCHITECTURE PLANNING ENGINEERING INTERIOR DESIGN

**AMERICAN BANK TOWER
SUITE 300
AUSTIN, TEXAS 78701
612 469 8309**

**VALNUT HILL LANE
SUITE 100
DALLAS, TEXAS 75231
214 750-1949**