


EDI ARCHITECTS, INC.
 ARCHITECTURE PLANNING ENGINEERING INTERIOR DESIGN
 AMERICAN BANK TOWER
 SUITE 500
 DALLAS TEXAS 75202
 AUSTIN, TX / 489-8308

TOWN OF ADDISON
 ADDISON

**ADDITION TO
 PUBLIC WORKS SERVICE CENTER**
 Westgrove Road
 Addison Texas

DATE: 5-16-86
 11 JUNE 86
 24 JULY 1986 - BID

SHEET NO:
A2.5
 OF SHEETS
 JOB NO: 851-137

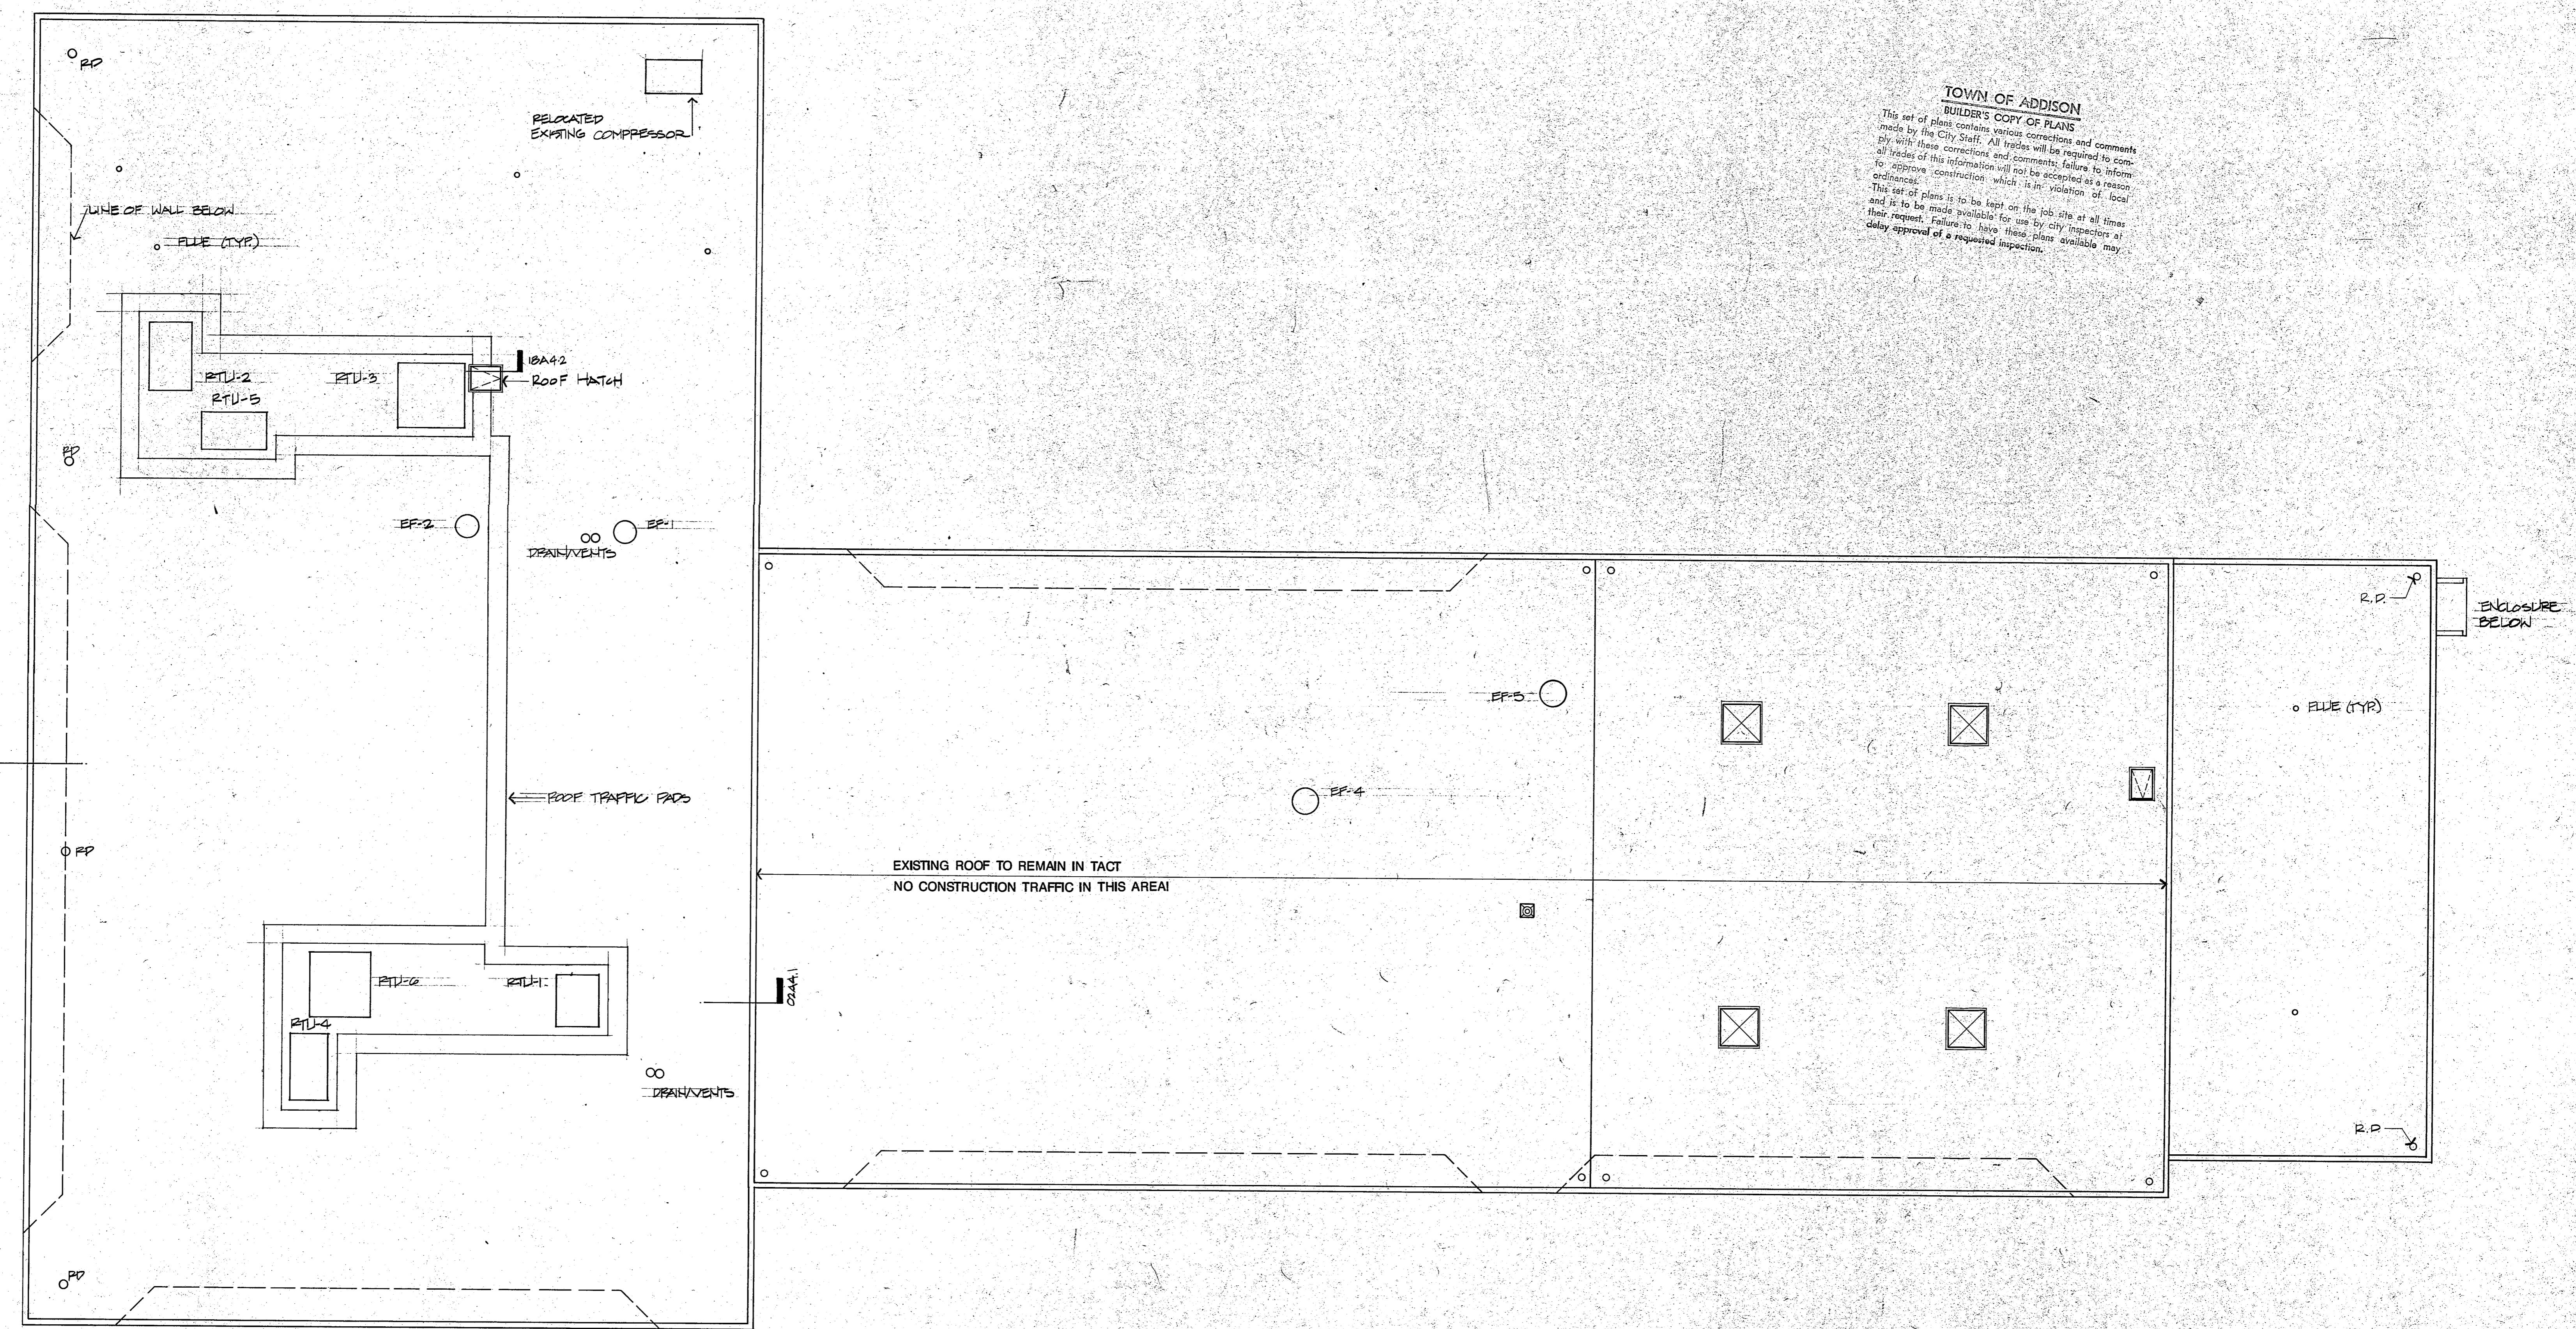

TOWN OF ADDISON
BUILDER'S COPY OF PLANS
 This set of plans contains various corrections and comments made by the City Staff. All trades will be required to comply with these corrections and comments. Failure to inform the City Staff of these corrections and comments will result in the City Staff not being able to approve construction which is in violation of local ordinances.
 This set of plans is to be kept on the job site at all times and it is to be made available for use by city inspectors at their request. Failure to have these plans available may delay approval of a requested inspection.

01 ROOF PLAN
 A2.5 1/8"=1'-0"

