

EDI ARCHITECTS, INC.
 ARCHITECTURE PLANNING ENGINEERING INTERIOR DESIGN
 8440 WALNUT HILL LANE AMERICAN BANK TOWER
 SUITE 100 DALLAS, TEXAS 75201
 814 / 750-1948 AUSTIN, TEXAS 78701
 512 / 468-6308

TOWN OF
ADDISON

**ADDITION TO
 PUBLIC WORKS SERVICE CENTER**
 Addison Texas
 Westgrove Road


DATE: 5-16-86
 11 JUNE 86
 24 JULY 1986 - BID

SHEET NO:
A8.1
 13 OF 16 SHEETS
 JOB NO: 851-137

NOTES:

- 1 EXISTING DOORS TO REMAIN IN PLACE
 #914 THRU 917
 929 THRU 936
 940 THRU 942
 REMOVE AND STORE ALL OTHER DOORS & FRAMES
 FOR RE-USE. REF. DOOR SCHEDULE
- 2 REMOVE AND STORE ALL PLUMBING FIXTURES
 FOR RE-USE
- 3 REMOVE AND STORE LOCKERS FOR OWNERS RE-USE
- 4 REMOVE AND RE-USE ALL KITCHEN APPLIANCES
- 5 REMOVE AND RE-USE EXISTING CEILING TILES,
 METAL GRID, DIFFUSERS AND LIGHT FIXTURES AS
 INDICATED

**TOWN OF ADDISON
 BUILDING DEPARTMENT**
 This set of plans contains various corrections and comments
 prepared by the City Staff. All trades will be required to comply
 with all corrections and comments. Failure to comply with any
 of the above information will not be acceptable. Information
 for existing construction which is in violation of applicable
 codes shall be to be kept on the job site at all times
 and to be made available for use by city inspectors at
 their request. Failure to have these plans available may
 delay approval of a requested inspection.

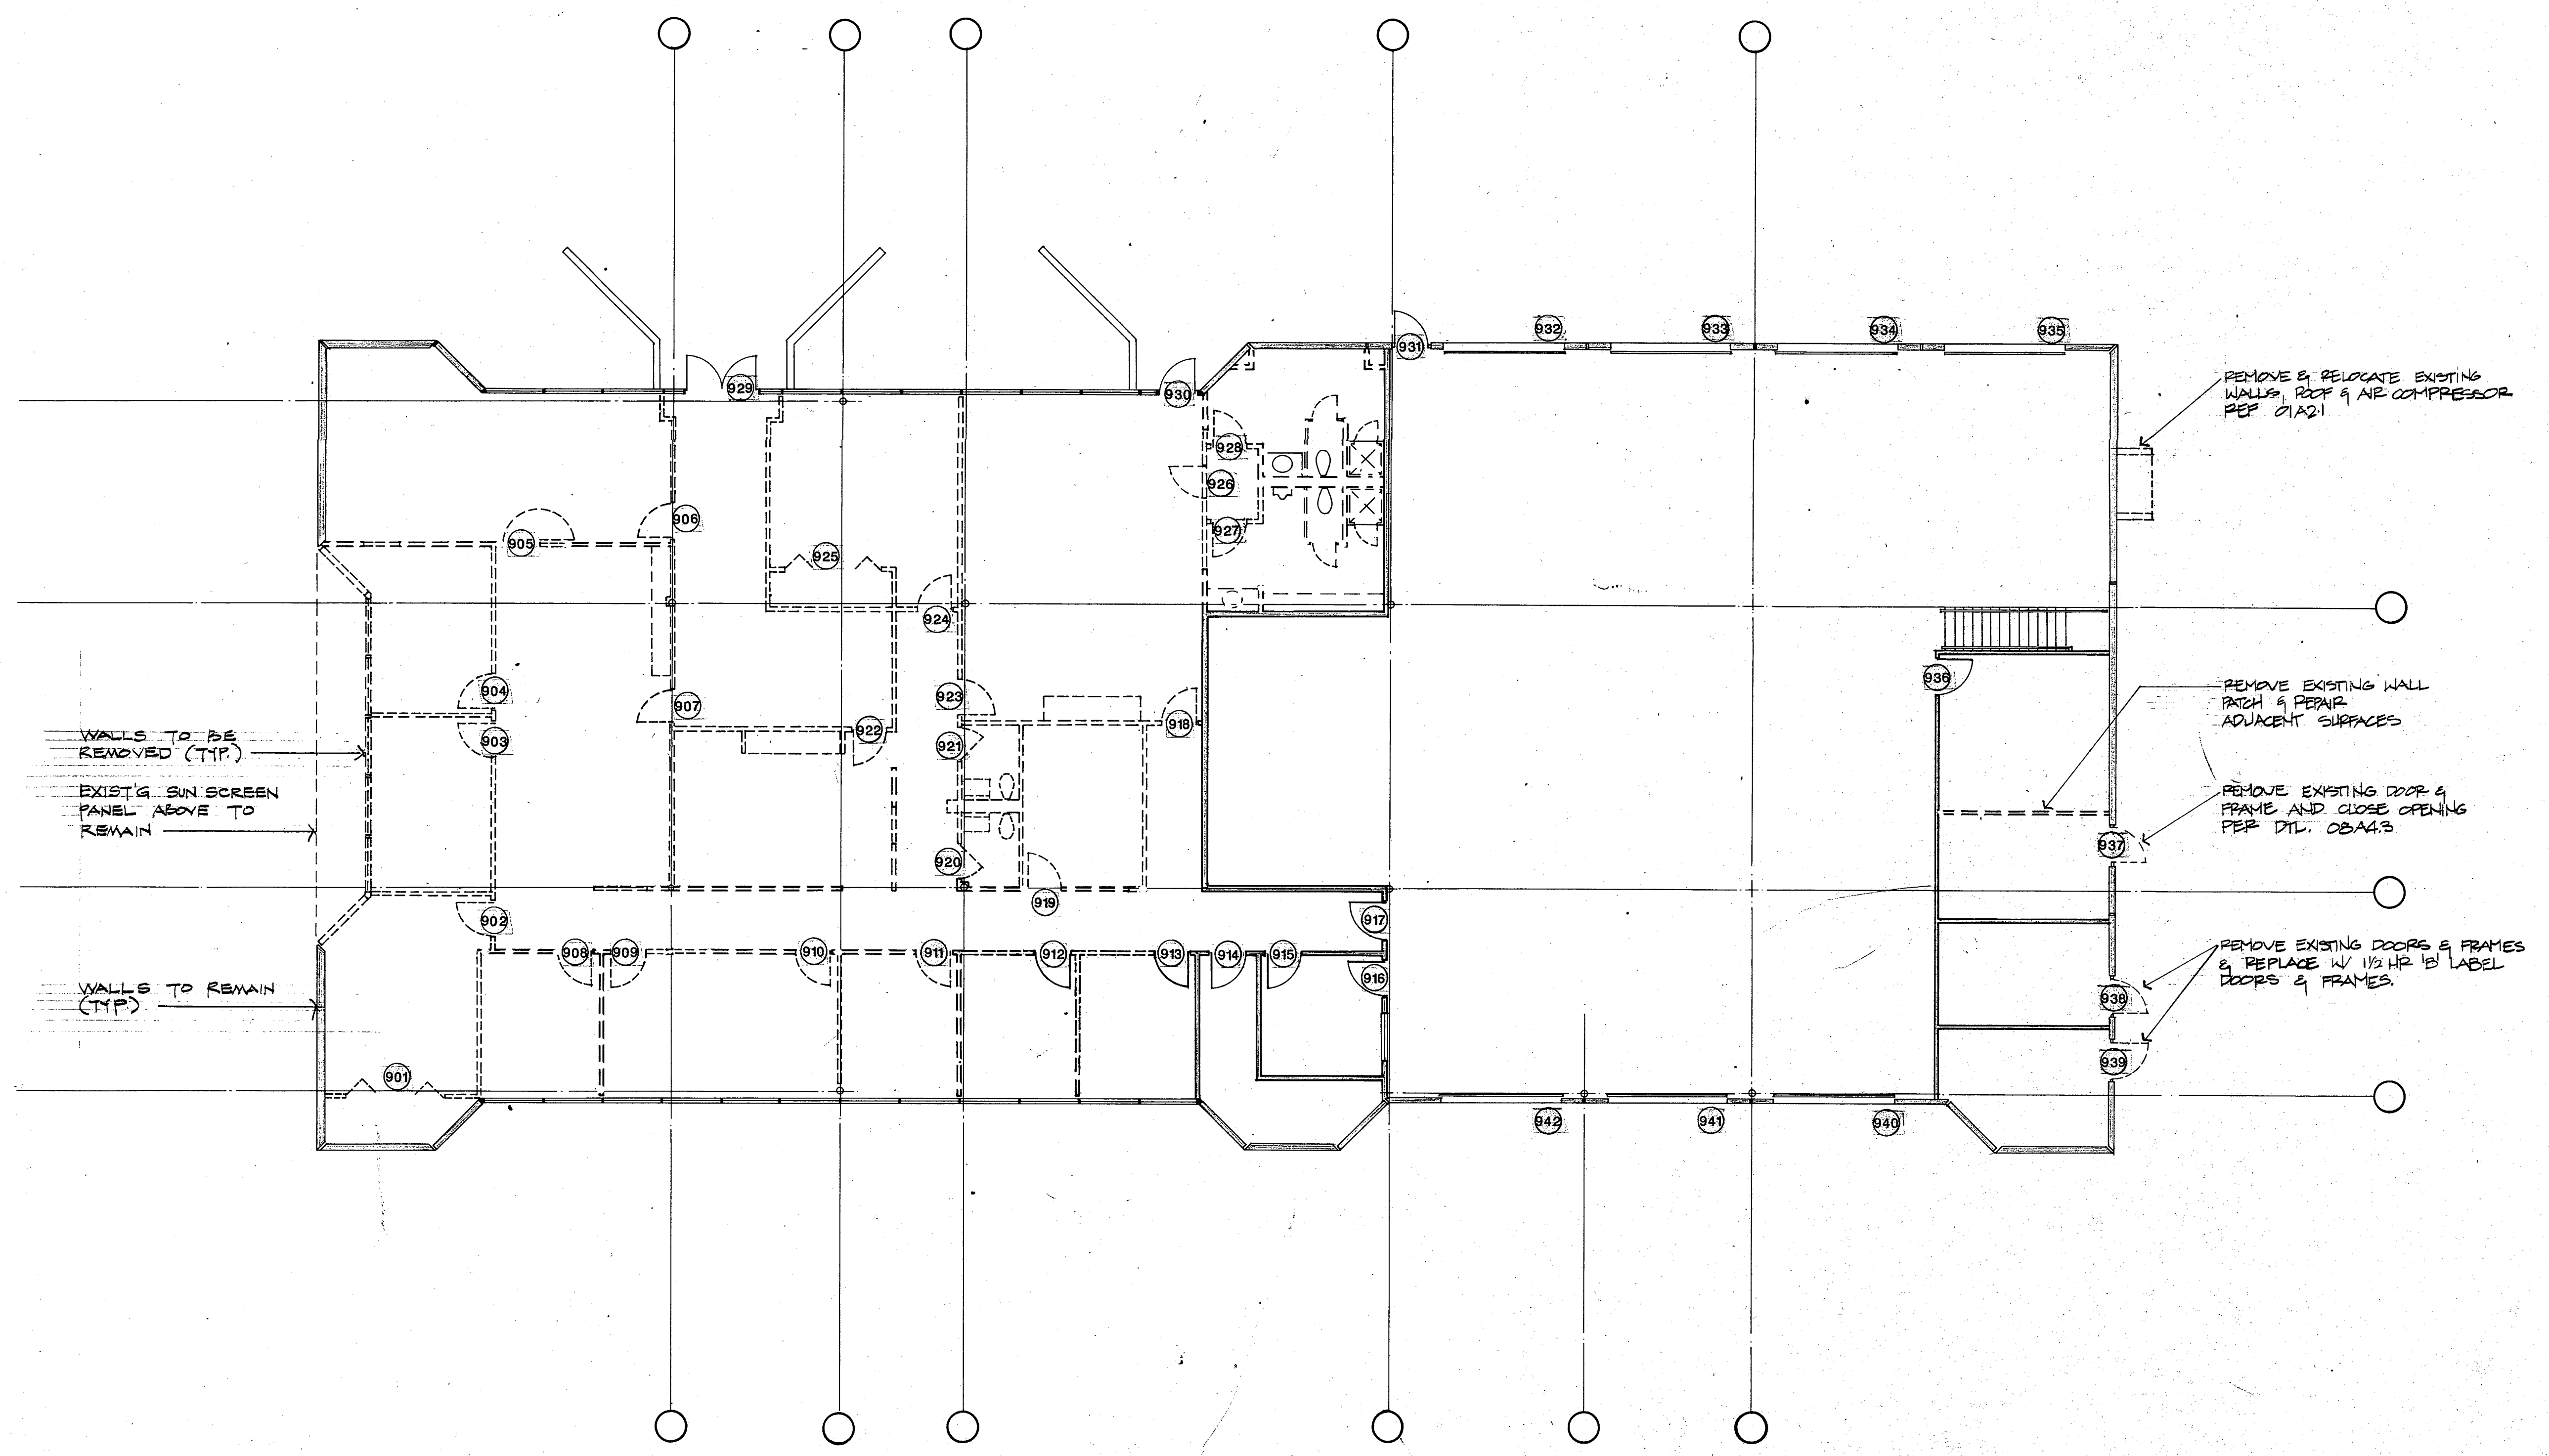

01 DEMOLITION PLAN
 A8.1 1/8" = 1' - 0"

JOB NO SHEET

JOB NO SHEET

JOB NO SHEET

JOB NO SHEET