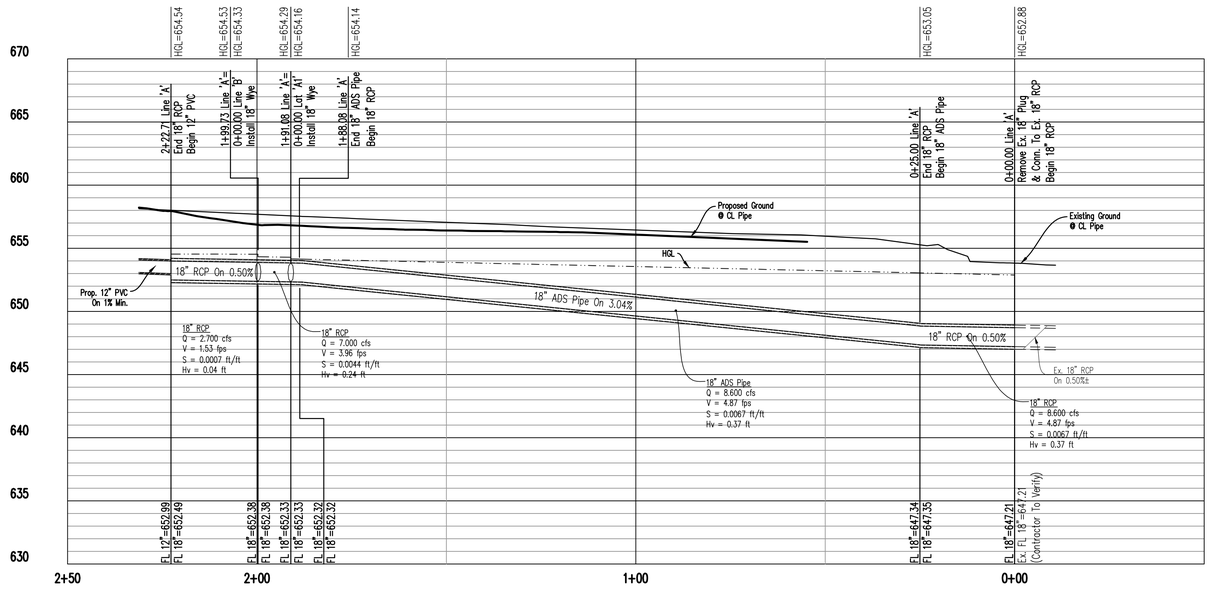


## Storm Line 'A' (PUBLIC)

1"=20': H
1"=6': V

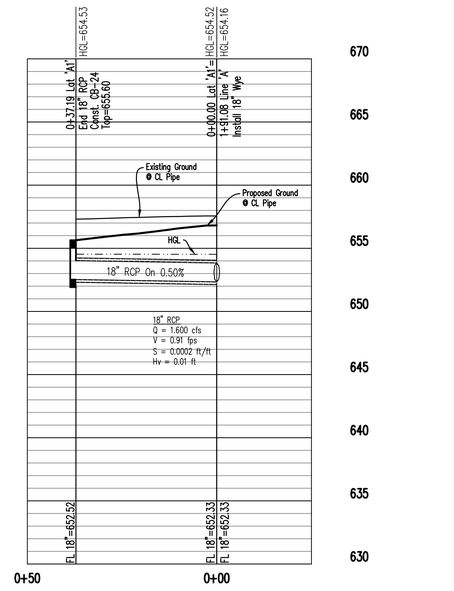


## Storm Lat 'A1' (PUBLIC)

1"=20': H
1"=6': V

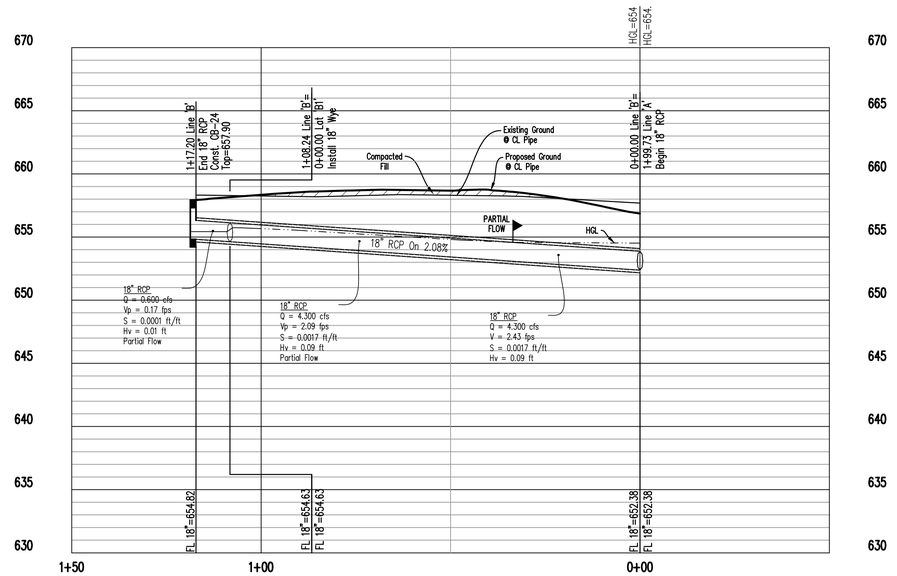


## Storm Line 'B' (PUBLIC)

1"=20': H
1"=6': V

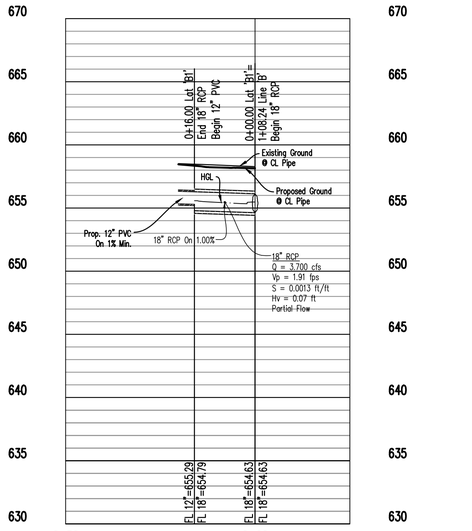


## Storm Lat 'B1' (PUBLIC)

1"=20': H
1"=6': V

RECORD DRAWINGS

NOTE:
THESE PLANS HAVE BEEN REVISED TO CONFORM WITH CONSTRUCTION RECORDS PROVIDED BY THE CONTRACTOR.


SPIARS ENGINEERING
765 Custer Road, Suite 100 • Plano, TX 75075 • (972) 422-0077
TBPE No. F-2121 • TBPLS No. F-10043100


STATE OF TEXAS
DAVID J. BOND
122081
LICENSED
PROFESSIONAL ENGINEER
4/5/18

KNIGHT RENOVATIONS
LOT 2R, BLOCK A
TOWN OF ADDISON
DALLAS COUNTY, TEXAS

STORM SEWER PROFILES

Issue Dates:
September 16, 2016

| Revisions | Date |
|---|---|

Scale: As Shown
Drawn By: BLM
Checked By: JWS

Sheet C 5
of 10

SEI No. 16-036


Plotted by: Barrett Plot Date: 4/4/2018 8:04 AM
Drawing: C:\2016 JOBS\16-036 4200 Sojourn\16-036 Storm Sewer Profiles.dwg Saved By: Barrett Save Time: 1/26/2018 11:47:18 AM