


LINE A - 8" DIA. 8' PVC GEN. PIPE  
 LINE B - 8" DIA. 8' PVC GEN. PIPE  
 LINE C - 8" DIA. 8' PVC GEN. PIPE  
 LINE D - 8" DIA. 8' PVC GEN. PIPE  
 LINE E - 8" DIA. 8' PVC GEN. PIPE  
 LINE F - 8" DIA. 8' PVC GEN. PIPE

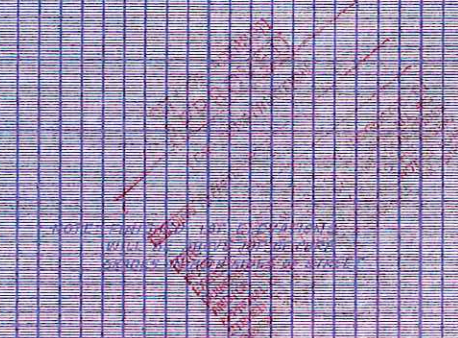

SANITARY SEWER PROFILES						
BENT TREE SOUTH ADDITION						
ADDISON, TEXAS						
C. L. MOON INC. ~ ENGINEER						
DALLAS, TEXAS						
DESIGN	DRAWN	DATE	SCALE	NOTES	FILE	NO.
MOON	RAM	April 1981	H: 1"=100' V: 1"=6'	J.C. G.O.		12