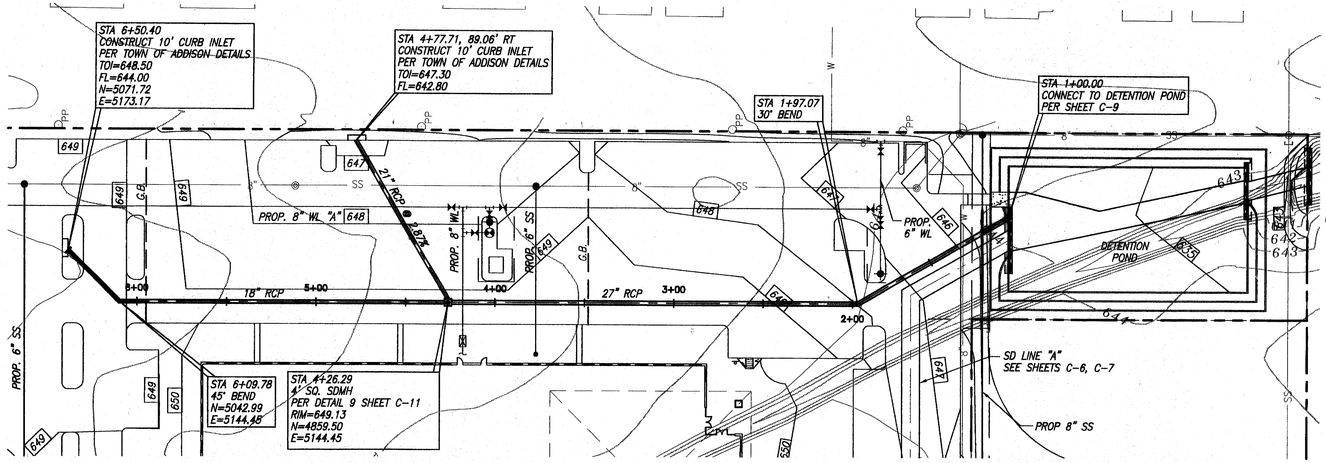

N

0 20' 40' 80'

1"=40'

NOTES

1. REFER TO DETAILED GRADING PLAN (SHEET C-3 FOR MH AND INLET RIM ELEVATIONS.)
2. STORM DRAIN PIPES SHALL BE CLASS III C-76 RCP, UNLESS NOTED OTHERWISE.
3. INLETS AND CONCRETE COLLARS SHALL BE CONSTRUCTED PER TOWN OF ADDISON DETAILS. STORM DRAIN MANHOLE SHALL BE CONSTRUCTED PER DETAIL 9 SHEET C-11.
4. REFER TO UTILITY PLAN (SHEET C-10) FOR PROPOSED WATER AND SEWER LAYOUT.

RECORD DRAWING
BASED ON THE INFORMATION SUPPLIED BY THE CONTRACTOR DATED 3-3-00 TO: THH

THE SEAL APPEARING ON THIS DOCUMENT WAS AUTHORIZED AND SIGNED BY ENGINEER: TRICIA H. HATLEY
TEXAS REGISTRATION NO: 83282
DATE OCT. 6, 1999

BENCHMARK:

SQUARE CUT ON INLET AT S.W. CORNER OF SOJOURN DR. AND ADDISON RD. ELEV. 641.95

SD LINE "B"

SCALES: HOR. 1"=40'
VERT. 1"=4'

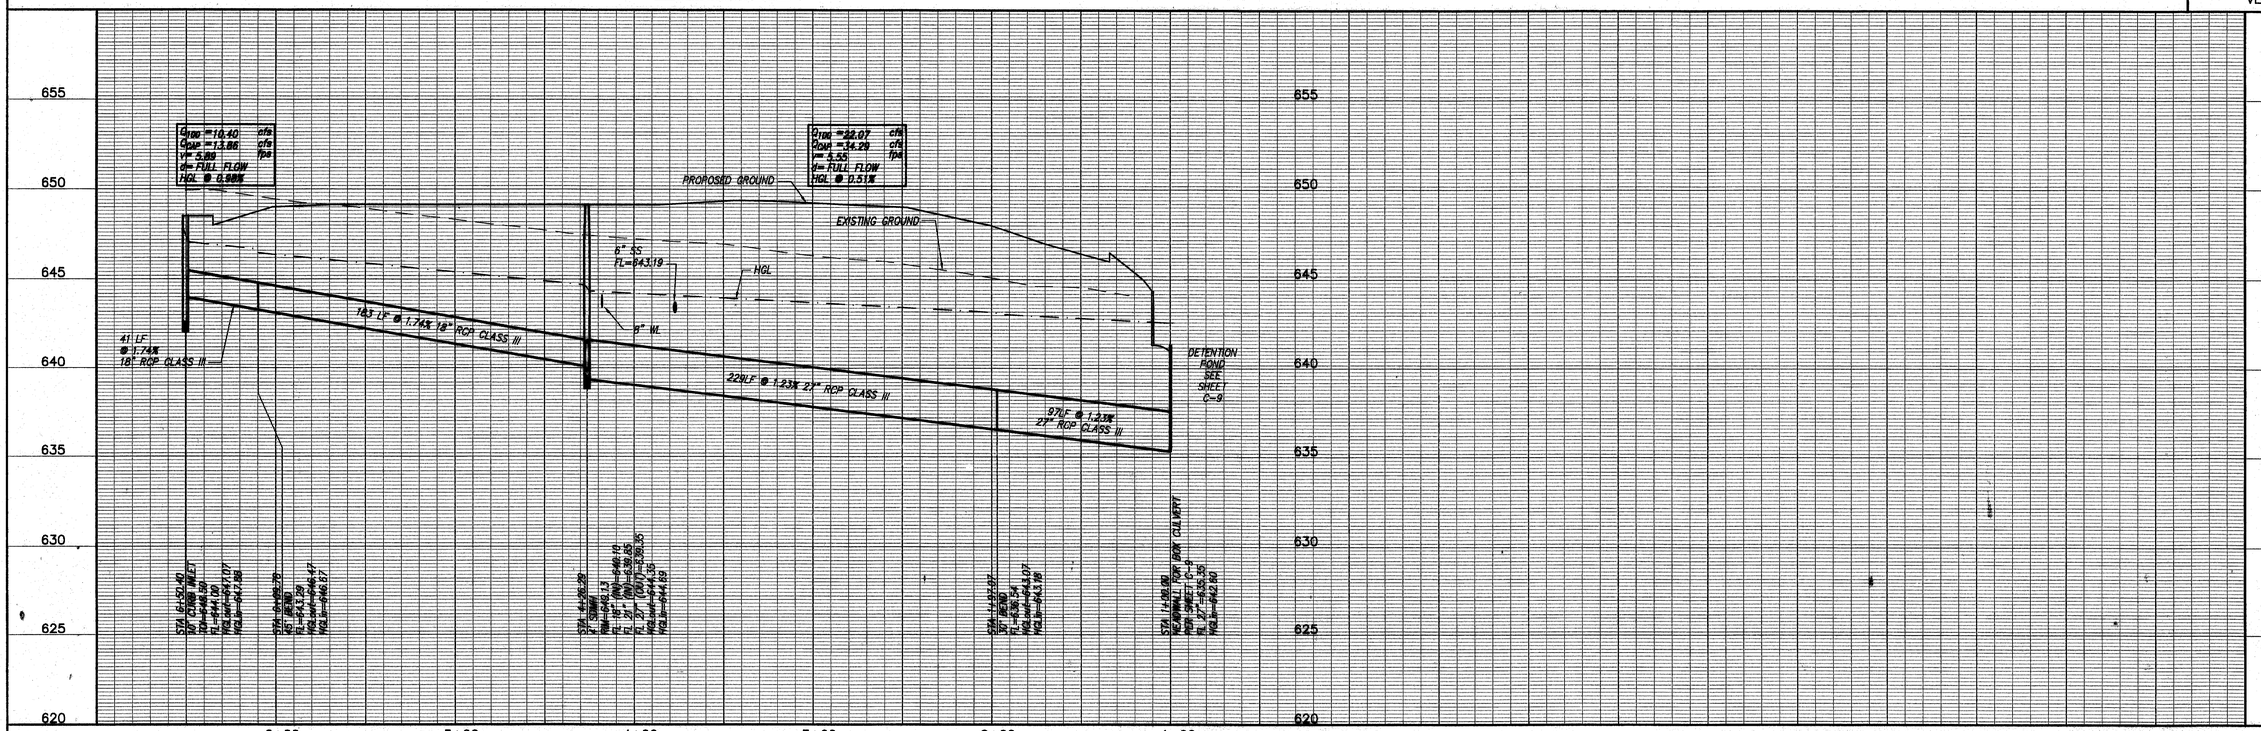

OMNIPLAN ARCHITECTS

SOJOURN OFFICE CENTER
ADDISON, TEXAS

SITEWORK PLANS

STORM DRAIN PP LINE "B" STA 1+00 TO END

FREESE-NICHOLS
1341 W. Mockingbird Lane-Suite 230-E
Dallas, Texas 75247
214-920-2500

F&N JOB NO. OMP99206
FILE 206SDPPA-II
DATE 7-26-99
DESIGNED MDW
DRAWN GAH
REVISED
CHECKED THH

NO.	REVISION	BY	DATE
1	PER CONTRACTOR RFI "1" AND "2"	MDW	4/26/00
2	REVISED PER PAVING FF 1 FOOT	MDW	6/5/00

VERIFY SCALE Bar is one inch on original drawing. If not one inch on this sheet, adjust scale.
0 1"

SHEET C-8

SEQ. 11 OF 16