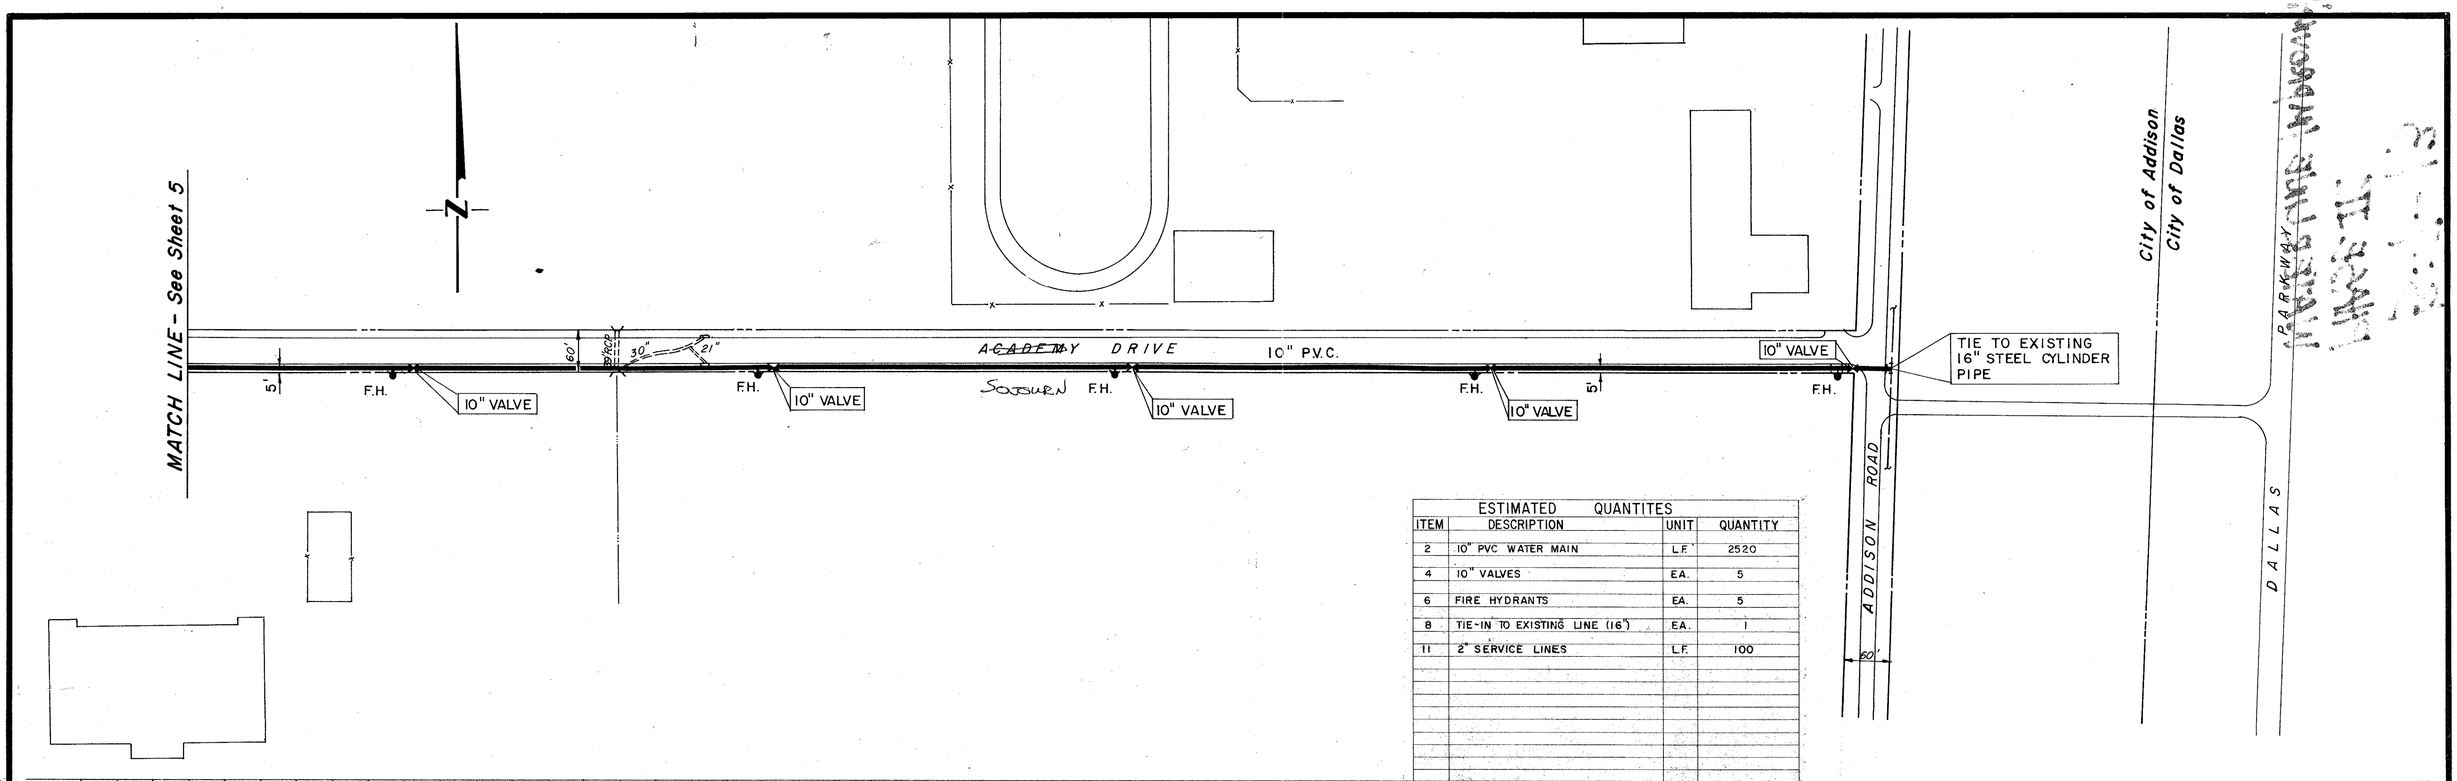

ESTIMATED QUANTITES			
ITEM	DESCRIPTION	UNIT	QUANTITY
2	10" PVC WATER MAIN	L.F.	2520
4	10" VALVES	EA.	5
6	FIRE HYDRANTS	EA.	5
8	TIE-IN TO EXISTING LINE (16")	EA.	1
11	2" SERVICE LINES	L.F.	100

NO.	REVISION	BY	DATE

CITY OF ADDISON
DALLAS COUNTY, TEXAS

WATER IMPROVEMENTS

PHASE
ACADEMY DRIVE
LINE

CONSULTING

DESIGNED BY

DRAWN BY