NO.	DATE	REVISION	APPROV.
1			
2			
3			

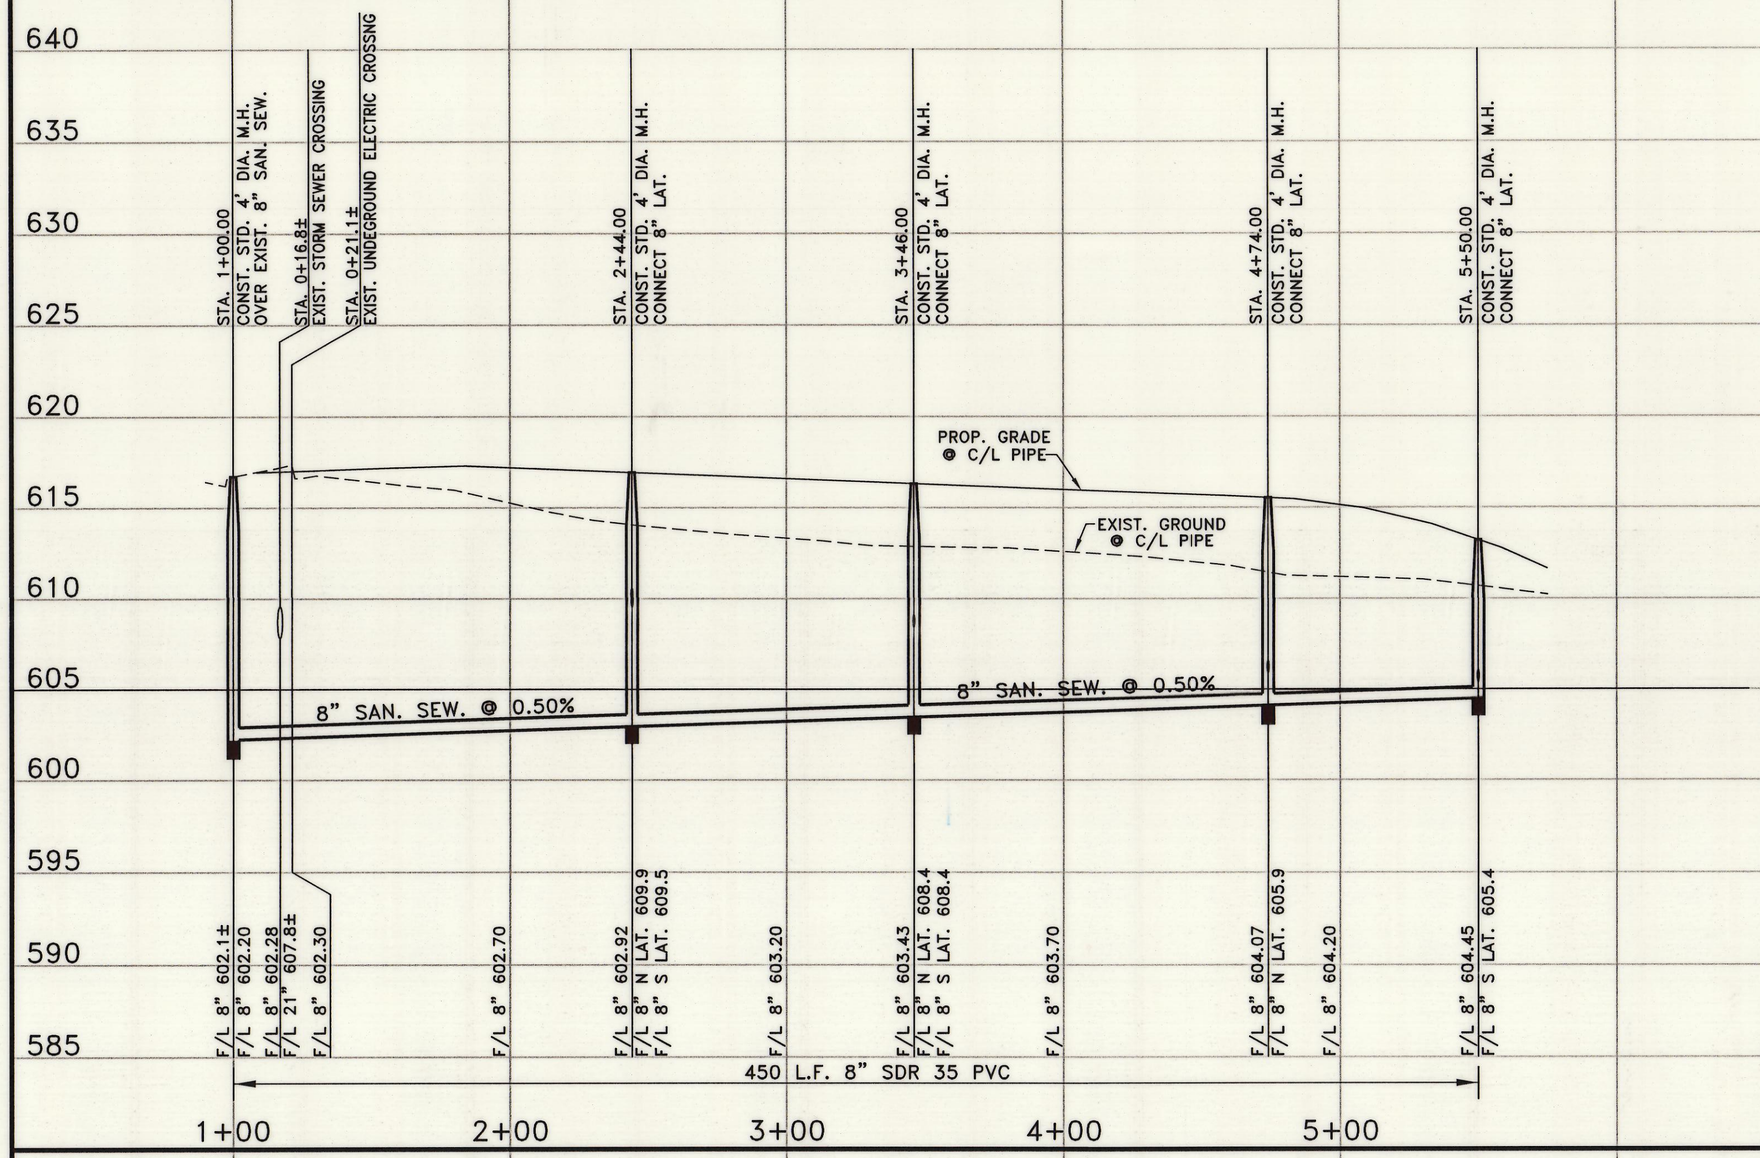

RECORD DRAWING
BASED ON CONTRACTOR MARKUPS
NOT FIELD SURVEY

GRANTHAM & ASSOCIATES
F-005438

STATE OF TEXAS
BRUCE R. GRANTHAM
62659
REGISTERED
PROFESSIONAL ENGINEER

THE SEAL APPEARING ON THIS DOCUMENT WAS AUTHORIZED BY: BRUCE R. GRANTHAM ON 11/10/09
ALTERATION OF A SEALED DOCUMENT WITHOUT PROPER NOTIFICATION TO THE RESPONSIBLE ENGINEER IS AN OFFENSE UNDER THE TEXAS ENGINEERING PRACTICE ACT.

DATE:	APRIL 2007	SCALE:	1"=40'(H)1"=6'(V)	JOB NO.:	1057-06
DRAWN:	G&A	DESIGN: BRG	REVIEWED: BRG	DWG:	1057WATSEW01PP

MIXED USE DEVELOPMENT
TOWN OF ADDISON
12" WATER & SANITARY SEWER PROFILES

SNK DEVELOPMENT INC.

g&a Grantham & Associates
Civil Engineering
1919 S. SHILOH ROAD, SUITE 440, L.B. 8
GARLAND, TEXAS 75042
(972) 864-2333(TEL)
(972) 864-2334(FAX)