



MATCH LINE STA. 3+70

MATCH LINE STA. 3+70

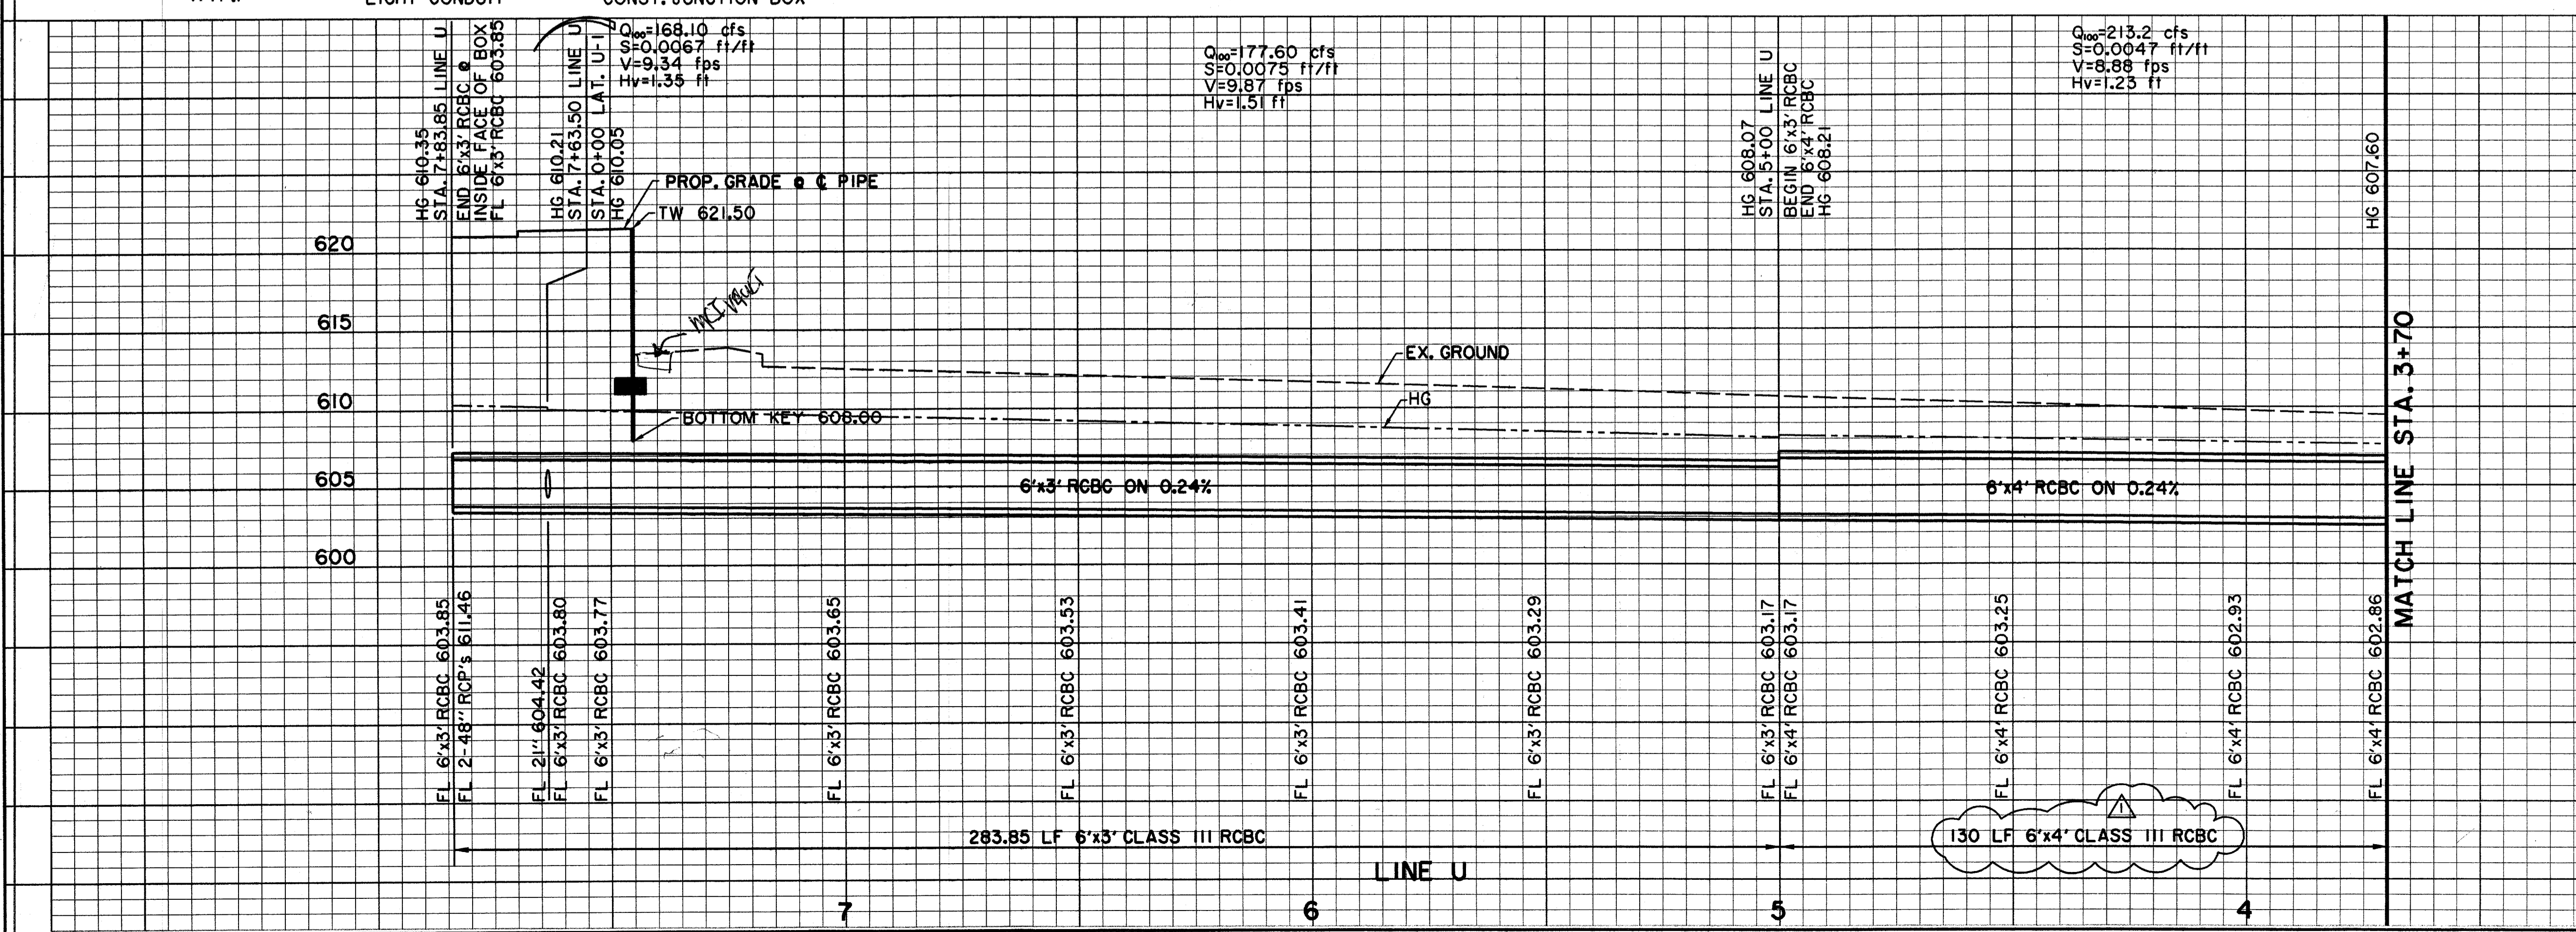

BENCHMARKS:
 "C" CUT SOUTHWEST CORNER OF CURB INLET, WEST SIDE OF SPECTRUM DRIVE, ±30' NORTH OF MORRIS AVENUE. ELEV. 611.84
 "X" CUT ON CONC. TOP OF CURB OF MEDIAN NOSE ON SPECTRUM DRIVE AT INTERSECTION OF McENTIRE PLACE. ELEV. 619.30

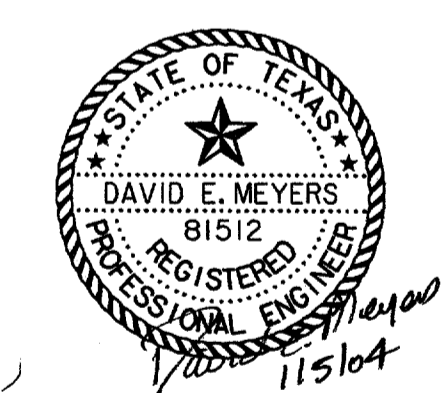

DATE	DESCRIPTION	REF. NO.
1/05/04	ISSUED FOR CONSTRUCTION	
11/11/03	REVISED 6"x4" RCBC LIMITS	
11/07/03	ISSUED FOR BID	

DRAINAGE PLAN & PROFILE
 LINE U STA. 3+70 TO STA. 7+83.85
SPECTRUM DRIVE EXTENSION

TOWN OF ADDISON, TEXAS

Huff - 2010, Inc.
 3131 McKinney Ave., Suite 500, Dallas, TX 75204
 Phone (214) 871-3311/Fax (214) 871-0757

DESIGN	DRAWN	APPR.	SCALE	DATE	PROJECT NO.	NO.
HZI	HZI	DEM	H: 1"=20' V: 1"=6'	NOV 2003	01-3220-01	19

PLOT ROTATION=0.000000
 P2=ROTATION=0.000000
 P3=ROTATION=0.000000
