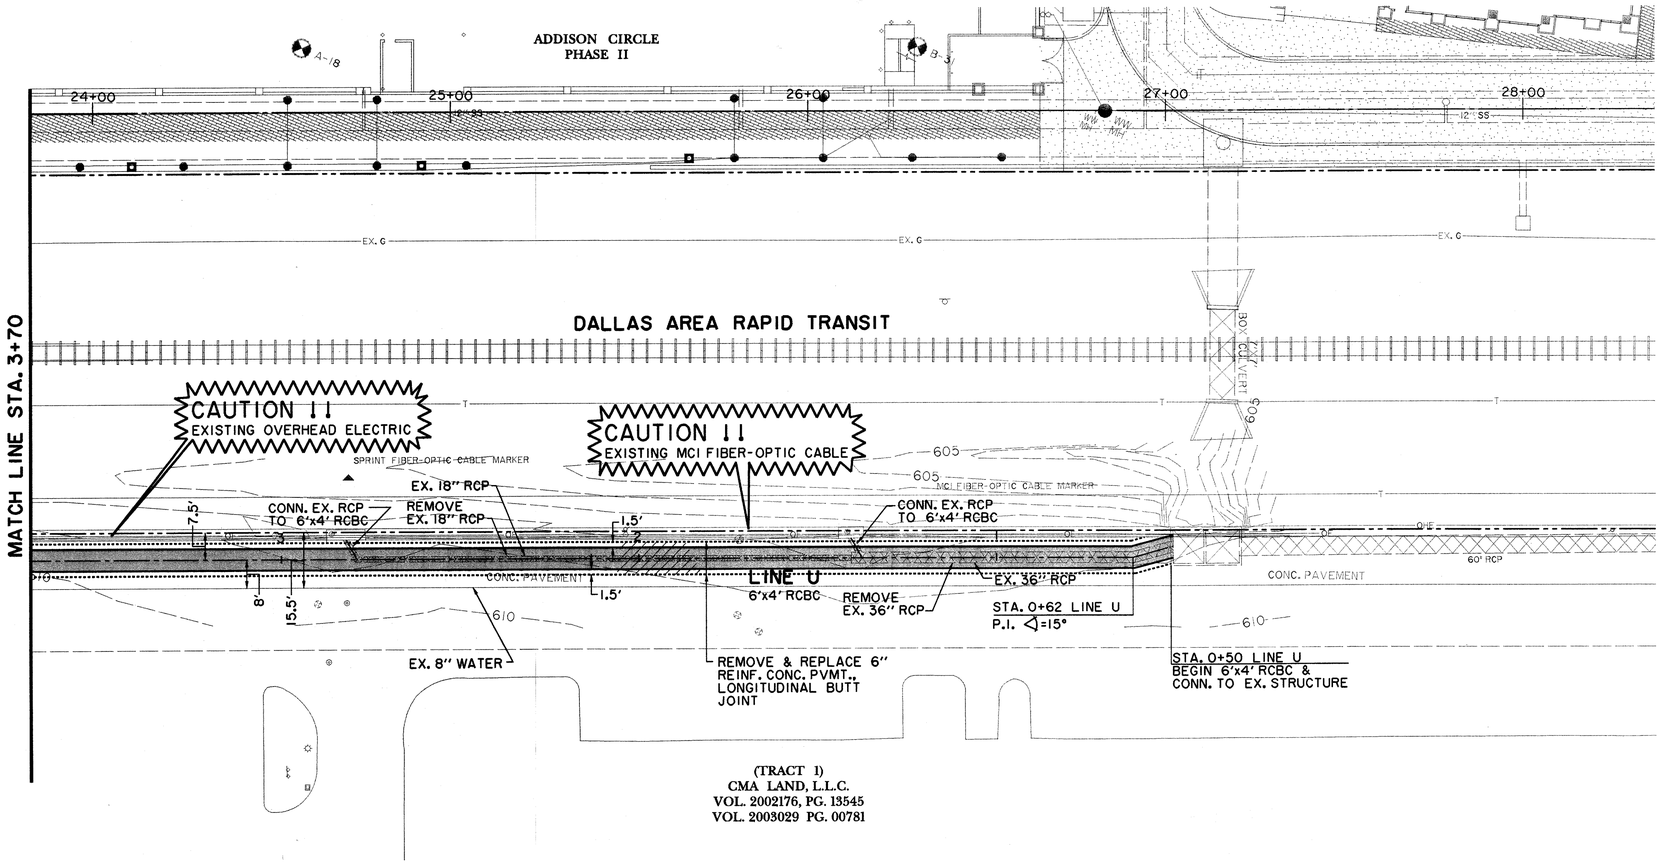

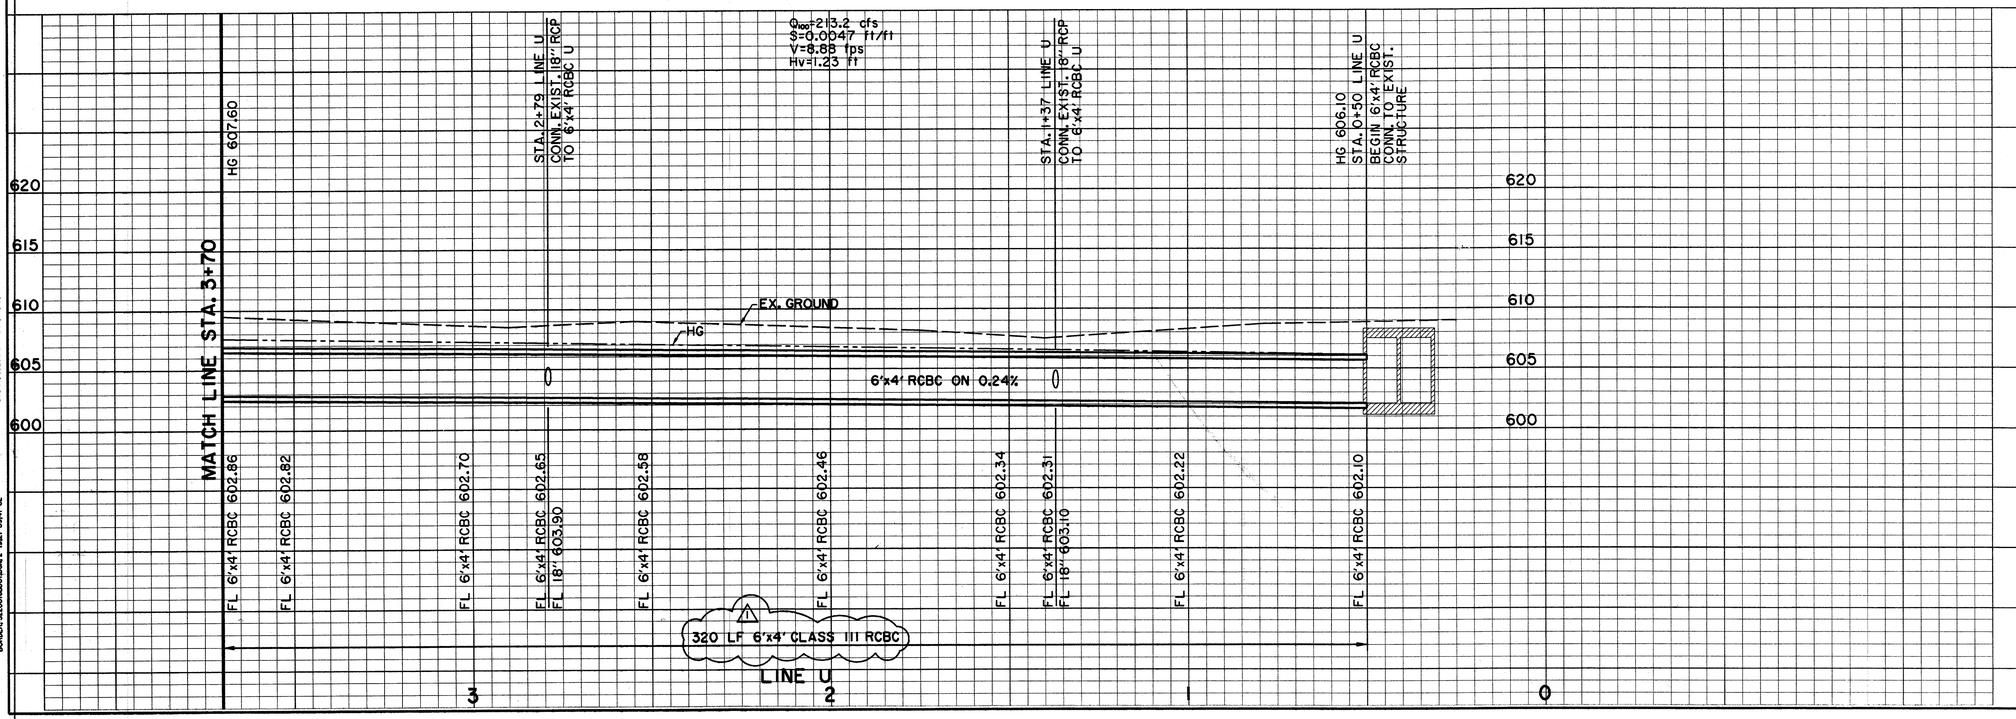

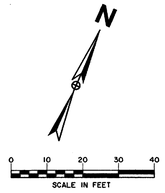

BENCHMARKS:

"□" CUT SOUTHWEST CORNER OF CURB INLET, WEST SIDE OF SPECTRUM DRIVE, ±30' NORTH OF MORRIS AVENUE.
ELEV. 611.84

"X" CUT ON CONC. TOP OF CURB OF MEDIAN NOSE ON SPECTRUM DRIVE AT INTERSECTION OF McENTIRE PLACE.
ELEV. 619.30

STATE OF TEXAS
DAVID E. MEYERS
81512
REGISTERED PROFESSIONAL ENGINEER
11/5/04

DATE	DESCRIPTION	REF NO.
1/05/04	ISSUED FOR CONSTRUCTION	
11/11/03	REVISED 6'x4' RCBC LIMITS	1
11/07/03	ISSUED FOR BID	

DRAINAGE PLAN & PROFILE
LINE U STA. 0+50 TO STA. 3+70
SPECTRUM DRIVE EXTENSION
TOWN OF ADDISON, TEXAS

Huitt - Zollars, Inc.
3131 Mckinney Ave., Suite 600, Dallas, TX 75204
Phone (214) 871-3311 Fax (214) 871-0757

DESIGN	DRAWN	APPR.	SCALE	DATE	PROJECT NO.	NO.
HZI	HZI	DEM		NOV 2003	01-3220-01	20

h:\proj\01322001\dgn\32200iUD07.DGN