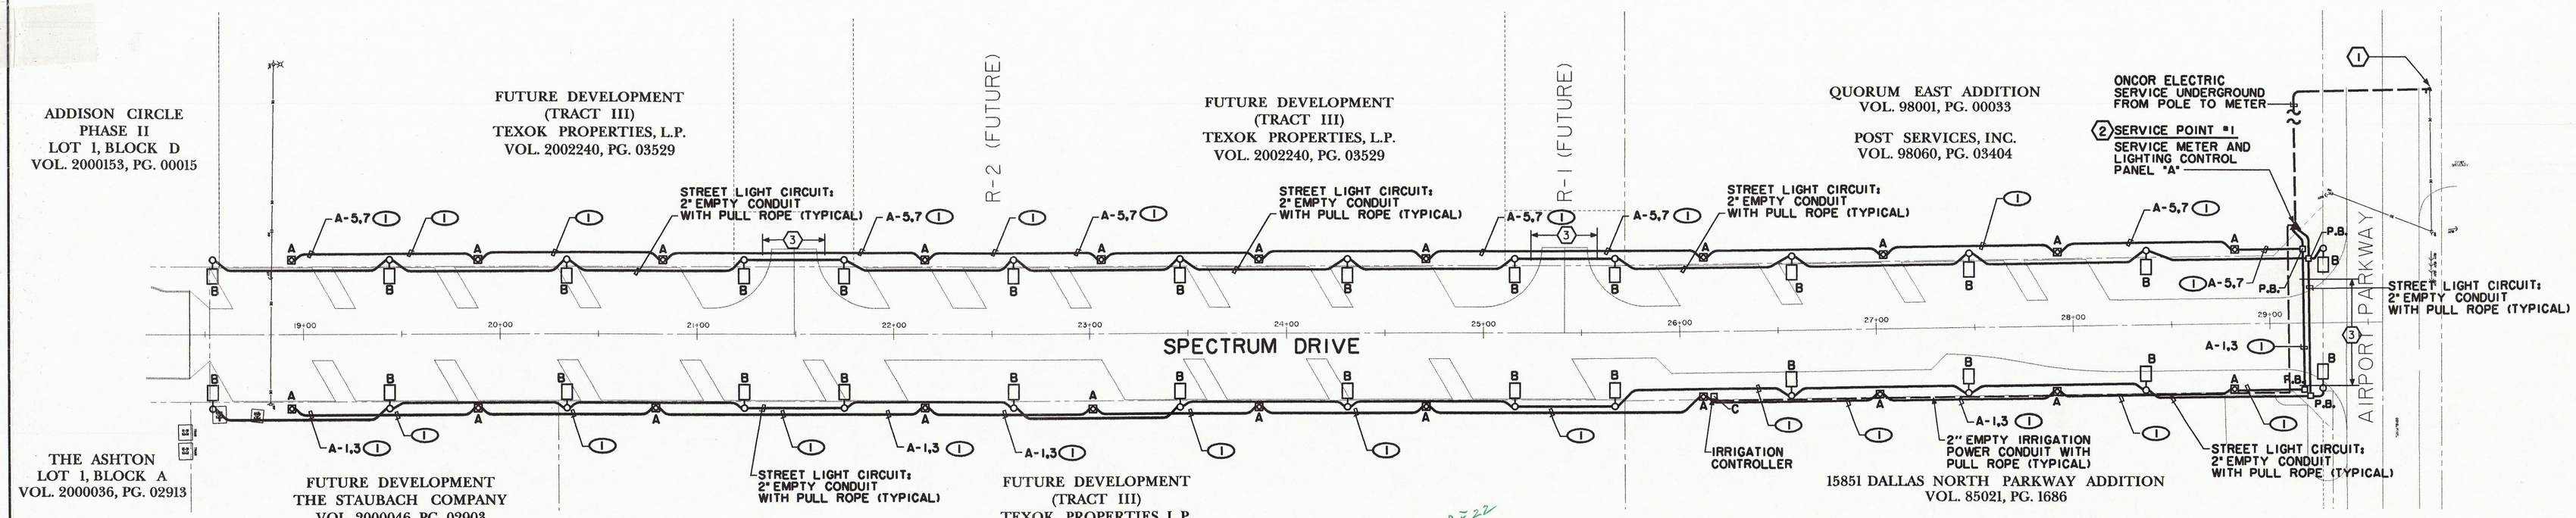

NOTES:

REFER TO LANDSCAPE ARCITECTURAL PLANS FOR EXACT LIGHT POLE LOCATIONS.

REFER TO NOTES AND DETAILS ON SHEET 55

1/54 BASE BID: LIGHTING PLAN

SCALE: 1" = 40'-0"

KEY NOTES

NUMBER	DESCRIPTION
1	ONCOR ELECTRIC SERVICE POLE WITH AERIAL-TO-UNDERGROUND TRANSITION. PROVIDE WIRE AND CONDUIT TERMINATIONS AS REQUIRED BY ONCOR.
2	PROVIDE NEMA 3R ENCLOSURE TO HOUSE PANELS, LIGHT CONTROLS, METERS ETC. SEE DETAIL 3/55.
3	CONCRETE ENCASE CONDUITS UNDER ROADWAY.

LIGHTING CIRCUIT CONDUCTOR SCHEDULE

MARK	WIRE AND CONDUIT
1	(2) #4, #8 GROUND - 2"C
2	(2) #6, #8 GROUND - 2"C
3	(2) #8, #8 GROUND - 2"C

Total A=30

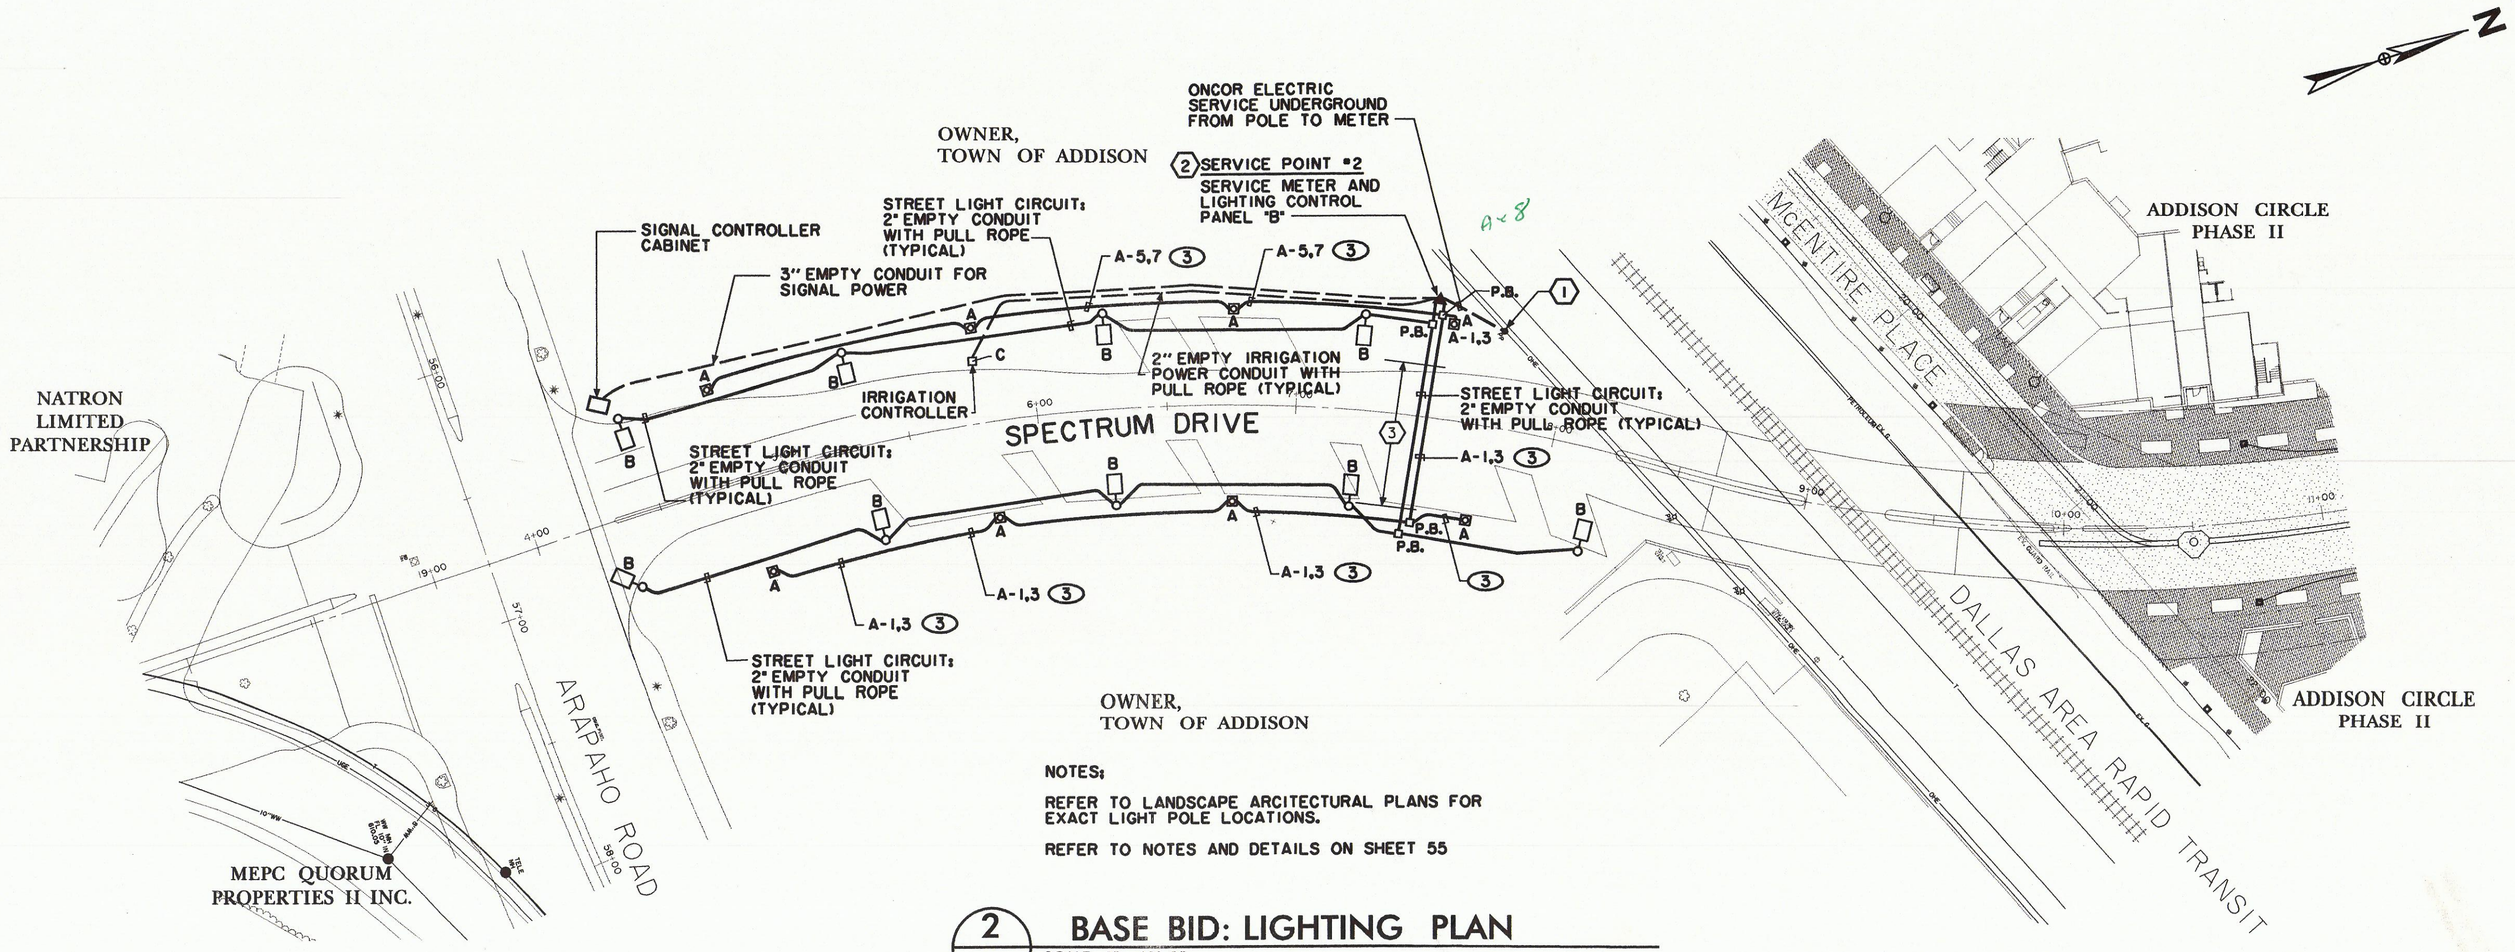

NOTES:

REFER TO LANDSCAPE ARCITECTURAL PLANS FOR EXACT LIGHT POLE LOCATIONS.

REFER TO NOTES AND DETAILS ON SHEET 55

2/54 BASE BID: LIGHTING PLAN

SCALE: 1" = 40'-0"

BENCHMARKS:

"□" CUT SOUTHWEST CORNER OF CURB INLET, WEST SIDE OF SPECTRUM DRIVE, ±30' NORTH OF MORRIS AVENUE.
ELEV. 611.84

"□" CUT ON TOP EAST END OF CURB INLET ON NORTH SIDE OF MORRIS AVENUE AND ±150' EAST OF QUORUM DRIVE CENTERLINE.
ELEV. 616.39

"X" CUT ON CONC. TOP OF CURB OF MEDIAN NOSE ON SPECTRUM DRIVE AT INTERSECTION OF McENTIRE PLACE.
ELEV. 619.30

STATE OF TEXAS
RICHARD L. DICKERSON
69306
REGISTERED
PROFESSIONAL ENGINEER
4/26/04

DATE	DESCRIPTION	REF NO.
4/22/04	DELETED 29 PEDESTRIAN POLES/LIGHTS	2
3/02/04	REVISED ALL STREET AND PEDESTRIAN LTG	1
11/07/03	ISSUED FOR BID	

BASE BID
STREET LIGHT CONDUIT & POWER PLAN
SPECTRUM DRIVE EXTENSION

TOWN OF ADDISON, TEXAS

Huitt - Zollars, Inc.
3131 Mckinney Ave., Suite 600, Dallas, TX 75204
Phone (214) 871-3311/Fax (214) 871-0757

DESIGN	DRAWN	APPR.	SCALE	DATE	PROJECT NO.	NO.
HZI	HZI	RLD	1"=40'	NOV 2003	01-3220-01	54

\\hzdallas2\proj\01322001\dgn\322001ue06.dgn

PRF R07.11.00=9.0.000000
0:\VENTEL\scrcreate.ini
\\hzdallas2\proj\01322001\dgn\322001ue06.dgn
Mon Apr 26 11:34:37 2004
For: Kathleen Hamilton
no batch