Sta. 25+00 I.P. Set 100' Lt. ℄

STA. 25+12, 45.5' Lt. ℄
Std. Type "X" Inlet (mod.)
T.C. 585.44
Top Inlet 585.44
fl. Opng. 584.36
Inv. 581.86

STA. 27+00
1-10' Recessed Inlet
T.C. 584.75
fl. 580.75

STA. 29+00
1-10' Recessed Inlet
T.C. 583.55
fl. 579.55

Sta. 30+00 I.P. Set 100' Lt. ℄

15' Esmt.

16' Gate

6' C.L. Fence

4" Poly

Sta. 25+00 I.P. Set 50' Lt. ℄

STA. 25+00

Adjust W.V.

LAT. G-1
18" R.C.P.

LAT. G-2
18" R.C.P.

Sta. 30+00 I.P. Set 50' Lt. ℄

STA. 30+00

Gravel

18" R.C.P.

4" Gas Abandoned

Overhead Power & Tele.

LATERAL "G"

Cluster 2 & 4

24" R.C.P.

30" R.C.P.

Adjust M.H.

8" Sani. Sewer

15" R.C.P.

SPRING VALLEY RD.
N 89°46'E

ADDISON
FARMERS BRANCH

Adjust W.V.

To be removed, typical

Tele. Pedestal

Overhead Line

Relocate W.M. behind curb

Sta. 25+00 P.K. Nail Set 50' Rt. ℄

Sta. 30+00 P.K. Nail Set 50' Rt. ℄

MATCH LINE

6" Oak

Conc. Walk

Remove conc. 55.5' Rt. ℄

Remove conc. 55.5' Rt. ℄

Sta. 25+00 P.K. Nail Set 100' Rt. ℄

Buried Tele. Cable

6' C.L. Fence

4' C.L. Fence

Fire Station

Sta. 30+00 P.K. Nail Set 100' Rt. ℄

Record Set 5/9/85

B.M. # 2 ☐ On Conc. At N.E. Corner, Sidewalk Of Farmers Branch Fire Station No. 2 At N.E. Of Bldg.
Elv. 584.57

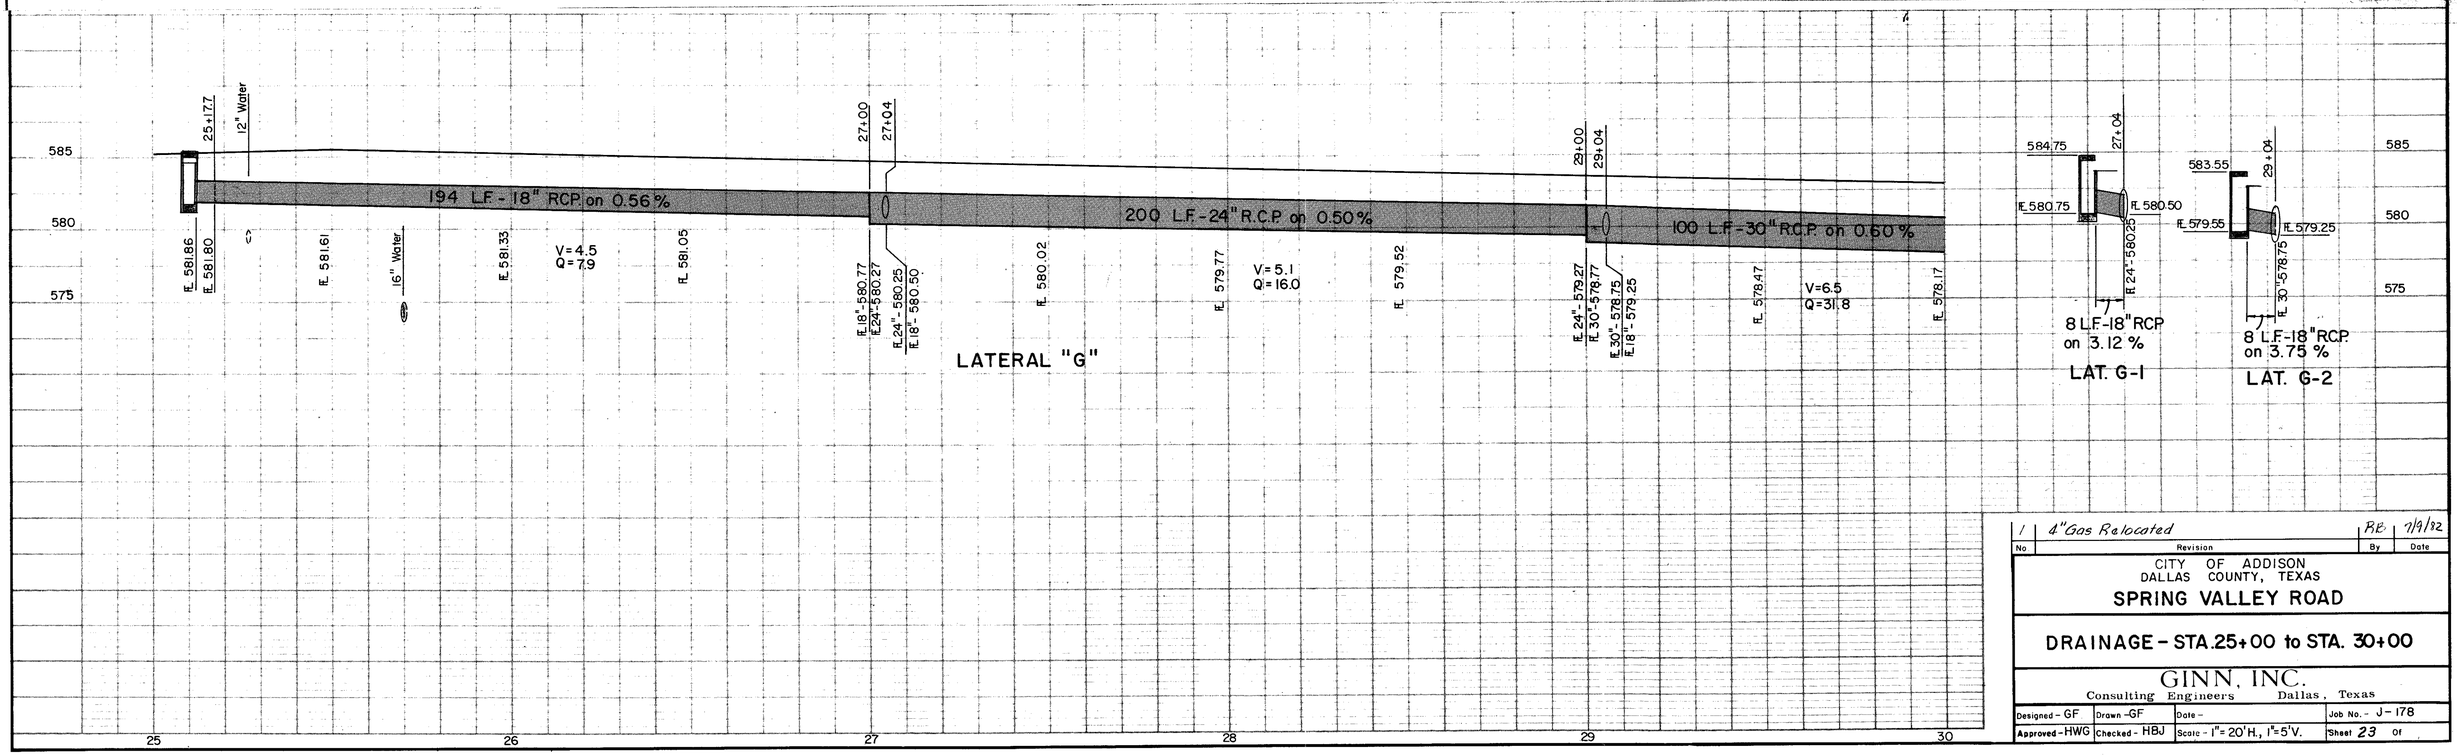

No	Revision	By	Date
1	4" Gas Relocated	RB	7/1/92

CITY OF ADDISON
DALLAS COUNTY, TEXAS

SPRING VALLEY ROAD

DRAINAGE - STA. 25+00 to STA. 30+00

GINN, INC.
Consulting Engineers Dallas, Texas

Designed - GF	Drawn - GF	Date -	Job No. - J-178
Approved - HWG	Checked - HBJ	Scale - 1" = 20' H, 1" = 5' V.	Sheet 23 Of